



**LEGEND**

ORIGINAL SURVEYED EXISTING GRADE ALONG CONSTRUCTION C  
 FINISHED GRADE THIS CONTRACT  
 ULTIMATE FINISHED GRADE ALONG CONSTRUCTION C

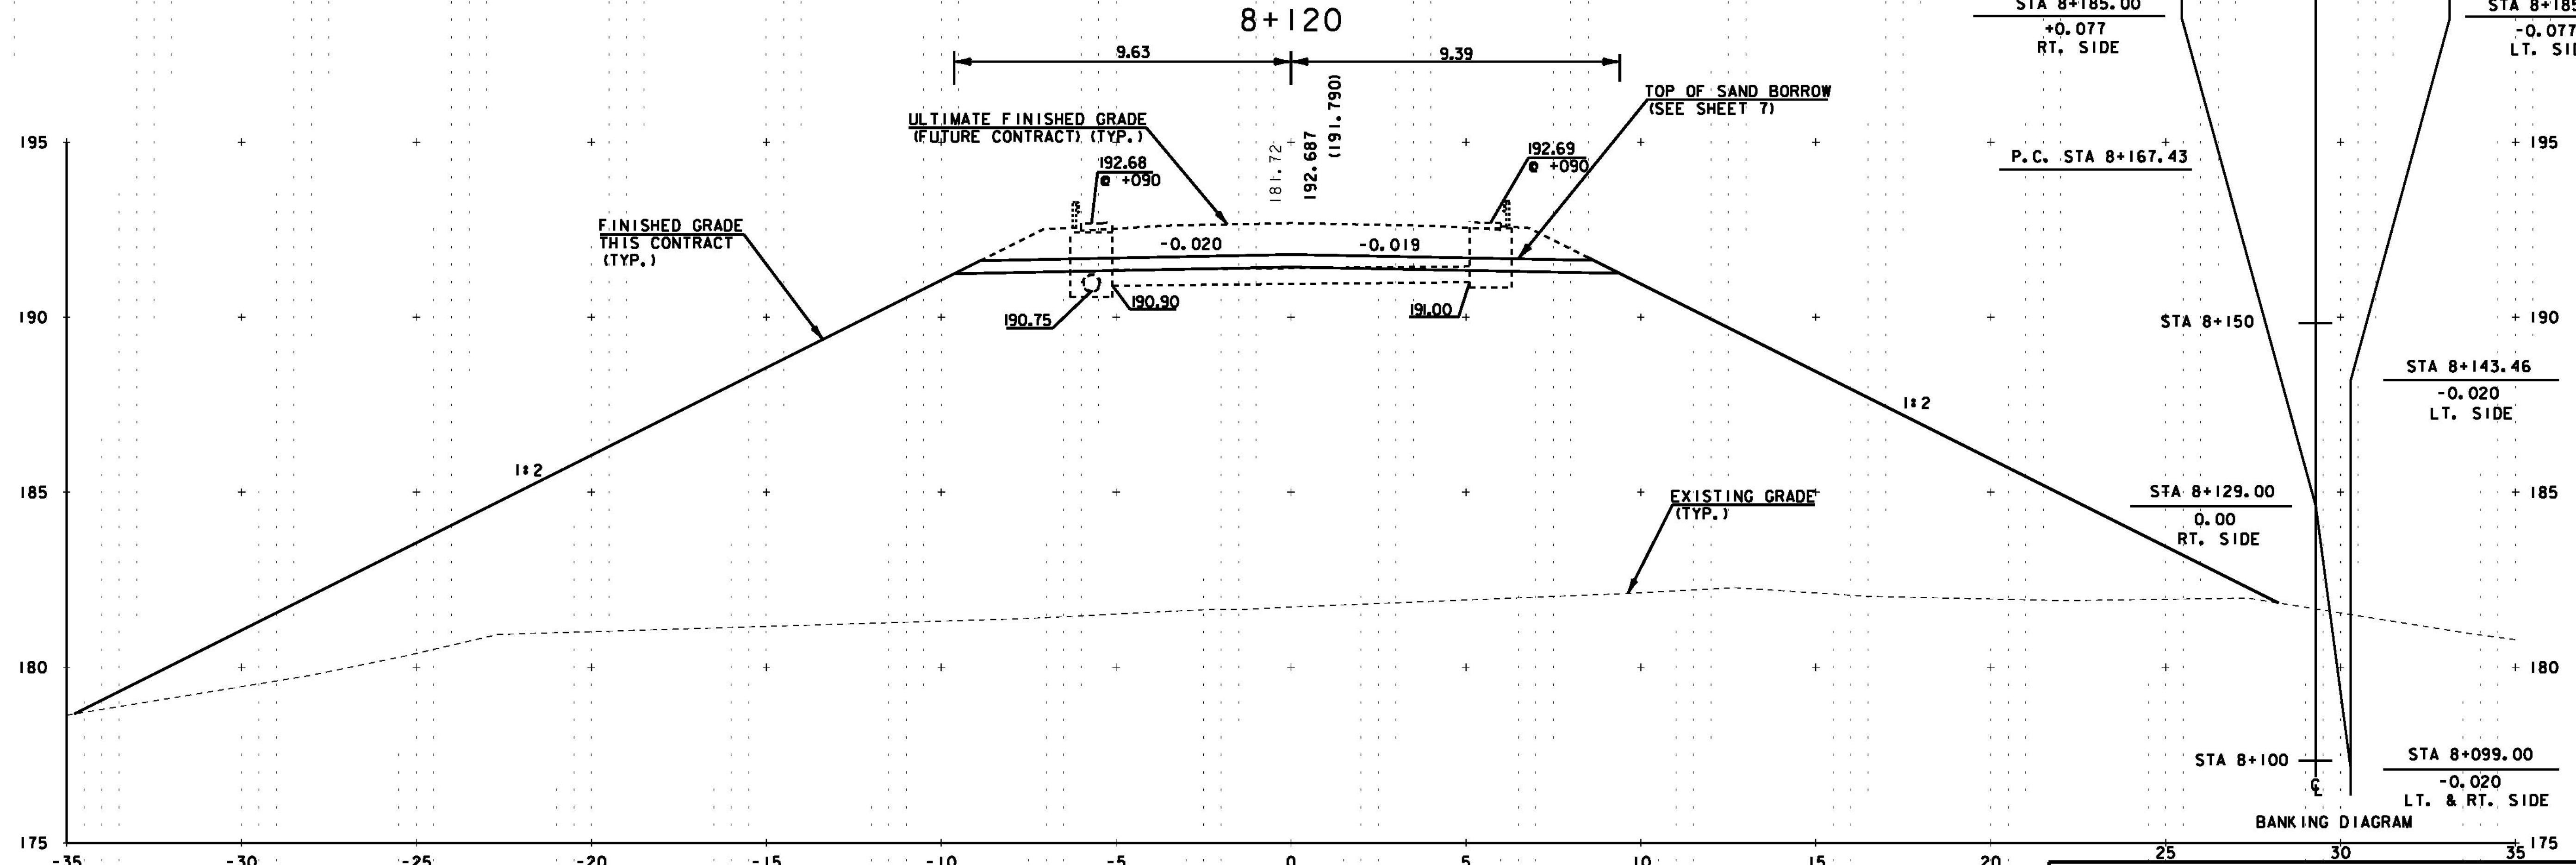

NOTE: ALL DIMENSIONS IN METERS (M) EXCEPT WHERE NOTED.

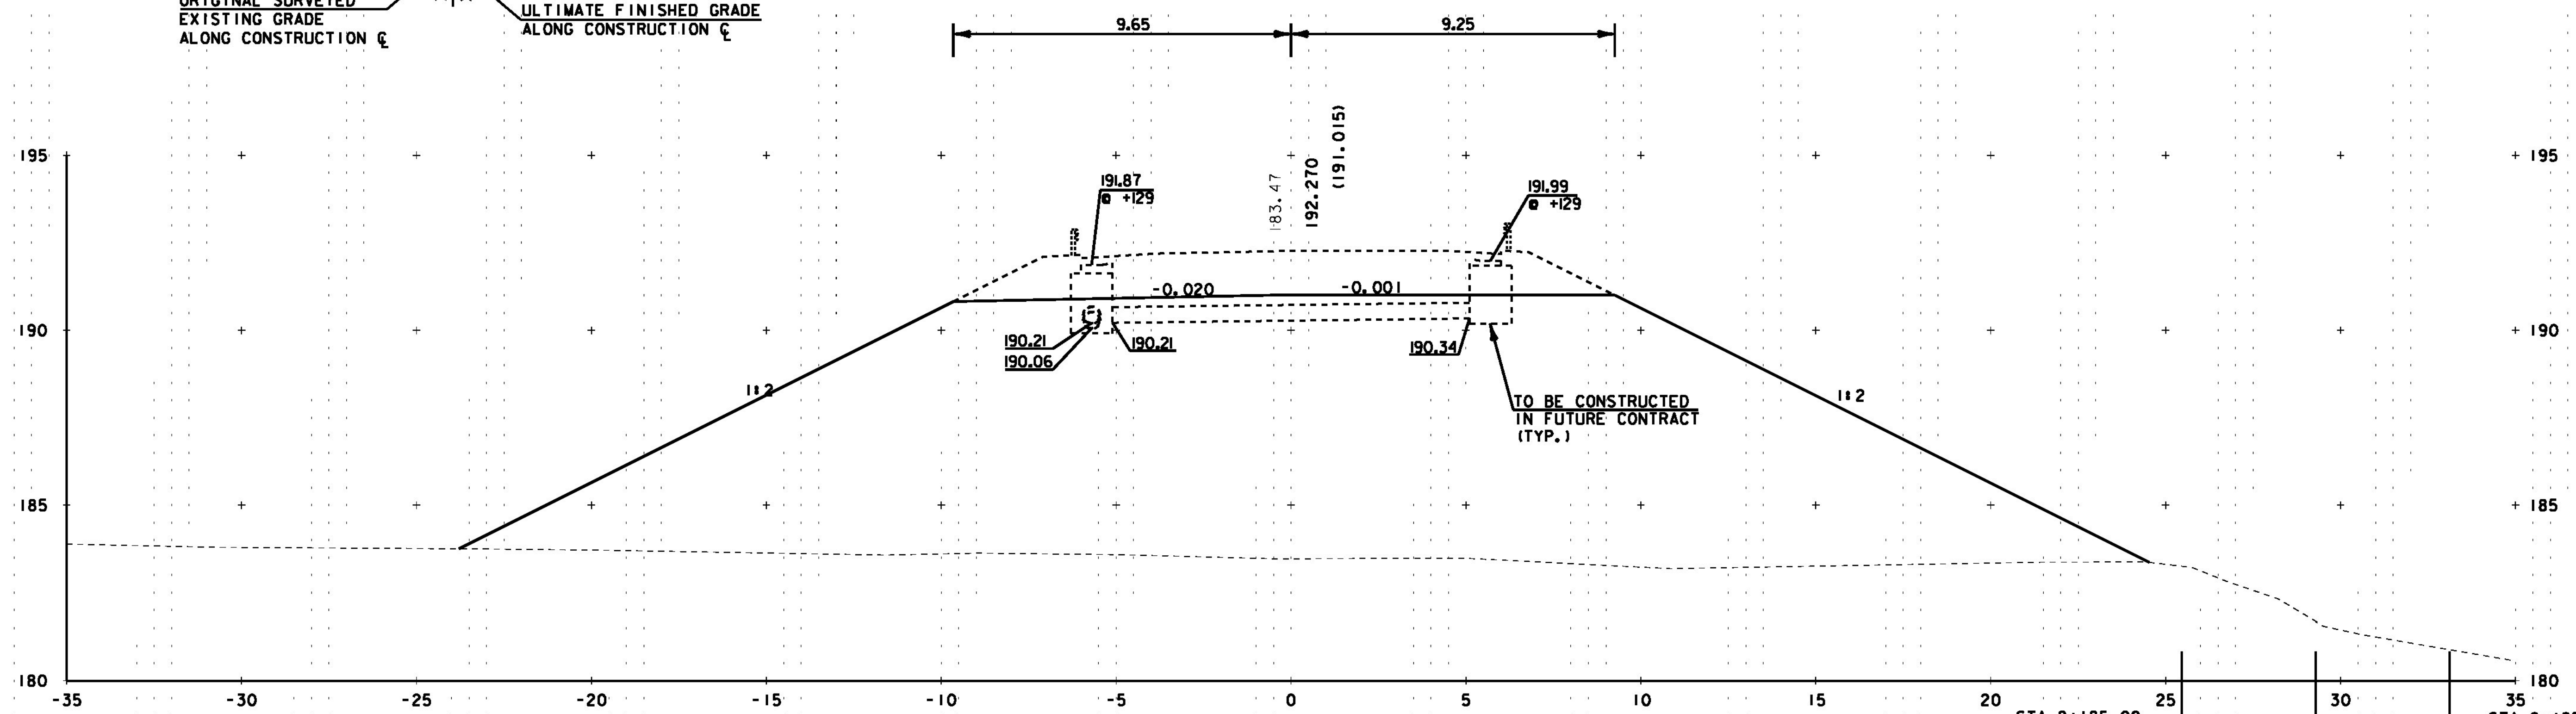

PROJECT NAME:	MORRISTOWN	FILE NAME:	z10b194xs.dgn	PLOT DATE:	30-MAR-2012
PROJECT NUMBER:	STP F 029-1(2)C/1	PROJECT LEADER:	DMB	DRAWN BY:	MAL
		DESIGNED BY:	BRC	CHECKED BY:	DMB
		ROADWAY CROSS SECTIONS:	8+100 TO 8+120	SHEET	112 OF 123