



LEGEND

XXX.XX
 XXX.XXX
 (XXX.XXX)

ORIGINAL SURVEYED
 EXISTING GRADE
 ALONG CONSTRUCTION C

FINISHED GRADE
 THIS CONTRACT

ULTIMATE FINISHED GRADE
 ALONG CONSTRUCTION C

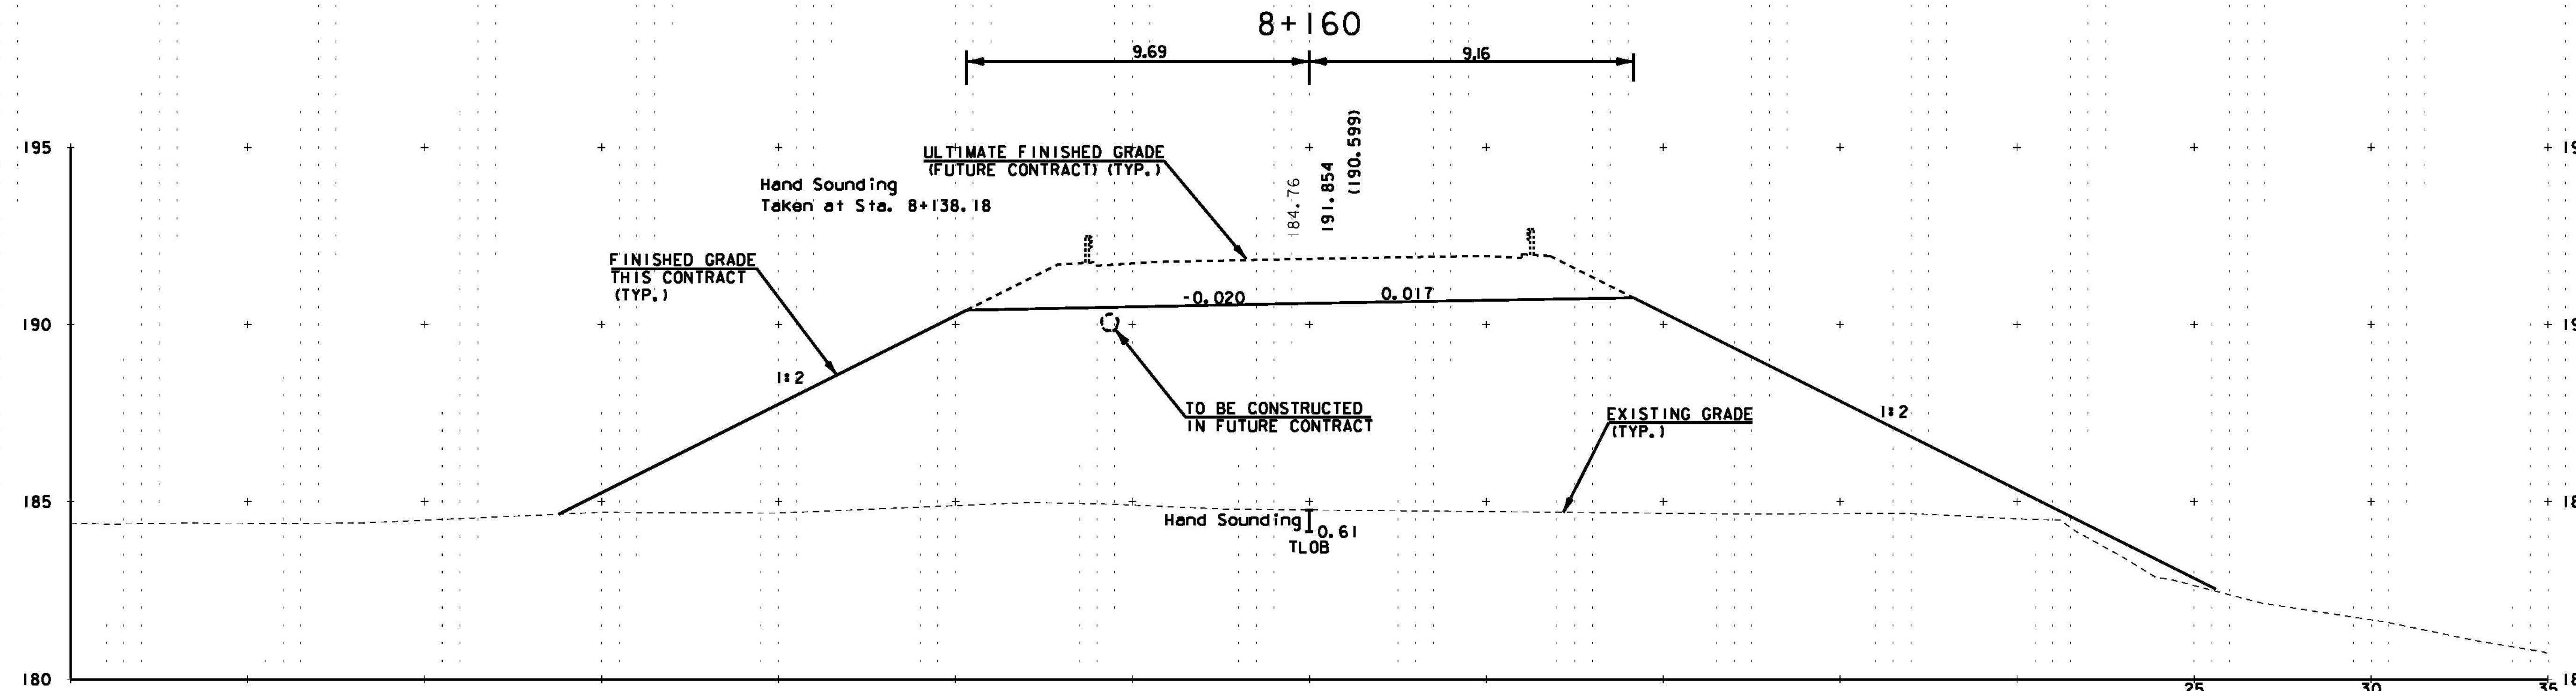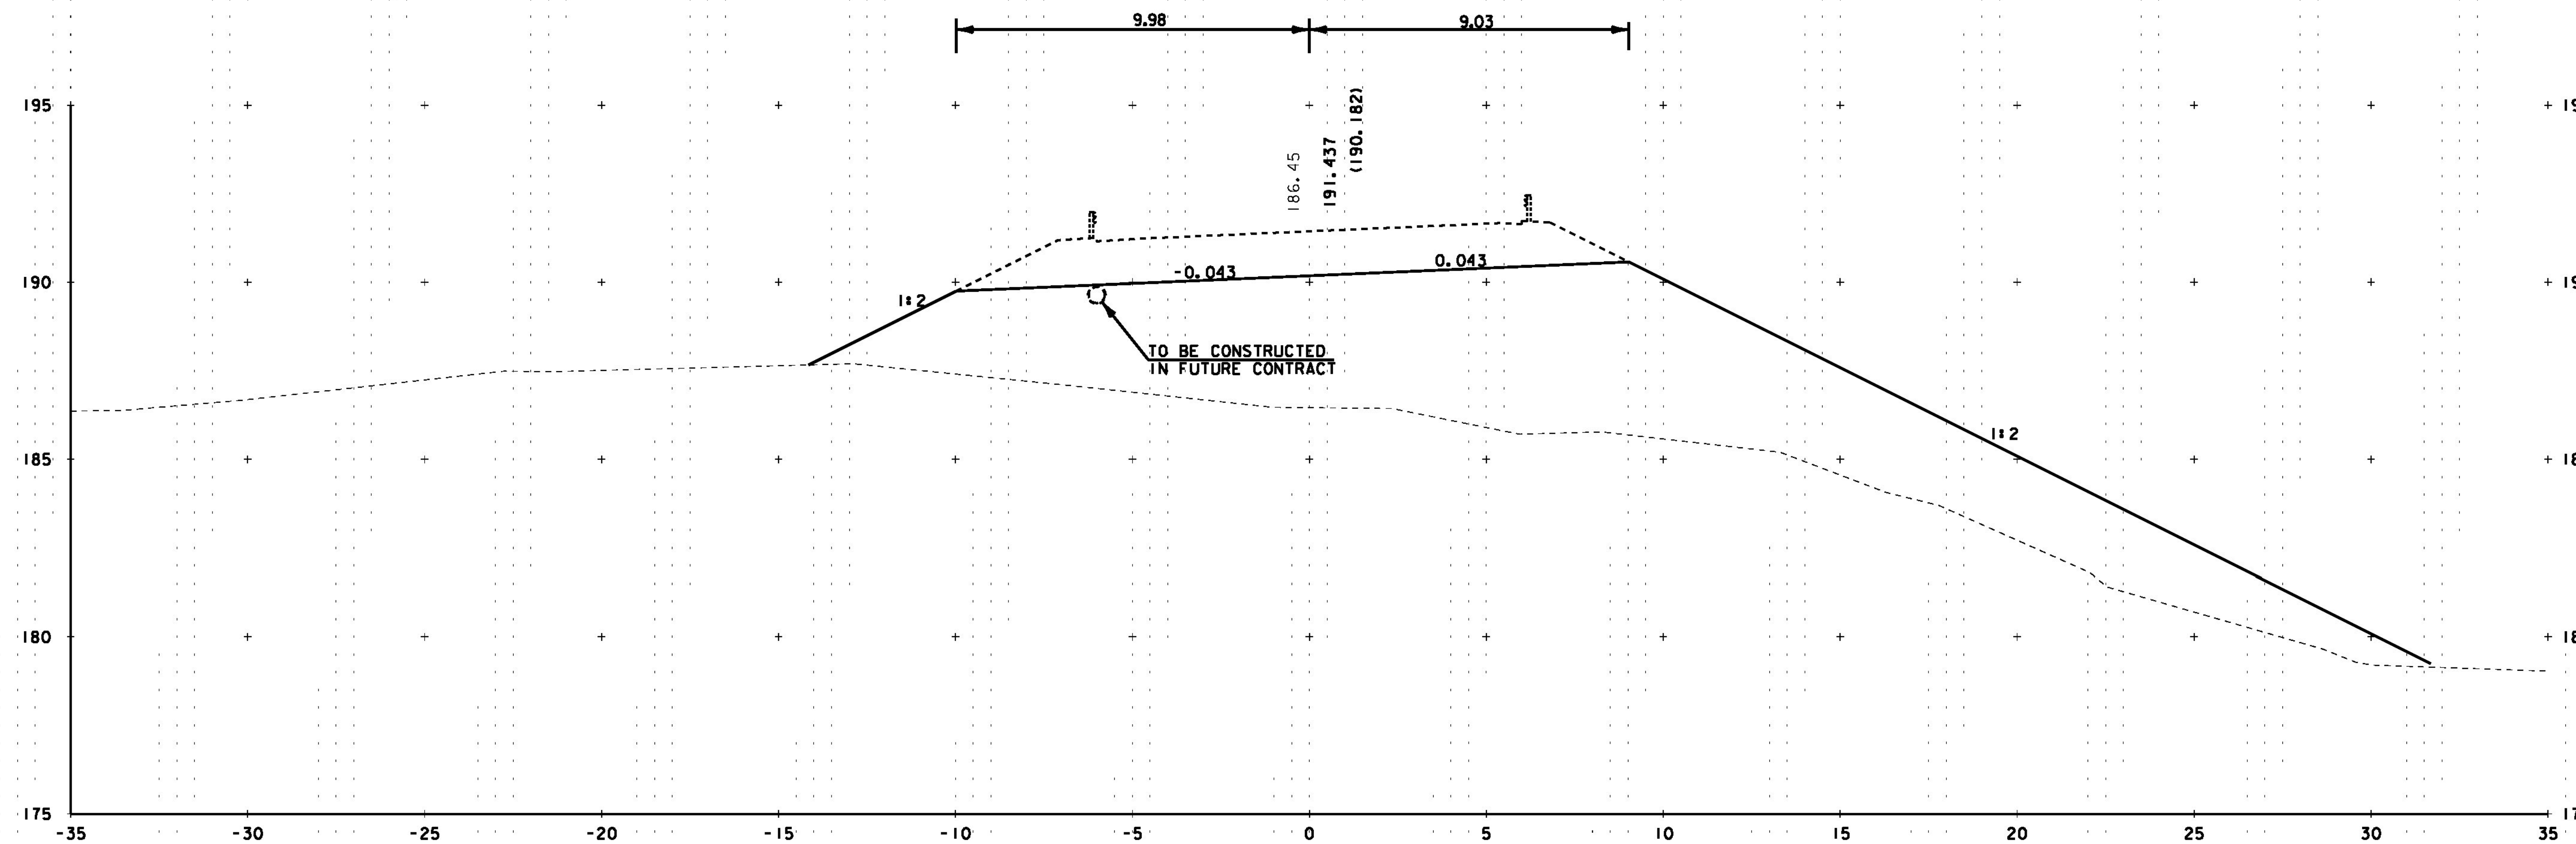

NOTE: ALL DIMENSIONS IN METERS (M) EXCEPT WHERE NOTED.



PROJECT NAME:	MORRISTOWN	PLOT DATE:	30-MAR-2012
PROJECT NUMBER:	STP F 029-1(2)C/1	DRAWN BY:	MAL
FILE NAME:	z10b194xs.dgn	CHECKED BY:	DMB
PROJECT LEADER:	DMB	DESIGNED BY:	BRC
ROADWAY CROSS SECTIONS:	8+140 TO 8+160	SHEET	113 OF 123