



LEGEND

XXX.XX
 XXX.XXX
 (XXX.XXX)
 FINISHED GRADE THIS CONTRACT
 ULTIMATE FINISHED GRADE ALONG CONSTRUCTION C
 ORIGINAL SURVEYED EXISTING GRADE ALONG CONSTRUCTION C

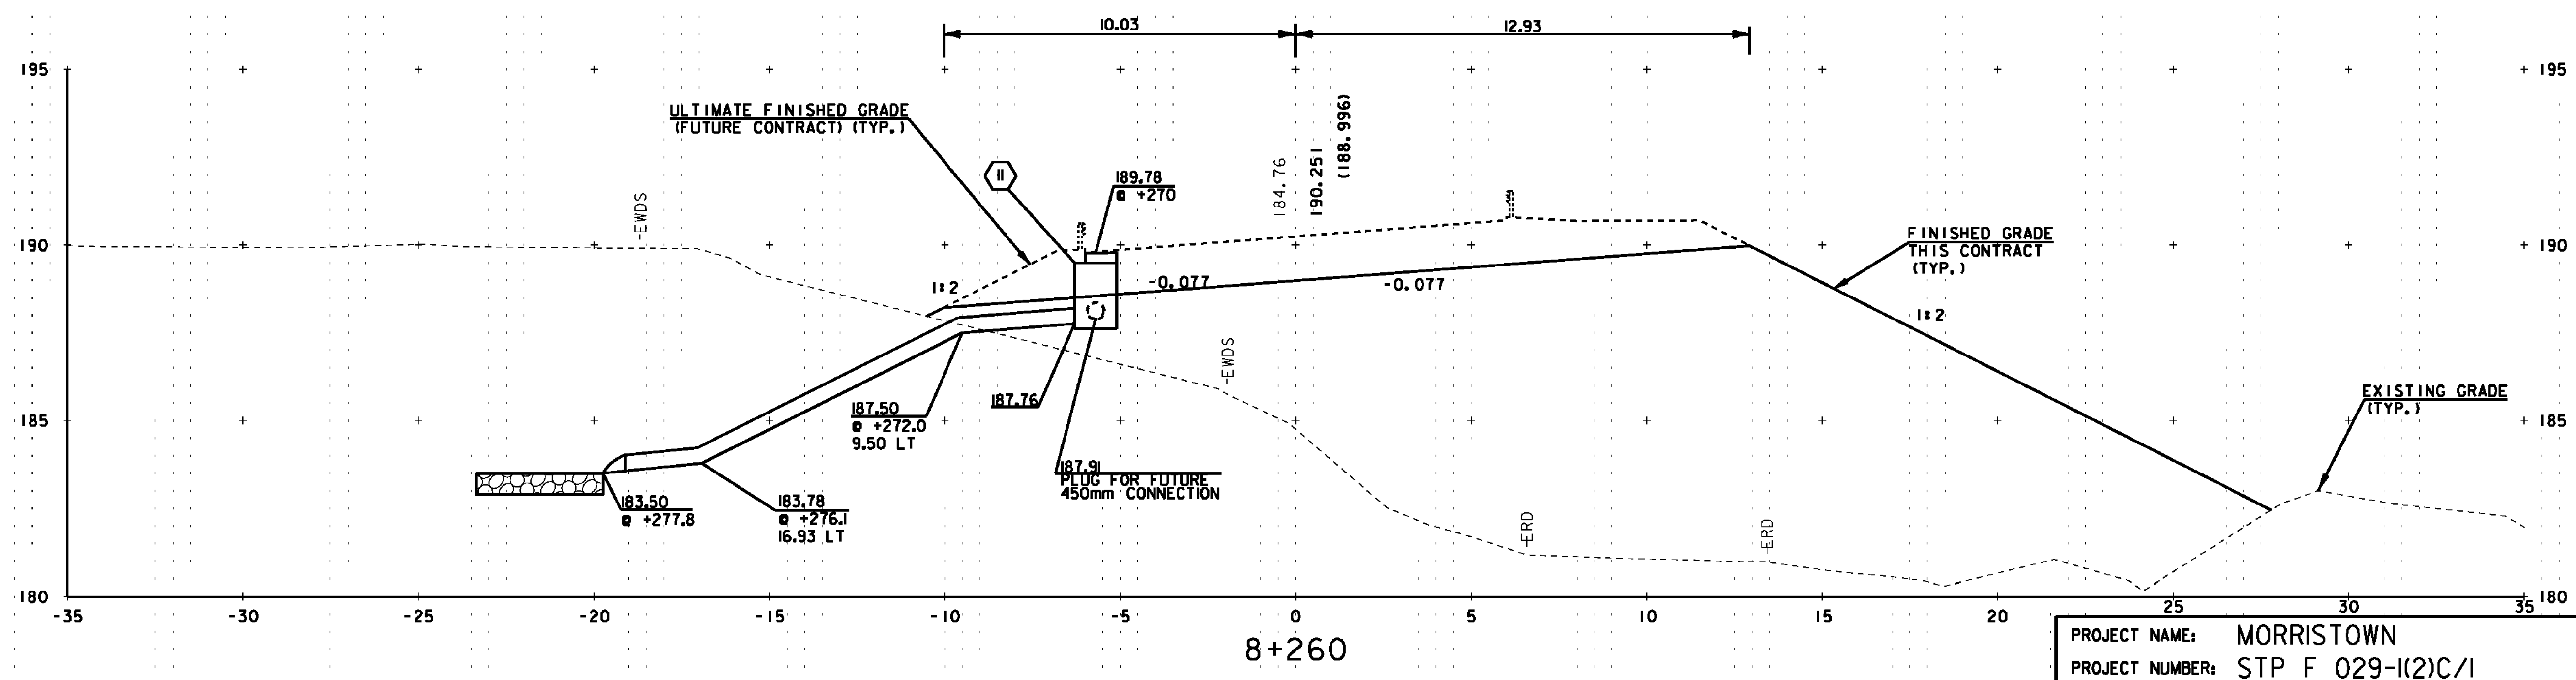

NOTE: ALL DIMENSIONS IN METERS (M) EXCEPT WHERE NOTED.

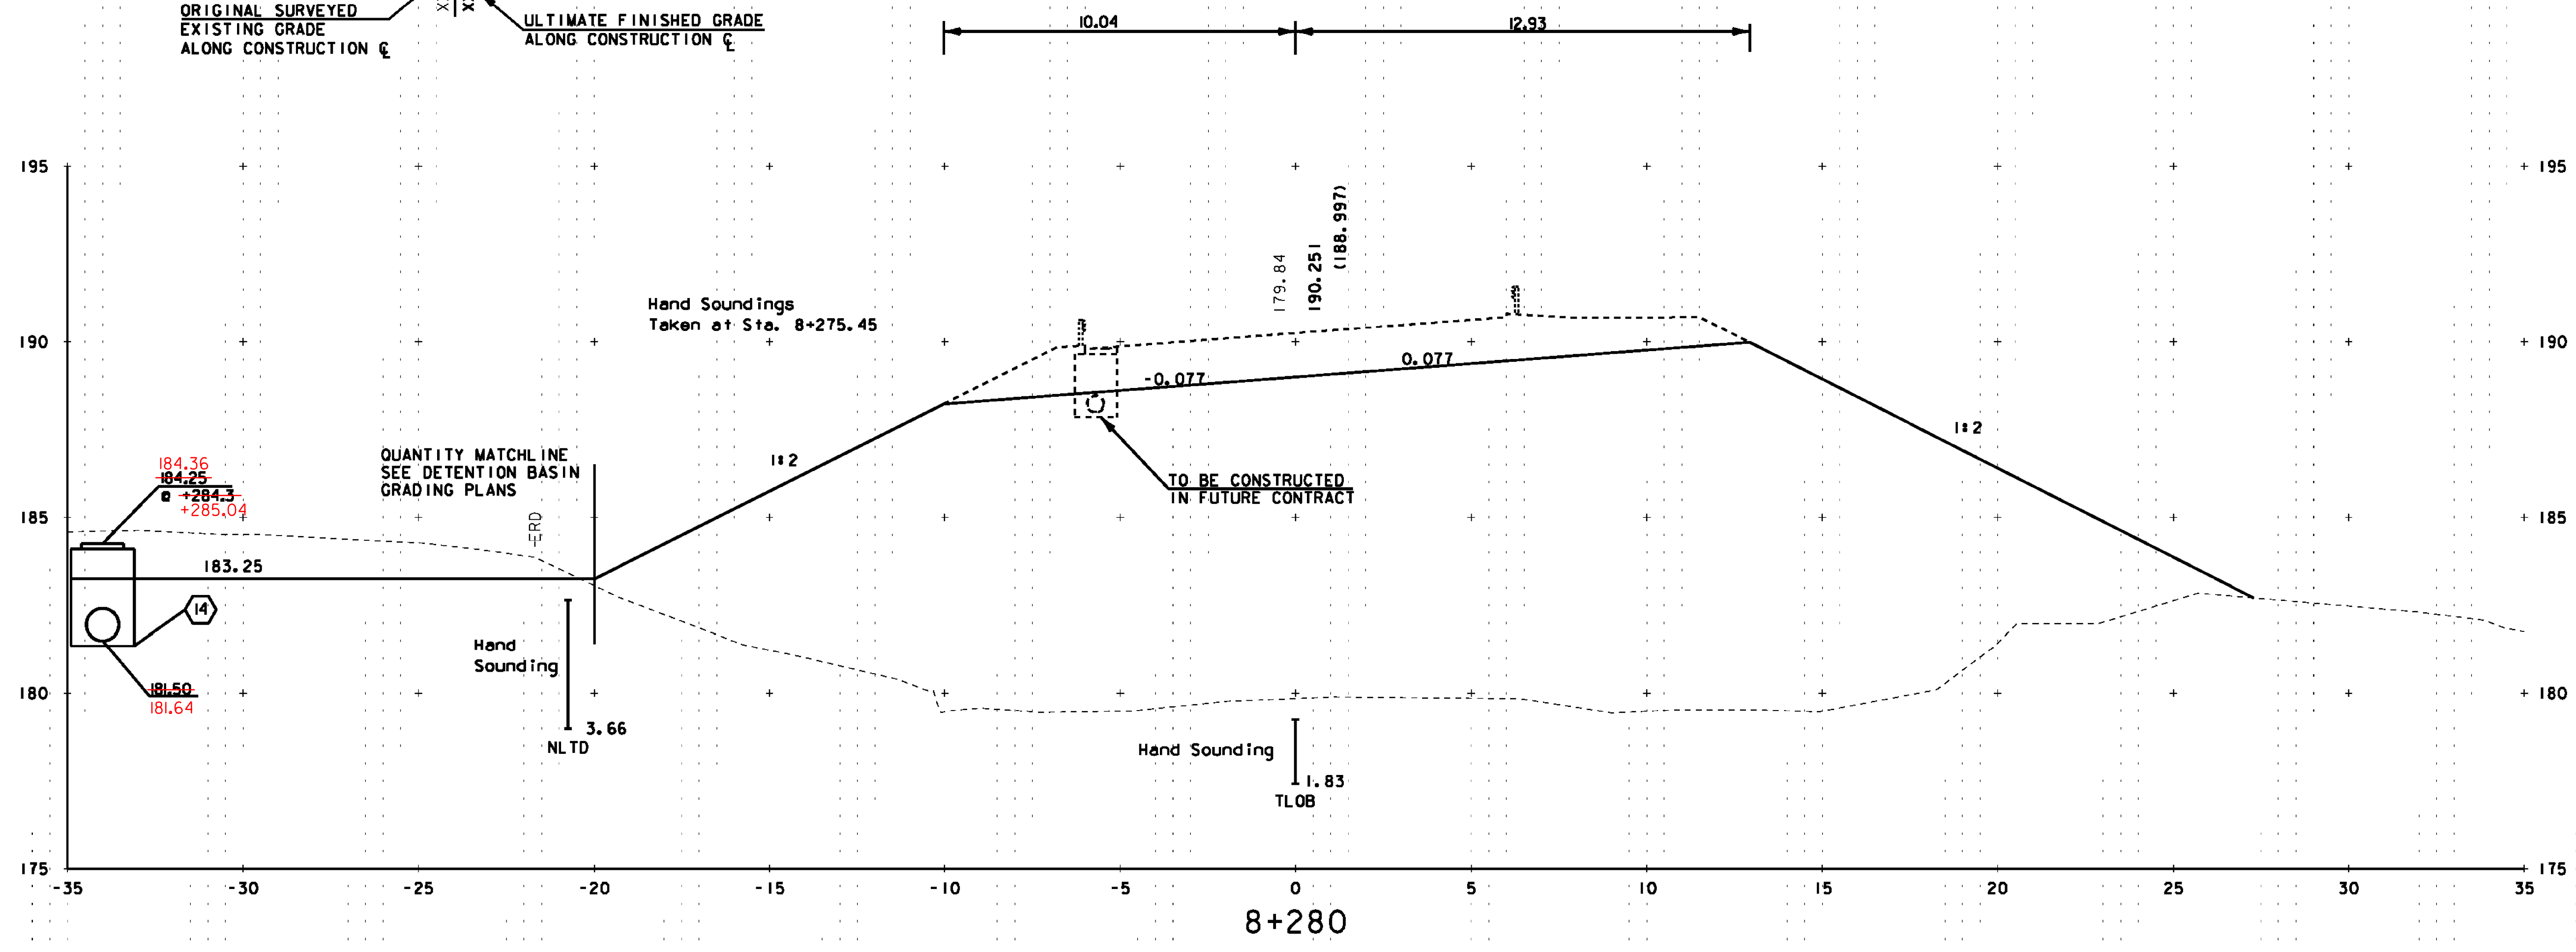

| | |
|--|------------------------|
| PROJECT NAME: MORRISTOWN | PLOT DATE: 30-MAR-2012 |
| PROJECT NUMBER: STP F 029-(1)C/1 | DRAWN BY: MAL |
| FILE NAME: z10b194xs.dgn | CHECKED BY: DMB |
| DESIGNED BY: BRC | SHEET 116 OF 123 |
| ROADWAY CROSS SECTIONS: 8+260 TO 8+280 | |