
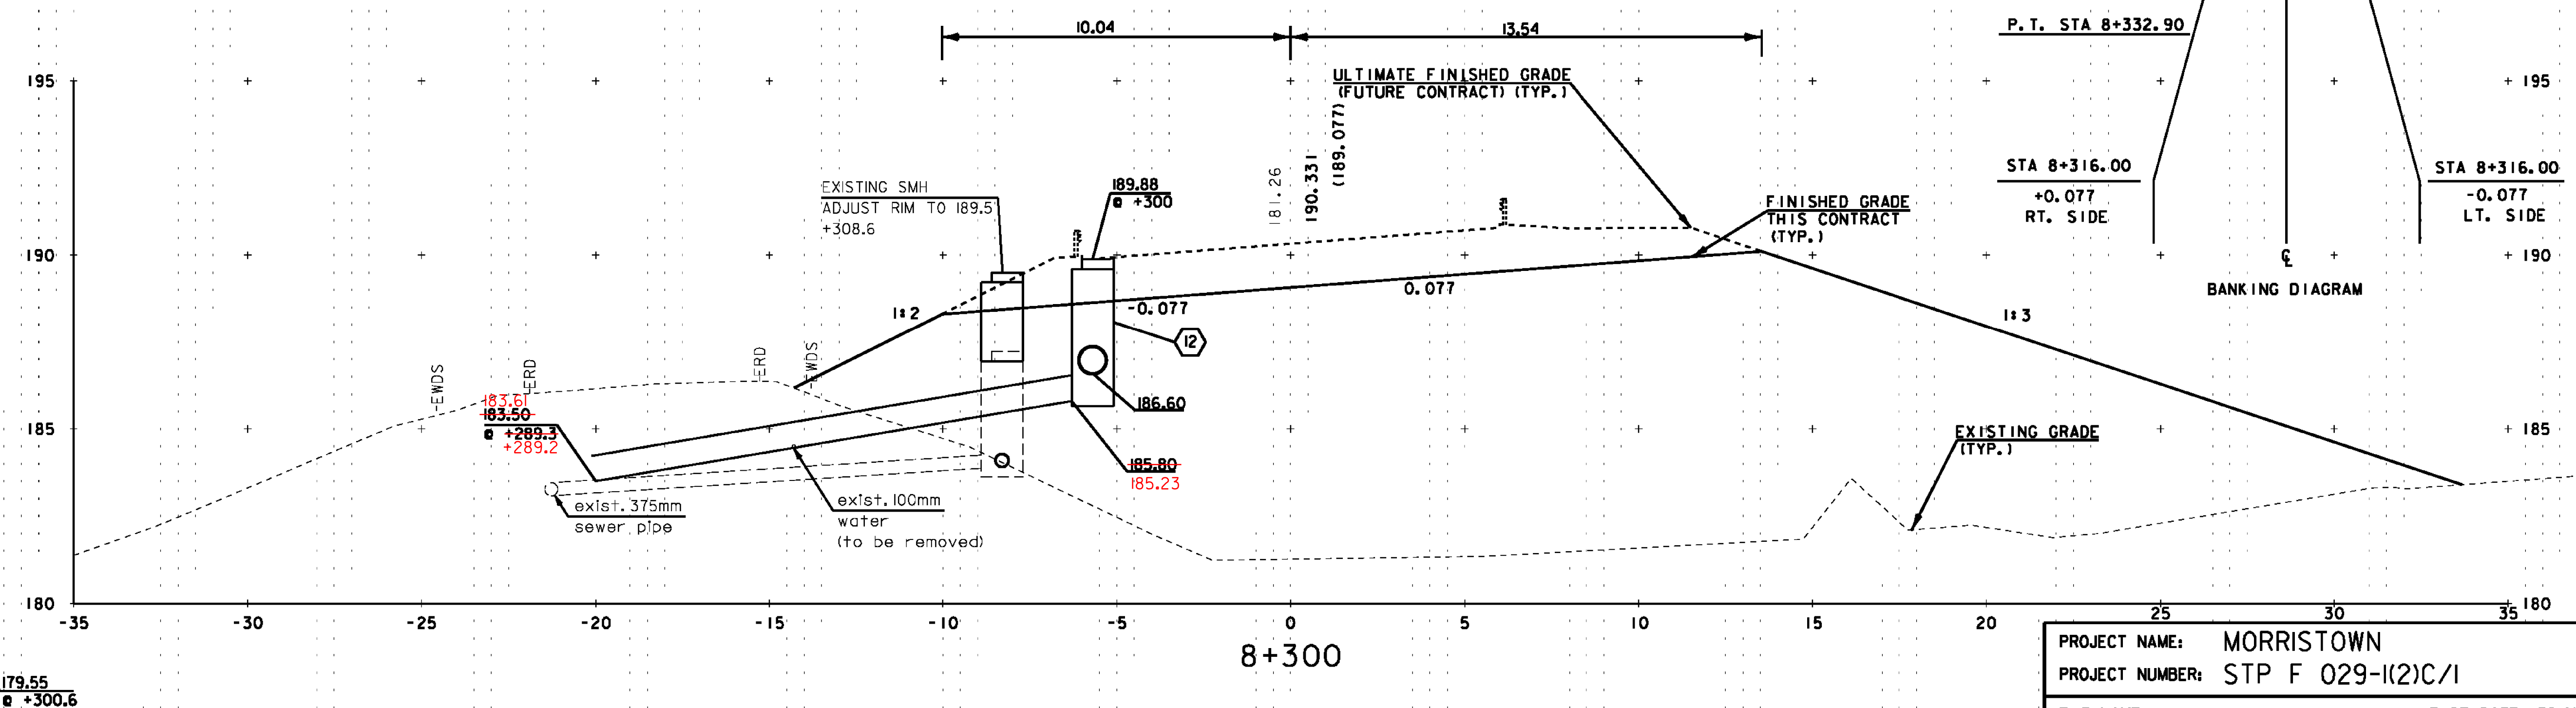


LEGEND

ORIGINAL SURVEYED EXISTING GRADE ALONG CONSTRUCTION CL
 FINISHED GRADE THIS CONTRACT
 ULTIMATE FINISHED GRADE ALONG CONSTRUCTION CL

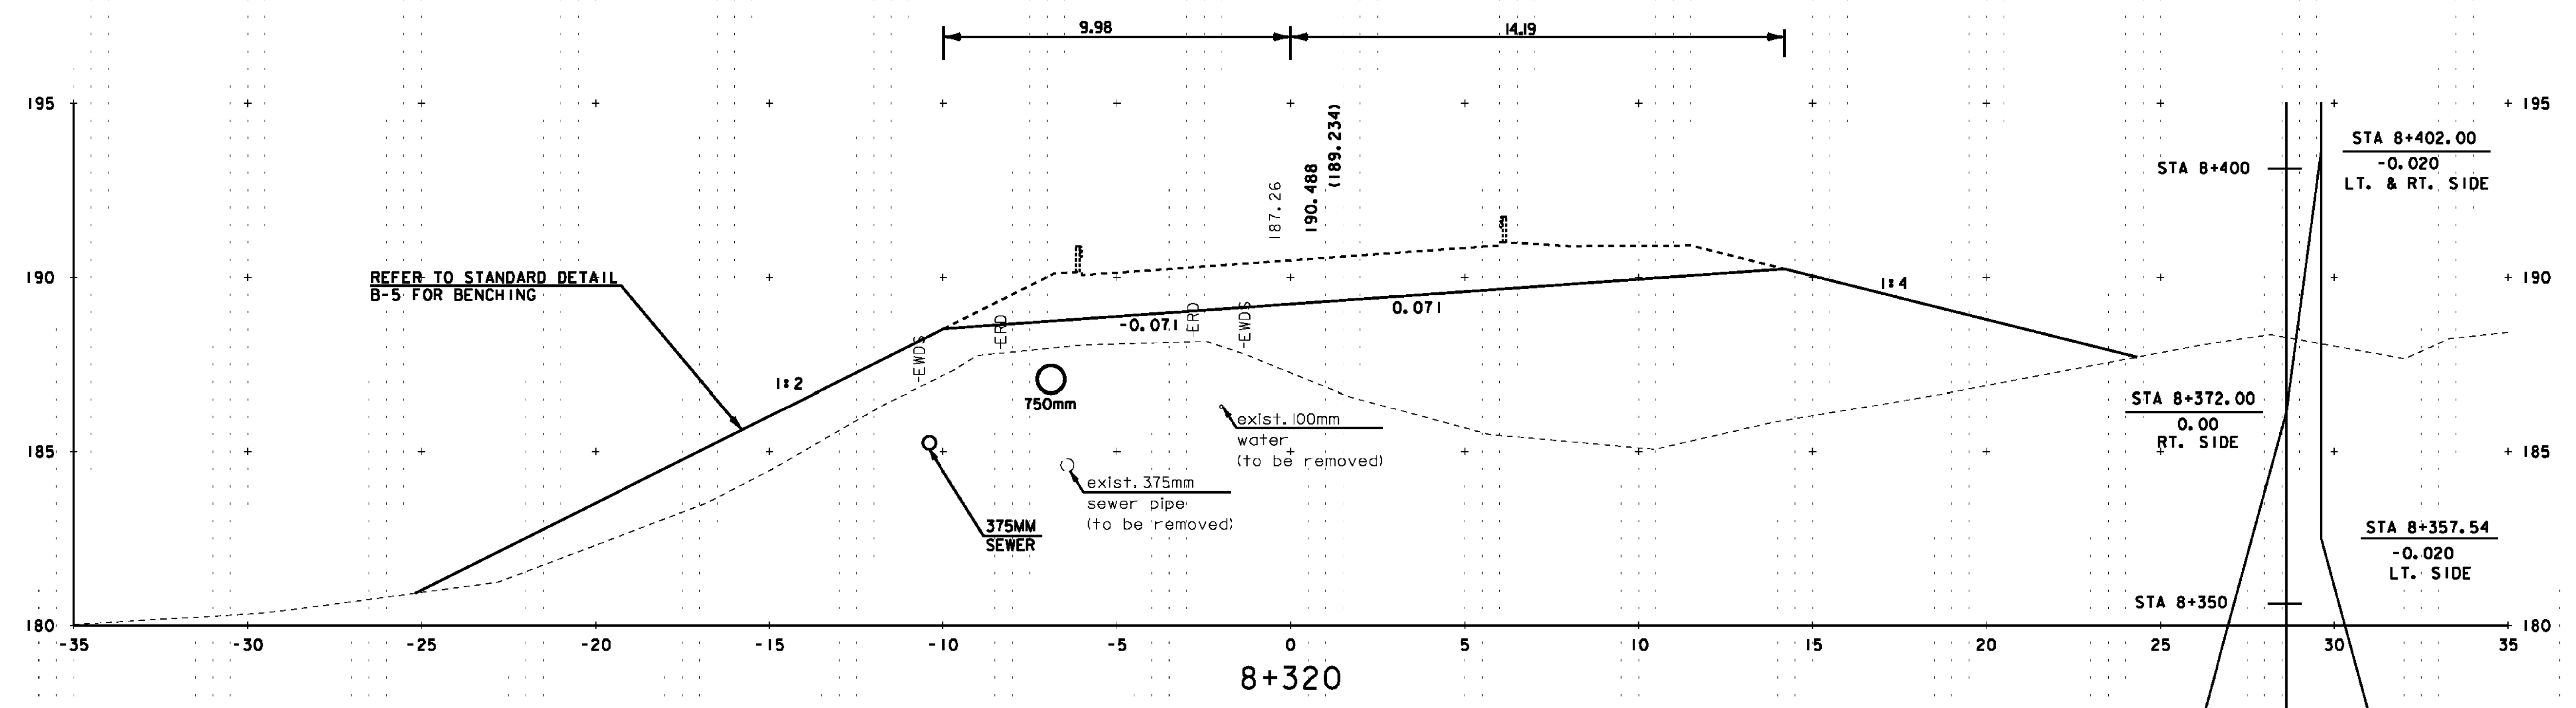

PROJECT NAME:	MORRISTOWN	PLOT DATE:	30-MAR-2012
PROJECT NUMBER:	STP F 029-(12)C/1	DRAWN BY:	MAL
FILE NAME:	z10b194xs.dgn	CHECKED BY:	DMB
PROJECT LEADER:	DMB	ROADWAY CROSS SECTIONS:	8+300 TO 8+320
DESIGNED BY:	BRC	SHEET	117 OF 123

NOTE: ALL DIMENSIONS IN METERS (M) EXCEPT WHERE NOTED.

