


LEGEND

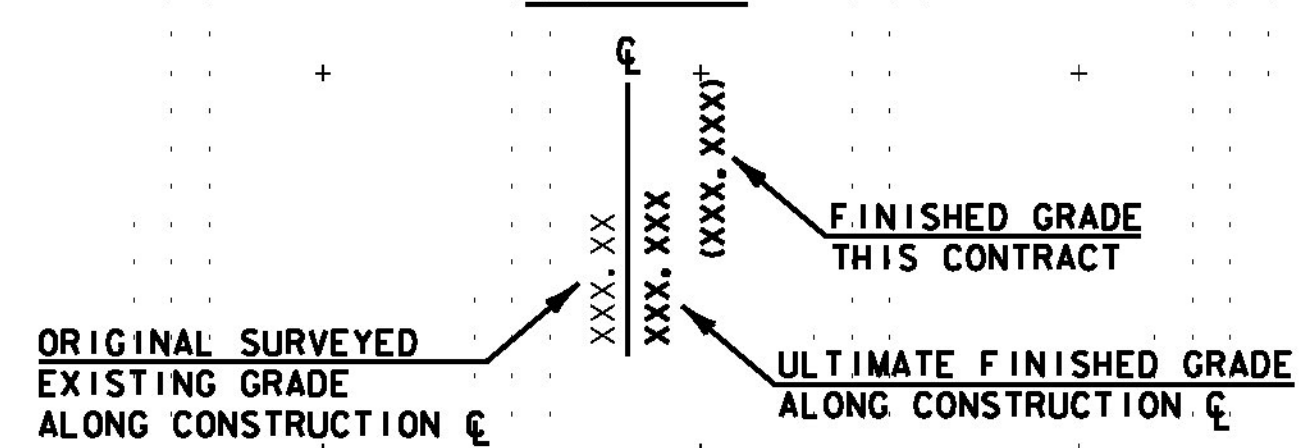

NOTE: ALL DIMENSIONS IN METERS (M) EXCEPT WHERE NOTED.



| | |
|-------------------------|-------------------|
| PROJECT NAME: | MORRISTOWN |
| PROJECT NUMBER: | STP F 029-1(2)C/1 |
| FILE NAME: | z10b194xs.dgn |
| PROJECT LEADER: | DMB |
| DESIGNED BY: | BRC |
| ROADWAY CROSS SECTIONS: | 8+340 TO 8+360 |
| PLOT DATE: | 30-MAR-2012 |
| DRAWN BY: | MAL |
| CHECKED BY: | DMB |
| SHEET | 118 OF 123 |