


I+015

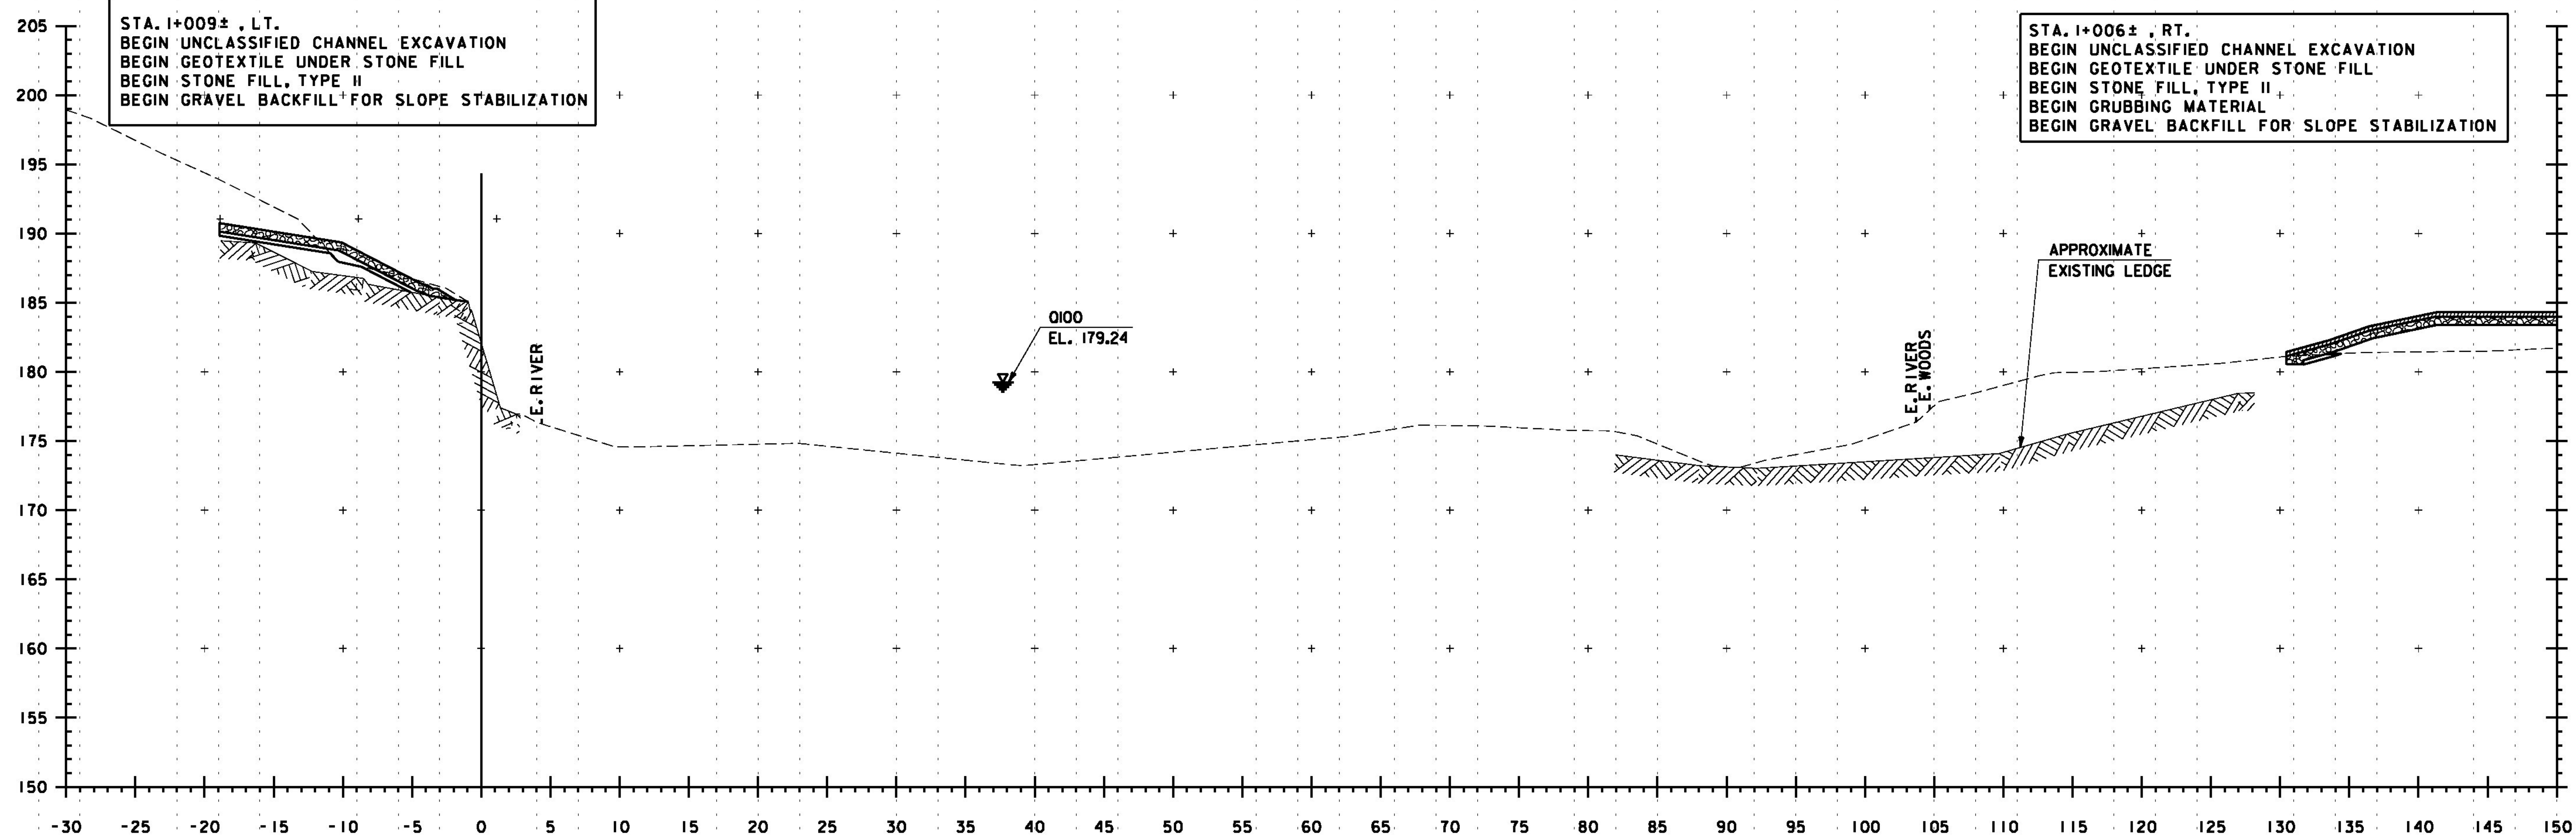

STA. I+009±, LT.
 BEGIN UNCLASSIFIED CHANNEL EXCAVATION
 BEGIN GEOTEXTILE UNDER STONE FILL
 BEGIN STONE FILL, TYPE II
 BEGIN GRAVEL BACKFILL FOR SLOPE STABILIZATION


STA. I+006±, RT.
 BEGIN UNCLASSIFIED CHANNEL EXCAVATION
 BEGIN GEOTEXTILE UNDER STONE FILL
 BEGIN STONE FILL, TYPE II
 BEGIN GRUBBING MATERIAL
 BEGIN GRAVEL BACKFILL FOR SLOPE STABILIZATION

I+010

NOTE: ALL DIMENSIONS IN METERS (M) EXCEPT WHERE NOTED.

NOTES

1. FOR GRADING AROUND BRIDGE, SEE GRADING PLAN, SHEET 70.

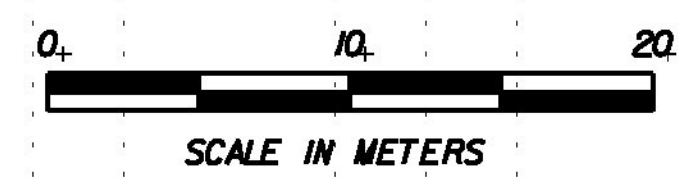

PROJECT NAME:	MORRISTOWN	PLOT DATE:	30-MAR-2012
PROJECT NUMBER:	STP F 029-1(2)C/1	DRAWN BY:	P. Dustin
FILE NAME:	z10b194acs.dgn	CHECKED BY:	R. Joy
PROJECT LEADER:	DMB	SHEET	119 OF 123
DESIGNED BY:	S. Della/B. Colburn	CHANNEL CROSS SECTIONS:	I+010 TO I+015