


I+025

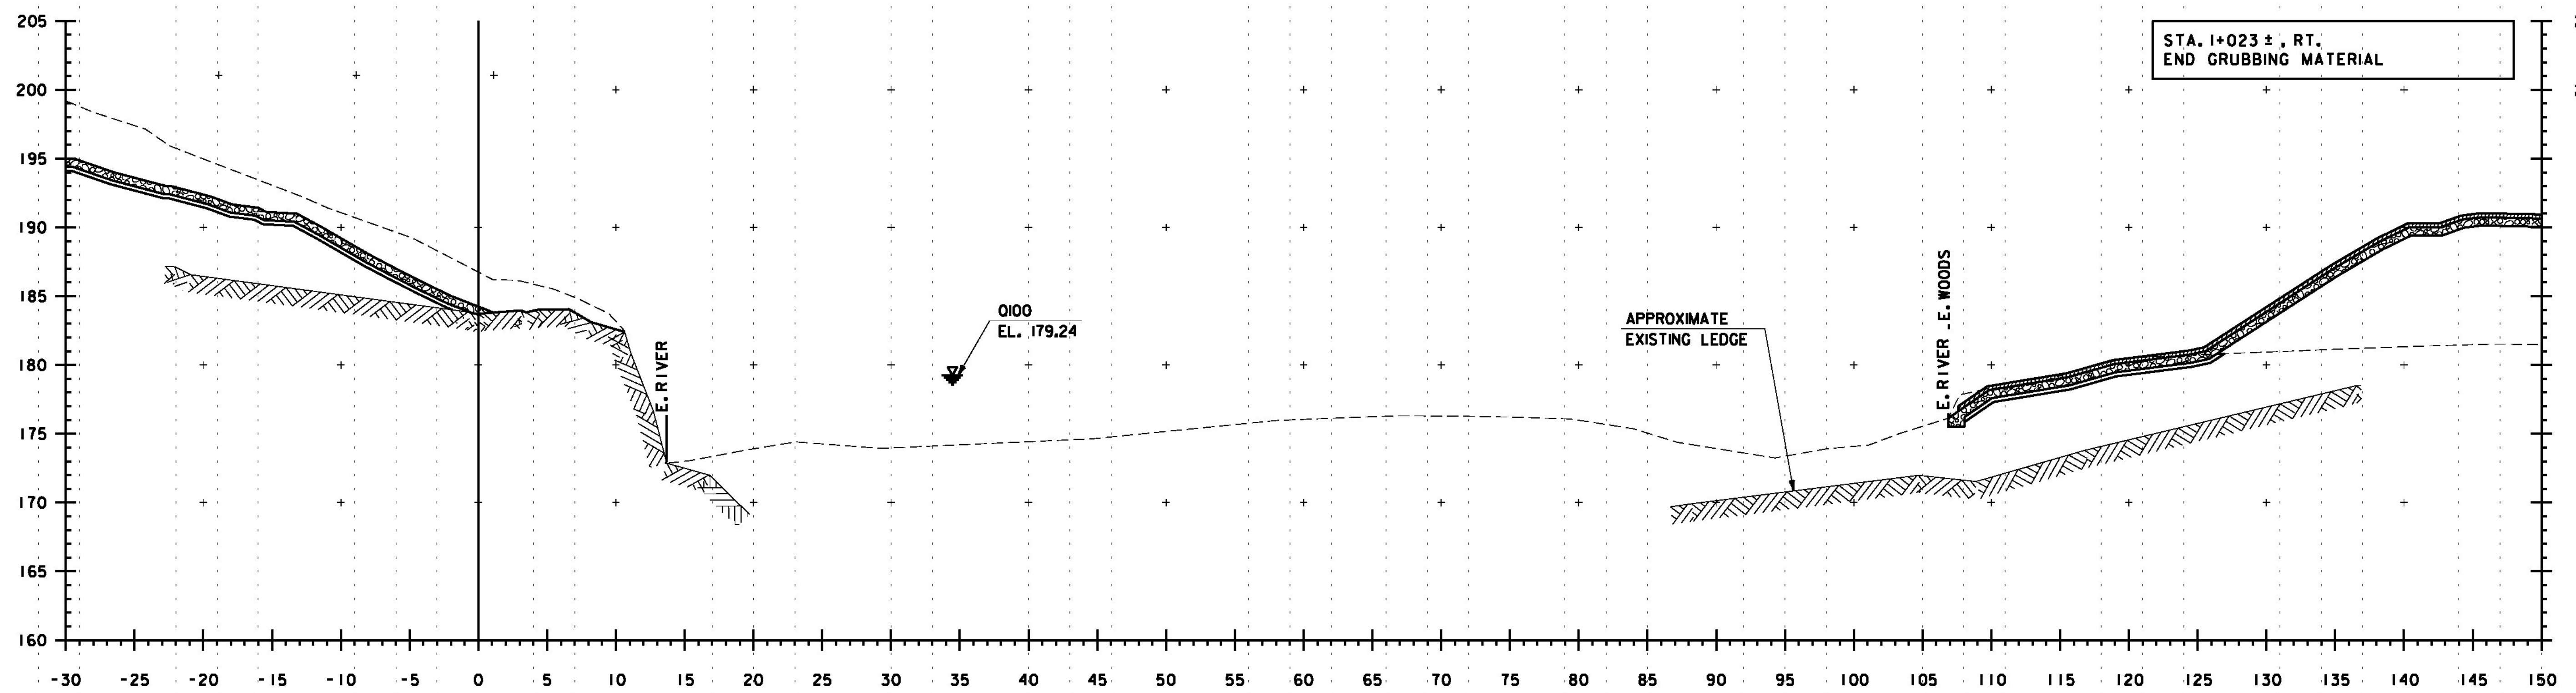


I+020

NOTE: ALL DIMENSIONS IN METERS (M) EXCEPT WHERE NOTED.

**NOTES**

1. FOR GRADING AROUND BRIDGE, SEE GRADING PLAN, SHEET 70.

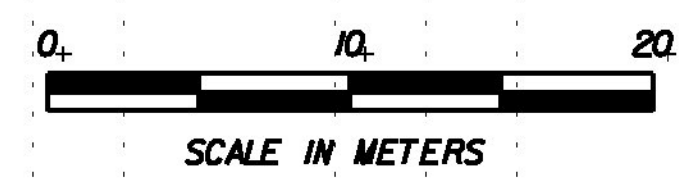

PROJECT NAME:	MORRISTOWN	PLOT DATE:	29-MAR-2012
PROJECT NUMBER:	STP F 029-1(2)C/1	DRAWN BY:	P. Dustin
FILE NAME:	z10b194acs.dgn	CHECKED BY:	R. Joy
PROJECT LEADER:	DMB	SHEET	120 OF 123
DESIGNED BY:	S. Della/B. Colburn		
CHANNEL CROSS SECTIONS:	I+020 TO I+025		