



STA. I+049±, LT.
 END UNCLASSIFIED CHANNEL EXCAVATION
 END GEOTEXTILE UNDER STONE FILL
 END STONE FILL, TYPE II
 END GRUBBING MATERIAL
 END GRAVEL BACKFILL FOR SLOPE STABILIZATION

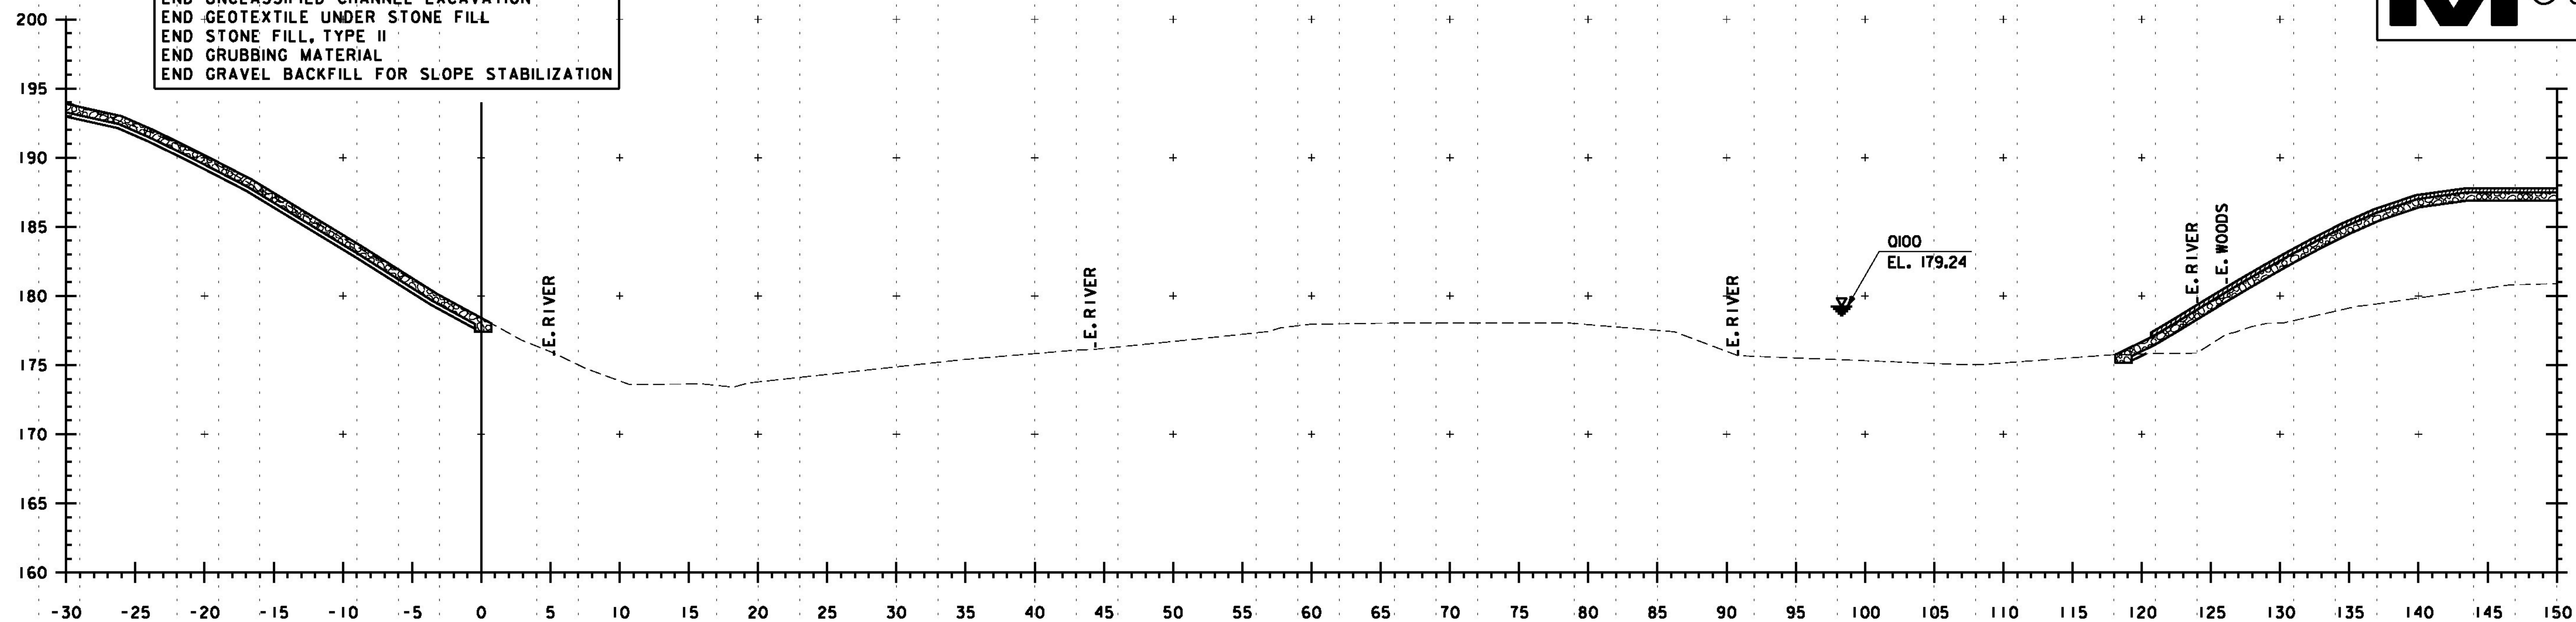

I+045

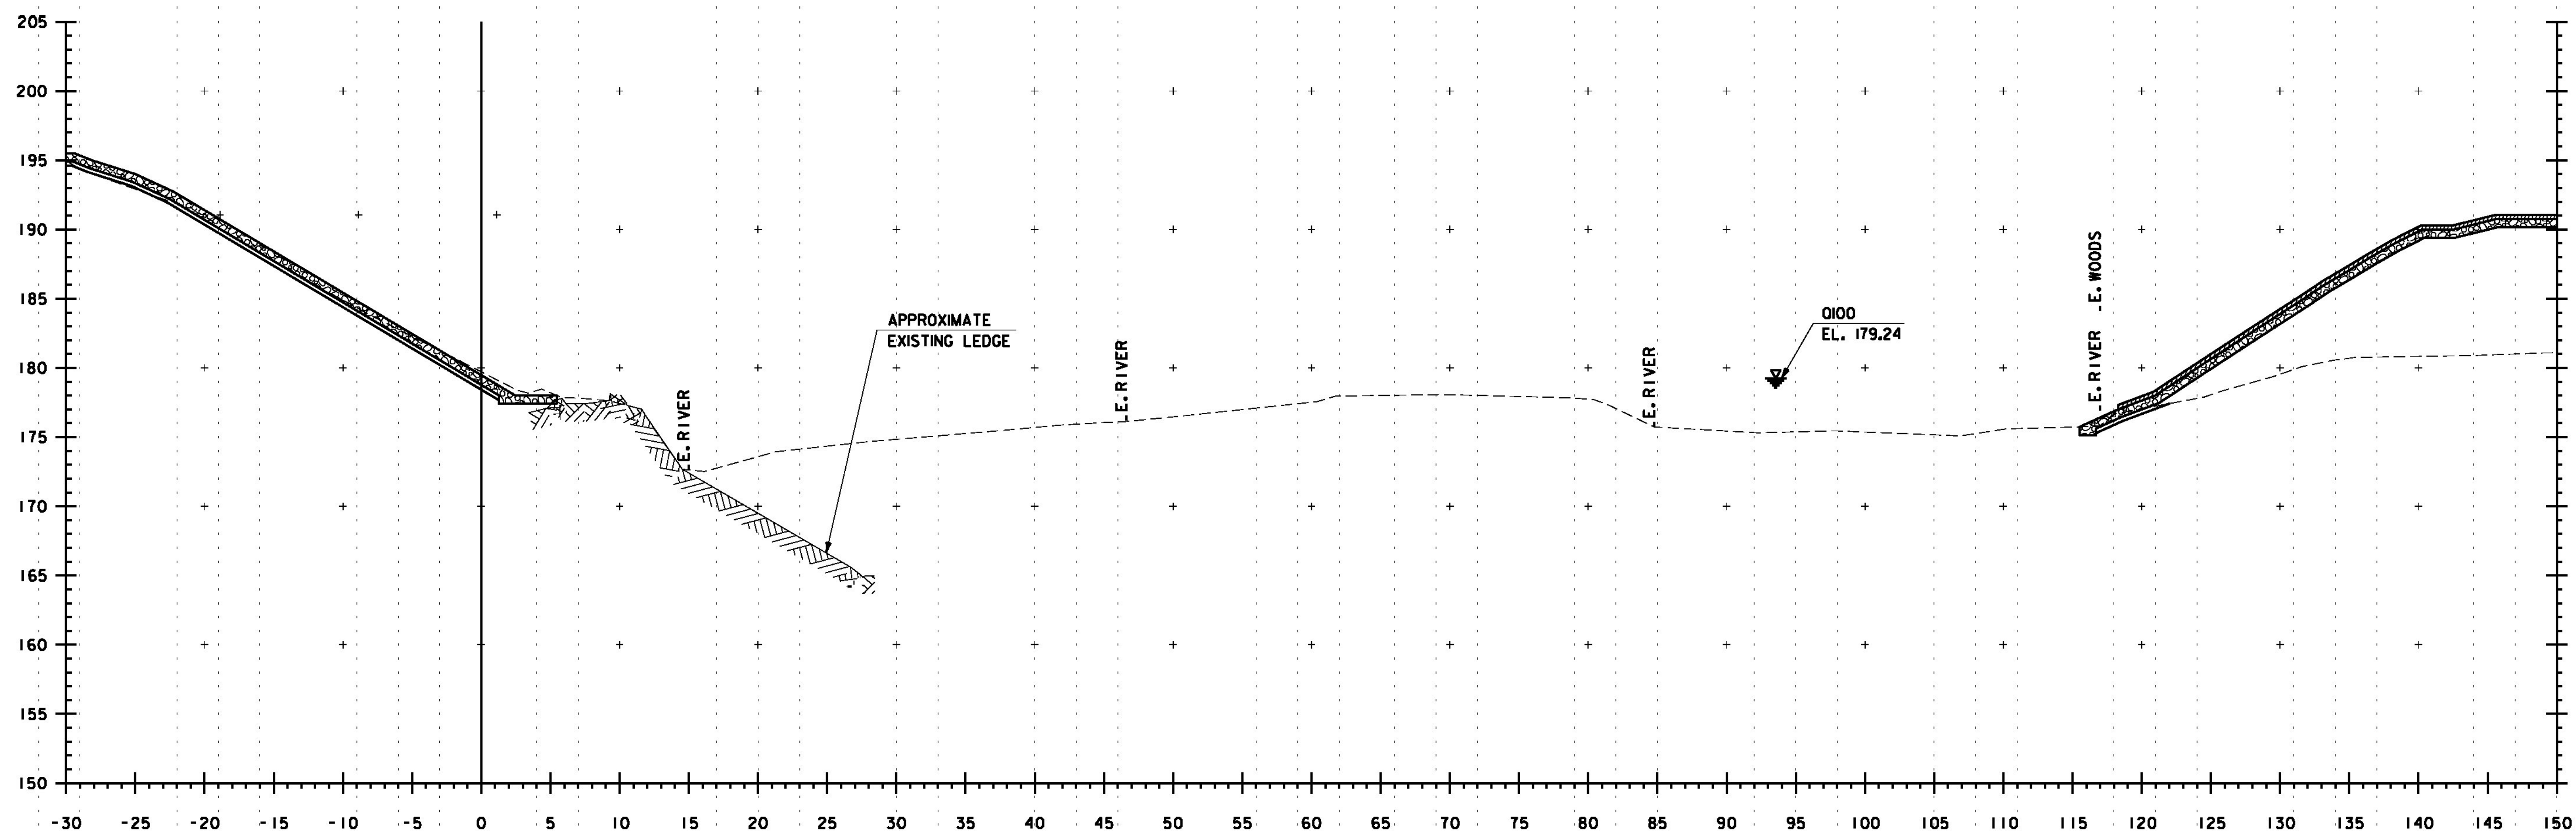

I+040

NOTES

1. FOR GRADING AROUND BRIDGE, SEE GRADING PLAN, SHEET 70.

NOTE: ALL DIMENSIONS IN METERS (M) EXCEPT WHERE NOTED.

PROJECT NAME: MORRISTOWN
 PROJECT NUMBER: STP F 029-1(2)C/1

FILE NAME: z10b194acs.dgn PLOT DATE: 29-MAR-2012
 PROJECT LEADER: DMB DRAWN BY: P. Dustin
 DESIGNED BY: S. Della/B. Colburn CHECKED BY: R. Joy
 CHANNEL CROSS SECTIONS: I+040 TO I+045 SHEET 122 OF 123

