



**WEB ELEVATION**  
SCALE: 1:10

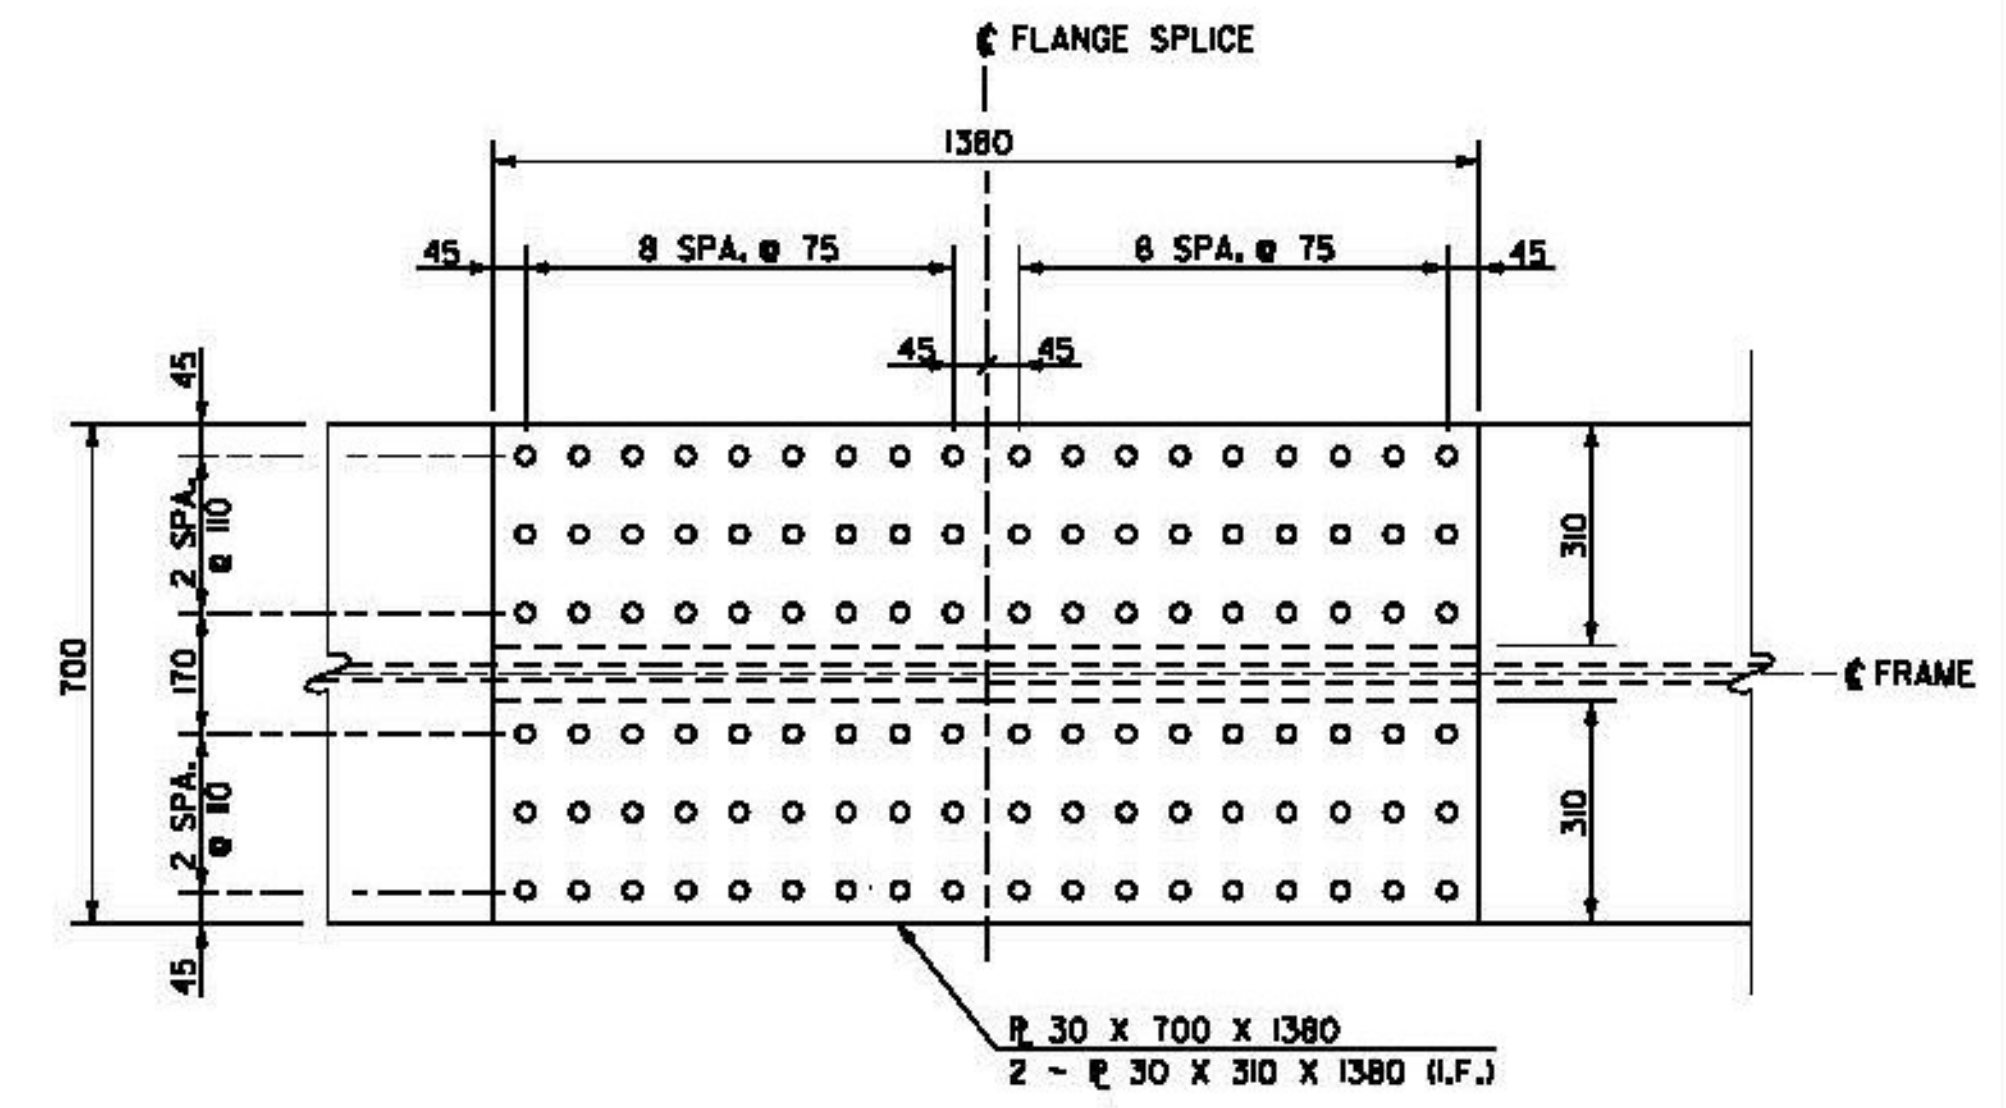


**TOP FLANGE PLAN**  
SCALE: 1:10

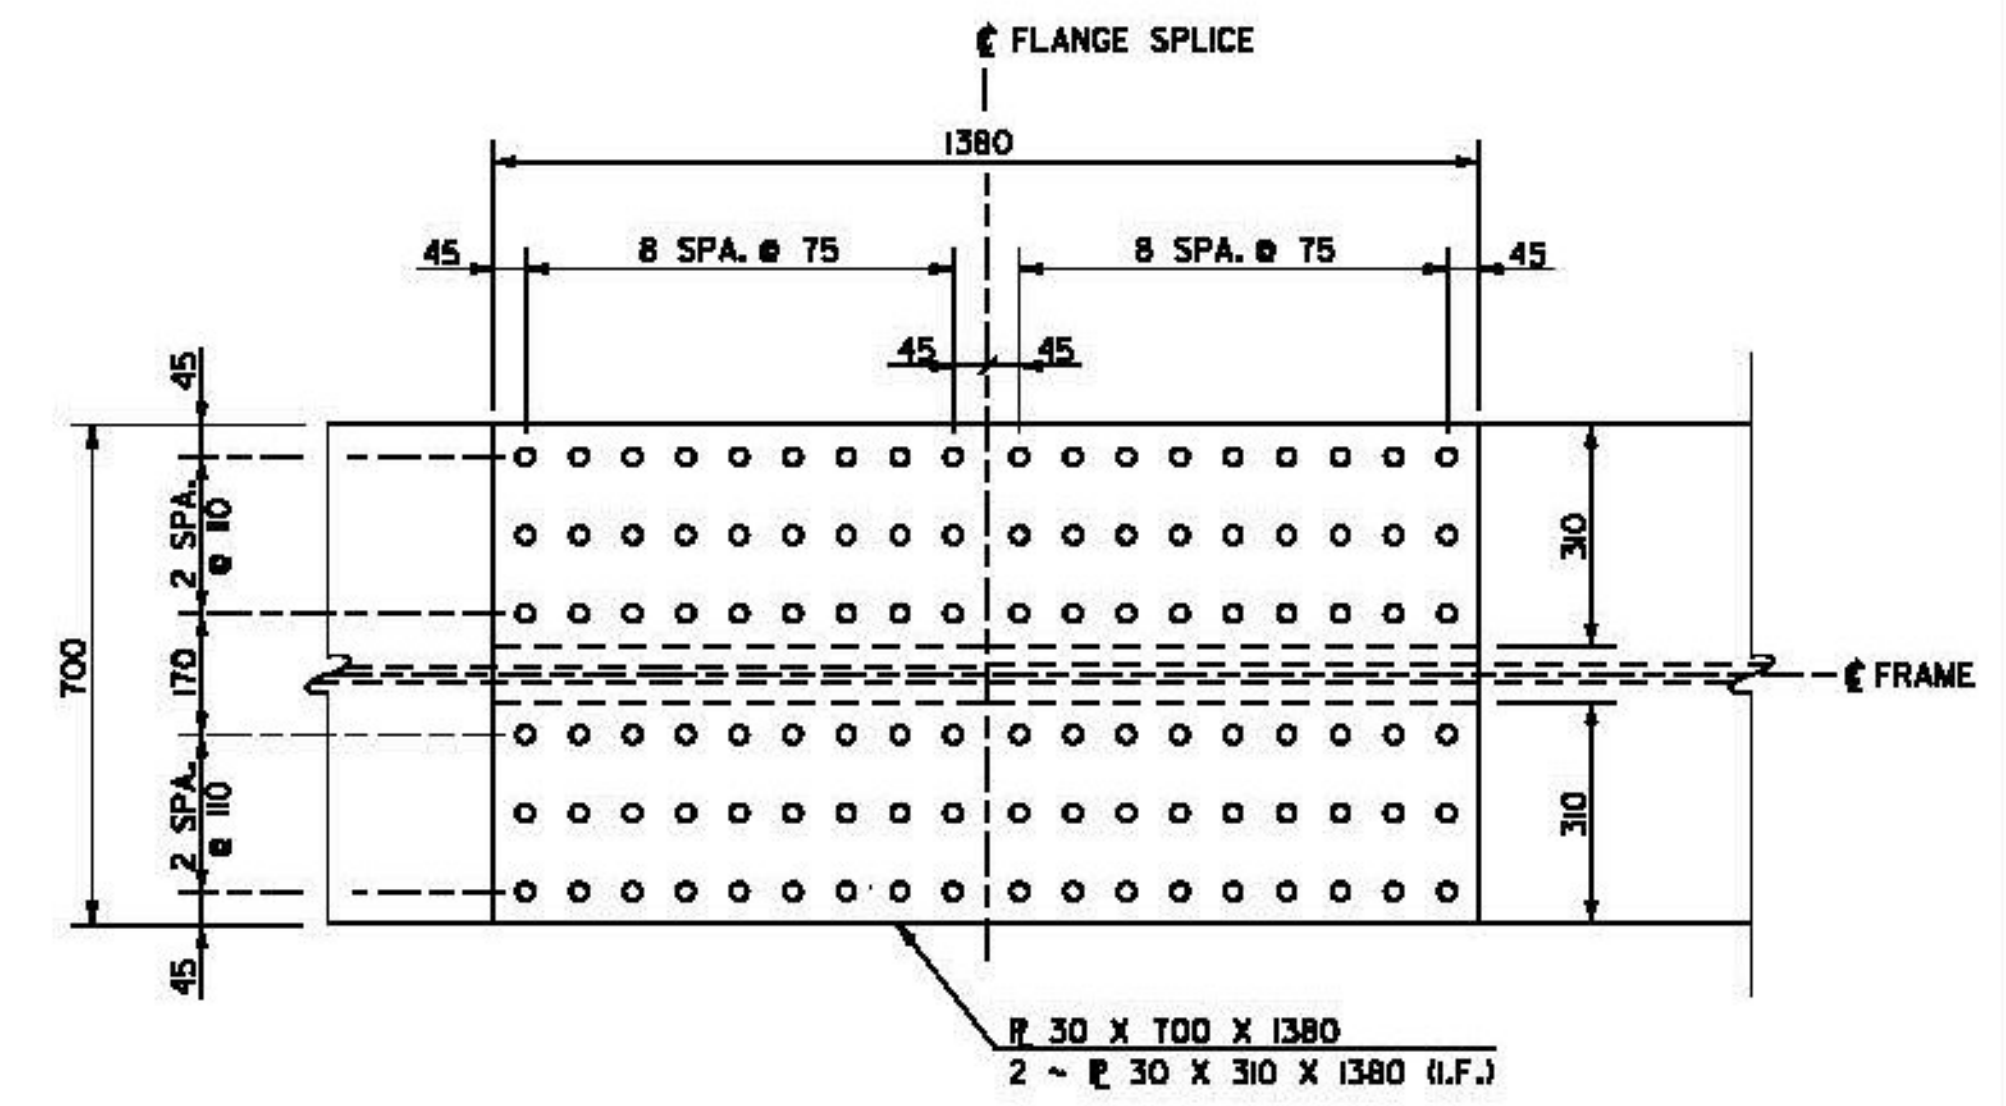

**BOTTOM FLANGE PLAN**  
SCALE: 1:10

**REVISED  
FIELD SPLICE NO. 3**

NOTE: THIS SHEET REPLACES SHEET 79 OF THE CONTRACT PLAN SET. NO OTHER SHEETS HAVE BEEN REVISED TO REFLECT THE REVISED SPLICE 3 DESIGN.

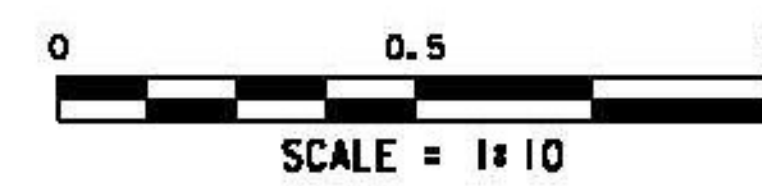

**NOTE**

L FOR FIELD SPLICE NOTES, SEE SHEET 78.  
NOTE: ALL DIMENSIONS IN MILLIMETERS (mm) EXCEPT WHERE NOTED.

PROJECT NAME:	MORRISTOWN	PLOT DATE:	3/13/2013
PROJECT NUMBER:	STP F 029-1(2)C/1	DRAWN BY:	S. Merkwan
FILE NAME:	Rev1_z10b194af.s.dgn	CHECKED BY:	R. Joy
PROJECT LEADER:	DMB	DESIGNED BY:	D. Kull
REVISIONS:	REVISED FIELD SPLICE NO. 3		SHEET 1 OF 1

