


REV.		BILL OF MATERIAL				JOB NO.		DRAWING NO.		REV.
NO.	DATE	QTY	UNIT	MATERIAL	LENGTH	WEIGHT	NO.	NO.	NO.	
1	7G4D	1	WR	GIRDER		2653 kg				
1	G	1	WR	PL 25x127	12 459	5228 kg				
1	J	1	WH	PL 20x2125	14 058	4620 kg				
1	R	1	TL	PL 50x700	13 245	3638 kg				
1	R	1	TL	PL 50x700	13 245	3638 kg				
1	E	1	BL	PL 50x700	5 359	1499 kg				
1	C	1	BL	PL 50x700	9 218	2538 kg				
1	R	1	BL	PL 50x700	13 245	3638 kg				
3	V	2	x3d	PL 13x240	1 530	87 kg				
3	M	2	x3f	PL 13x390	2 125	72 kg				
3	X	4	x3g	PL 13x240	2 125	72 kg				
3	Y	36	x3k	PL 35x325	0 400	39 kg				
6	K	1	x4v	PL 13x790	0 420	31 kg				
6	K	3	x4w	PL 13x790	0 424	32 kg				
6	K	2	x4y	PL 13x790	0 424	32 kg				
8	J	42	7/8" HSB	(HDS-NS)	0 4	47 kg				
8	P	42	7/8" HSB	(HDS-NS)	0 4	47 kg				
8	Q	42	7/8" HSB	(HDS-NS)	0 4	47 kg				

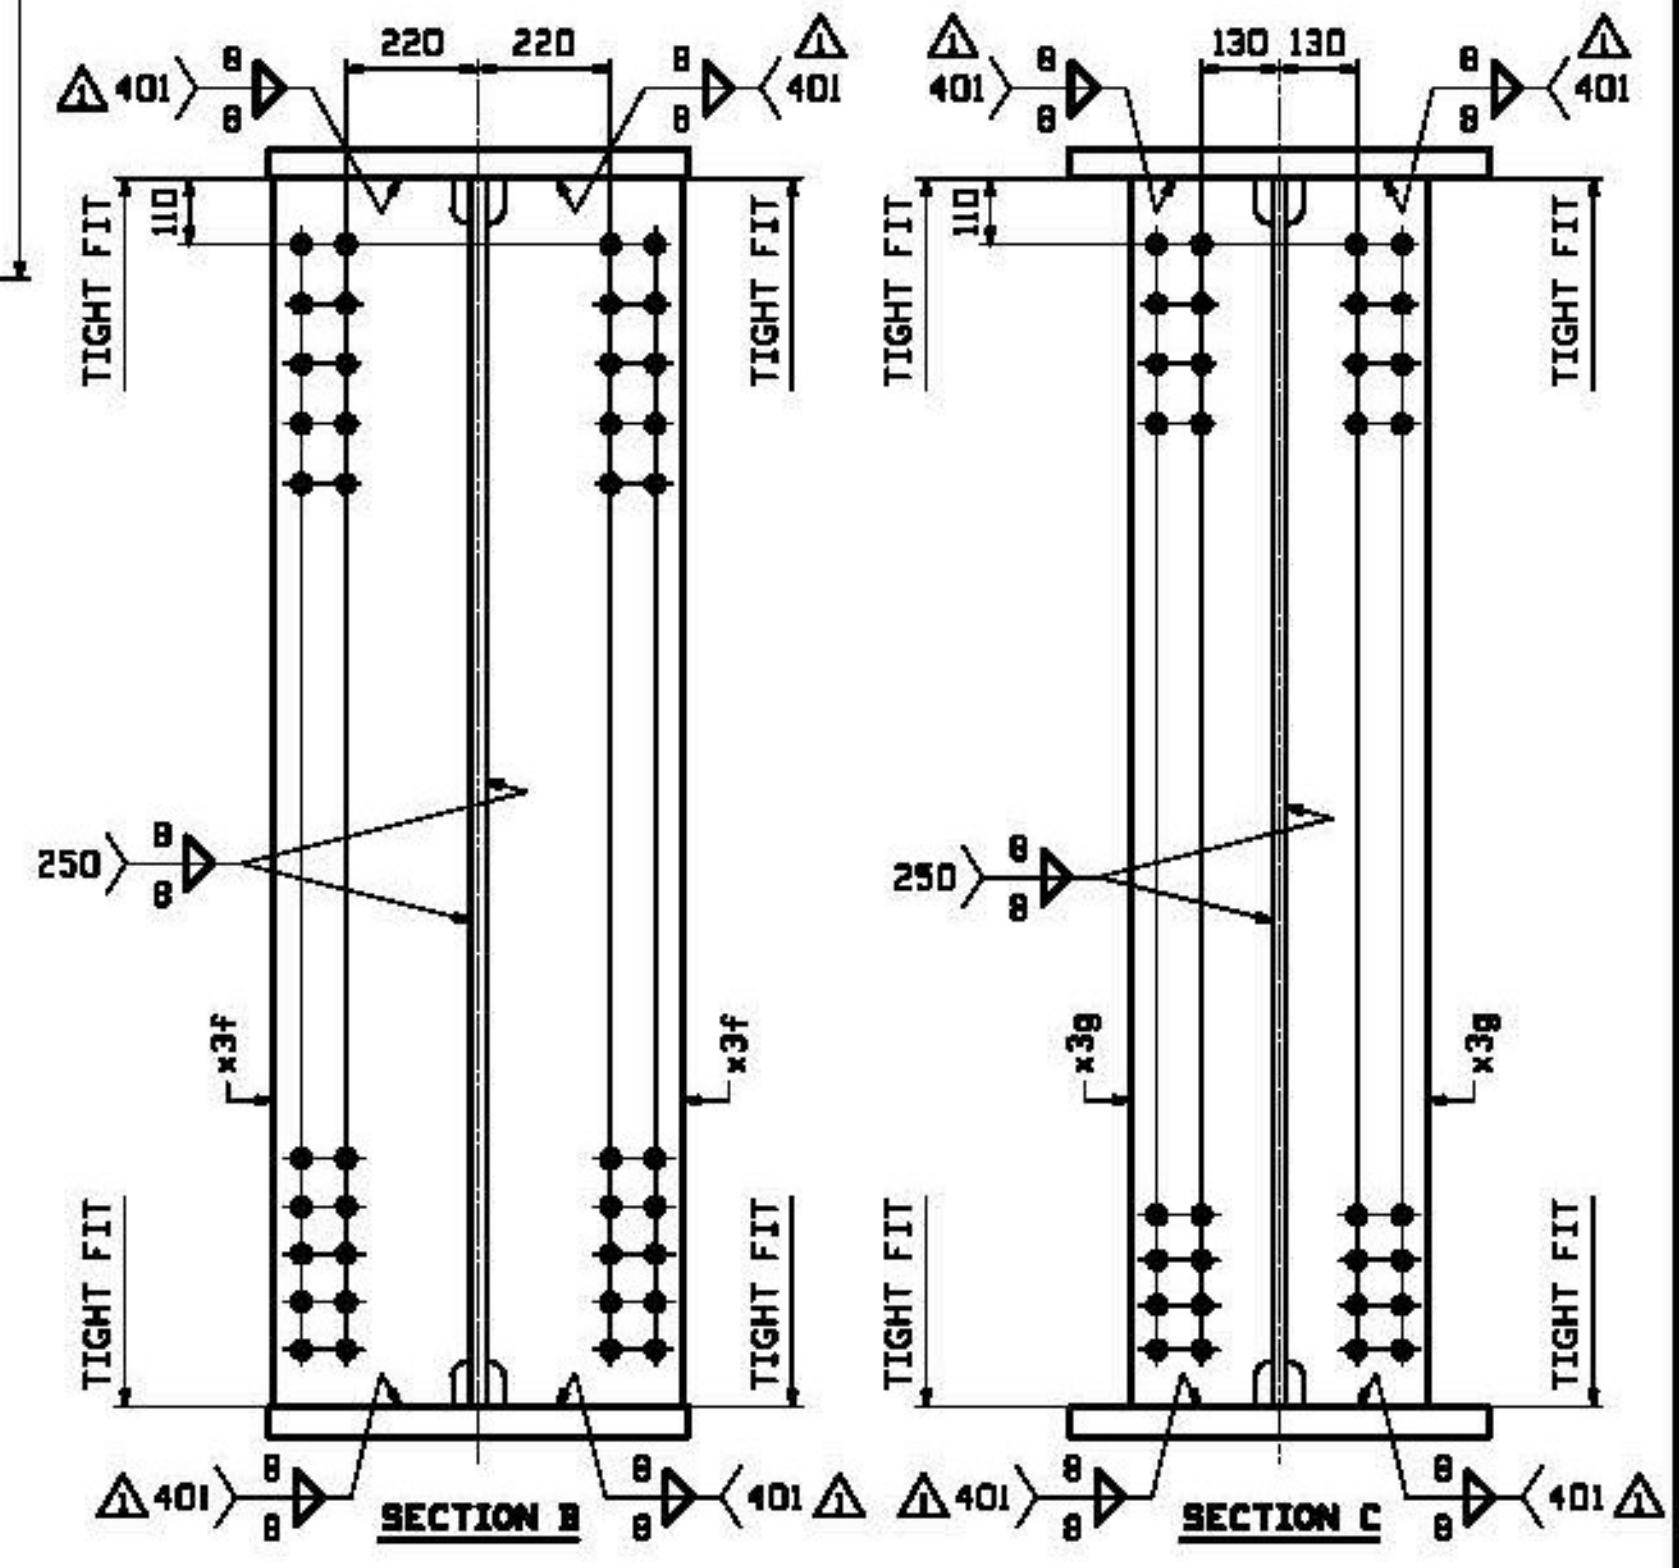

ONE - GIRDER - 7G4D (CONTINUED)
FOR FIELD SPlice DETAILS SEE DRAWINGS XI & X2.
FOR GIRDER STANDARD DETAILS SEE DRAWING X3 & X4.
FOR CAMBER & FLANGE DIAGRAMS SEE DRAWING C2.
FOR GENERAL NOTES SEE DRAWING GNI.
T2 DENOTES MATERIAL SUBJECT TO CHARPY V-NOTCH TESTING.

Reviewed _____ x Furnish As Corrected _____
Rejected _____ Revise and Resubmit _____

This review is only for general conformance with the design concept and the information given in the Construction Documents. Corrections or comments made on the shop drawings during the review do not relieve the Contractor from compliance with the requirements of the Plans and Specifications. Review of a specific item shall not include review of an assembly of which an item is a component. The Contractor is responsible for dimensions to be confirmed and corrected at the job site; information that pertains solely to the fabrication process or to the means, methods, techniques, sequences and procedures of construction; coordination of the Work with that of other trades and performing all Work in a safe and satisfactory manner.

Date: March 27, 2013
By: D. Kull

McFarland Johnson

WORK THIS SHEET WITH SHEETS 7AB, 7C & 7D

REV.	DATE	REMARKS	DMN	CHK	APVL	SHOP
3/21/13		MOVED GIRDER 7G2B TO SHEETS 7C & 7D	EEO	PCP		
12/19		APPROVAL COMMENTS	EEO	PCP		

MATERIAL:	SURFACE PREP. & PAINT:	HOLES:	SHOP BOLTS:
M270M-345M U.N.	SEE GNI	15/16"	AS NOTED

DESCRIPTION:	GIRDER DETAIL - 7G4D
CASCO BAY STEEL STRUCTURES, INC.	
1 WALLACE AVE.	PHONE (207) 780-6722
SOUTH PORTLAND, ME 04106	FAX: (207) 780-6726
STRUCTURE:	VT 100 OVER LAHOILLE RIVER
	MORRISTOWN, VT LAHOILLE COUNTY
	STP F 029-1 (2) C/1
LOCATION:	MORRISTOWN, VT
PROJ. NO.	STP F 029-1(2)C/1
CUSTOMER:	MINTERTSET, INC.
DRAWN:	EEO
DATE:	08/24
CHKD:	PCP
DATE:	09/17
JOB NO.	521
DWG NO.	7B
REV.	