


SPAN 1 PLAN (BTM OF WEB)

SPAN 2 PLAN (BTM OF WEB)

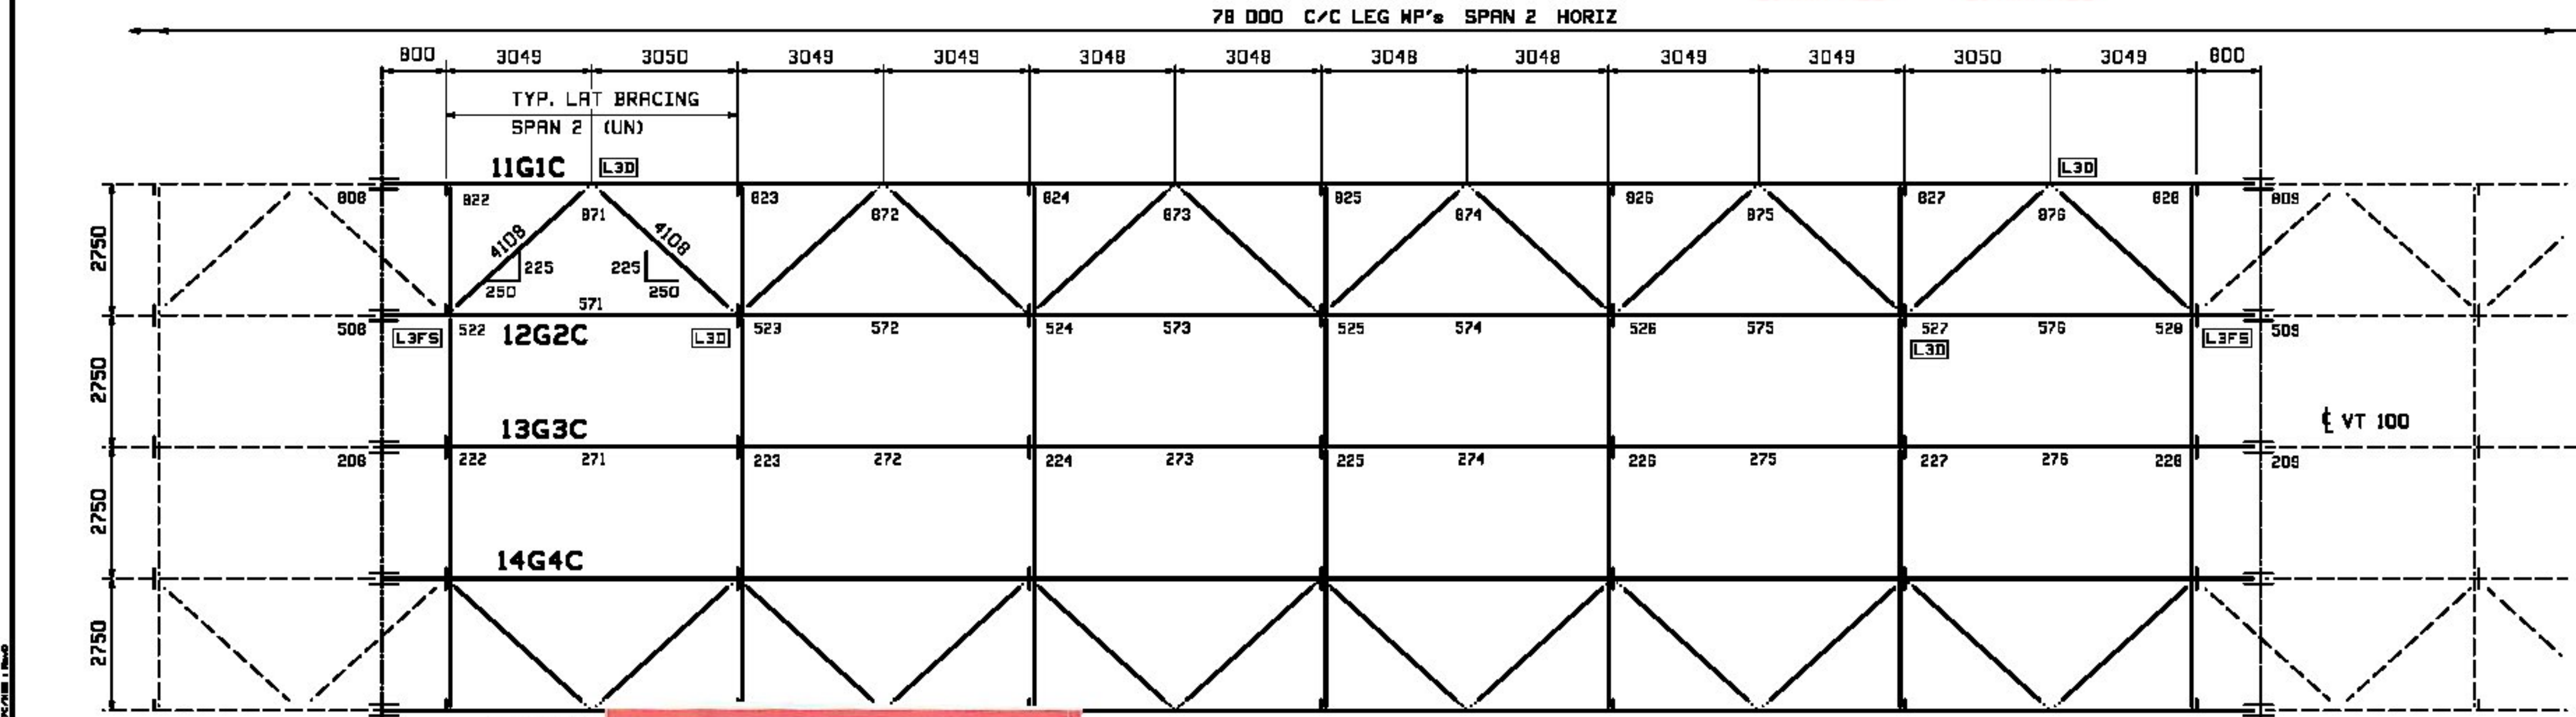

SPAN 2 PLAN (BTM OF WEB)

NOTE #1
 THE PURPOSE OF THIS DRAWING IS TO COORDINATE GEOMETRIC CONTROL INFORMATION. THIS DWG IS SUBMITTED FOR INFORMATION ONLY AND IS NOT INTENDED FOR SHOP FABRICATION.


- NOTES**
1. LONGITUDINAL DIMENSIONS ARE SLOPING ALONG BTM OF WEB WITH CORRECTIONS MADE FOR GEOMETRIC CAMBER, GRADE & DL CAMBER (UN).
 2. TRANSVERSE DIMENSIONS ARE IN A HORIZ. PLANE (UN).
 3. DROP ARROW POINTS TOWARDS LOW END OF MEMBER.
 4. ENDS OF GIRDERS & BRG. STIFF'S ARE VERT. AFTER DL ROTATION.
 5. CP STIFF, INT STIFF & FIELD SPLICES ARE NORMAL TO GRADE.
 6. FOR LAYOUTS SEE "TD" SHEETS.

WORK THIS SHEET WITH SHEETS WS1 - WS4 & WS6

REV.	DATE	REMARKS	DWN	CHK	APVL	SHOP
MATERIAL:		SURFACE PREP. & PAINT:	HOLES:		SHOP BOLTS:	
DESCRIPTION: CALCULATION PLAN ~ SPANS 1 & 2 (BTM OF WEB)						
CASCO BAY STEEL STRUCTURES, INC. 1 WALLACE AVE. PHONE (207) 780-6722 SOUTH PORTLAND, ME 04106 FAX. (207) 780-6726						
STRUCTURE: VT 100 OVER LAHOILLE RIVER MORRISTOWN, VT LAHOILLE COUNTY STP F 028-1 (2) C/1			DRAWN: EEO	DATE: 10/03		
			CHKD: PCP	DATE: 10/03		
LOCATION: MORRISTOWN, VT			JOB NO.:	DWG NO. W55		
PROJ NO. STP F 028-112C/1			521	REV.		
CUSTOMER: MINTERSET, INC.						

VERMONT
 Agency of Transportation
 X Approved
 Furnish as Corrected
 Douglas E. Bonneau, P.E.
 Structures Project Manager
 Rejected
 Revise & Resubmit
 12/10/12
 Date

X Reviewed
 Rejected
 Furnish As Corrected
 Revise and Resubmit
 The reviewer is only for general conformance with the design concept and the information given in the Construction Documents. Comments or omissions made on the shop drawings during the review do not relieve the Contractor from compliance with the requirements of the Plans and Specifications. Review of a specific item shall not include review of an assembly of which an item is a component. The Contractor is responsible for limitations to be confirmed and corrected at the job site and markings that pertain solely to the fabrication process or to the means, methods, techniques, sequences and procedures of construction in coordination of the Work with that of other trades and performing all Work in a safe and satisfactory manner.
 Date: October 24, 2012
 By: D. Hill
 McFarland Johnson

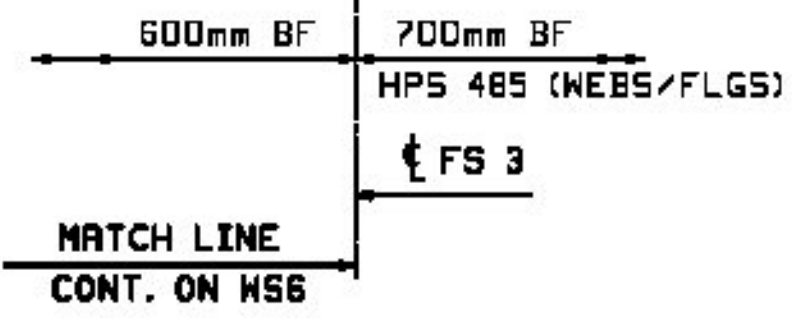

MATCH LINE
 CONT. ON W56

2012 10 24 15:00 11/10/12 11:00 11/10/12 11:00 11/10/12 11:00