




4 - BRG STIFFENERS ~ x3a  
 ABUT 1 & 2 - FRASCIA (TYPE D1)

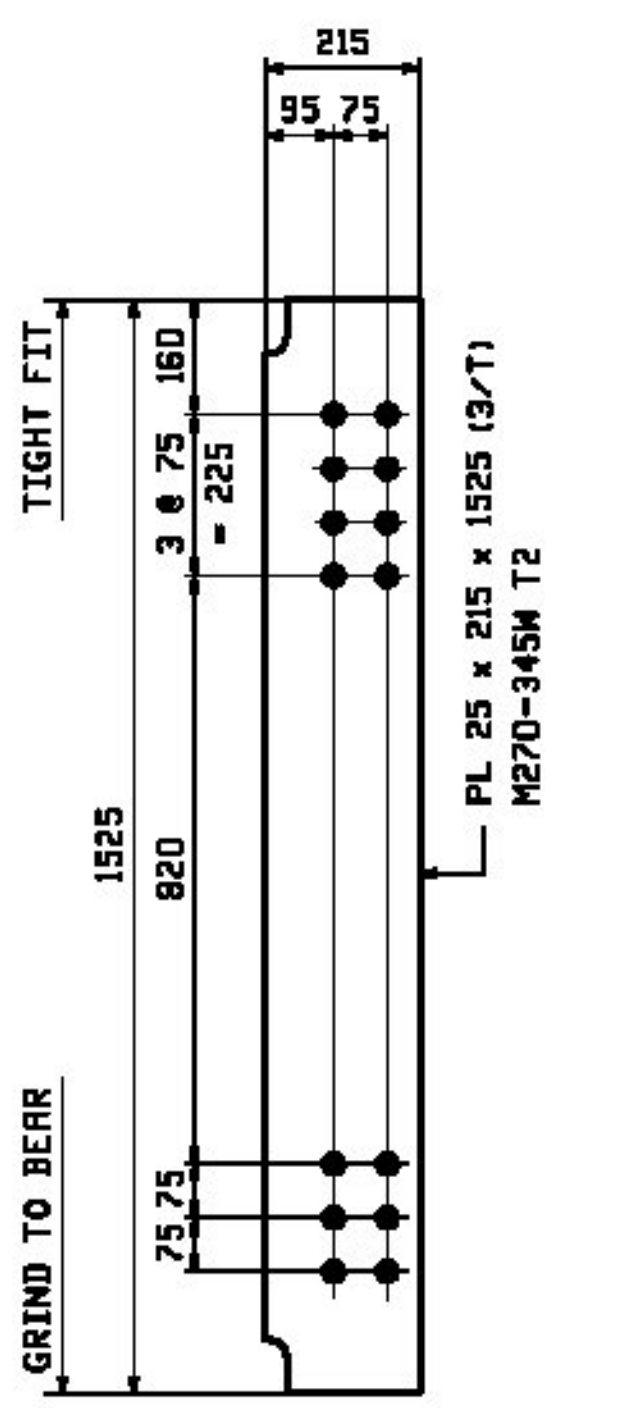


16 - BRG STIFFENERS ~ x3b  
 ABUT 1 & 2 (TYPE D1)

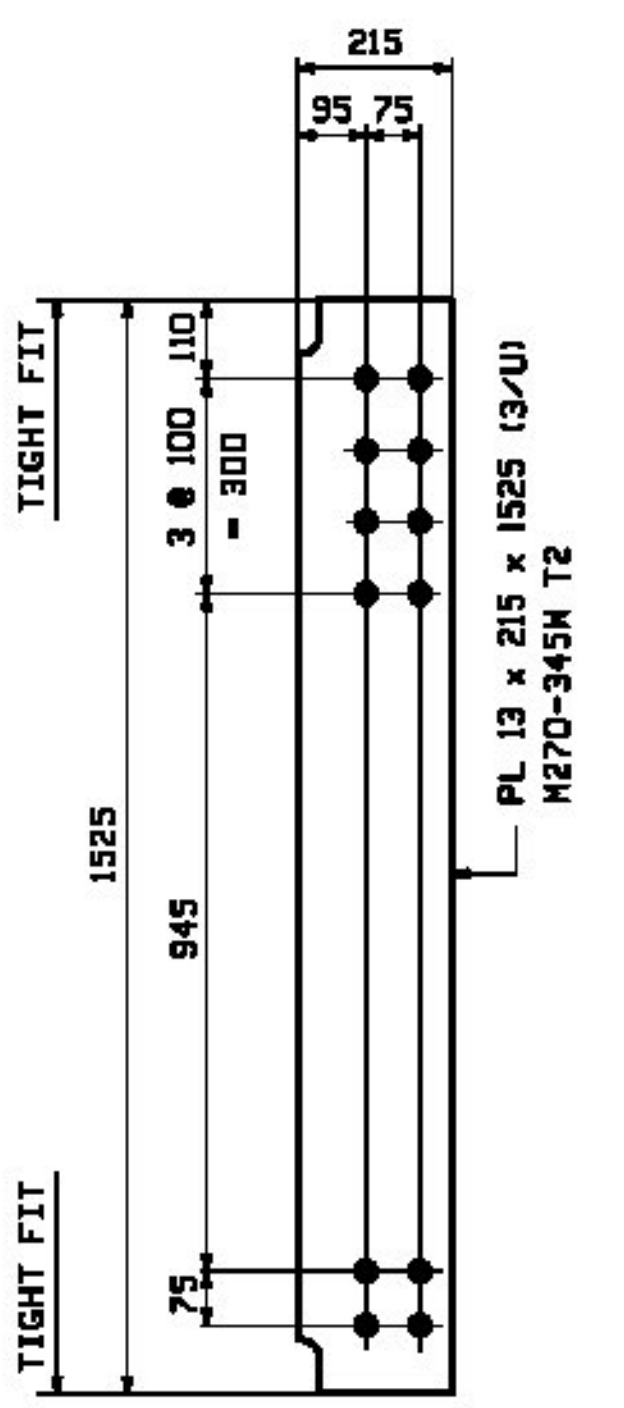

80 - CF CONN STIFF ~ x3c  
 (TYPE D2)

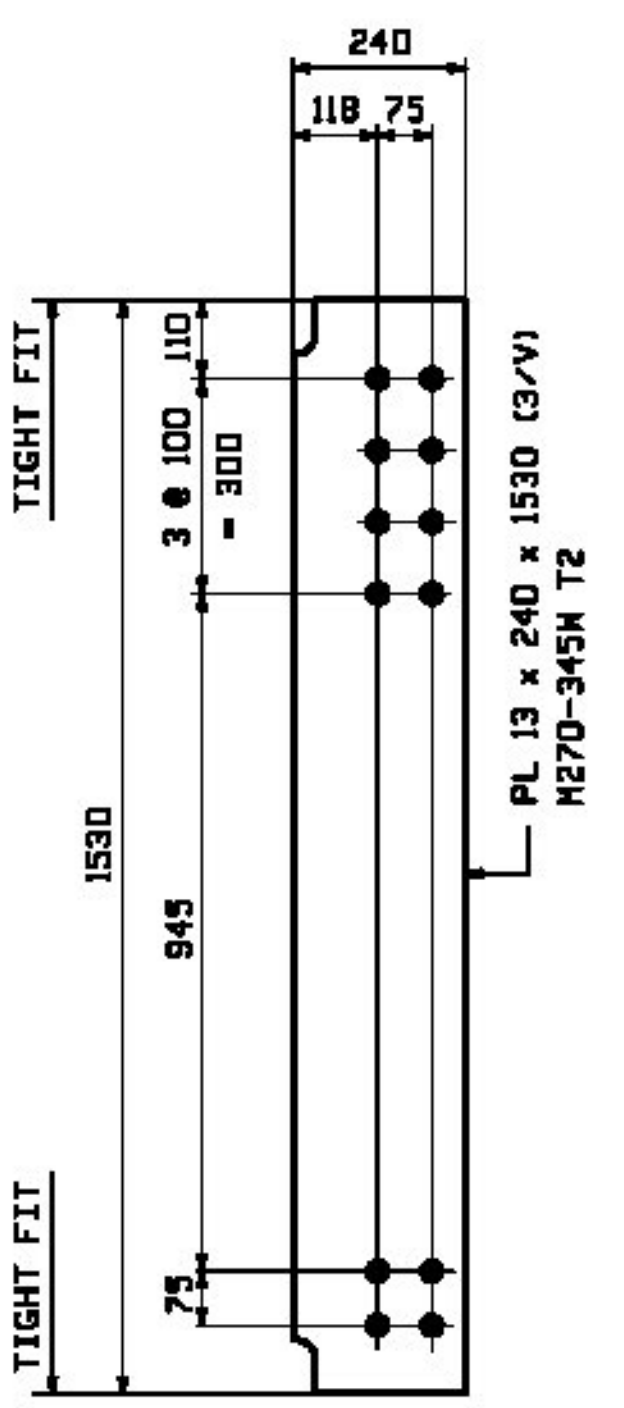


16 - CF CONN STIFF ~ x3d  
 (TYPE D3)

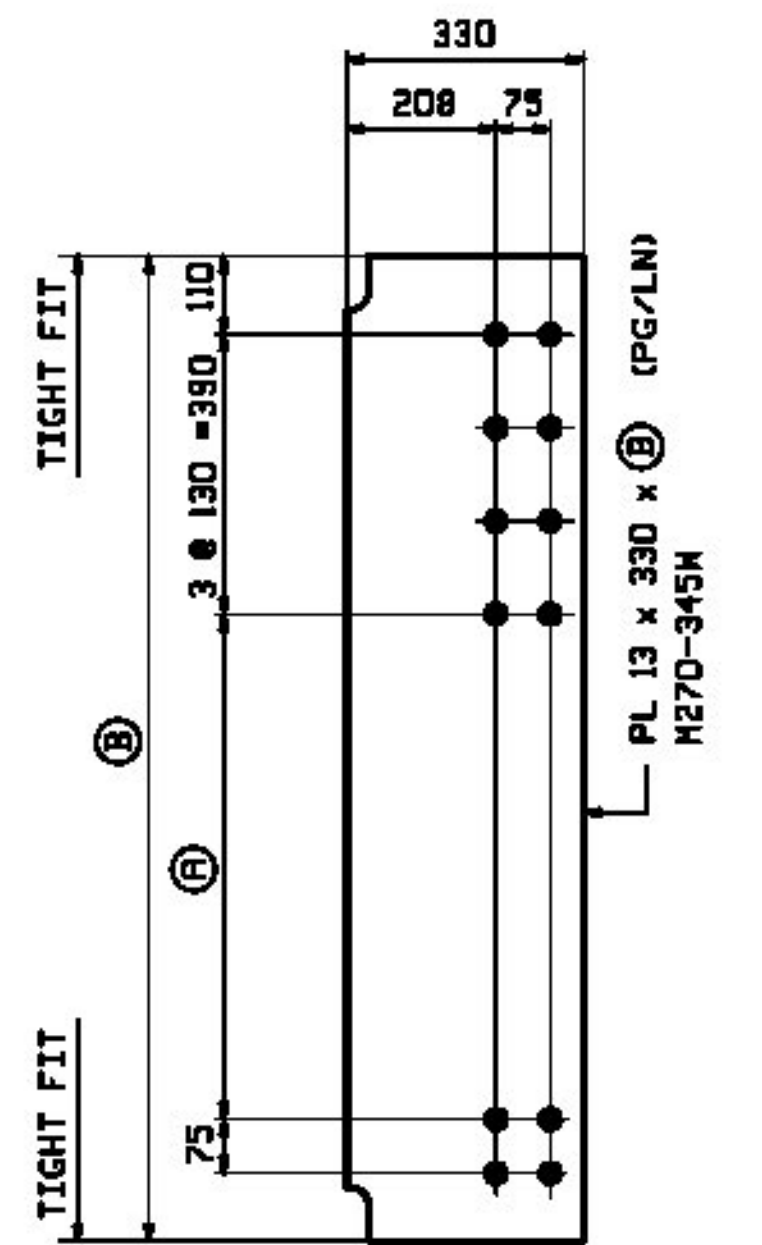


CF CONN STIFF ~ MARK A


MARK A	QTY	Ⓐ	Ⓑ	PG/LN	
x3a	16	928	1598	5/H	TYPE D6A
x3n	16	704	1374	5/J	TYPE D6B
x3p	16	480	1150	5/K	TYPE D6C

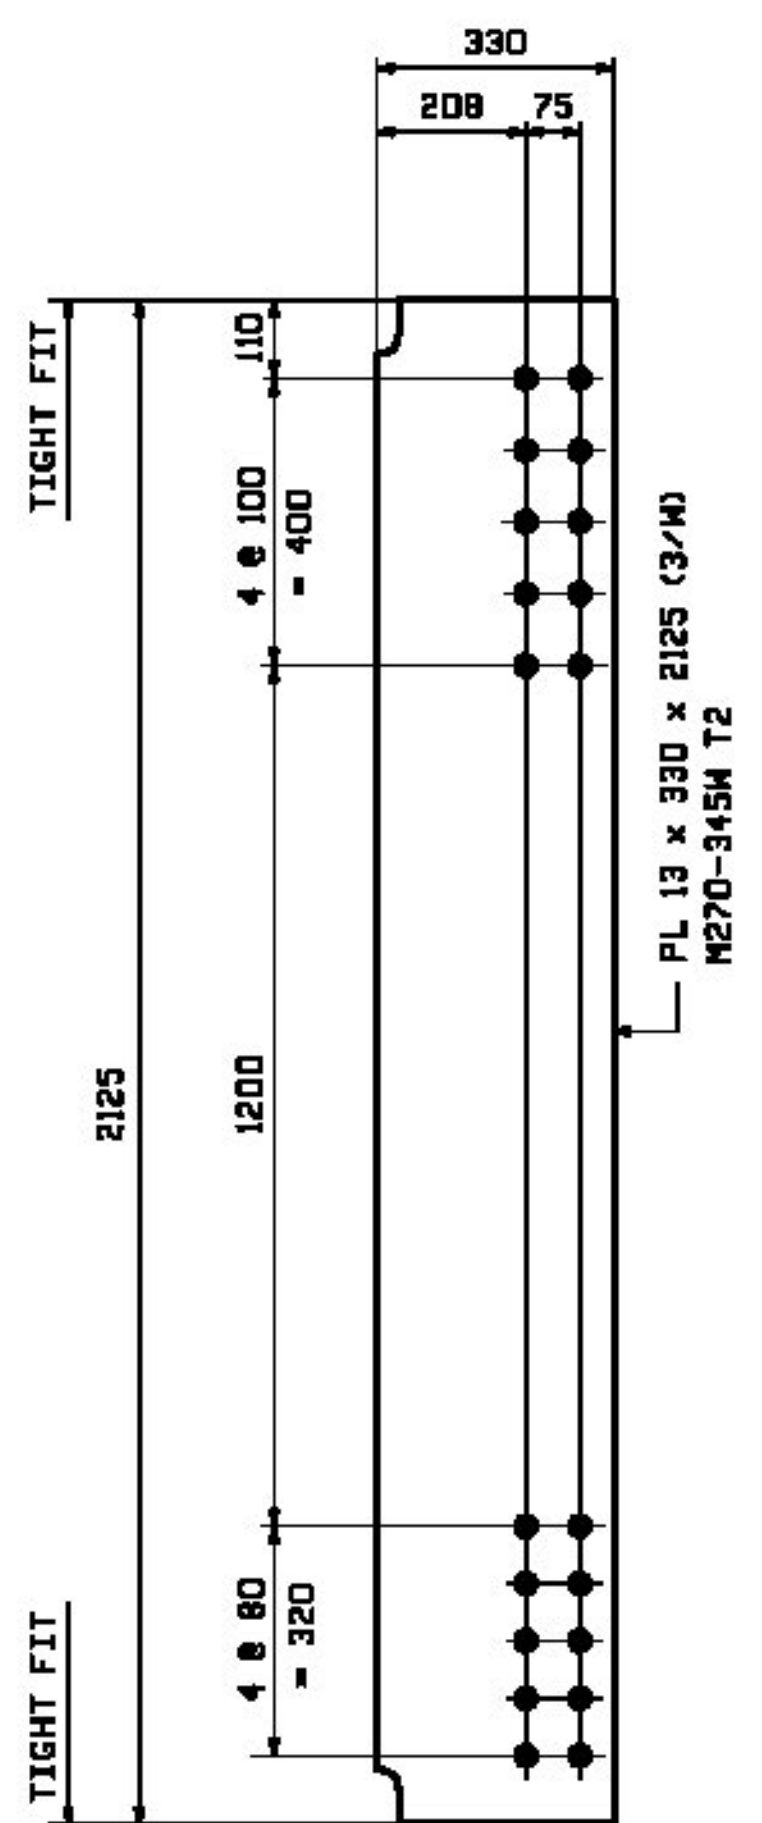


16 - CF CONN STIFF ~ x3f  
 (TYPE D4)

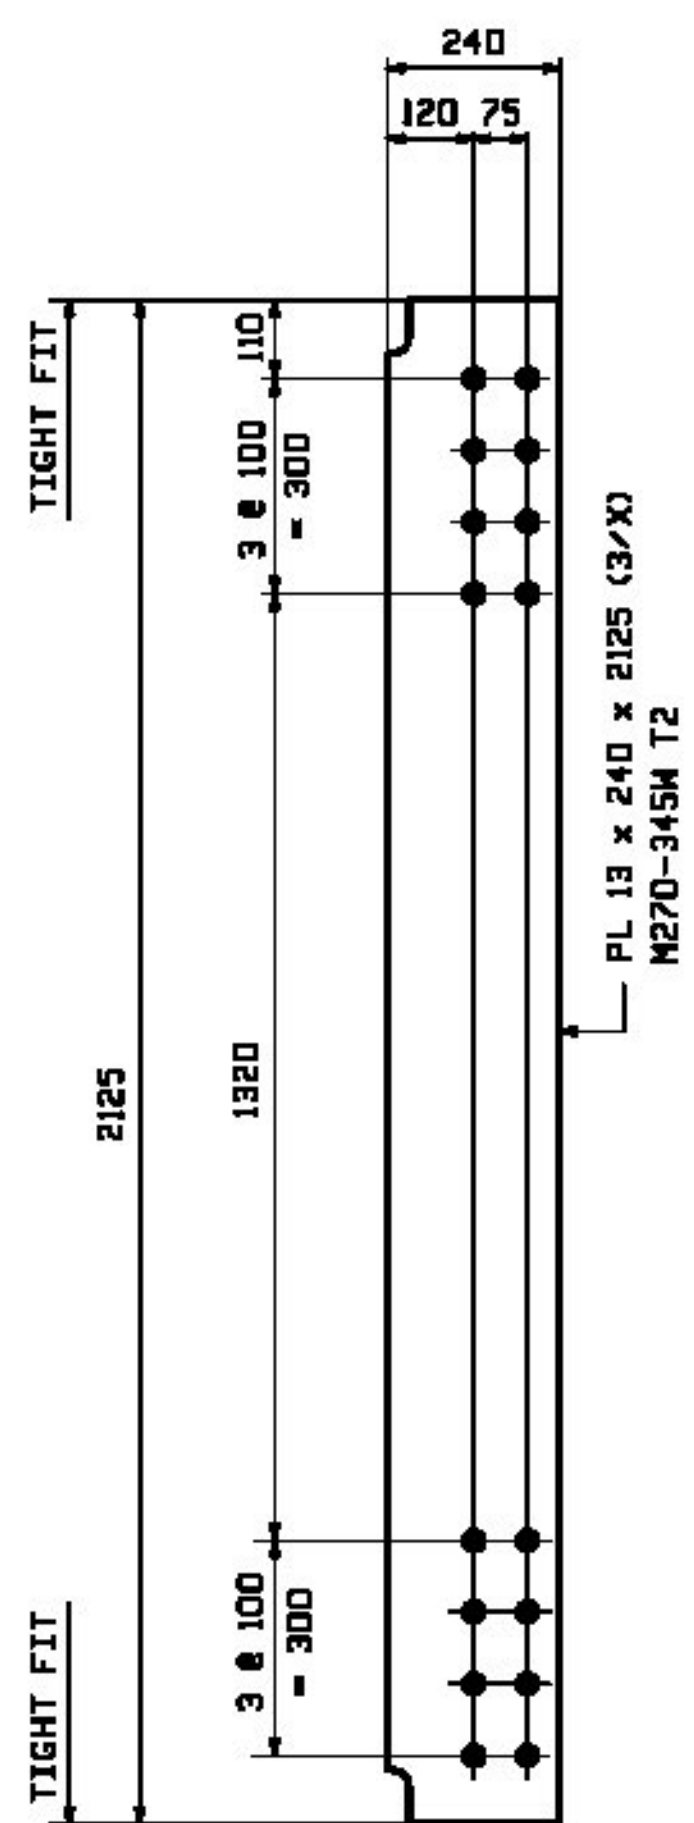


88 - CF CONN STIFF ~ x3g  
 (TYPE D5)

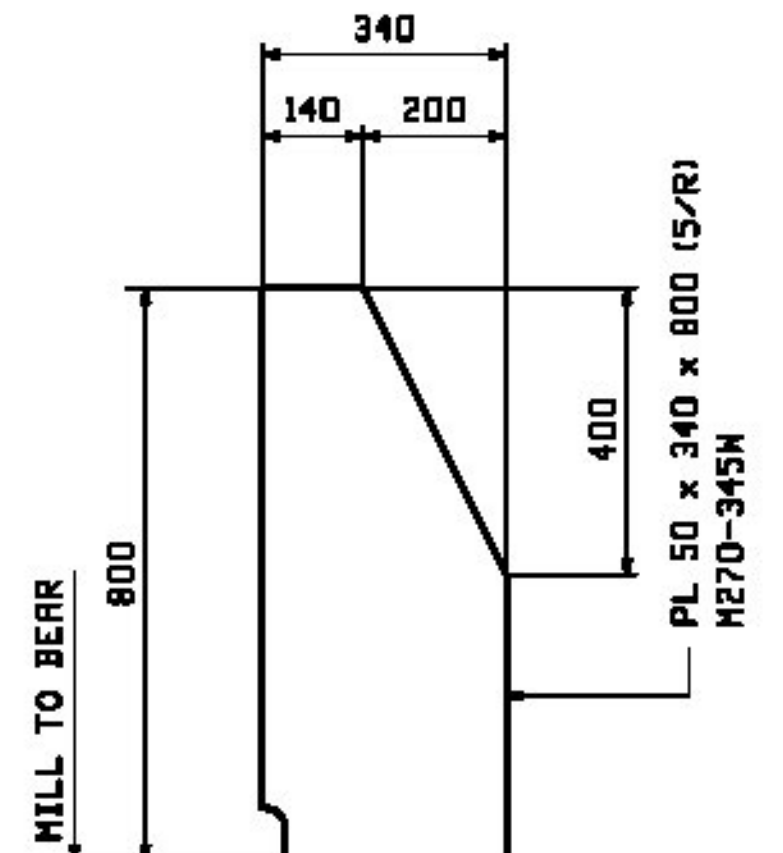


40 - BRG STIFFENERS ~ x3h  
 DELTA LEGS

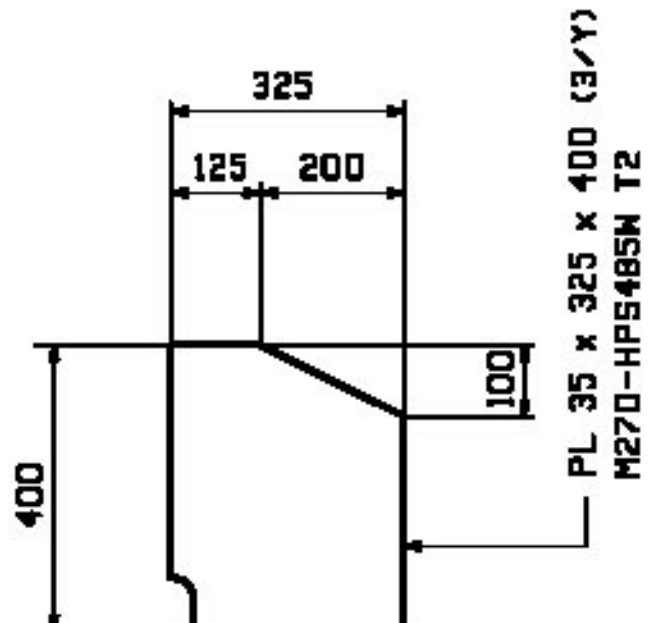

360 - STIFFENERS ~ x3k  
 KNEES

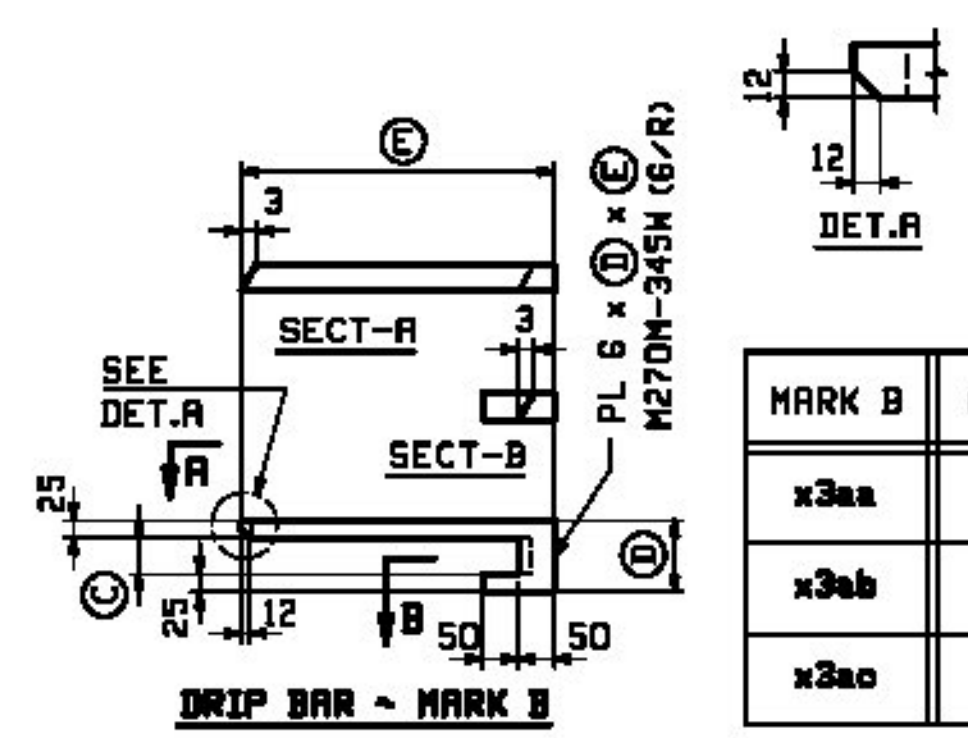

MARK B	QTY	Ⓒ	Ⓓ	Ⓔ	
x3aa	1	50	100	395	50x600 FLG
x3ab	3	50	100	440	50x700 FLG
x3ac	1	35	85	395	35x600 FLG

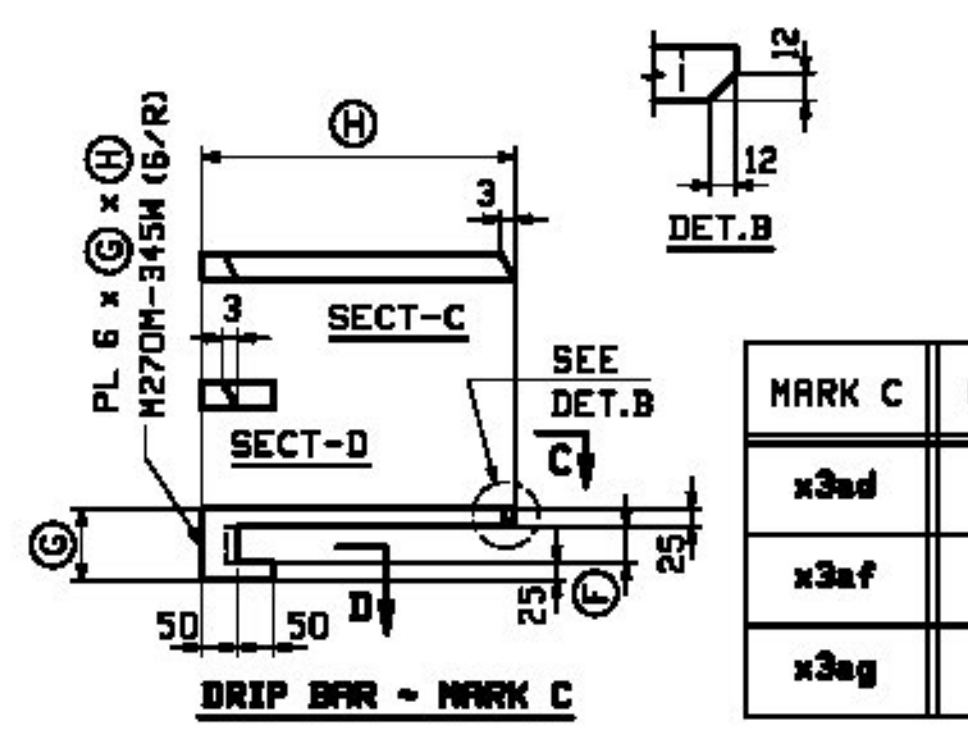

MARK C	QTY	Ⓕ	Ⓖ	Ⓕ	
x3ad	1	50	100	395	50x600 FLG
x3af	3	50	100	440	50x700 FLG
x3ag	1	35	85	395	35x600 FLG

VERMONT Agency of Transportation  
 Approved  
 Douglas E. Bonneau, P.E.  
 Structures Project Manager  
 Date: 12/10/12  
 Rejected  
 Revise & Resubmit

McFarland Johnson  
 Date: October 24, 2012  
 By: D. Kull

NOTES:  
 1. FOR GENERAL NOTES SEE DRAWING GNI.  
 2. T2 DENOTES CHARNY V-NOTCH TESTING REQUIRED.

REV.	DATE	REMARKS	DWN	CHK	APVL	SHOP
AS NOTED		SURFACE PREP. & PRINT: SEE GNI				SHOP BOLTS: NONE
DESCRIPTION: GIRDER STANDARD DETAILS						
CASCO BAY STEEL STRUCTURES, INC. 1 WALLACE AVE. PHONE (207) 780-6722 SOUTH PORTLAND, ME 04106 FAX. (207) 780-6726						
STRUCTURE: VT 100 OVER LAHOILLE RIVER MORRISTOWN, VT LAHOILLE COUNTY STP F 029-1 (2) C/1			DRAWN: CRK DATE: 08/20		CHKD: PCP DATE: 9/17/12	
LOCATION: MORRISTOWN, VT			JOB NO. 521		DWG NO. X3	
PROJ NO. STP F 029-112C/1			CUSTOMER: MINTERSET, INC.		REV. REV. Δ	