




JOB NO.		DRAWING NO.		REV.	
921		26			
REV.	DATE	BY	CHKD.	APPV.	REMARKS
1					
2					
3					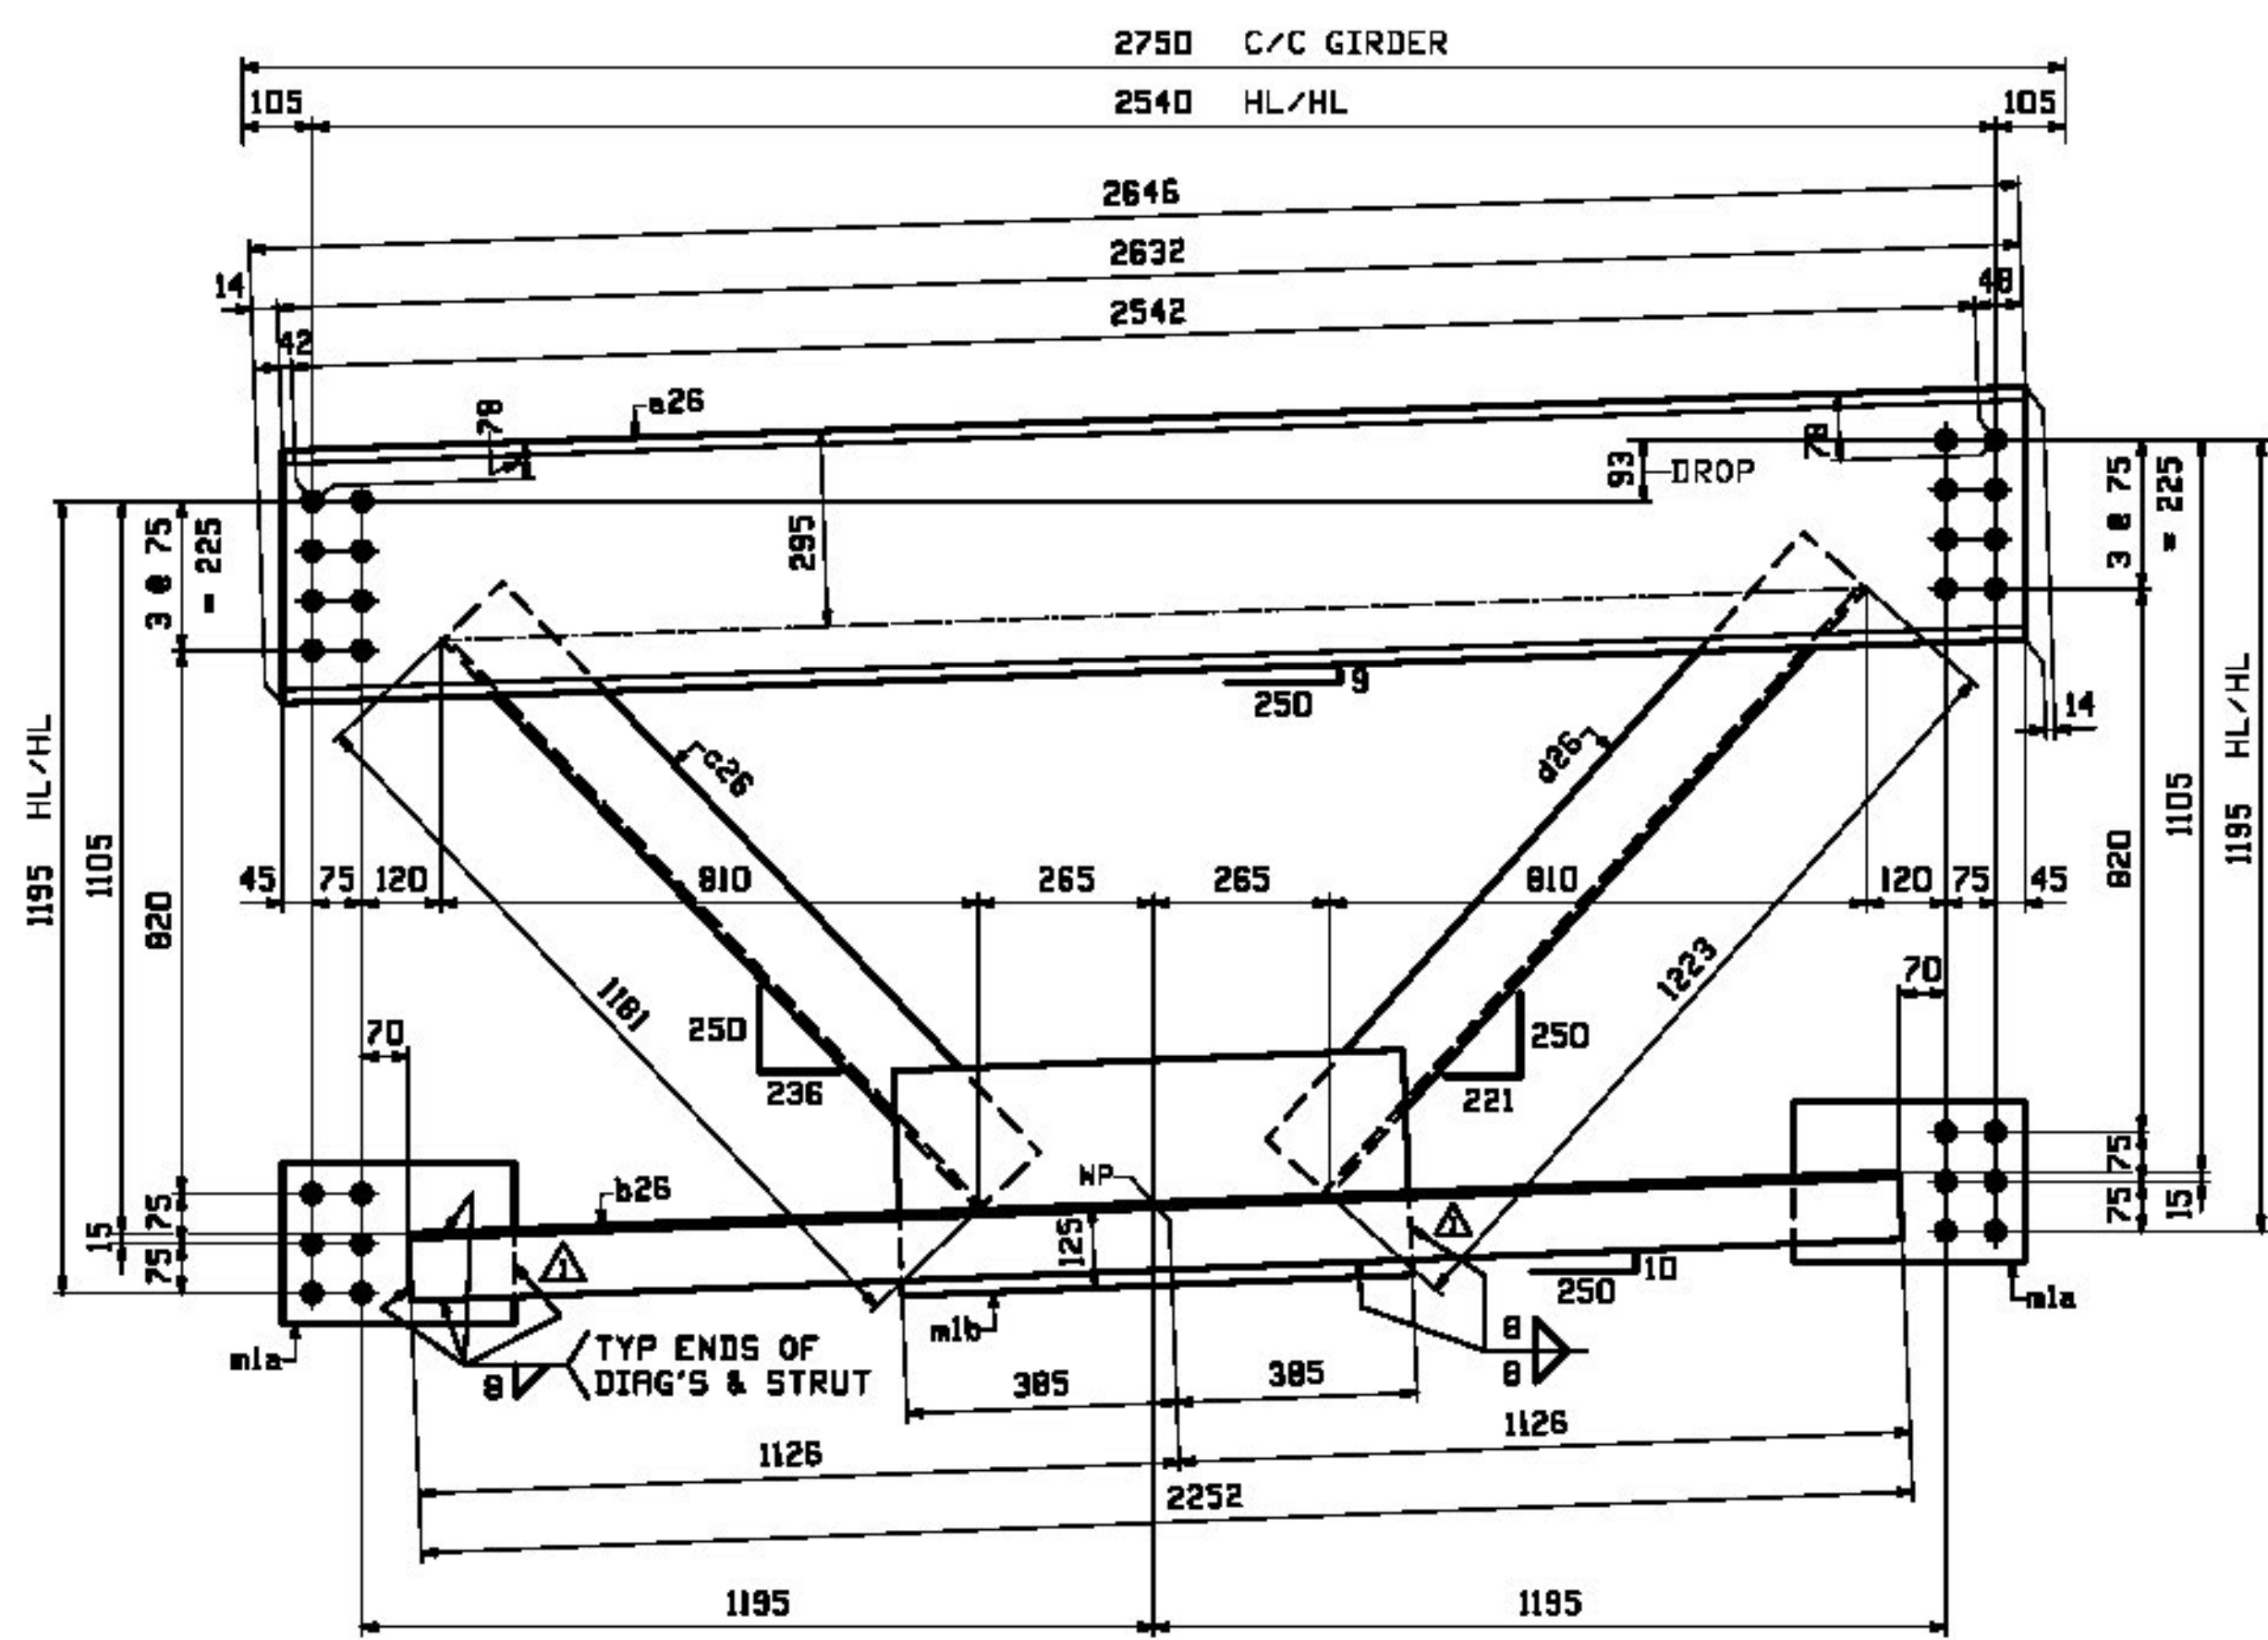
2 ~ END CROSSFRAMES - 26CF1 ← PRINTED (SEE DWG GNI)
TYPE DI - LOOKING UP-STATION

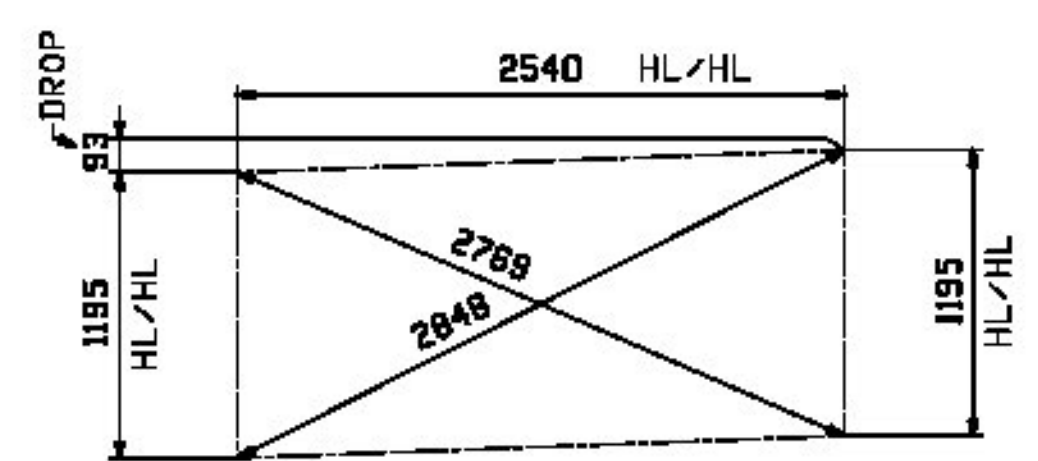

CROSS CHECK - 26CF1

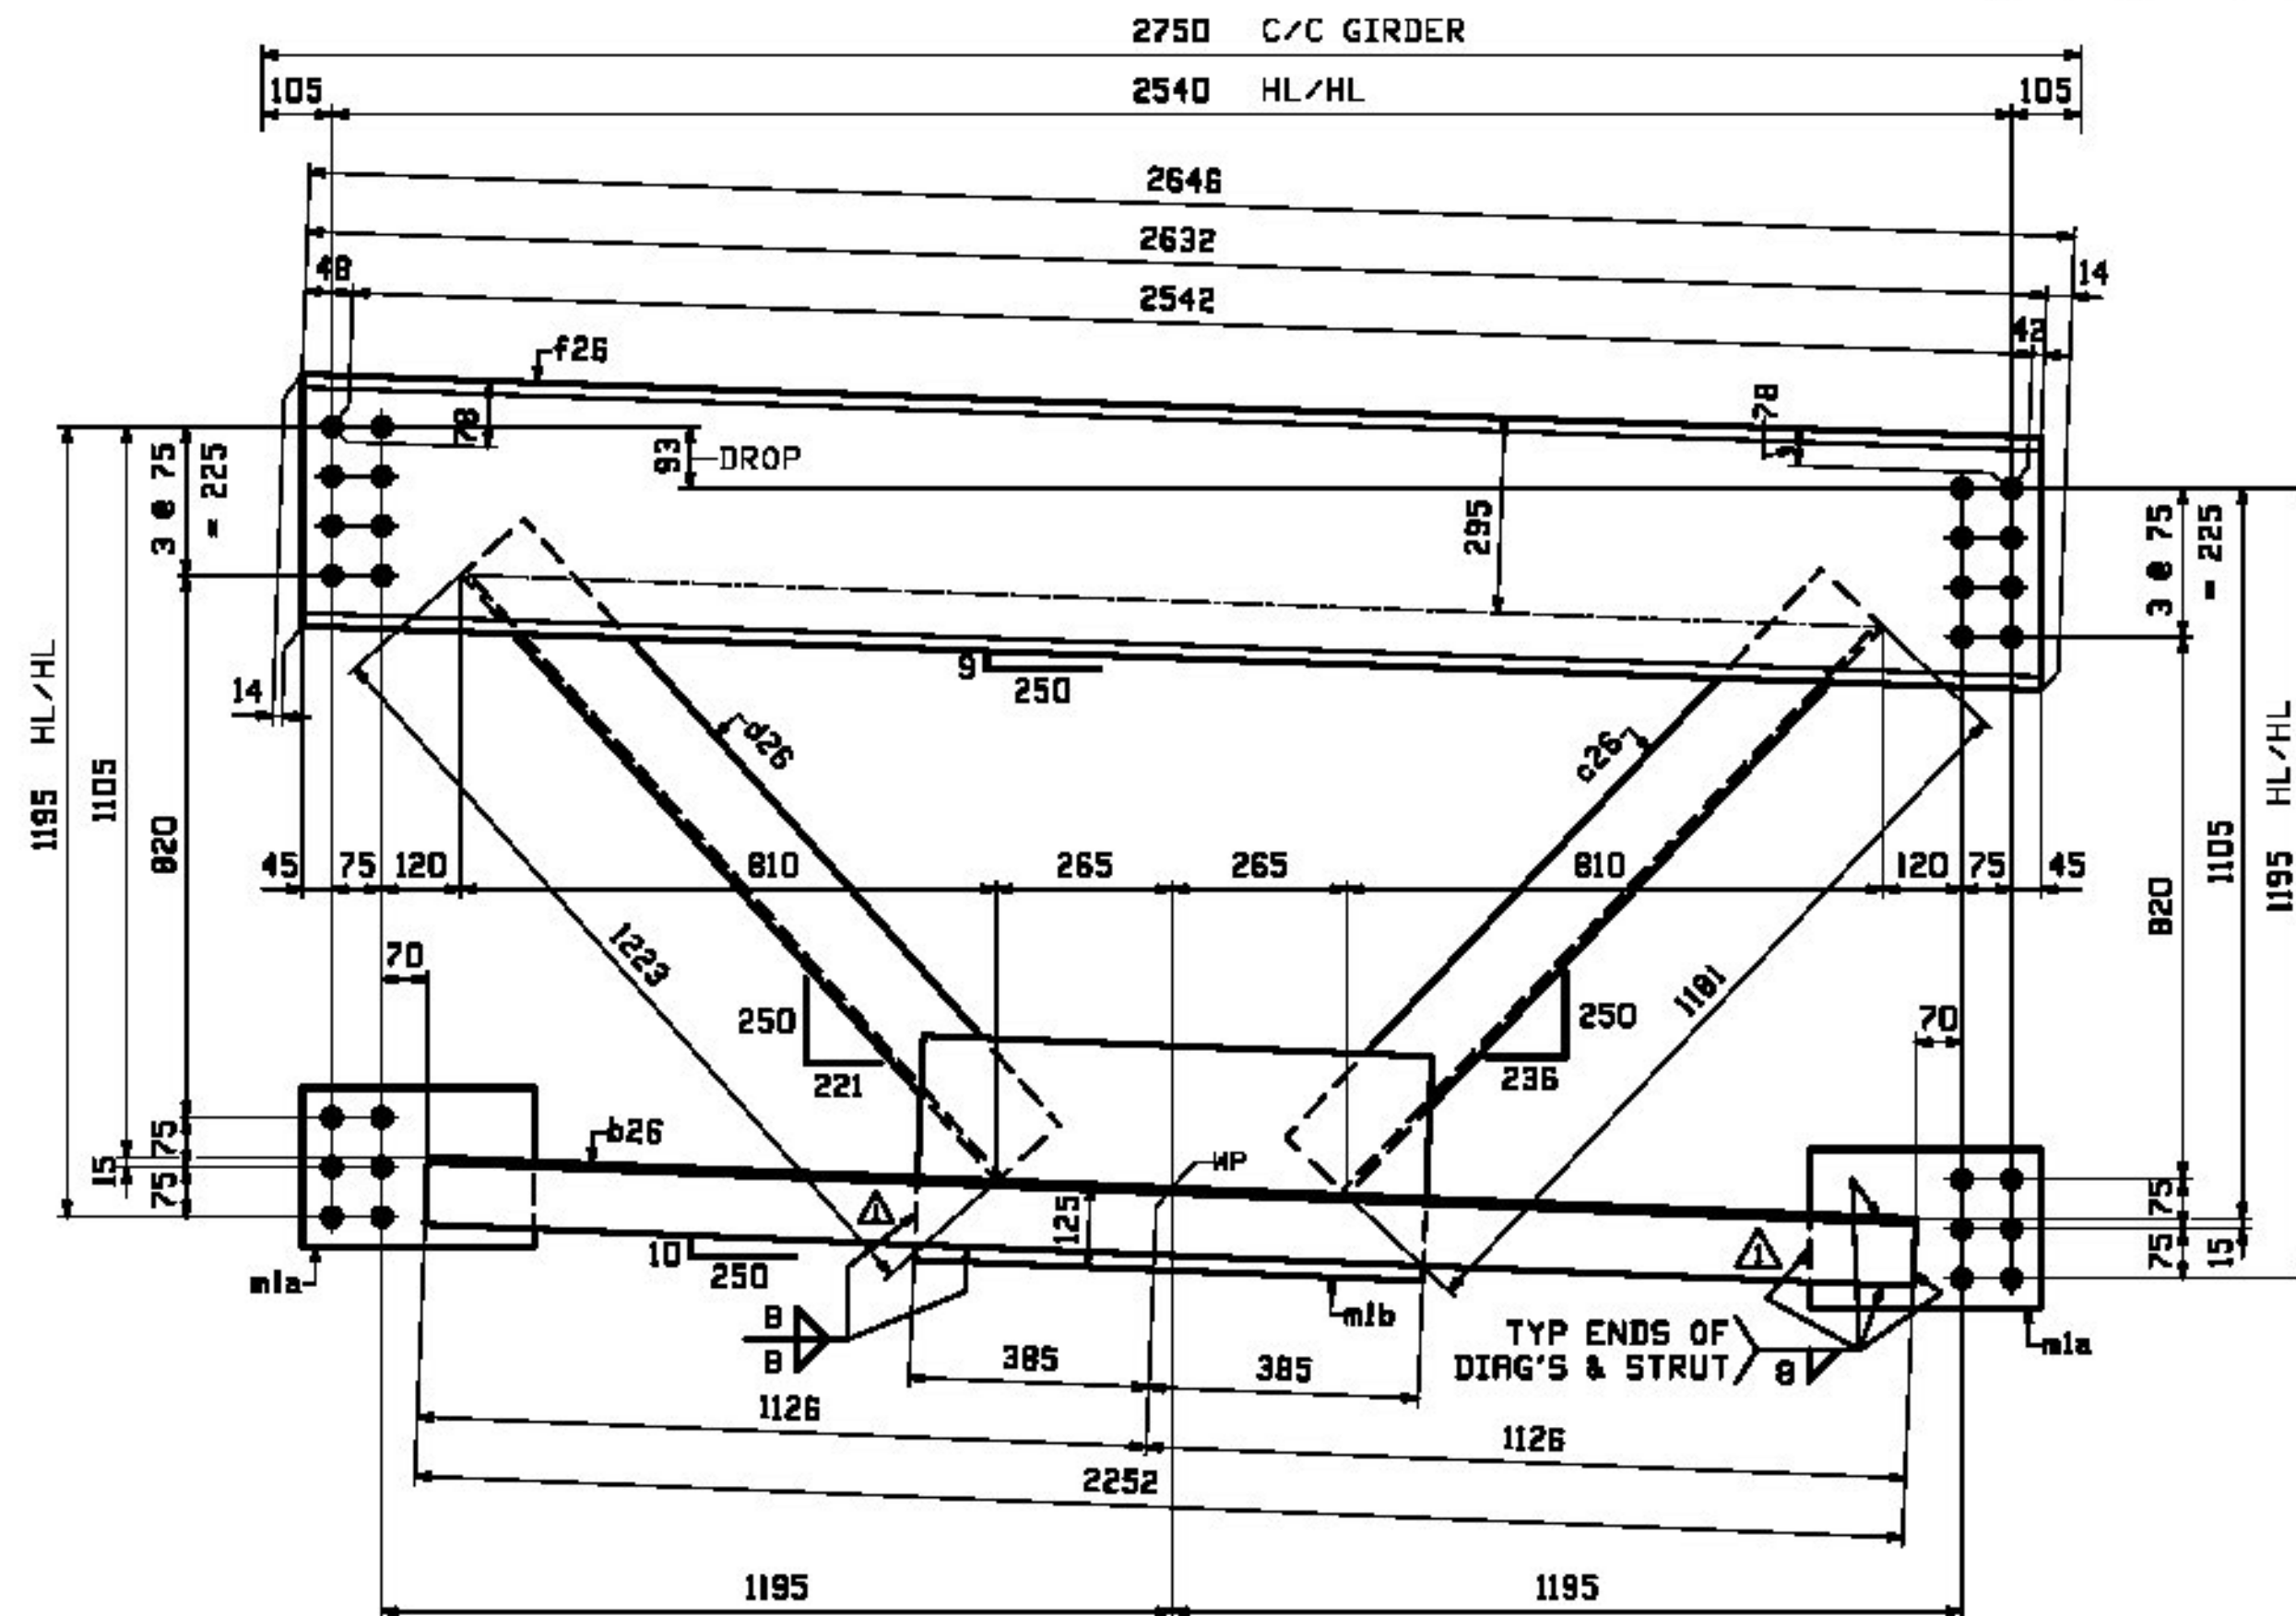

2 ~ END CROSSFRAMES - 26CF2 ← PRINTED (SEE DWG GNI)
TYPE DI - LOOKING UP-STATION

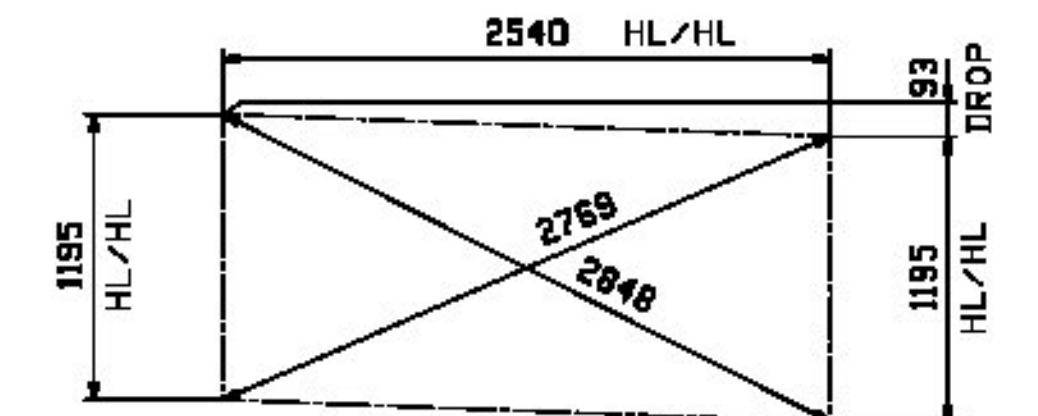

CROSS CHECK - 26CF2

NOTE:
FOR GENERAL NOTES AND WELD TERMINATION DETAIL SEE DRAWING GNI.

Agency of Transportation
Approved _____ Rejected _____
Furnish as Corrected _____ Revise & Resubmit _____
Date: 05/12/12
Douglas E. Beauneau, P.E. Date
Structures Project Manager

REV.	DATE	REMARKS	DWN	CHK	APVL	SHOP
1	12/18	APPROVAL COMMENTS	EEO	PCP		
2						
3						
DESCRIPTION: END CROSSFRAMES
CASCO BAY STEEL STRUCTURES, INC.
1 WALLACE AVE. PHONE (207) 780-6722
SOUTH PORTLAND, ME 04106 FAX. (207) 780-6726
STRUCTURE: VT 100 OVER LAHOILLE RIVER
MORRISTOWN, VT LAHOILLE COUNTY
STP F 029-1 (2) C/1
DRAWN: JTB DATE: 08/16
CHKD: PCP DATE: 08/17
LOCATION: MORRISTOWN, VT JOB NO. DWG NO.
PROJ NO. STP F 029-1(2)C/1 521 26
CUSTOMER: MINTERSET, INC. REV. 26