


**PROJECT PAVING LIMITS**


TOWN AND ROUTE	BEGIN STATION	END STATION	LANE TYPICAL	WEARING DEPTH	NOTES
U. S. 7					
CHARLOTTE					
	150+85.09	155+75	VARIES-12'-12'-VARIES	2"	LEVEL 1/2" TYPE IVS, WEARING COURSE 2" TYPE III
	155+75	170+50	10'-12'-12'-10'	2"	LEVEL 1/2" TYPE IVS, WEARING COURSE 2" TYPE III
	170+50	181+50	VARIES-11'-VARIES-11'-VARIES	2"	LEVEL 1/2" TYPE IVS, WEARING COURSE 2" TYPE III
	181+50	186+25	VARIES-VARIES-12'-VARIES-11'-5'	2"	LEVEL 1/2" TYPE IVS, WEARING COURSE 2" TYPE III
	186+25	270+25	10'-12'-11'-11'-5'	2"	LEVEL 1/2" TYPE IVS, WEARING COURSE 2" TYPE III
	270+25	280+50	11'-12'-11'-VARIES-VARIES	2"	LEVEL 1/2" TYPE IVS, WEARING COURSE 2" TYPE III
	280+50	283+50	10'-12'-12'-10'	2"	LEVEL 1/2" TYPE IVS, WEARING COURSE 2" TYPE III
	283+50	306+25	10'-12'-12'-10'	2"	SPOT LEVEL, LEVEL 1/2" TYPE IVS, WEARING COURSE 2" TYPE III
	306+25	308+00	VARIES-12'-12'-VARIES	2"	SPOT LEVEL, LEVEL 1/2" TYPE IVS, WEARING COURSE 2" TYPE III
	308+00	345+94.33	8'-12'-12'-8'	2"	SPOT LEVEL, LEVEL 1/2" TYPE IVS, WEARING COURSE 2" TYPE III
SHELBURNE	0+00	26+00	8'-12'-12'-8'	2"	SPOT LEVEL, LEVEL 1/2" TYPE IVS, WEARING COURSE 2" TYPE III
	26+00	30+50	VARIES-12'-VARIES-12'-VARIES-VARIES	2"	SPOT LEVEL, LEVEL 1/2" TYPE IVS, WEARING COURSE 2" TYPE III
	30+50	38+25	10'-12'-VARIES-12'-VARIES	2"	SPOT LEVEL, LEVEL 1/2" TYPE IVS, WEARING COURSE 2" TYPE III
	38+25	45+00	10'-12'-12'-8'	2"	LEVEL 1/2" TYPE IVS, WEARING COURSE 2" TYPE III
	45+00	50+50	VARIES-12'-12'-VARIES	2"	LEVEL 1/2" TYPE IVS, WEARING COURSE 2" TYPE III
	50+50	58+08	4'-12'-12'-4'	2"	LEVEL 1/2" TYPE IVS, WEARING COURSE 2" TYPE III
	58+08	61+00	4'-12'-12'-4'	2"	COLD PLANE 2 1/2", LEVEL 1/2" TYPE IVS, WEARING COURSE 2" TYPE III
	61+00	65+50	7'-11'-11'-5'	2"	COLD PLANE 2 1/2", LEVEL 1/2" TYPE IVS, WEARING COURSE 2" TYPE III
	65+50	69+75	VARIES-VARIES-11'-11'-5'	2"	COLD PLANE 2 1/2", LEVEL 1/2" TYPE IVS, WEARING COURSE 2" TYPE III
	69+75	71+25	9'-11'-11'-5'	2"	COLD PLANE 2 1/2", LEVEL 1/2" TYPE IVS, WEARING COURSE 2" TYPE III
	71+25	81+75	4'-11'-11'-5'	2"	COLD PLANE 2 1/2", LEVEL 1/2" TYPE IVS, WEARING COURSE 2" TYPE III
	81+75	98+00	VARIES-11'-11'-5'	2"	COLD PLANE 2 1/2", LEVEL 1/2" TYPE IVS, WEARING COURSE 2" TYPE III
	98+00	99+25	4'-11'-11'-5'	2"	COLD PLANE 2 1/2", LEVEL 1/2" TYPE IVS, WEARING COURSE 2" TYPE III
	99+25	106+50	VAREIS-VARIES-VARIES-11'-VARIES	2"	COLD PLANE 2 1/2", LEVEL 1/2" TYPE IVS, WEARING COURSE 2" TYPE III
	106+50	111+50	3'-11'-11'-3'	2"	COLD PLANE 2 1/2", LEVEL 1/2" TYPE IVS, WEARING COURSE 2" TYPE III
	111+50	112+25	VARIES-11'-VARIES-11'-3'	2"	COLD PLANE 2 1/2", LEVEL 1/2" TYPE IVS, WEARING COURSE 2" TYPE III
	112+25	113+25	VARIES-11'-VARIES-11'-VARIES	2"	COLD PLANE 2 1/2", LEVEL 1/2" TYPE IVS, WEARING COURSE 2" TYPE III
	113+25	114+25	10'-11'-11'-11'-2'	2"	COLD PLANE 2 1/2", LEVEL 1/2" TYPE IVS, WEARING COURSE 2" TYPE III
	114+25	117+50	VARIES-VARIES-12'-VARIES-11'-VARIES	2"	COLD PLANE 2 1/2", LEVEL 1/2" TYPE IVS, WEARING COURSE 2" TYPE III
	117+50	123+00	VARIES-12'-12'-VARIES	2"	COLD PLANE 2 1/2", LEVEL 1/2" TYPE IVS, WEARING COURSE 2" TYPE III
	123+00	125+65	11'-11'-VARIES-11'-VARIES	2"	COLD PLANE 2 1/2", LEVEL 1/2" TYPE IVS, WEARING COURSE 2" TYPE III
	125+65	128+36	11'-11'-VARIES-11'-VARIES	1 1/4"	COLD PLANE 1 1/4", 1 1/4" TYPE IVS, BRIDGE #144

	128+36	135+75	11'-11'-VARIES-11'-VARIES	2"	COLD PLANE 2 1/2", LEVEL 1/2" TYPE IVS, WEARING COURSE 2" TYPE III
	135+75	137+81.00	8'-12'-12'-8'	2"	COLD PLANE 2 1/2", LEVEL 1/2" TYPE IVS, WEARING COURSE 2" TYPE III
S. BURLINGTON	51+61.58	54+25	2'-VARIES-11'-11'-12'-11'-11'-2'	2"	COLD PLANE 2 1/2", LEVEL 1/2" TYPE IVS, WEARING COURSE 2" TYPE III
	54+25	60+00	2'-11'-11'-12'-11'-11'-2'	2"	COLD PLANE 2 1/2", LEVEL 1/2" TYPE IVS, WEARING COURSE 2" TYPE III
	60+00	63+50	2'-VARIES-11'-11'-12'-11'-11'-VARIES	2"	COLD PLANE 2 1/2", LEVEL 1/2" TYPE IVS, WEARING COURSE 2" TYPE III
	63+50	76+00	3'-11'-11'-12'-11'-11'-1'	2"	COLD PLANE 2 1/2", LEVEL 1/2" TYPE IVS, WEARING COURSE 2" TYPE III
	76+00	79+25	2'-VARIES-11'-11'-12'-11'-11'-2'	2"	COLD PLANE 2 1/2", LEVEL 1/2" TYPE IVS, WEARING COURSE 2" TYPE III
	79+25	80+75	2'-11'-11'-12'-11'-11'-2'	2"	COLD PLANE 2 1/2", LEVEL 1/2" TYPE IVS, WEARING COURSE 2" TYPE III
	80+75	83+00	2'-VARIES-11'-11'-12'-11'-11'-2'	2"	COLD PLANE 2 1/2", LEVEL 1/2" TYPE IVS, WEARING COURSE 2" TYPE III
	83+00	87+75	2'-11'-11'-12'-11'-11'-2'	2"	COLD PLANE 2 1/2", LEVEL 1/2" TYPE IVS, WEARING COURSE 2" TYPE III
	87+75	90+79.55	VARIES-11'-11'-12'-11'-11'-VARIES-VARIES	2"	COLD PLANE 2 1/2", LEVEL 1/2" TYPE IVS, WEARING COURSE 2" TYPE III

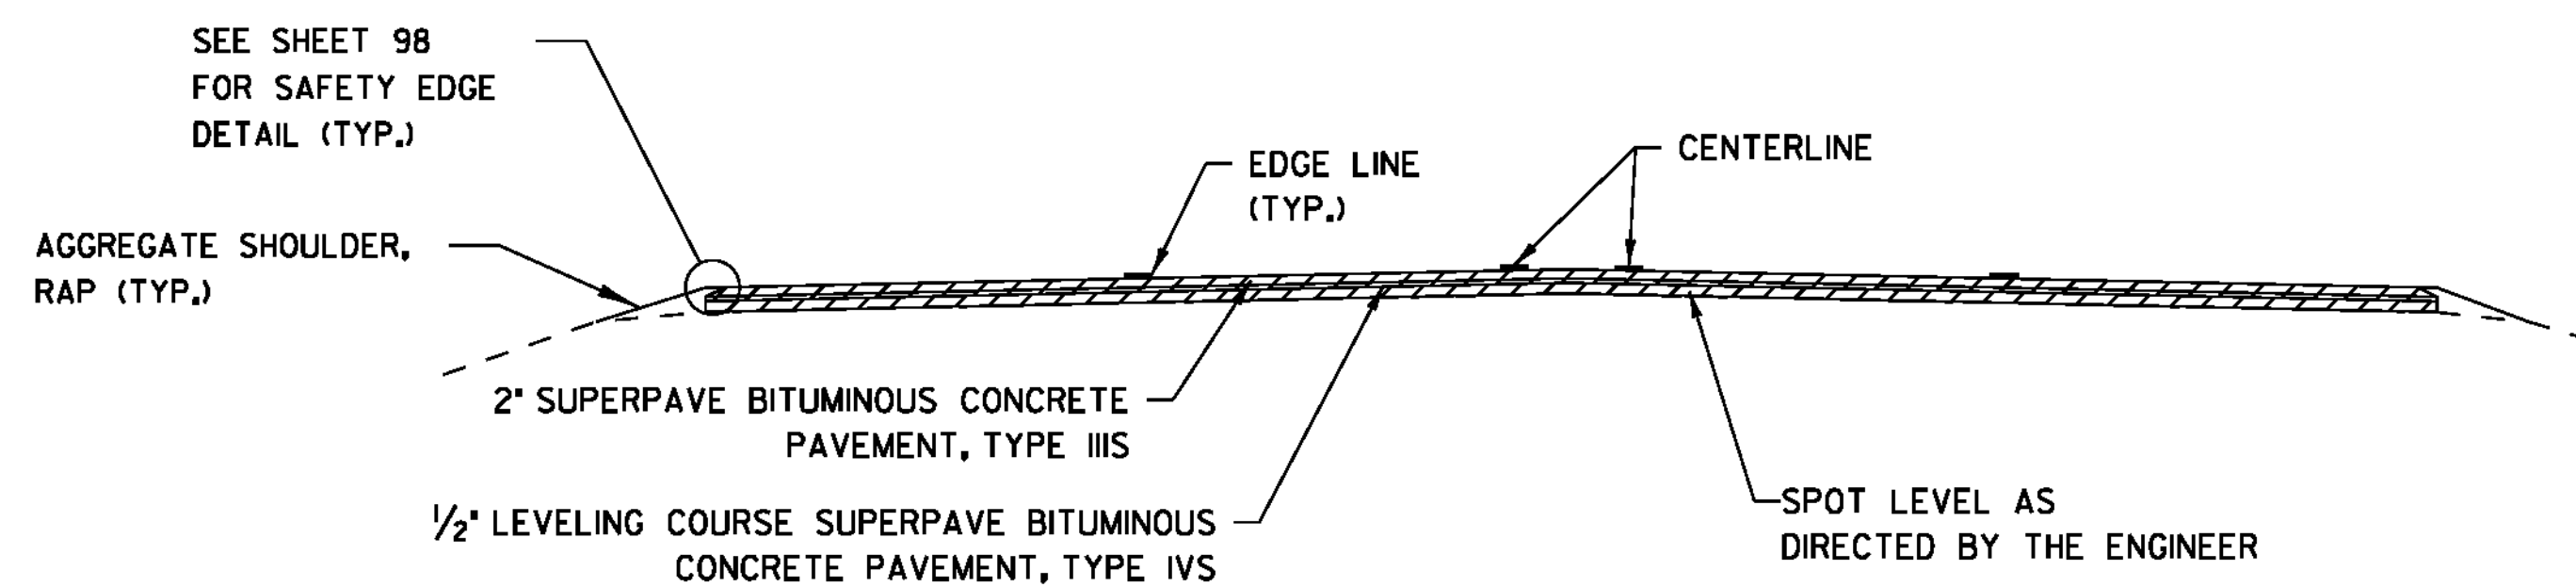

**SPOT LEVELING TYPICAL SECTION**

CHARLOTTE STA. 283+50 - STA. 345+94.33      SHELBURNE STA. 0+00 - STA. 38+25

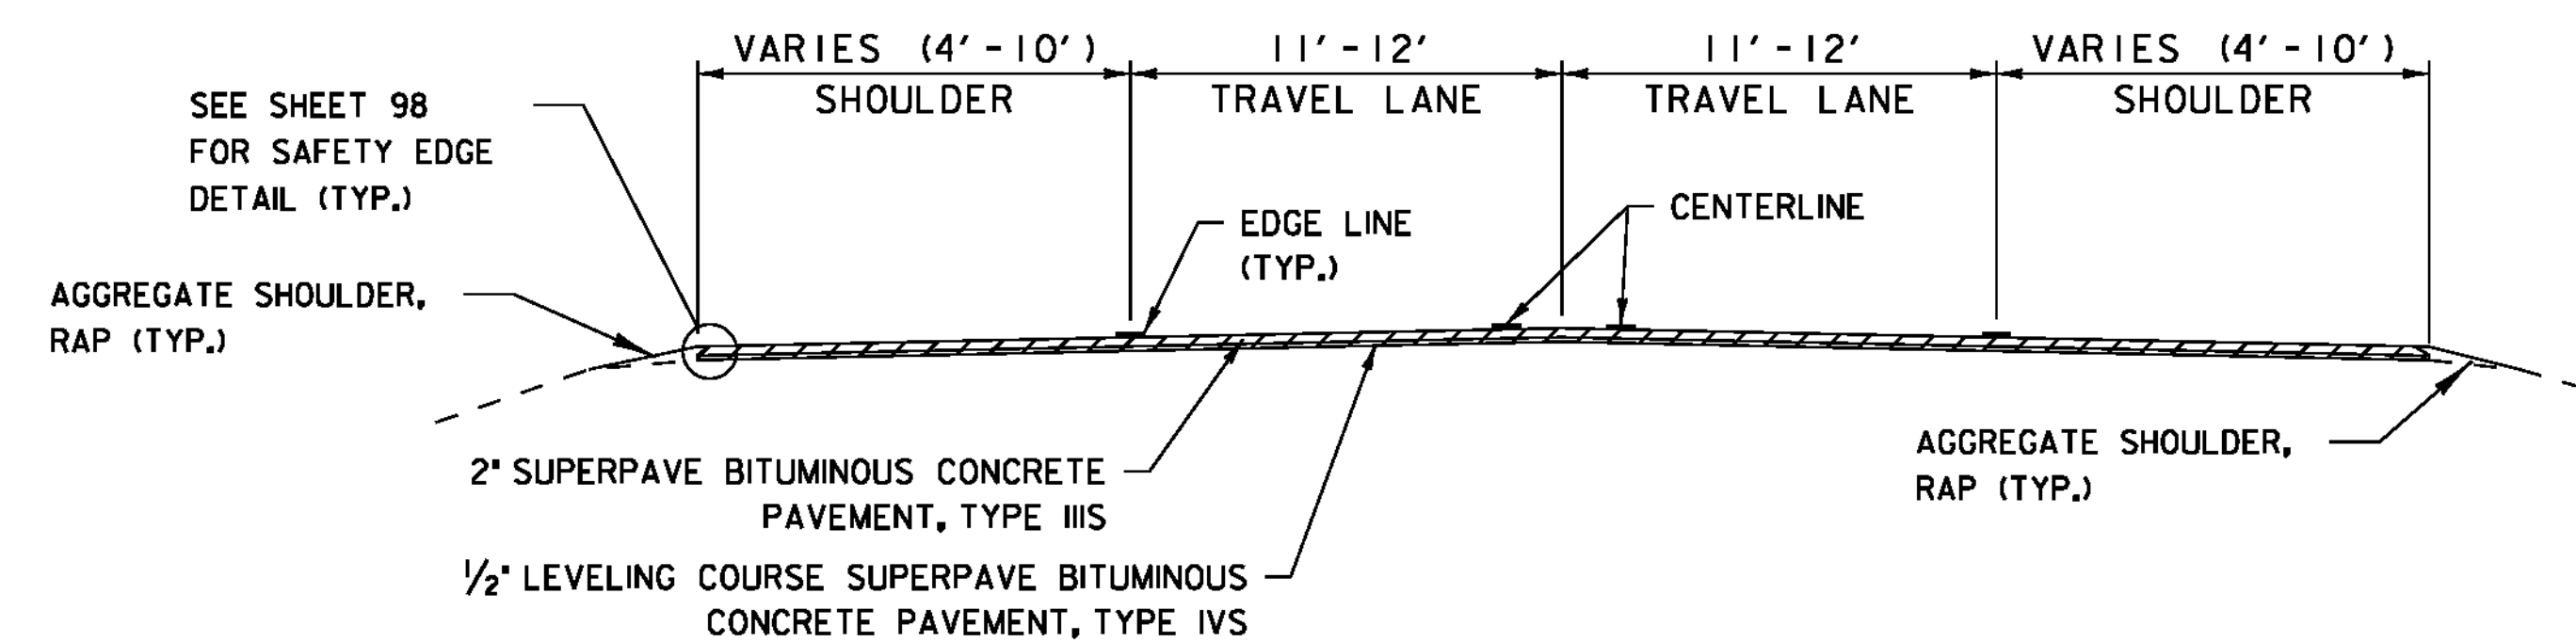

**LEVEL/OVERLAY TYPICAL SECTION**

CHARLOTTE STA. 150+85.09 - STA. 170+50      SHELBURNE STA. 0+00 - STA. 26+00  
STA. 280+50 - STA. 345+94.33      STA. 38+25 - STA. 58+08

**PROJECT  
TYPICAL  
SHEET 1**

PROJECT NAME: CHARLOTTE - SOUTH BURLINGTON  
PROJECT NUMBER: NH 2907(I)

FILE NAME: p10B206.dgn      PLOT DATE: 4/19/12  
PROJECT LEADER: CDL      DRAWN BY: BMB  
DESIGNED BY: BMB      CHECKED BY: EPD  
PLOT FILE: p10B206\_4.l      SHEET 4 OF 107

**NOT TO SCALE**