



LEVEL/OVERLAY TYPICAL SECTION

CHARLOTTE
STA. 170+50 - STA. 181+50

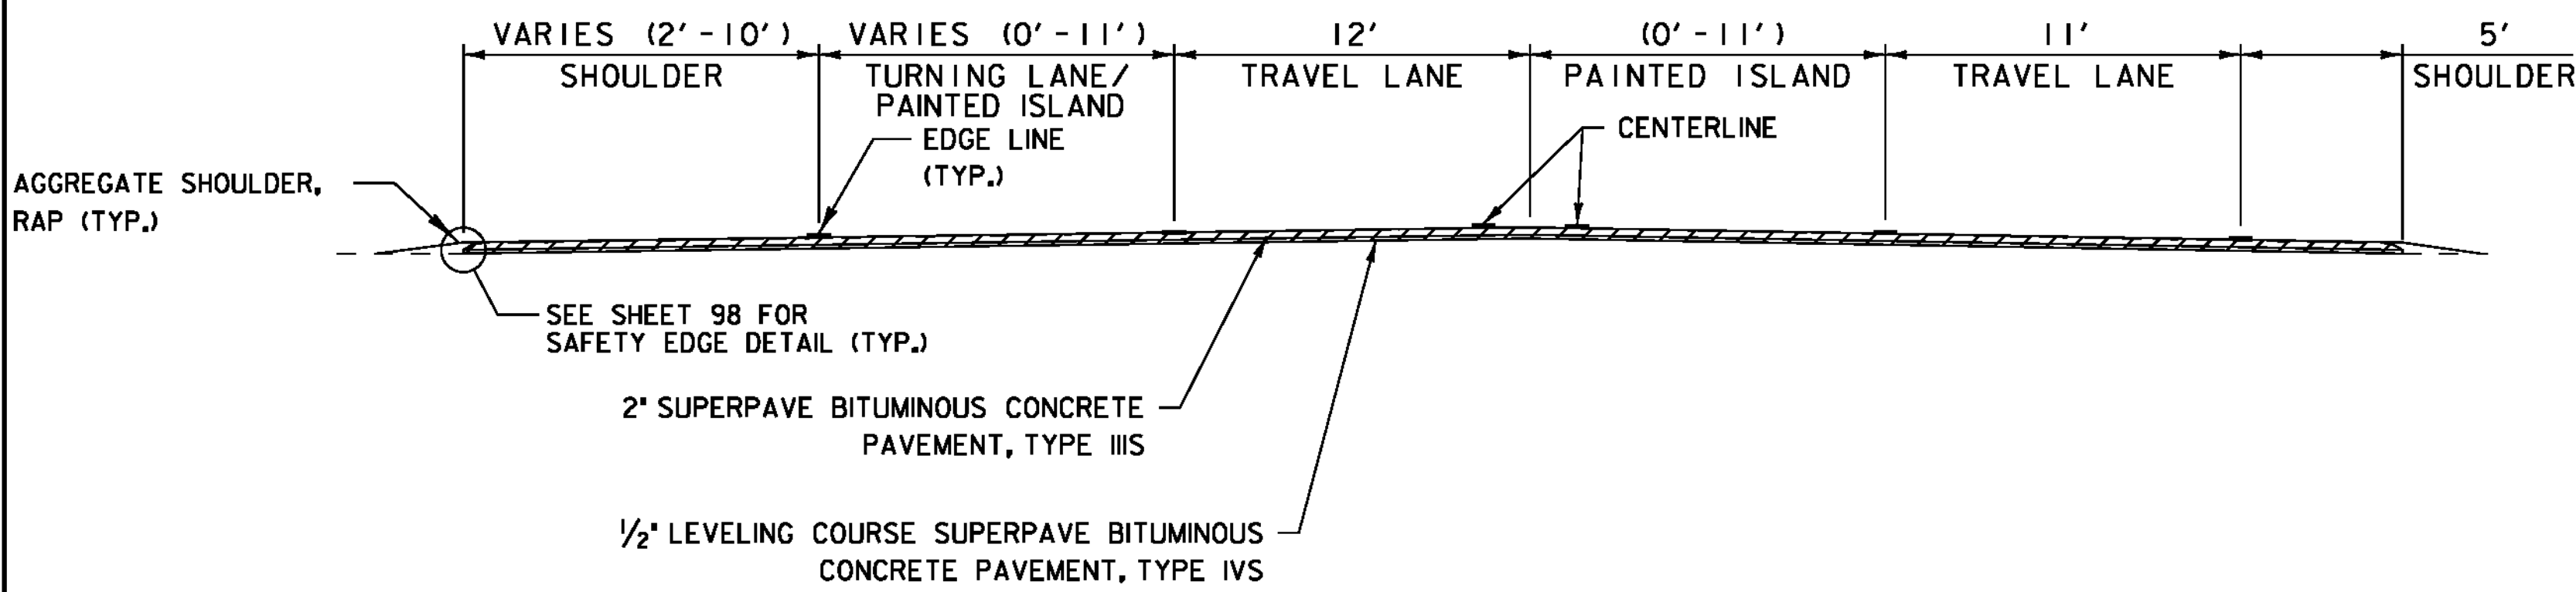


LEVEL/OVERLAY TYPICAL SECTION

CHARLOTTE
STA. 181+50 - STA. 186+25

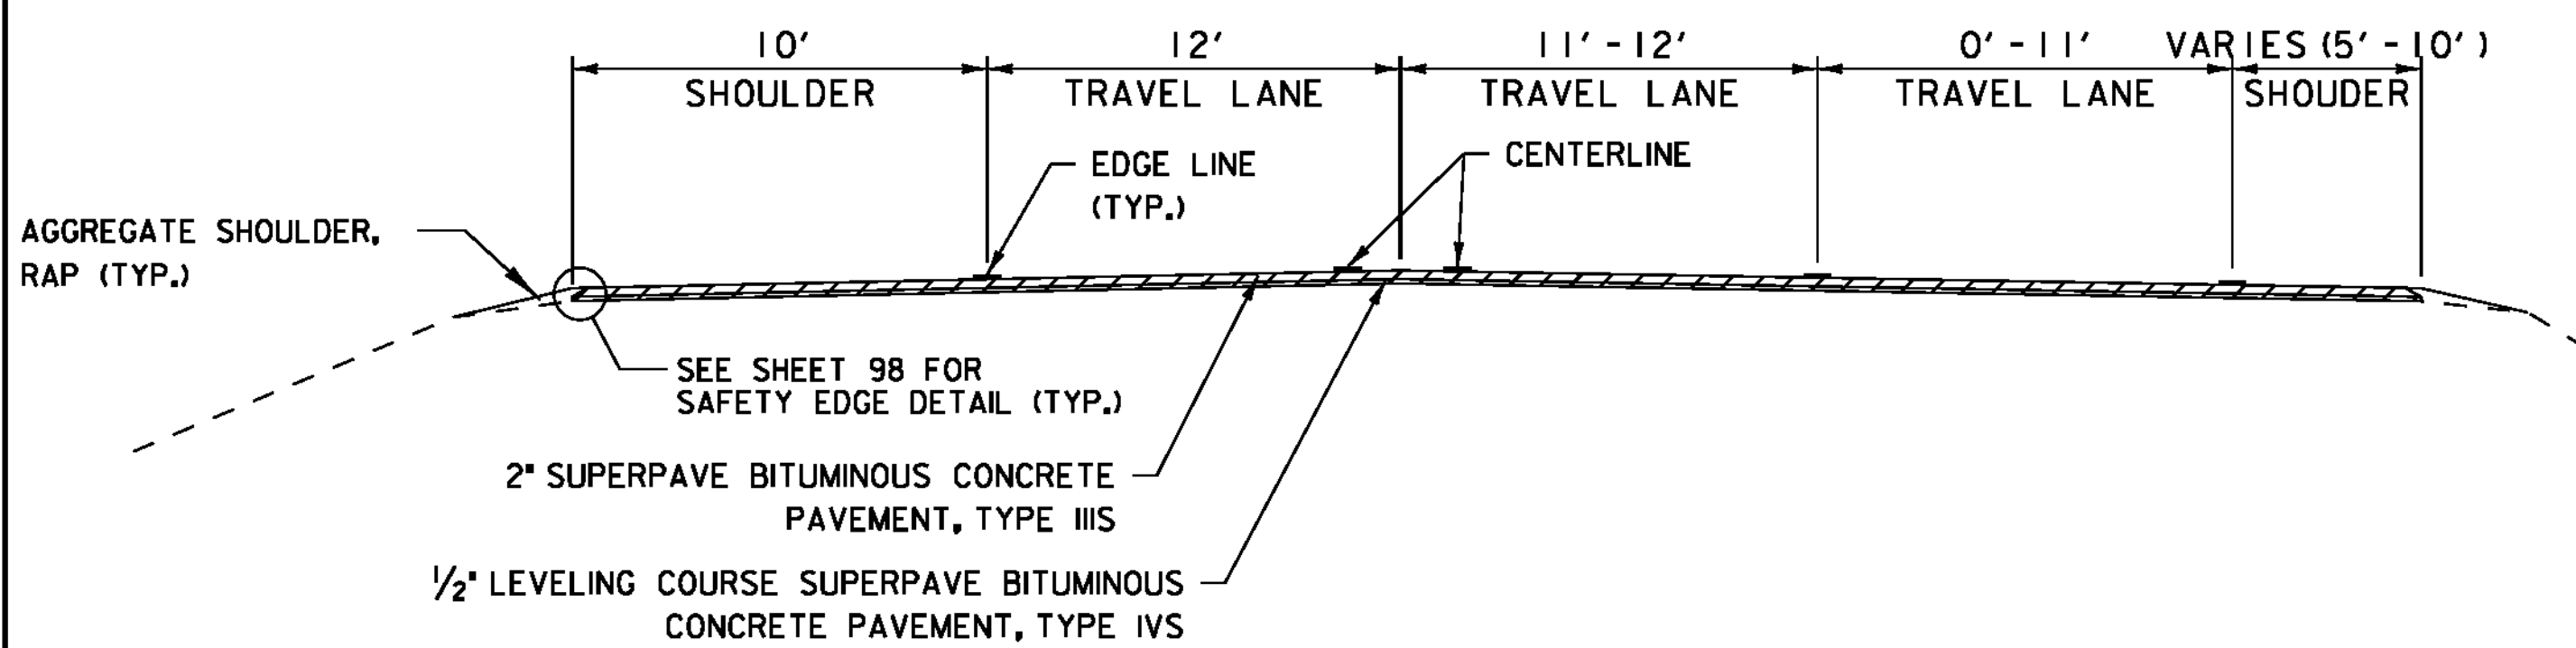


LEVEL/OVERLAY TYPICAL SECTION

CHARLOTTE
STA. 186+25 - STA. 280+50

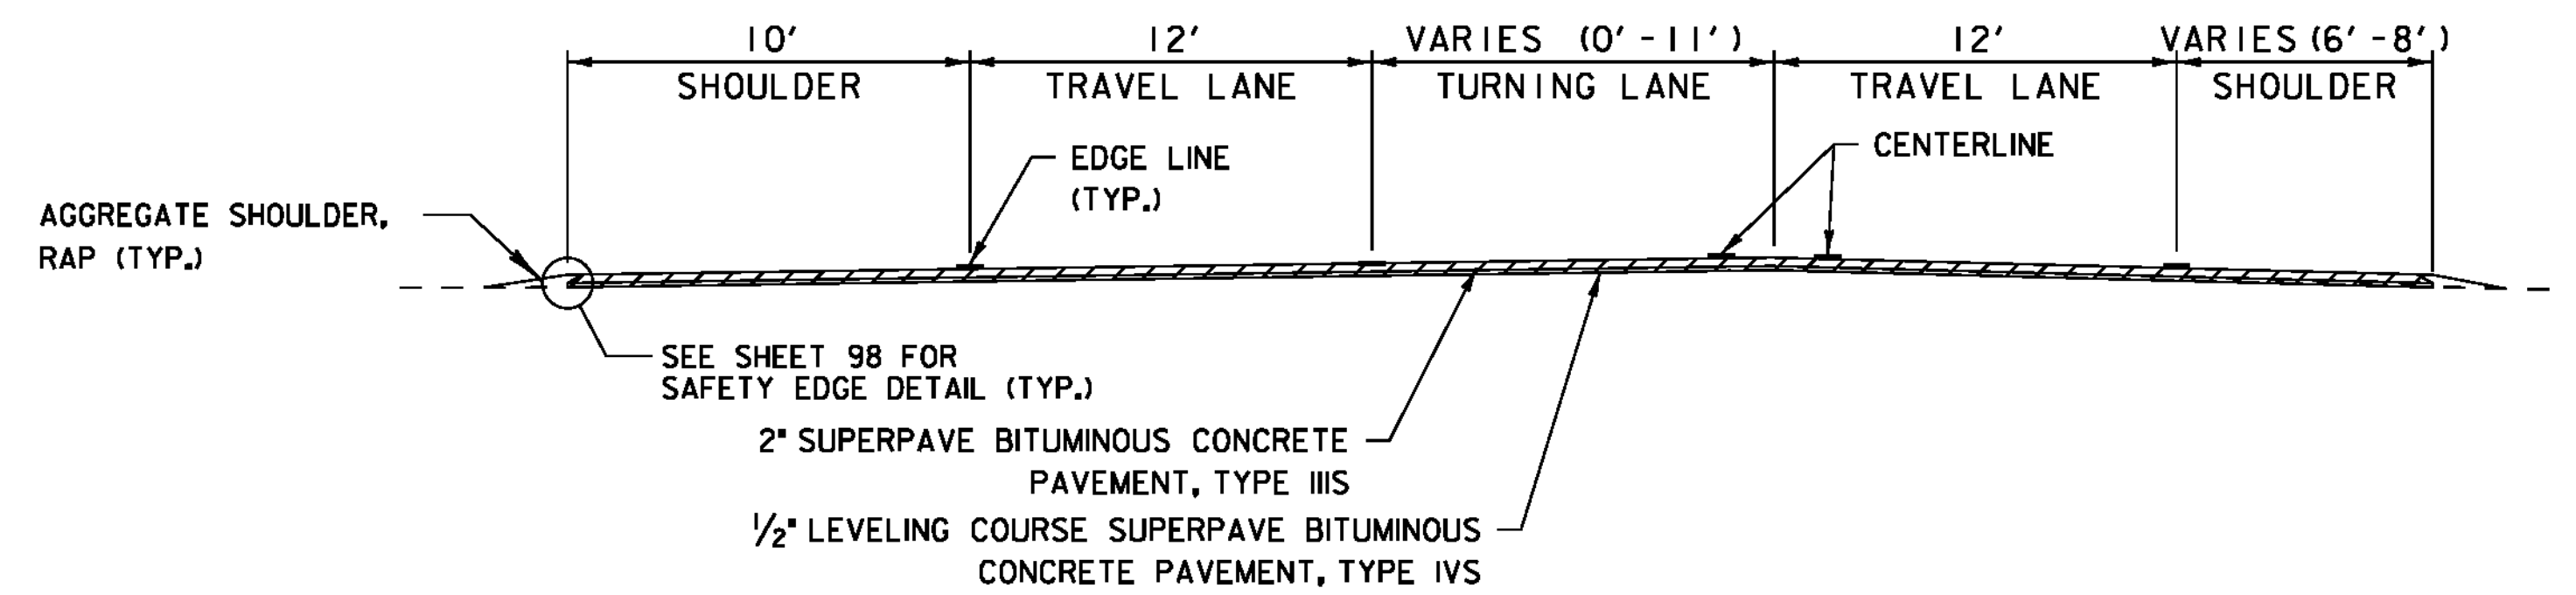


LEVEL/OVERLAY TYPICAL SECTION

SHELBURNE
STA. 30+50 - STA. 38+25

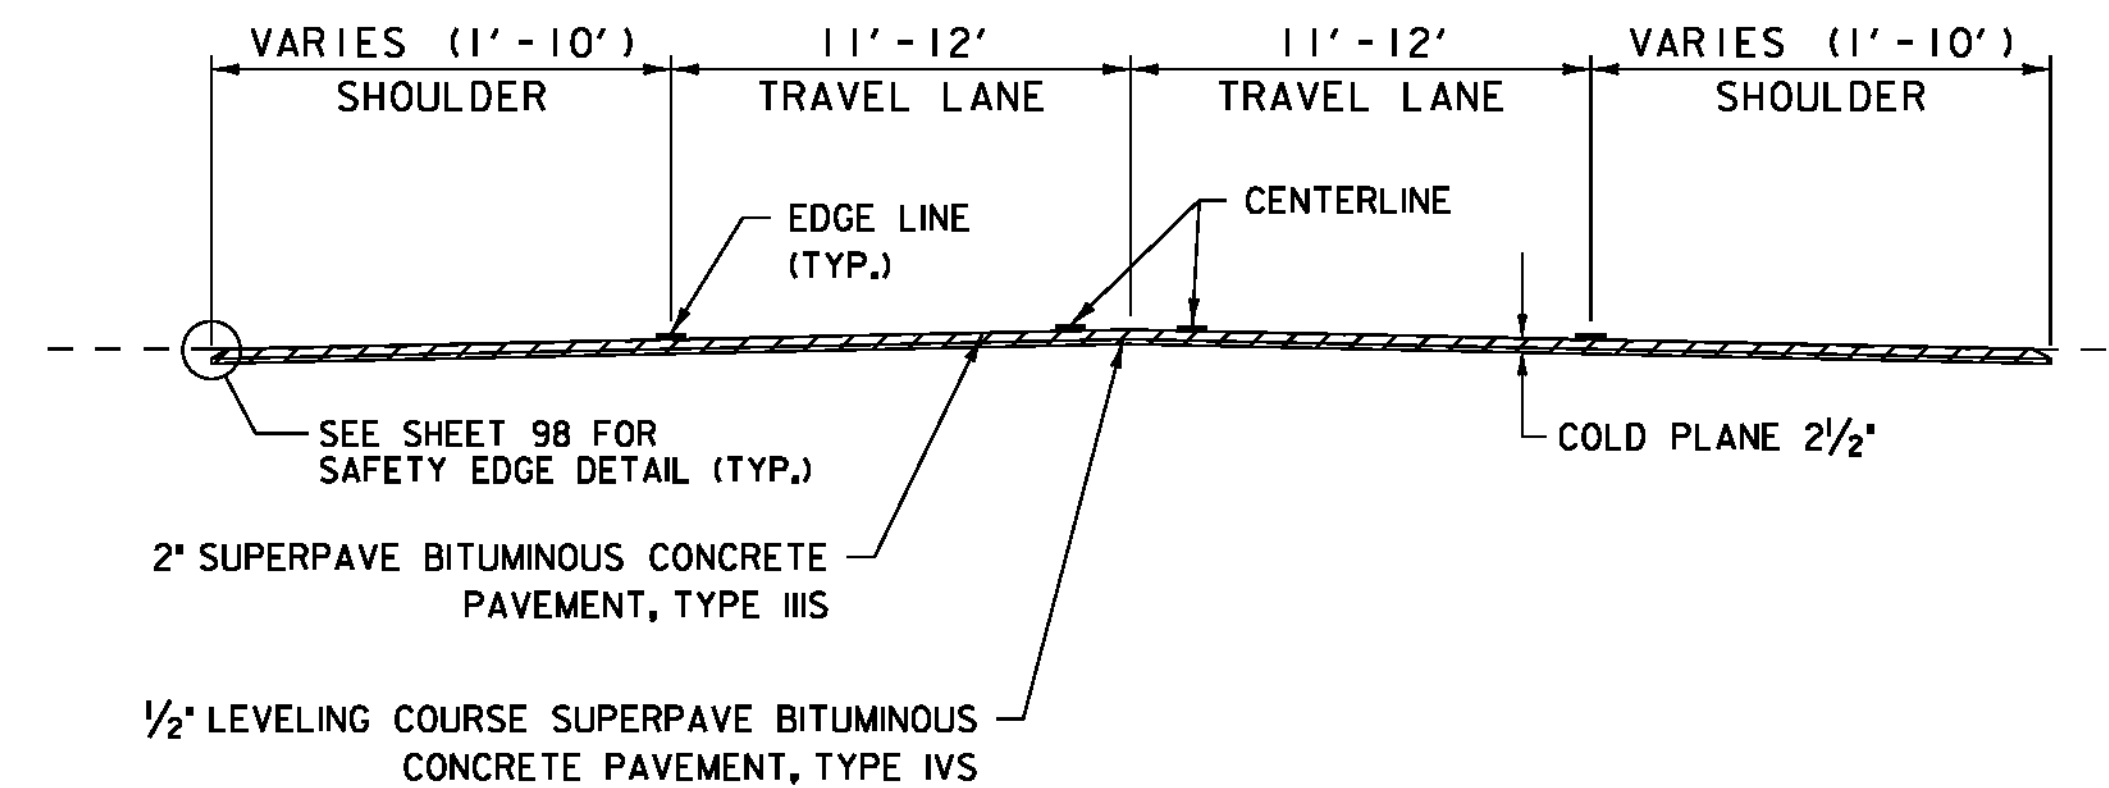

COLD PLANE AND OVERLAY TYPICAL SECTION

SHELBURNE
STA. 69+75 - STA. 99+25 •
STA. 106+50 - STA. 111+50
STA. 117+50 - STA. 123+00
STA. 135+75 - STA. 137+81.00
*PROPOSED CENTERLINE IS 2' LEFT OF BASELINE/EXISTING
CENTERLINE FROM STA. 61+38 - STA. 100+00

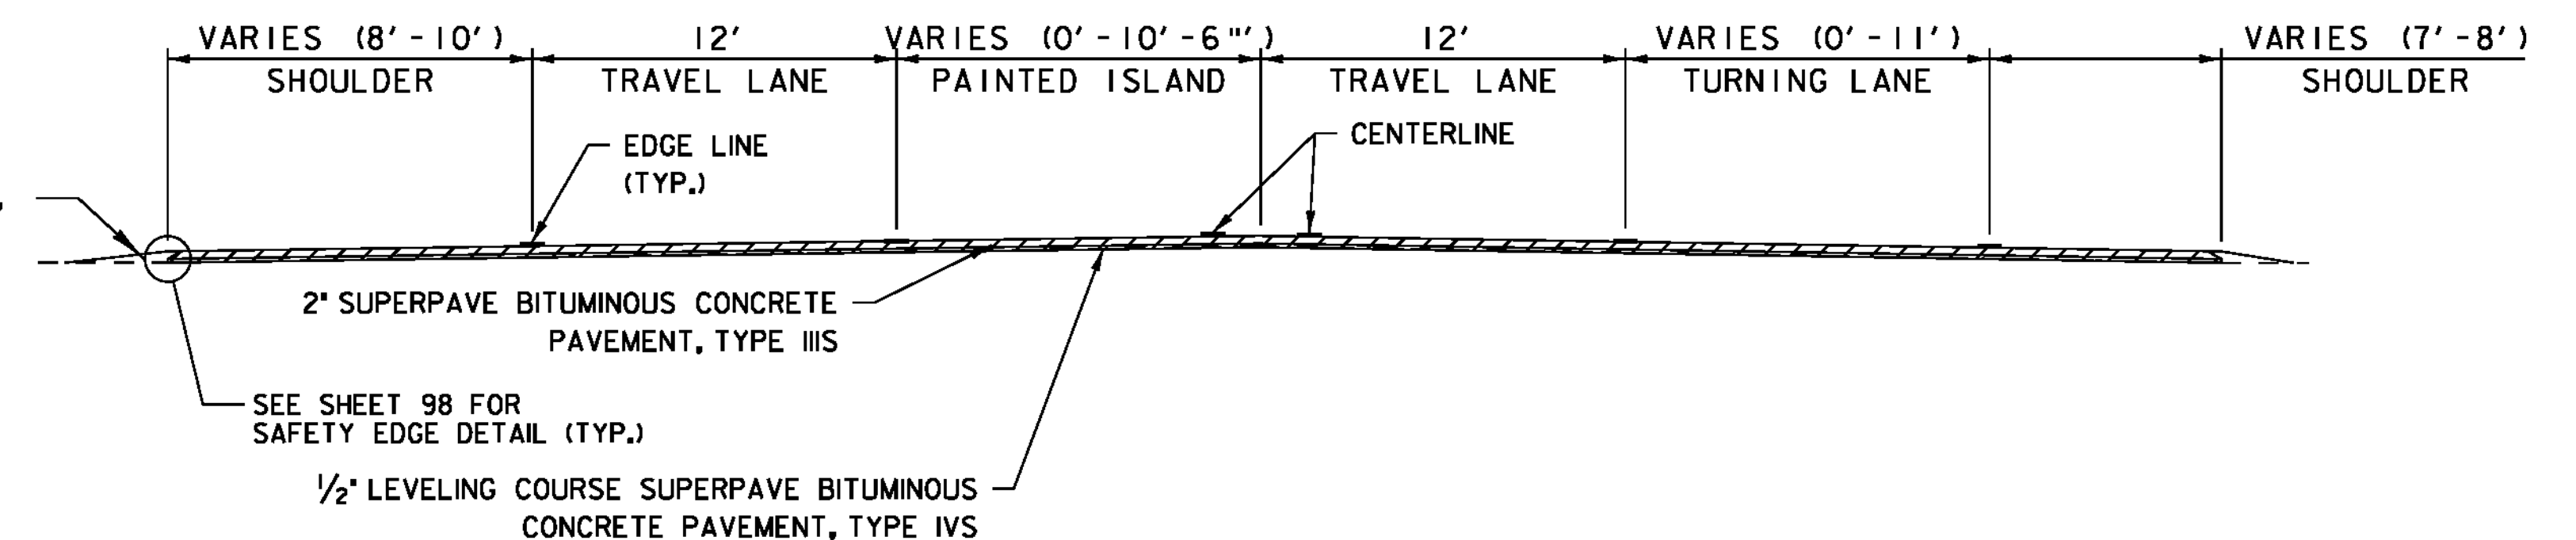

LEVEL/OVERLAY TYPICAL SECTION

SHELBURNE
STA. 26+00 - STA. 30+50

NOT TO SCALE

**PROJECT
TYPICAL
SHEET 2**

PROJECT NAME: CHARLOTTE - SOUTH BURLINGTON
PROJECT NUMBER: NH 2907(I)

FILE NAME: p10B206.dgn
PROJECT LEADER: CDL
DESIGNED BY: BMB
PLOT FILE: p10B206.5.I

PLOT DATE: 4/19/12
DRAWN BY: BMB
CHECKED BY: EPD
SHEET 5 OF 107