

**DURABLE 4 INCH WHITE LINE, TYPE I TAPE**  
 STA. 252+50 - STA. 267+25 (SOLID LT & RT)  
 (WITH EDGELINE BREAKS AT TOWN ROADS)  
 STA. 252+50 - STA. 267+25 (DASHED RT)  
 STA. 259+15 RT (EDGELINES TH #7)

TOWN HIGHWAY TRAVEL LANES SHALL  
 NOT EXCEED A 12' WIDTH BEYOND THE  
 PROPOSED RADIUS POINT.

**DURABLE 4 INCH YELLOW LINE, TYPE I TAPE**  
 STA. 252+50 - STA. 267+25 (CENTERLINE LT)  
 (WITH CENTERLINE BREAKS AT TOWN ROADS)  
 STA. 259+15 RT (CENTERLINE TH#7)

**DURABLE 24 INCH STOP BAR, TYPE I TAPE**  
 STA. 259+15 - STA. 259+39 RT

**DURABLE LETTER OR SYMBOL, TYPE I TAPE**  
 STA. 259+25 RT "STOP"


**TEMPORARY 4 INCH WHITE LINE, PAINT**  
 STA. 252+50 - STA. 267+25 (SOLID LT & RT)  
 (WITH EDGELINE BREAKS AT TOWN ROADS)  
 STA. 252+50 - STA. 267+25 (DASHED RT)  
 STA. 259+15 RT (EDGELINES TH #7)

**TEMPORARY 4 INCH YELLOW LINE, PAINT**  
 STA. 252+50 - STA. 267+25 (CENTERLINE LT)  
 (WITH CENTERLINE BREAKS AT TOWN ROADS)  
 STA. 259+15 RT (CENTERLINE TH#7)

**TEMPORARY 24 INCH STOP BAR, PAINT**  
 STA. 259+15 - STA. 259+39 RT

**TEMPORARY LETTER OR SYMBOL, PAINT**  
 STA. 259+25 RT "STOP"

**REMOVING SIGNS**  
 AS SHOWN - 28

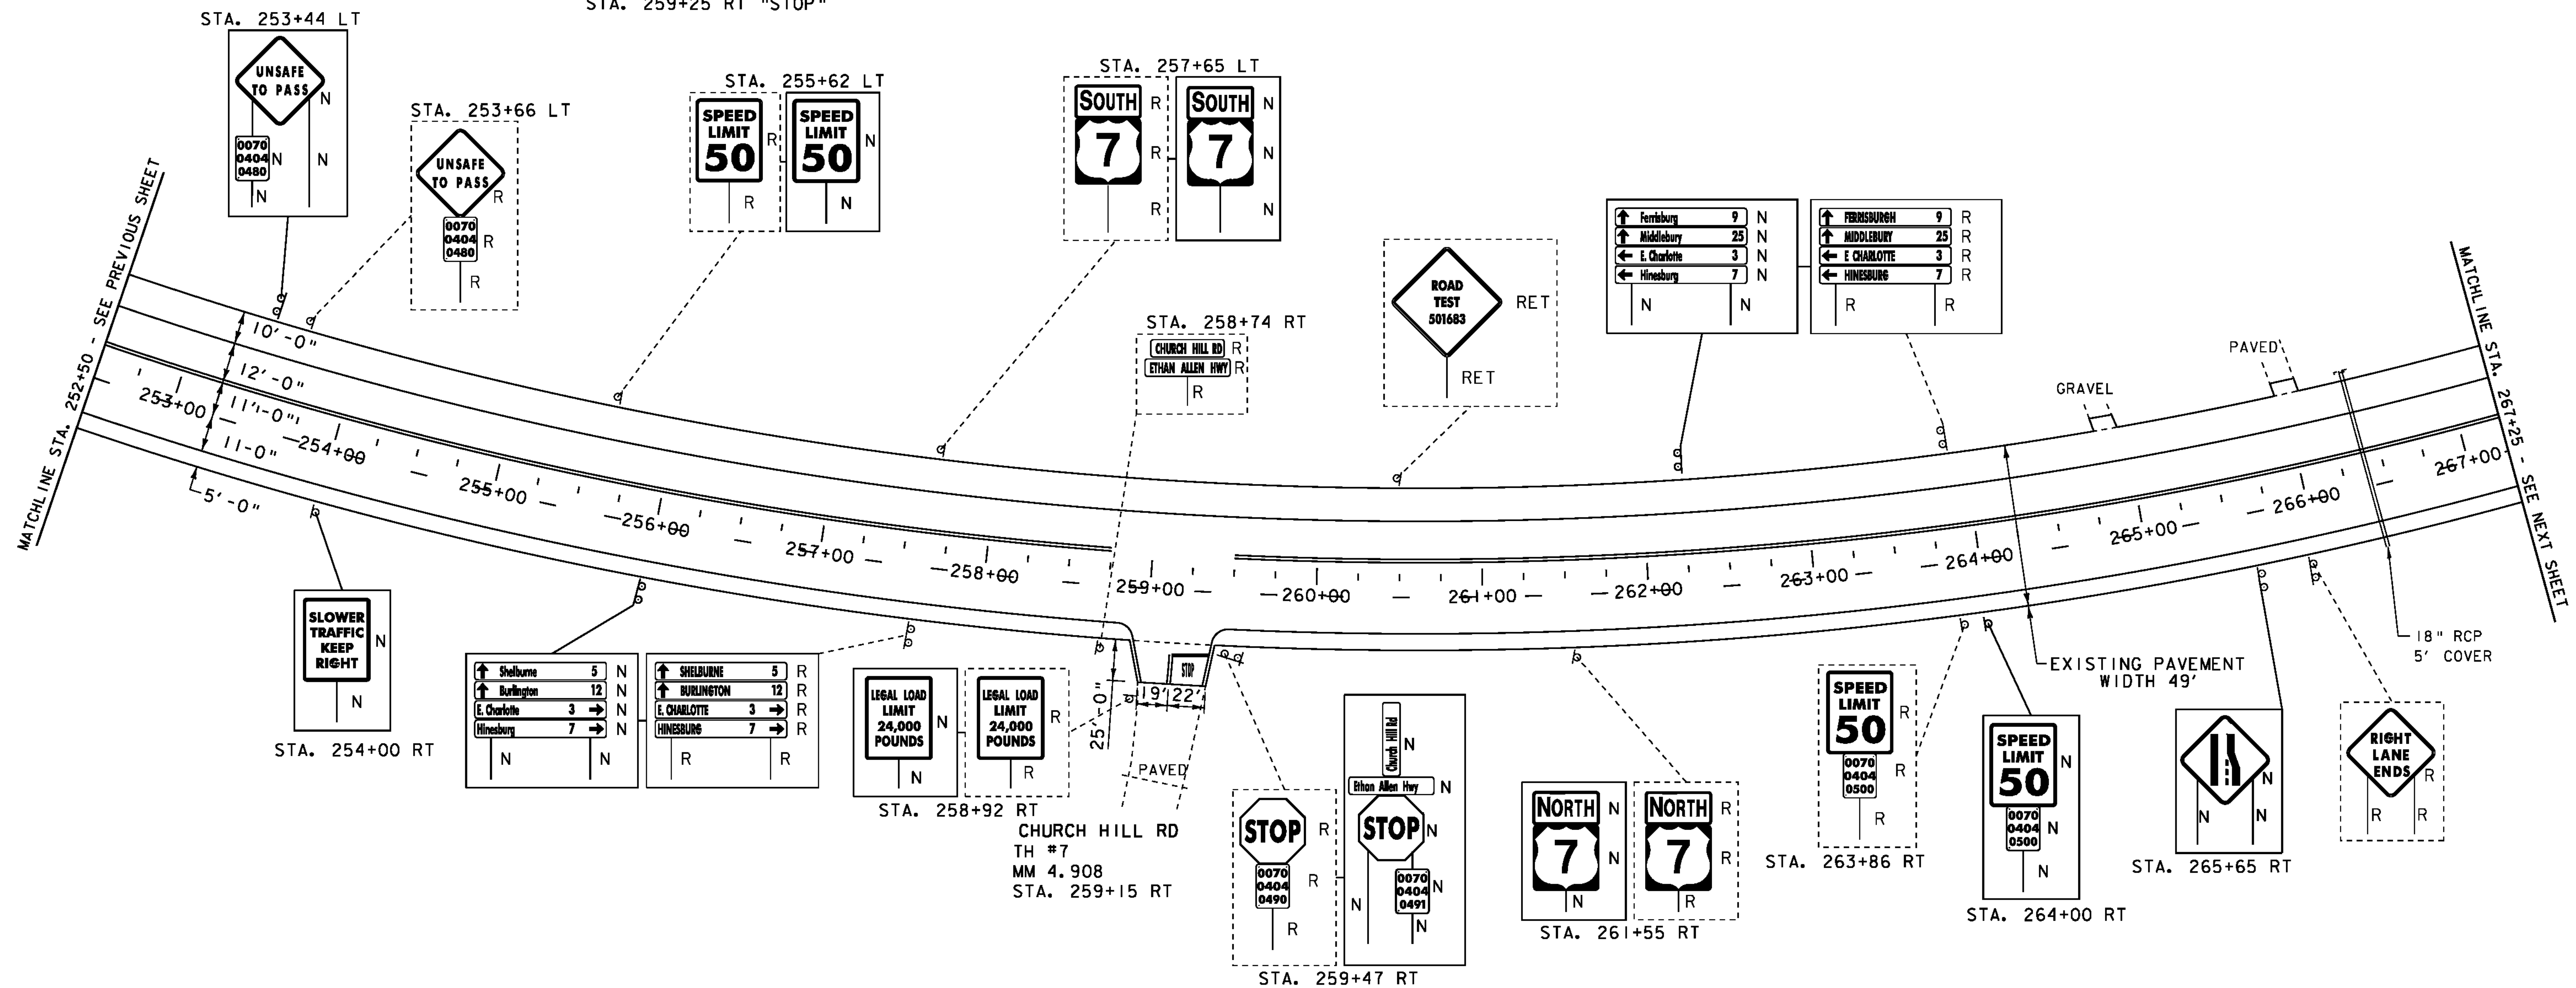

- LEGEND**
- SIGN
  - ⊕ HYDRANT
  - MANHOLE
  - VALVE
  - ⊗ GAS PIPELINE MARKER
  - ⊕ CATCH BASIN / DROP INLET
  - ⊕ CURB INLET
  - ⊕ TRAFFIC CONTROL BOX
  - ⊕ PARKING METER
  - ⊕ UTILITY POLE
  - ⊕ LIGHT POLE
  - ⊕ EX. DETECTABLE WARNINGS
  - ⊕ JUNCTION BOX
  - ⊕ PED BUTTON
  - ⊕ ELECTRICAL BOX
  - ⊕ SIGNAL
  - ⊕ PEDESTAL POST
  - ⊕ STRAIN POLE
  - ⊕ CAMERA
  - ⊕ VIDEO DETECTION ZONE

- SIGN LEGEND**
- R = REMOVE
  - R&S = REMOVE AND SALVAGE
  - RET = RETAIN
  - S = SALVAGE
  - N = NEW
  - B-B = BACK TO BACK

|                               |  |
|-------------------------------|--|
| <b>PROJECT LAYOUT SHEET 5</b> | PROJECT NAME: CHARLOTTE-SOUTH BURLINGTON |
|                               | PROJECT NUMBER: NH 2907(I)               |
| FILE NAME: p10B206.dgn        | PLOT DATE: 4/19/12                       |
| PROJECT LEADER: CDL           | DRAWN BY: BMB                            |
| DESIGNED BY: BMB              | CHECKED BY: EPD                          |
| PLOT FILE: p10B206_21.i       | SHEET 21 OF 107                          |

**NOT TO SCALE**