


STA. 267+25 - STA. 281+75 (SOLID LT & RT)
 STA. 267+25 - STA. 267+86 (DASHED RT)
 DURABLE 4 INCH YELLOW LINE, TYPE I TAPE
 STA. 267+25 - STA. 281+75 (CENTERLINE LT & RT)
 DURABLE LETTER OR SYMBOL, TYPE I TAPE
 STA. 267+65 RT LANE REDUCTION ARROW
 STA. 269+30 RT LANE REDUCTION ARROW
 STA. 270+95 RT LANE REDUCTION ARROW
 STA. 272+60 RT LANE REDUCTION ARROW
 STA. 274+25 RT LANE REDUCTION ARROW

TEMPORARY 4 INCH WHITE LINE, PAINT
 STA. 267+25 - STA. 281+75 (SOLID LT & RT)
 STA. 267+25 - STA. 267+86 (DASHED RT)
 TEMPORARY 4 INCH YELLOW LINE, PAINT
 STA. 267+25 - STA. 281+75 (CENTERLINE LT & RT)
 TEMPORARY LETTER OR SYMBOL, PAINT
 STA. 267+65 RT LANE REDUCTION ARROW
 STA. 269+30 RT LANE REDUCTION ARROW
 STA. 270+95 RT LANE REDUCTION ARROW
 STA. 272+60 RT LANE REDUCTION ARROW
 STA. 274+25 RT LANE REDUCTION ARROW

REMOVING SIGNS
 AS SHOWN - 3


NOTE:
 REMOVAL OF POST AT STA. 275+28 RT
 SHALL BE PAID FOR AS ITEM 675.50
 "REMOVING SIGNS"

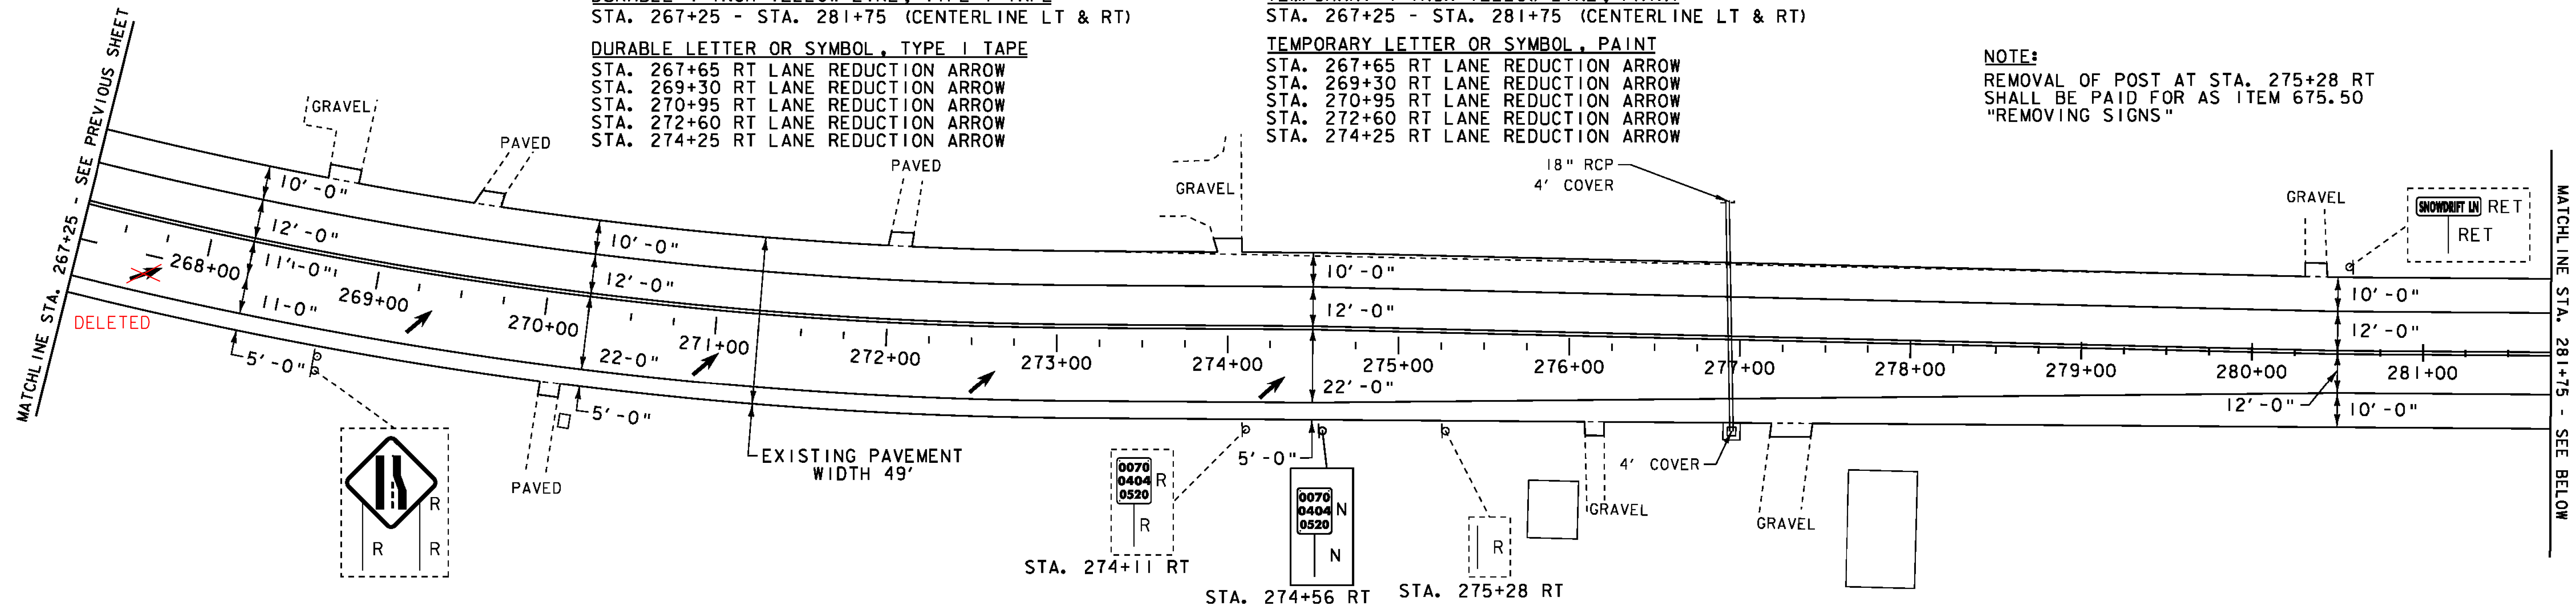

DURABLE 4 INCH WHITE LINE, TYPE I TAPE
 STA. 281+75 - STA. 296+50 (SOLID LT & RT)
 DURABLE 4 INCH YELLOW LINE, TYPE I TAPE
 STA. 281+75 - STA. 296+50 (SOLID LT & RT)

TEMPORARY 4 INCH WHITE LINE, PAINT
 STA. 281+75 - STA. 296+50 (SOLID LT & RT)
 TEMPORARY 4 INCH YELLOW LINE, PAINT
 STA. 281+75 - STA. 296+50 (SOLID LT & RT)

REMOVING SIGNS
 AS SHOWN - 4

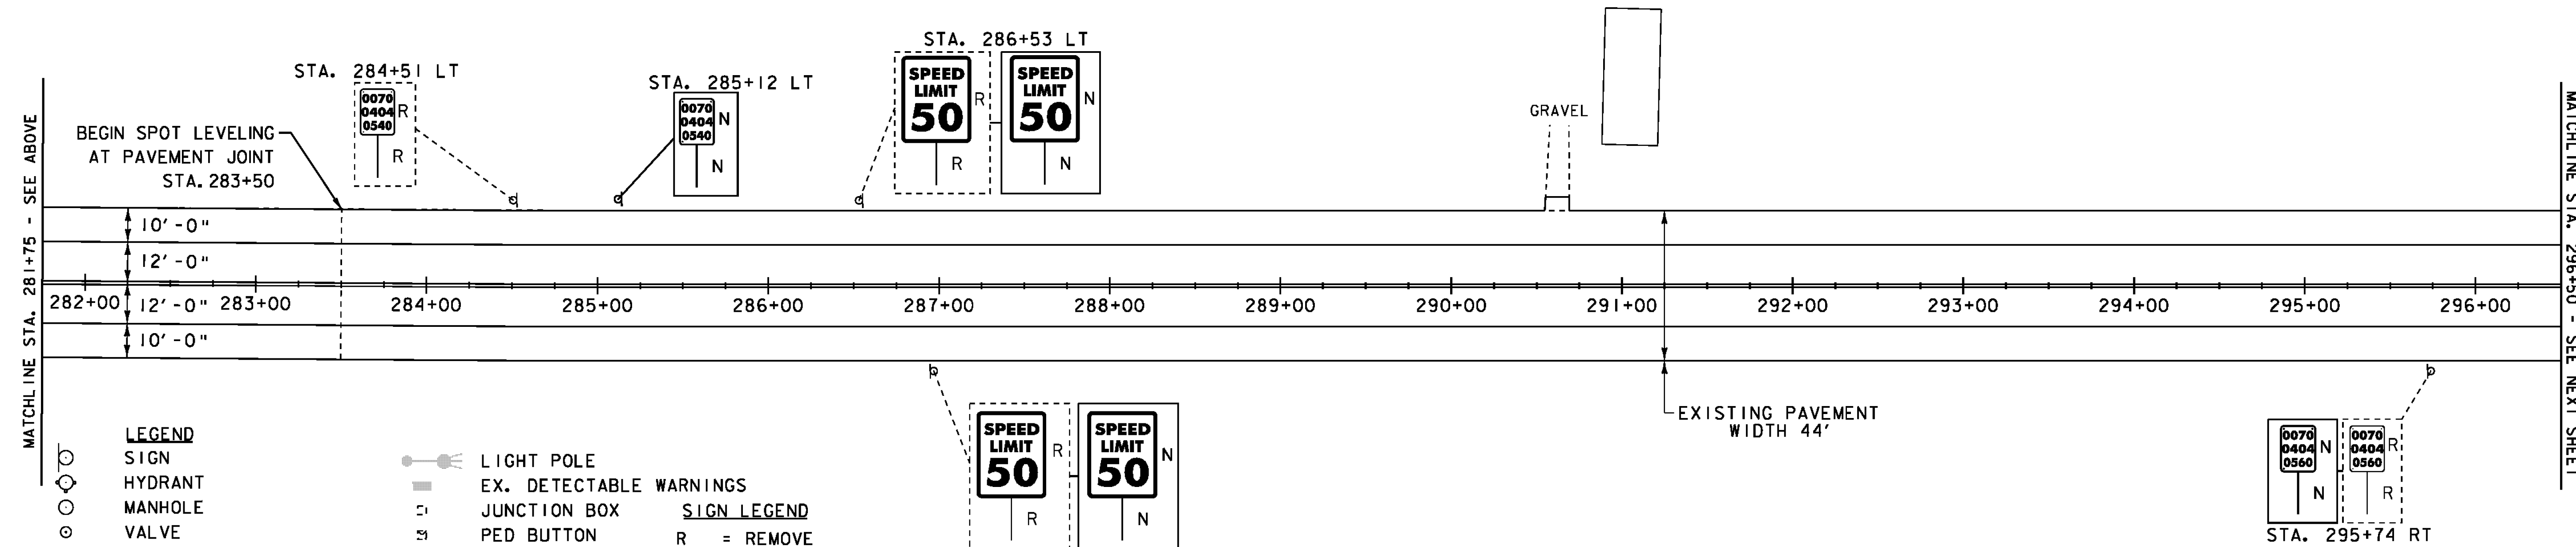

LEGEND

- | | | | |
|---|--------------------------|---|-------------------------|
| ○ | SIGN | ⊙ | LIGHT POLE |
| ⊙ | HYDRANT | ⊙ | EX. DETECTABLE WARNINGS |
| ⊙ | MANHOLE | ⊙ | JUNCTION BOX |
| ⊙ | VALVE | ⊙ | PED BUTTON |
| ⊙ | GAS PIPELINE MARKER | ⊙ | ELECTRICAL BOX |
| ⊙ | CATCH BASIN / DROP INLET | ⊙ | SIGNAL |
| ⊙ | CURB INLET | ⊙ | PEDESTAL POST |
| ⊙ | TRAFFIC CONTROL BOX | ⊙ | STRAIN POLE |
| ⊙ | PARKING METER | ⊙ | CAMERA |
| ⊙ | UTILITY POLE | ⊙ | VIDEO DETECTION ZONE |

SIGN LEGEND

- | | |
|-----|----------------------|
| R | = REMOVE |
| R&S | = REMOVE AND SALVAGE |
| RET | = RETAIN |
| S | = SALVAGE |
| N | = NEW |
| B-B | = BACK TO BACK |

PROJECT LAYOUT SHEET 6

PROJECT NAME: CHARLOTTE-SOUTH BURLINGTON
 PROJECT NUMBER: NH 2907(1)

FILE NAME: p10B206.dgn
 PROJECT LEADER: CDL
 DESIGNED BY: BMB
 PLOT FILE: p10B206_22.I

PLOT DATE: 4/19/12
 DRAWN BY: BMB
 CHECKED BY: EPD
 SHEET 22 OF 107

NOT TO SCALE