


DURABLE 4 INCH WHITE LINE, TYPE I TAPE
 STA. 326+75 - STA. 341+75 (SOLID LT & RT)

DURABLE 4 INCH YELLOW LINE, TYPE I TAPE
 STA. 326+75 - STA. 341+75 (SOLID LT & RT)

TEMPORARY 4 INCH WHITE LINE, PAINT
 STA. 326+75 - STA. 341+75 (SOLID LT & RT)

TEMPORARY 4 INCH YELLOW LINE, PAINT
 STA. 326+75 - STA. 341+75 (SOLID LT & RT)

REMOVING SIGNS
 AS SHOWN - 3

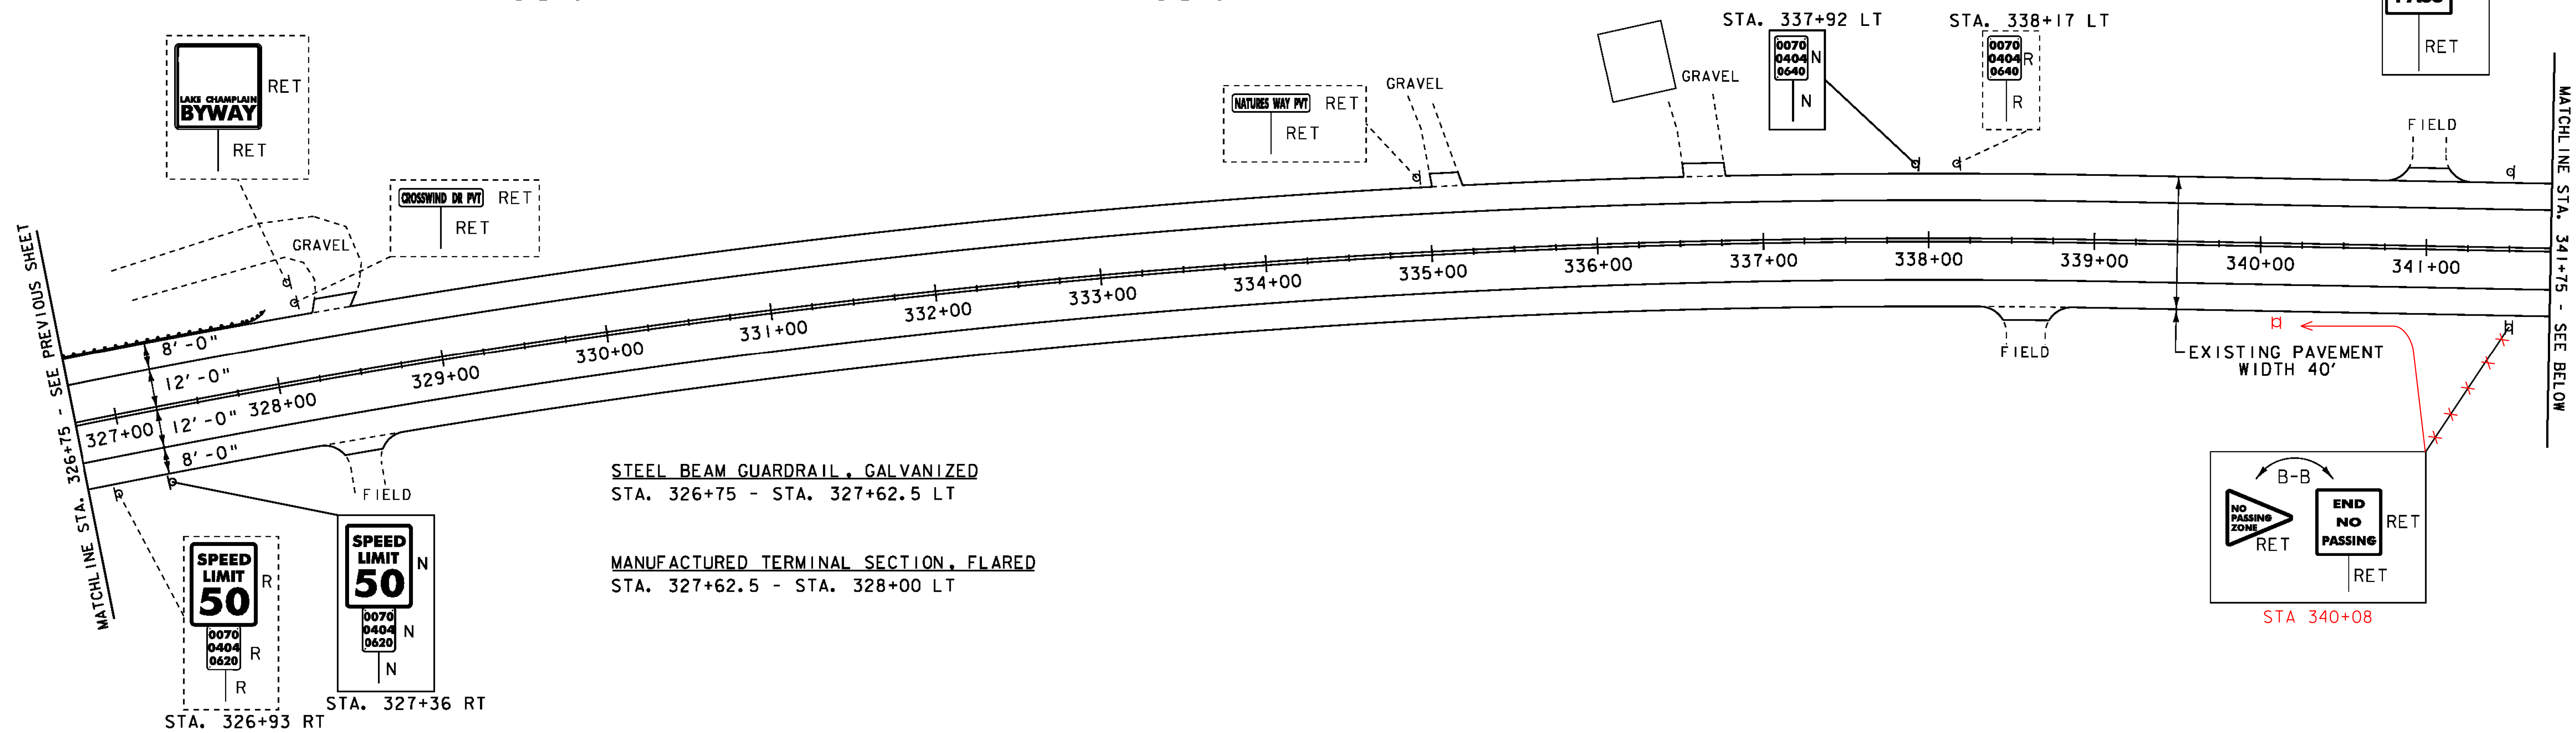

STEEL BEAM GUARDRAIL, GALVANIZED
 STA. 326+75 - STA. 327+62.5 LT

MANUFACTURED TERMINAL SECTION, FLARED
 STA. 327+62.5 - STA. 328+00 LT


DURABLE 4 INCH WHITE LINE, TYPE I TAPE
 STA. 341+75 - STA. 345+94.33 (SOLID LT & RT)
 STA. 0+00 - STA. 10+50 (SOLID LT & RT)

TEMPORARY 4 INCH WHITE LINE, PAINT
 STA. 341+75 - STA. 345+94.33 (SOLID LT & RT)
 STA. 0+00 - STA. 10+50 (SOLID LT & RT)

REMOVING SIGNS
 AS SHOWN - 4

DURABLE 4 INCH YELLOW LINE, TYPE I TAPE
 STA. 341+75 - STA. 345+94.33 (SOLID LT & RT)
 STA. 0+00 - STA. 1+50 (SOLID LT & RT)
 STA. 1+50 - STA. 10+25 (DASHED LT, SOLID RT)
 STA. 10+25 - STA. 10+50 (SOLID LT & RT)

TEMPORARY 4 INCH YELLOW LINE, PAINT
 STA. 341+75 - STA. 345+94.33 (SOLID LT & RT)
 STA. 0+00 - STA. 1+50 (SOLID LT & RT)
 STA. 1+50 - STA. 10+25 (DASHED LT, SOLID RT)
 STA. 10+25 - STA. 10+50 (SOLID LT & RT)

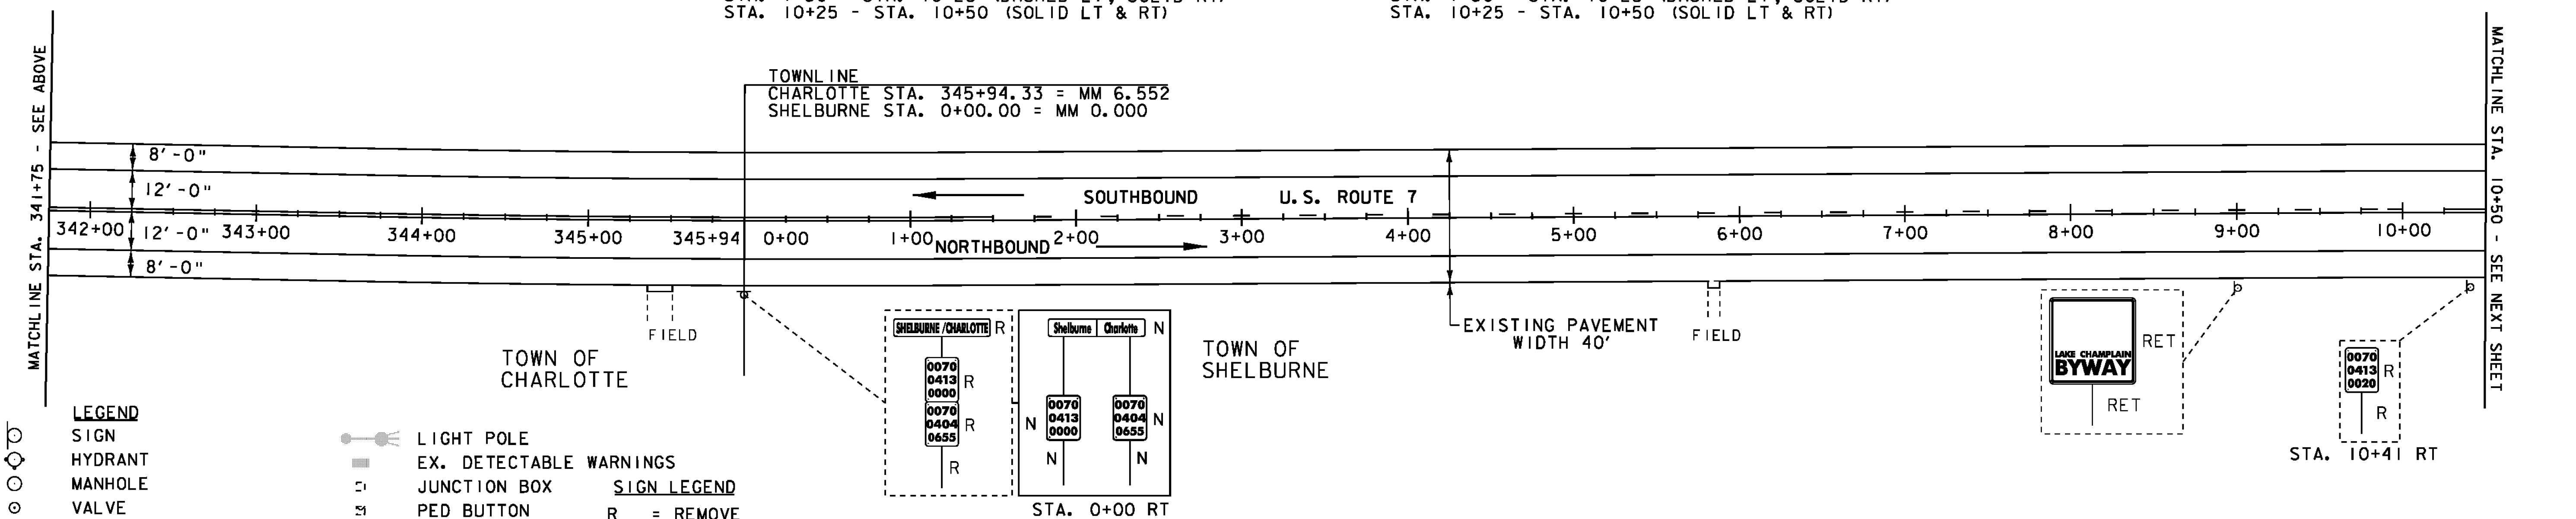

TOWN LINE
 CHARLOTTE STA. 345+94.33 = MM 6.552
 SHELBURNE STA. 0+00.00 = MM 0.000

TOWN OF CHARLOTTE

TOWN OF SHELBURNE

- LEGEND**
- SIGN
 - HYDRANT
 - MANHOLE
 - VALVE
 - GAS PIPELINE MARKER
 - CATCH BASIN / DROP INLET
 - CURB INLET
 - TRAFFIC CONTROL BOX
 - PARKING METER
 - UTILITY POLE

- LIGHT POLE
- EX. DETECTABLE WARNINGS
- JUNCTION BOX
- PED BUTTON
- ELECTRICAL BOX
- SIGNAL
- PEDESTAL POST
- STRAIN POLE
- CAMERA
- Vdz VIDEO DETECTION ZONE

- SIGN LEGEND**
- R = REMOVE
 - R&S = REMOVE AND SALVAGE
 - RET = RETAIN
 - S = SALVAGE
 - N = NEW
 - B-B = BACK TO BACK

NOT TO SCALE

PROJECT LAYOUT SHEET 8

PROJECT NAME: CHARLOTTE-SOUTH BURLINGTON
 PROJECT NUMBER: NH 2907(I)

FILE NAME: p10B206.dgn
 PROJECT LEADER: CDL
 DESIGNED BY: BMB
 PLOT FILE: p10B206_24.I

PLOT DATE: 4/19/12
 DRAWN BY: BMB
 CHECKED BY: EPD
 SHEET 24 OF 107