


REHAB, DROP INLETS, CATCH
BASINS, OR MANHOLES, CLASS I OR CLASS II
STA. 84+21 LT
STA. 86+72 LT

DURABLE 4 INCH WHITE LINE, TYPE I TAPE
STA. 81+50 - STA. 87+25 (SOLID LT & RT)
DURABLE 4 INCH YELLOW LINE, TYPE I TAPE
STA. 81+50 - STA. 87+25 (CENTERLINE LT)

TEMPORARY 4 INCH WHITE LINE, PAINT
STA. 81+50 - STA. 87+25 (SOLID LT & RT)
TEMPORARY 4 INCH YELLOW LINE, PAINT
STA. 81+50 - STA. 87+25 (CENTERLINE LT)

REMOVING SIGNS
AS SHOWN - 1

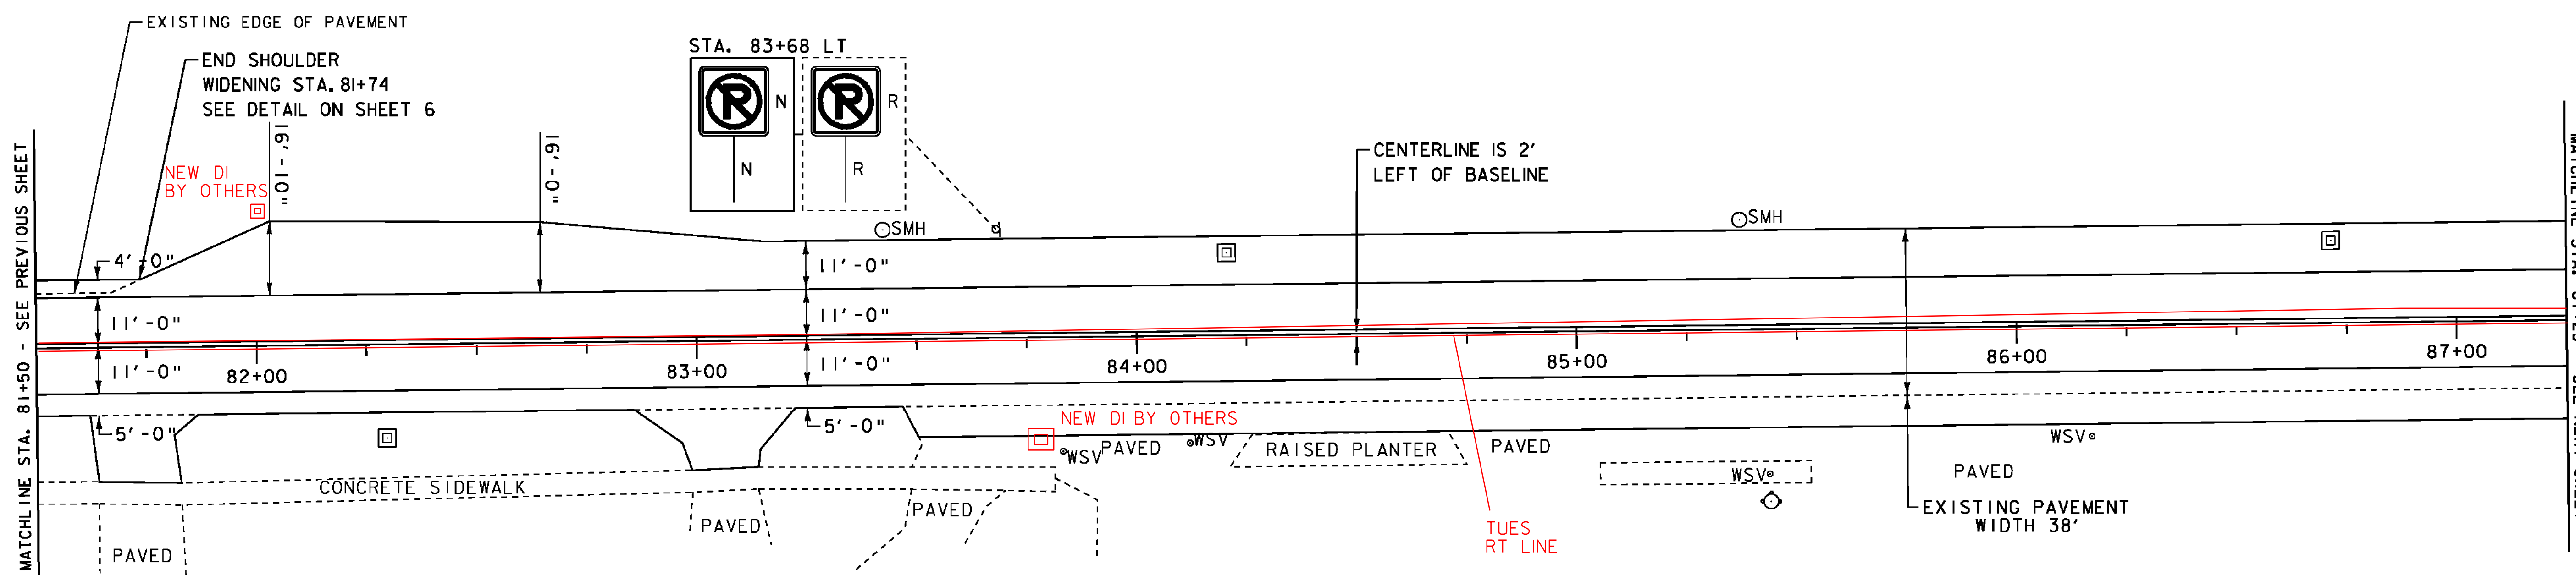

LEGEND

- | | | | |
|---|--------------------------|---|-------------------------|
| ○ | SIGN | ● | LIGHT POLE |
| ○ | HYDRANT | ■ | EX. DETECTABLE WARNINGS |
| ○ | MANHOLE | □ | JUNCTION BOX |
| ○ | VALVE | □ | PED BUTTON |
| ○ | GAS PIPELINE MARKER | □ | ELECTRICAL BOX |
| □ | CATCH BASIN / DROP INLET | □ | SIGNAL |
| □ | CURB INLET | □ | PEDESTAL POST |
| □ | TRAFFIC CONTROL BOX | □ | STRAIN POLE |
| □ | PARKING METER | □ | CAMERA |
| □ | UTILITY POLE | □ | VIDEO DETECTION ZONE |
-
- | | |
|-----|----------------------|
| | SIGN LEGEND |
| R | = REMOVE |
| R&S | = REMOVE AND SALVAGE |
| RET | = RETAIN |
| S | = SALVAGE |
| N | = NEW |
| B-B | = BACK TO BACK |

PROJECT LAYOUT SHEET 15

NOT TO SCALE

PROJECT NAME: CHARLOTTE-SOUTH BURLINGTON
PROJECT NUMBER: NH 2907(1)

FILE NAME: p10B206.dgn
PROJECT LEADER: CDL
DESIGNED BY: BMB
PLOT FILE: p10B206_31.l

PLOT DATE: 4/19/12
DRAWN BY: BMB
CHECKED BY: EPD
SHEET 31 OF 107