

REHAB. DROP INLETS, CATCH
BASINS, OR MANHOLES, CLASS I OR CLASS II
STA. 100+02 LT
STA. 101+69 RT
STA. 101+78 LT

CHANGING ELEVATION
OF SEWER MANHOLES
STA. 100+38 LT

REMOVAL OF EXISTING CURB
STA. 101+64 - STA. 101+74 RT

DURABLE 4 INCH WHITE LINE, TYPE I TAPE
STA. 98+25 - STA. 102+75 (SOLID LT & RT)
STA. 101+25 - STA. 102+00 (DOTTED RT)
STA. 102+00 - STA. 102+75 (SOLID RT)

DURABLE 4 INCH YELLOW LINE, TYPE I TAPE
STA. 98+25 - STA. 102+75 (CENTERLINE LT)
STA. 99+25 - STA. 102+00 (CENTERLINE LT & RT)

DURABLE 8 INCH YELLOW LINE, TYPE I TAPE
STA. 99+63 - STA. 101+77 (HATCHED LT & RT)

TEMPORARY 8 INCH YELLOW LINE, PAINT
STA. 99+63 - STA. 101+77 (HATCHED LT & RT)


DURABLE LETTER OR SYMBOL, TYPE I TAPE
STA. 102+05 RT ARROW
STA. 102+49 RT "ONLY"

TEMPORARY 4 INCH WHITE LINE, PAINT
STA. 98+25 - STA. 102+75 (SOLID LT & RT)
STA. 101+25 - STA. 102+00 (DOTTED RT)
STA. 102+00 - STA. 102+75 (SOLID RT)

TEMPORARY 4 INCH YELLOW LINE, PAINT
STA. 98+25 - STA. 102+75 (CENTERLINE LT)
STA. 99+25 - STA. 102+00 (CENTERLINE LT & RT)

TEMPORARY LETTER OR SYMBOL, PAINT
STA. 102+05 RT ARROW
STA. 102+49 RT "ONLY"

REMOVING SIGNS
AS SHOWN - 4

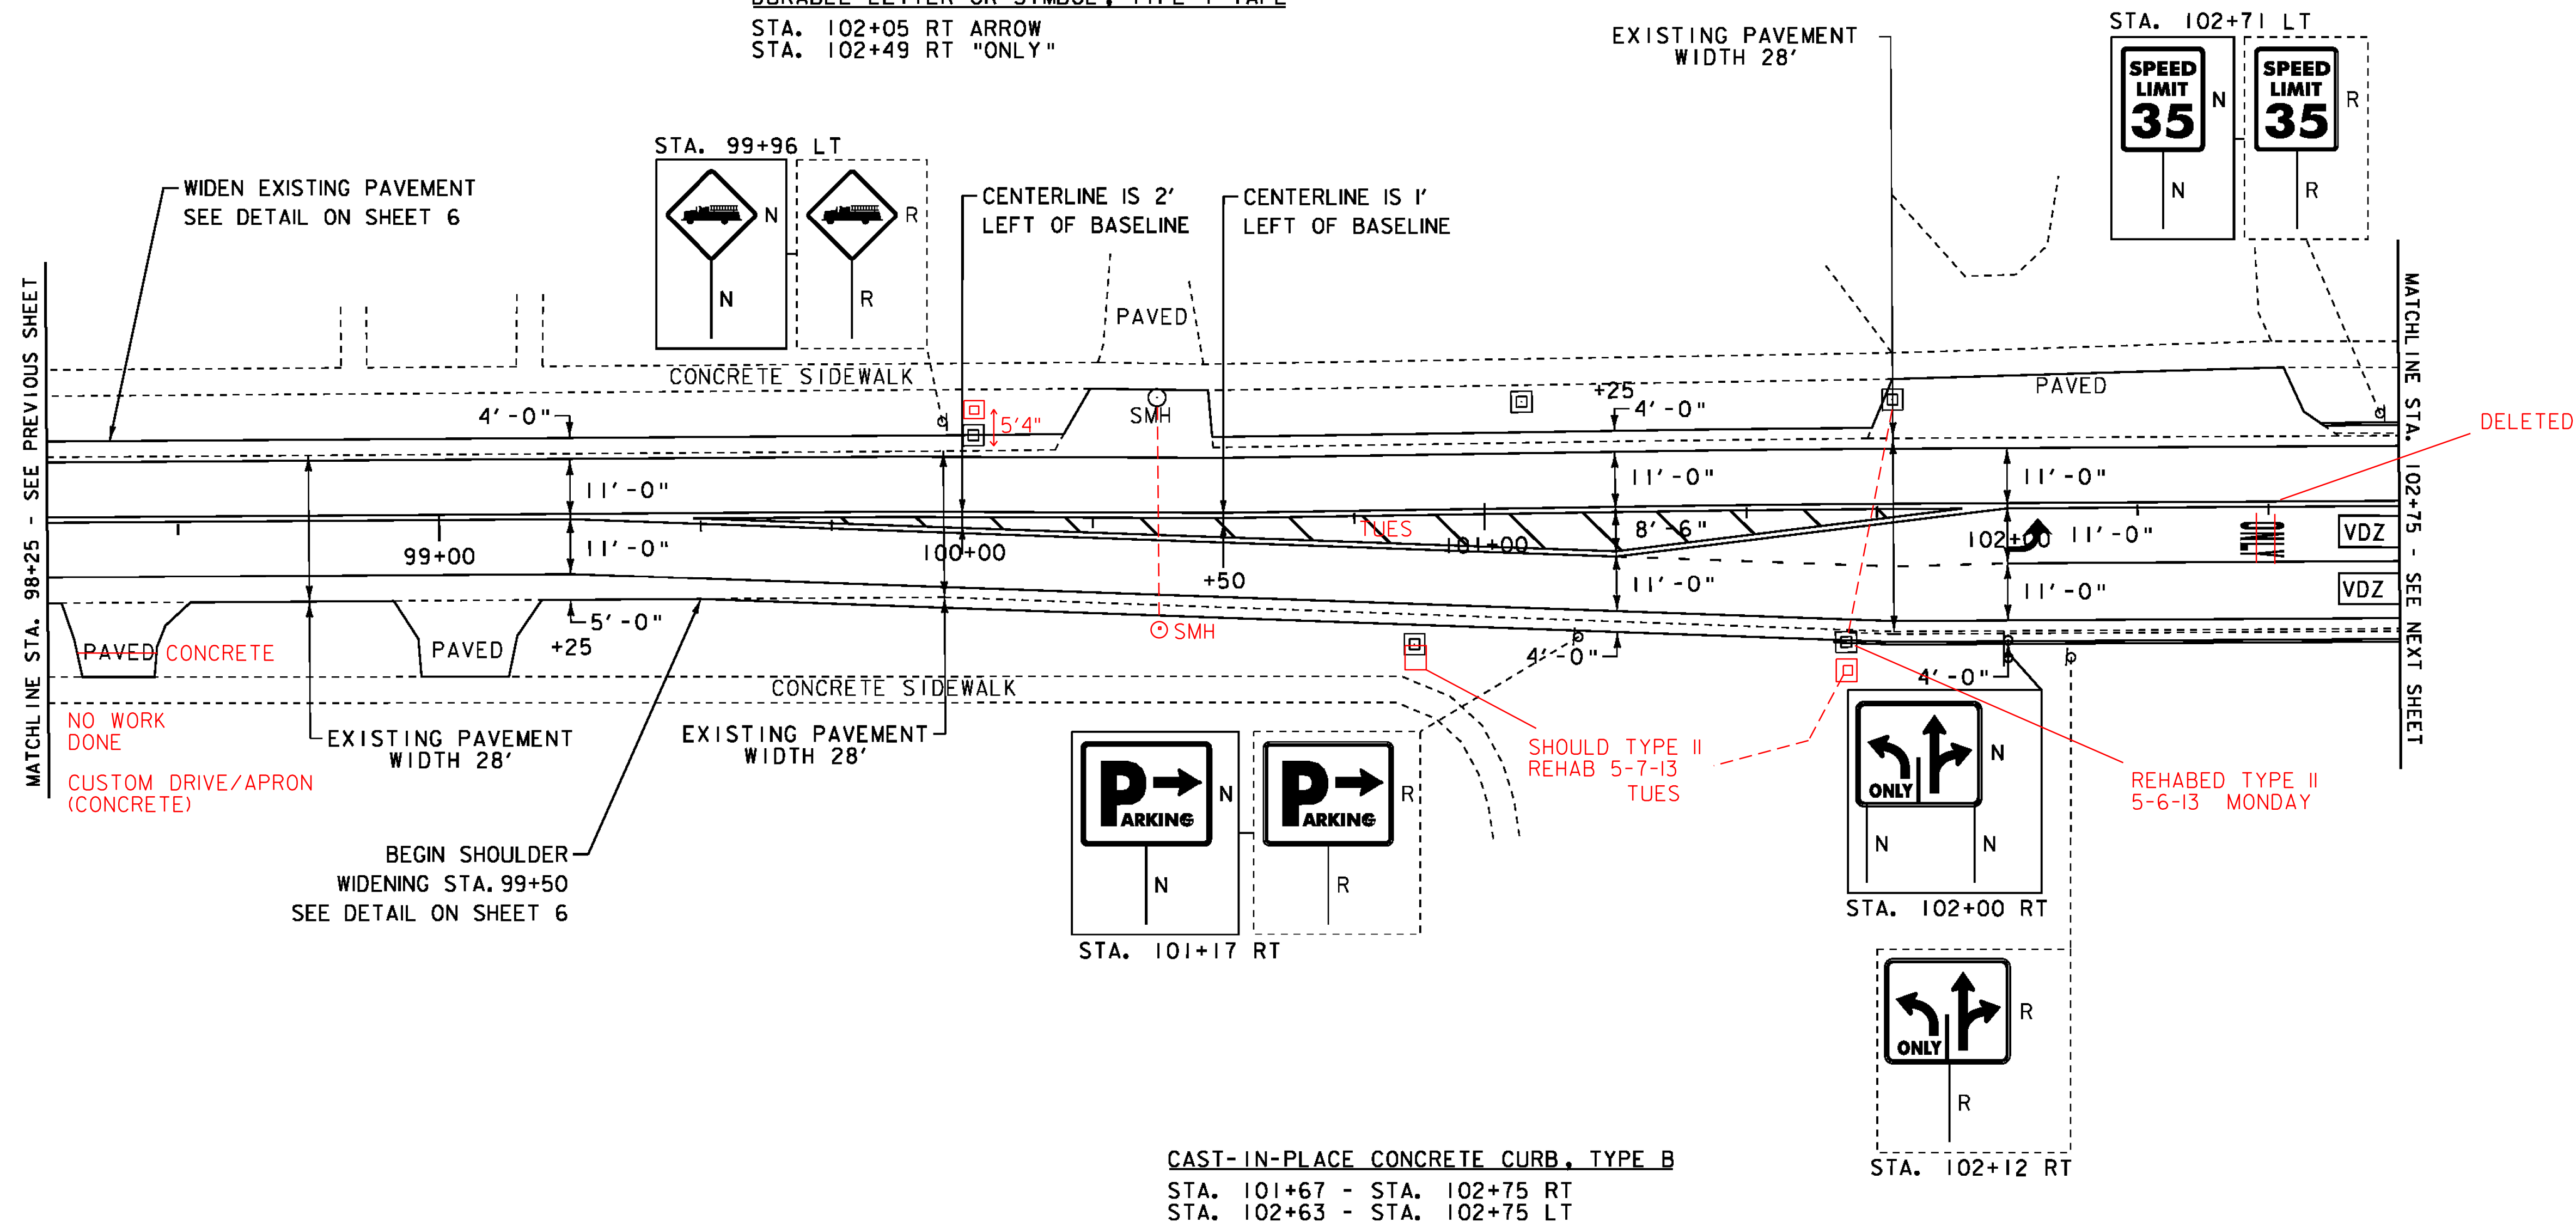

CAST-IN-PLACE CONCRETE CURB, TYPE B
STA. 101+67 - STA. 102+75 RT
STA. 102+63 - STA. 102+75 LT

LEGEND	
	SIGN
	HYDRANT
	MANHOLE
	VALVE
	GAS PIPELINE MARKER
	CATCH BASIN / DROP INLET
	CURB INLET
	TRAFFIC CONTROL BOX
	PARKING METER
	UTILITY POLE
	LIGHT POLE
	EX. DETECTABLE WARNINGS
	JUNCTION BOX
	PED BUTTON
	ELECTRICAL BOX
	SIGNAL
	PEDESTAL POST
	STRAIN POLE
	CAMERA
	VIDEO DETECTION ZONE
SIGN LEGEND	
R	= REMOVE
R&S	= REMOVE AND SALVAGE
RET	= RETAIN
S	= SALVAGE
N	= NEW
B-B	= BACK TO BACK

NOT TO SCALE

**PROJECT
LAYOUT
SHEET 18**

PROJECT NAME: CHARLOTTE-SOUTH BURLINGTON
PROJECT NUMBER: NH 2907(1)

FILE NAME: p10B206.dgn
PROJECT LEADER: CDL
DESIGNED BY: BMB
PLOT FILE: p10B206_34.I

PLOT DATE: 4/19/12
DRAWN BY: BMB
CHECKED BY: EPD
SHEET 34 OF 107