

DURABLE 4 INCH WHITE LINE, TYPE I TAPE
 STA. 108+25 - STA. 113+75 (SOLID LT & RT)
 STA. 112+25 - STA. 113+25 (DOTTED RT)
 STA. 113+25 - STA. 113+75 (SOLID RT)

DURABLE 4 INCH YELLOW LINE, TYPE I TAPE
 STA. 108+25 - STA. 113+75 (SOLID LT & RT)
 STA. 111+50 - STA. 113+25 (CENTERLINE RT)

DURABLE 8 INCH YELLOW LINE, TYPE I TAPE
 STA. 111+82 - STA. 112+82 (HATCHED RT)

TEMPORARY 8 INCH YELLOW LINE, PAINT
 STA. 111+82 - STA. 112+82 (HATCHED RT)

DURABLE LETTER OR SYMBOL, TYPE I TAPE
 STA. 110+34 LT "AHEAD"
 STA. 110+74 LT "SIGNAL"
 STA. 113+29 RT ARROW
 STA. 113+68 RT "ONLY"


TEMPORARY 4 INCH WHITE LINE, PAINT
 STA. 108+25 - STA. 113+75 (SOLID LT & RT)
 STA. 112+25 - STA. 113+25 (DOTTED RT)
 STA. 113+25 - STA. 113+75 (SOLID RT)

TEMPORARY 4 INCH YELLOW LINE, PAINT
 STA. 108+25 - STA. 113+75 (SOLID LT & RT)
 STA. 111+50 - STA. 113+25 (CENTERLINE RT)

CHANGING ELEVATION OF SEWER MANHOLES
 STA. 111+21 RT

TEMPORARY LETTER OR SYMBOL, PAINT
 STA. 110+34 LT "AHEAD"
 STA. 110+74 LT "SIGNAL"
 STA. 113+29 RT ARROW
 STA. 113+68 RT "ONLY"

REMOVING SIGNS
 AS SHOWN - 3

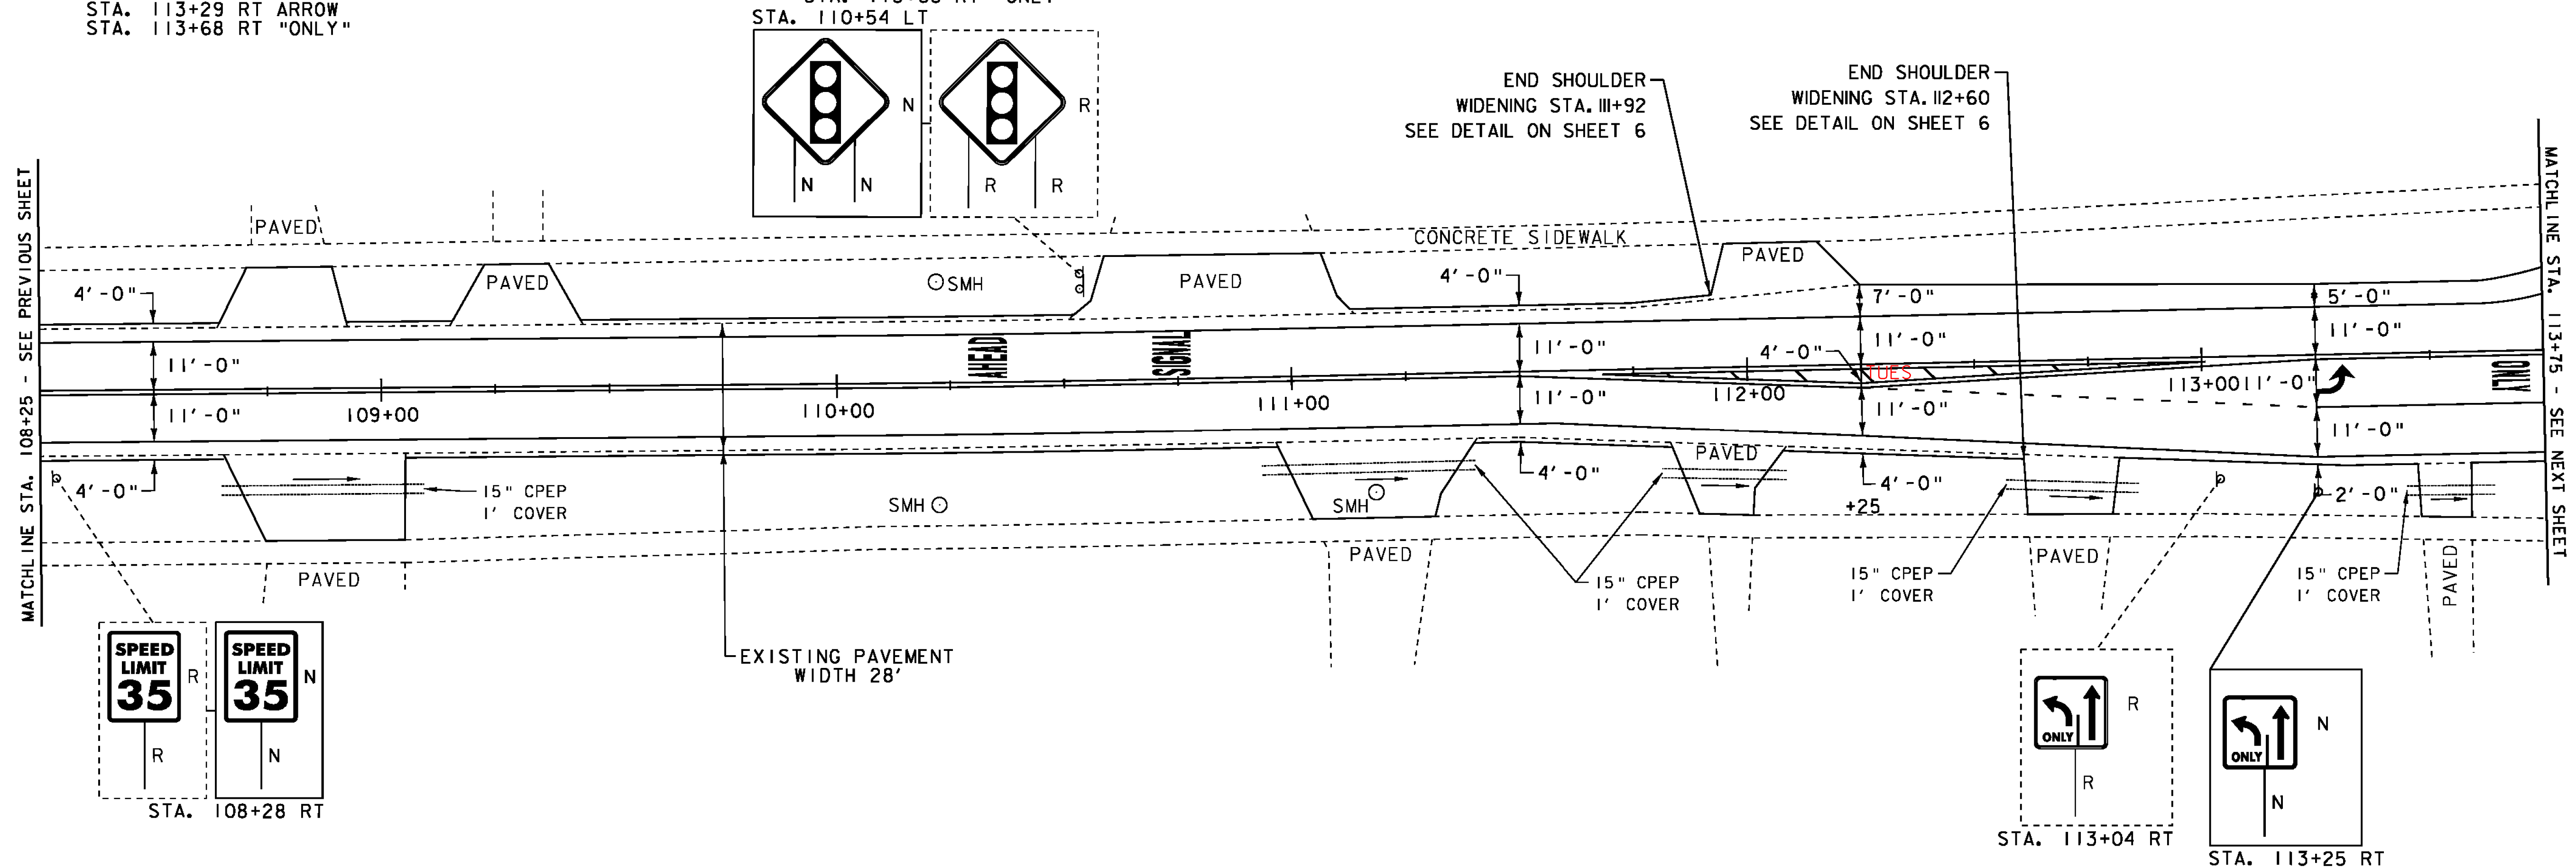

	SIGN		LIGHT POLE
	HYDRANT		EX. DETECTABLE WARNINGS
	MANHOLE		JUNCTION BOX
	VALVE		PED BUTTON
	GAS PIPELINE MARKER		ELECTRICAL BOX
	CATCH BASIN / DROP INLET		SIGNAL
	CURB INLET		PEDESTAL POST
	TRAFFIC CONTROL BOX		STRAIN POLE
	PARKING METER		CAMERA
	UTILITY POLE		VDZ

SIGN LEGEND	
R	= REMOVE
R&S	= REMOVE AND SALVAGE
RET	= RETAIN
S	= SALVAGE
N	= NEW
B-B	= BACK TO BACK

NOT TO SCALE

PROJECT LAYOUT SHEET 20	PROJECT NAME: CHARLOTTE-SOUTH BURLINGTON
	PROJECT NUMBER: NH 2907(1)
FILE NAME: p10B206.dgn	PLOT DATE: 4/19/12
PROJECT LEADER: CDL	DRAWN BY: BMB
DESIGNED BY: BMB	CHECKED BY: EPD
PLOT FILE: p10B206_36.plt	SHEET 36 OF 107