

DURABLE 4 INCH WHITE LINE, TYPE I TAPE

STA. 113+75 - STA. 114+08 (SOLID LT)
 STA. 113+75 - STA. 114+11 (SOLID RT)
 STA. 113+75 - STA. 119+50 (SOLID RT)
 STA. 114+52 - STA. 115+50 (SOLID LT)
 STA. 114+59 - STA. 119+50 (SOLID LT)
 STA. 115+50 - STA. 117+00 (DOTTED LT)

DURABLE 4 INCH YELLOW LINE, TYPE I TAPE

STA. 113+75 - STA. 114+10 (SOLID LT & RT)
 STA. 114+47 - STA. 119+50 (SOLID LT & RT)
 STA. 114+47 - STA. 117+50 (CENTERLINE RT)

DURABLE 8 INCH YELLOW LINE, TYPE I TAPE

STA. 114+48 - STA. 117+02 (HATCHED RT)
TEMPORARY 8 INCH YELLOW LINE, PAINT
 STA. 114+48 - STA. 117+02 (HATCHED RT)

DURABLE LETTER OR SYMBOL, TYPE I TAPE

STA. 114+06 RT ARROW STA. 115+01 LT "ONLY"
 STA. 114+56 LT ARROW STA. 115+56 LT ARROW

TEMPORARY 4 INCH WHITE LINE, PAINT

STA. 113+75 - STA. 114+08 (SOLID LT)
 STA. 113+75 - STA. 114+11 (SOLID RT)
 STA. 113+75 - STA. 119+50 (SOLID RT)
 STA. 114+52 - STA. 115+50 (SOLID LT)
 STA. 114+59 - STA. 119+50 (SOLID LT)
 STA. 115+50 - STA. 117+00 (DOTTED LT)

TEMPORARY 4 INCH YELLOW LINE, PAINT


STA. 113+75 - STA. 114+10 (SOLID LT & RT)
 STA. 114+47 - STA. 119+50 (SOLID LT & RT)
 STA. 114+47 - STA. 117+50 (CENTERLINE RT)

TEMPORARY LETTER OR SYMBOL, PAINT

STA. 114+06 RT ARROW STA. 115+01 LT "ONLY"
 STA. 114+56 LT ARROW STA. 115+56 LT ARROW

REMOVING SIGNS

AS SHOWN - 4

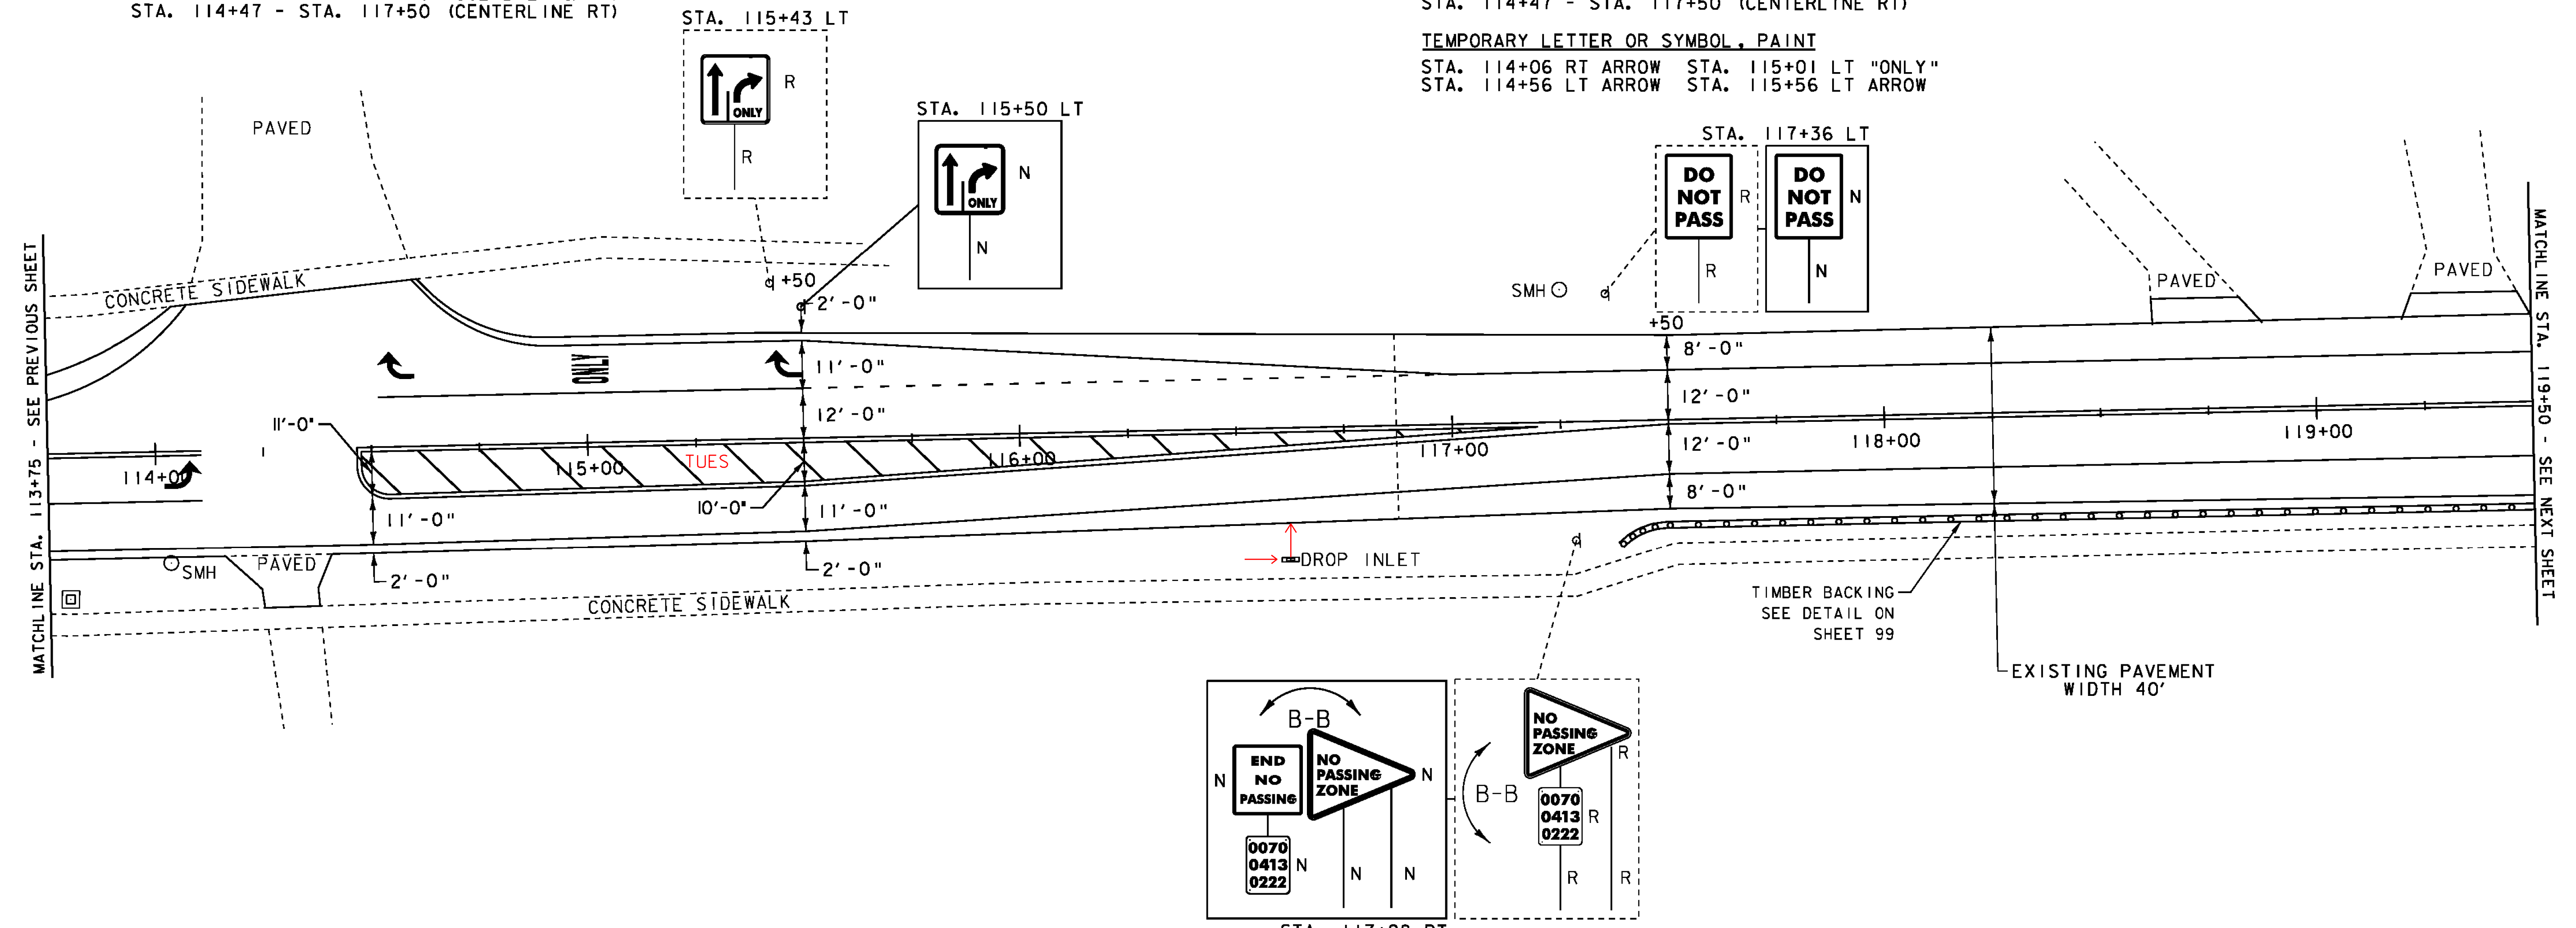

STEEL BEAM GUARDRAIL, GALVANIZED

STA. 117+38 - STA. 119+50 RT

ANCHOR FOR STEEL BEAM RAIL


STA. 117+38 RT

REMOVAL & DISPOSAL OF GUARDRAIL

STA. 117+38 - STA. 119+50 RT

SPECIAL PROVISION (TIMBER BACKING FOR GUARDRAIL)

STA. 117+38 - STA. 119+50 RT (SEE SHEET 99 FOR DETAILS)

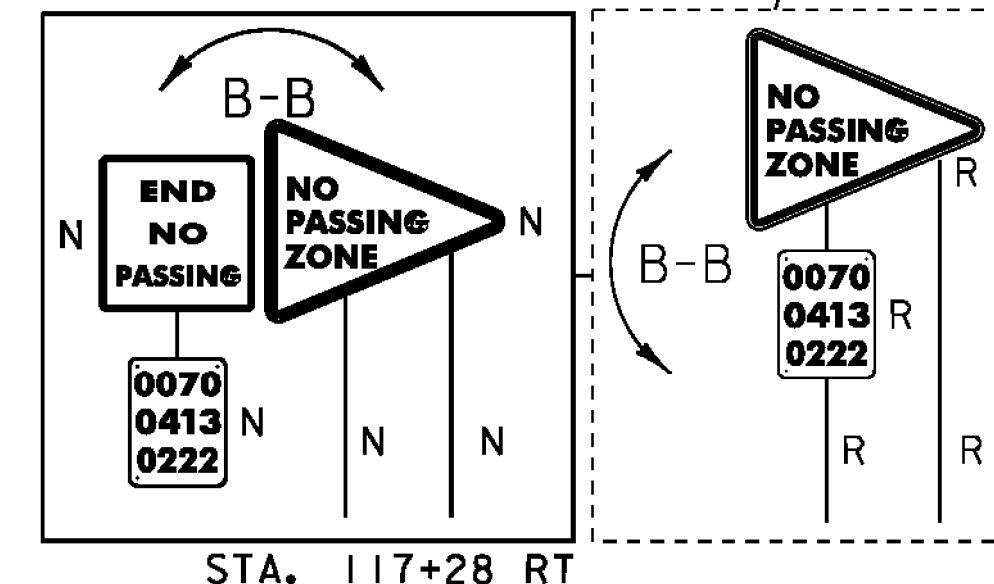

STA. 117+28 RT

LEGEND

- | | | | |
|---|--------------------------|---|-------------------------|
| ○ | SIGN | ● | LIGHT POLE |
| ○ | HYDRANT | ■ | EX. DETECTABLE WARNINGS |
| ○ | MANHOLE | □ | JUNCTION BOX |
| ○ | VALVE | □ | PED BUTTON |
| ○ | GAS PIPELINE MARKER | □ | ELECTRICAL BOX |
| □ | CATCH BASIN / DROP INLET | □ | SIGNAL |
| □ | CURB INLET | □ | PEDESTAL POST |
| □ | TRAFFIC CONTROL BOX | □ | STRAIN POLE |
| □ | PARKING METER | □ | CAMERA |
| □ | UTILITY POLE | □ | VIDEO DETECTION ZONE |
-
- | | |
|--------------------|----------------------|
| SIGN LEGEND | |
| R | = REMOVE |
| R&S | = REMOVE AND SALVAGE |
| RET | = RETAIN |
| S | = SALVAGE |
| N | = NEW |
| B-B | = BACK TO BACK |

NOT TO SCALE

PROJECT LAYOUT SHEET 21	PROJECT NAME: CHARLOTTE-SOUTH BURLINGTON
	PROJECT NUMBER: NH 2907(1)
	FILE NAME: p10B206.dgn
	PLOT DATE: 4/19/12
PROJECT LEADER: CDL	DRAWN BY: BMB
DESIGNED BY: BMB	CHECKED BY: EPD
PLOT FILE: p10B206_37.1	SHEET 37 OF 107