

**DURABLE 4 INCH WHITE LINE, TYPE I TAPE**  
 STA. 119+50 - STA. 125+25 (SOLID LT & RT)  
 STA. 125+00 - STA. 125+25 (DOTTED RT)

**DURABLE 4 INCH YELLOW LINE, TYPE I TAPE**  
 STA. 119+50 - STA. 125+25 (SOLID LT & RT)  
 STA. 123+00 - STA. 125+25 (CENTERLINE RT)

**DURABLE 8 INCH YELLOW LINE, TYPE I TAPE**  
 STA. 123+25 - STA. 125+25 (HATCHED RT)

**TEMPORARY 4 INCH WHITE LINE, PAINT**  
 STA. 119+50 - STA. 125+25 (SOLID LT & RT)  
 STA. 125+00 - STA. 125+25 (DOTTED RT)


**TEMPORARY 4 INCH YELLOW LINE, PAINT**  
 STA. 119+50 - STA. 125+25 (SOLID LT & RT)  
 STA. 123+00 - STA. 125+25 (CENTERLINE RT)

**TEMPORARY 8 INCH YELLOW LINE, PAINT**  
 STA. 123+25 - STA. 125+25 (HATCHED RT)

**REMOVING SIGNS**  
 AS SHOWN - 4

**ERECTING SALVAGED SIGNS**  
 AS SHOWN - 2

**REMOVAL OF EXISTING CURB**  
 STA. 125+23 - STA. 125+25 RT

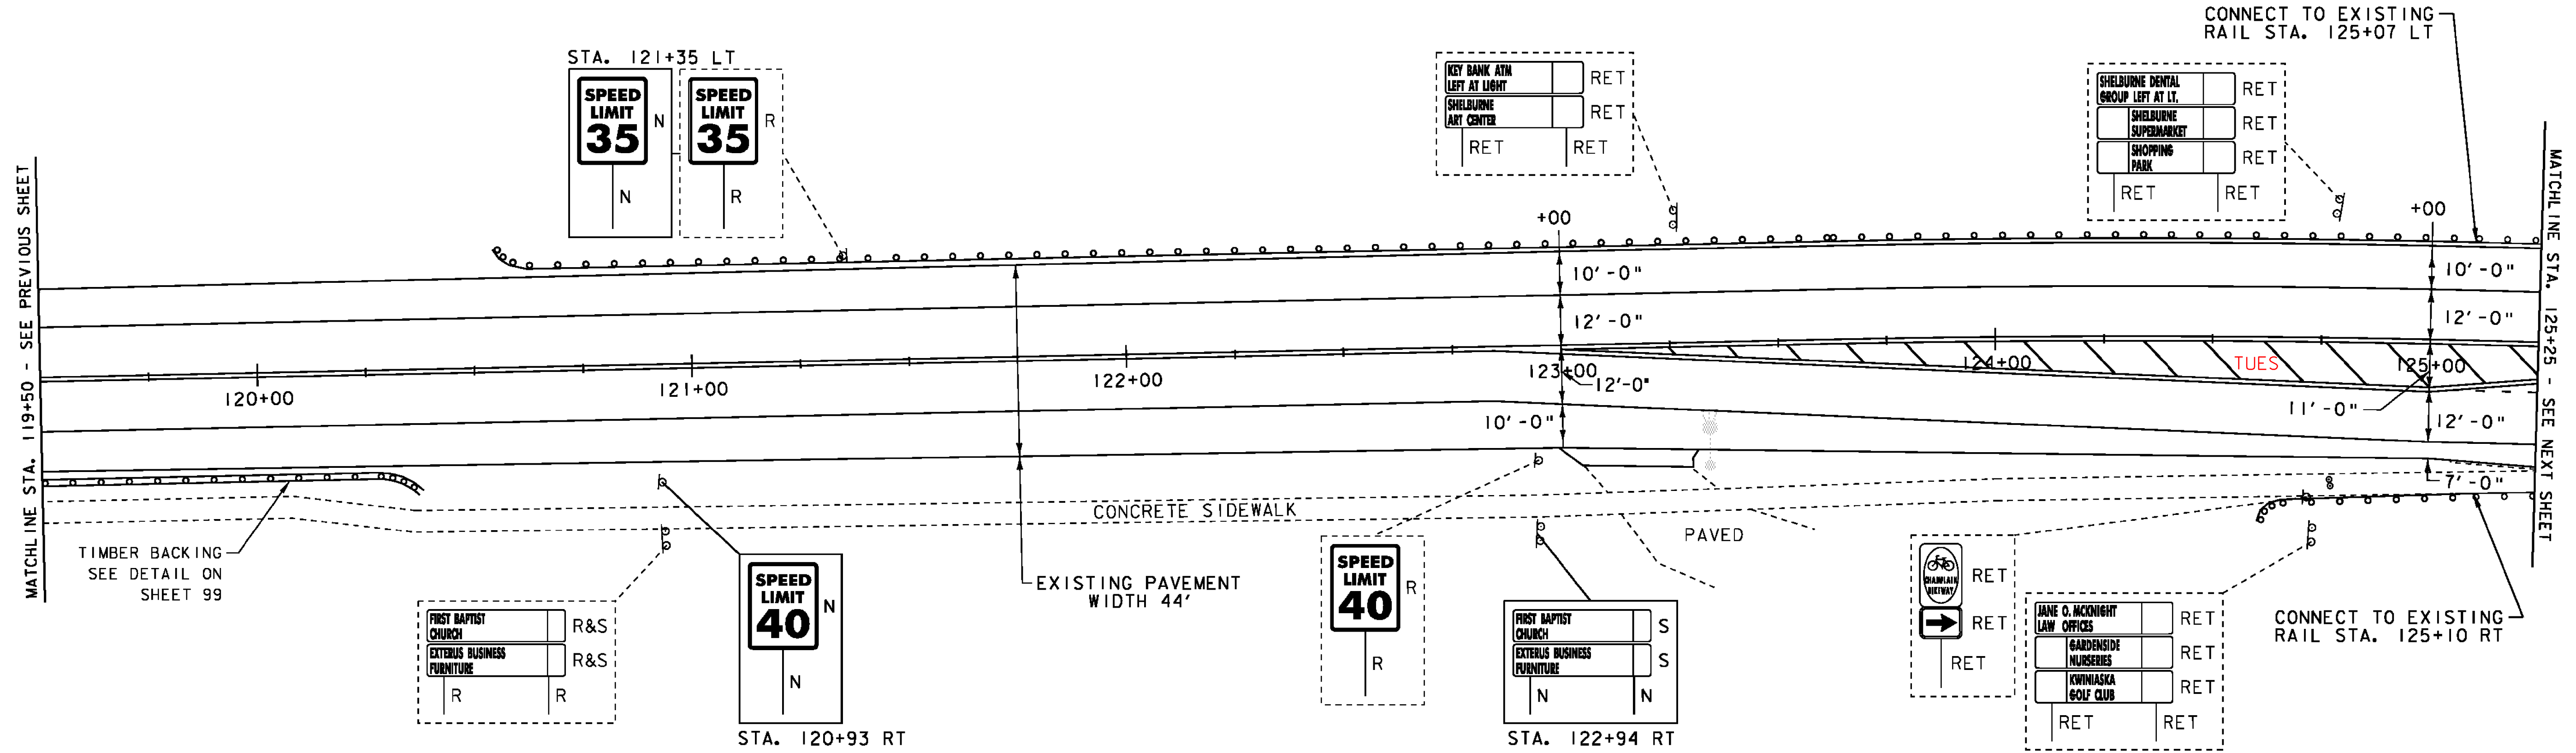

**STEEL BEAM GUARDRAIL, GALVANIZED**  
 STA. 119+50 - STA. 120+38 RT  
 STA. 120+57 - STA. 125+07 LT  
 STA. 124+60 - STA. 125+10 RT

**ANCHOR FOR STEEL BEAM RAIL**  
 STA. 120+38 RT  
 STA. 120+57 LT  
 STA. 124+60 RT

**REMOVAL & DISPOSAL OF GUARDRAIL**  
 STA. 119+50 - STA. 120+38 RT  
 STA. 120+57 - STA. 125+07 LT  
 STA. 124+60 - STA. 125+10 RT

**SPECIAL PROVISION (TIMBER BACKING FOR GUARDRAIL)**  
 STA. 119+50 - STA. 120+38 RT (SEE SHEET 99 FOR DETAILS)

**REMOVE AND RESET GUARDRAIL**  
 STA. 125+10 - STA. 125+25 RT

**LEGEND**

- SIGN
- HYDRANT
- MANHOLE
- VALVE
- GAS PIPELINE MARKER
- CATCH BASIN / DROP INLET
- CURB INLET
- TRAFFIC CONTROL BOX
- PARKING METER
- UTILITY POLE

- LIGHT POLE
  - EX. DETECTABLE WARNINGS
  - JUNCTION BOX
  - PED BUTTON
  - ELECTRICAL BOX
  - SIGNAL
  - PEDESTAL POST
  - STRAIN POLE
  - CAMERA
  - VIZ VIDEO DETECTION ZONE
- SIGN LEGEND**
- R = REMOVE
  - R&S = REMOVE AND SALVAGE
  - RET = RETAIN
  - S = SALVAGE
  - N = NEW
  - B-B = BACK TO BACK

**NOT TO SCALE**

<b>PROJECT LAYOUT SHEET 22</b>	PROJECT NAME: CHARLOTTE-SOUTH BURLINGTON	PLOT DATE: 4/19/12
	PROJECT NUMBER: NH 2907(1)	DRAWN BY: BMB
	FILE NAME: p10B206.dgn	CHECKED BY: EPD
	DESIGNED BY: BMB	SHEET 38 OF 107
	PLOT FILE: p10B206_38.I	