

DURABLE 4 INCH WHITE LINE, TYPE I TAPE  
 STA. 130+75 - STA. 136+25 (SOLID LT & RT)  
 STA. 130+75 - STA. 131+90 (SOLID RT)

DURABLE 4 INCH YELLOW LINE, TYPE I TAPE  
 STA. 130+75 - STA. 131+88 (SOLID LT & RT)  
 STA. 132+25 - STA. 136+25 (SOLID LT & RT)  
 STA. 132+25 - STA. 135+50 (CENTERLINE RT)

DURABLE 8 INCH YELLOW LINE, TYPE I TAPE  
 STA. 132+51 - STA. 135+15 (HATCHED RT)

DURABLE LETTER OR SYMBOL, TYPE I TAPE  
 STA. 131+05 RT "ONLY"  
 STA. 131+81 RT ARROW


TEMPORARY 4 INCH WHITE LINE, PAINT  
 STA. 130+75 - STA. 136+25 (SOLID LT & RT)  
 STA. 130+75 - STA. 131+90 (SOLID RT)

TEMPORARY 4 INCH YELLOW LINE, PAINT  
 STA. 130+75 - STA. 131+88 (SOLID LT & RT)  
 STA. 132+25 - STA. 136+25 (SOLID LT & RT)  
 STA. 132+25 - STA. 135+50 (CENTERLINE RT)

TEMPORARY 8 INCH YELLOW LINE, PAINT  
 STA. 132+51 - STA. 135+15 (HATCHED RT)

TEMPORARY LETTER OR SYMBOL, PAINT  
 STA. 131+05 RT "ONLY"  
 STA. 131+81 RT ARROW

REMOVING SIGNS  
 AS SHOWN - I  
REHAB, DROP INLETS, CATCH BASINS, OR MANHOLES, CLASS I OR CLASS II  
 STA. 132+90 RT  
 STA. 134+40 RT  
REMOVAL OF EXISTING CURB  
 STA. 132+85 - STA. 132+95 RT  
 STA. 134+35 - STA. 134+45 RT

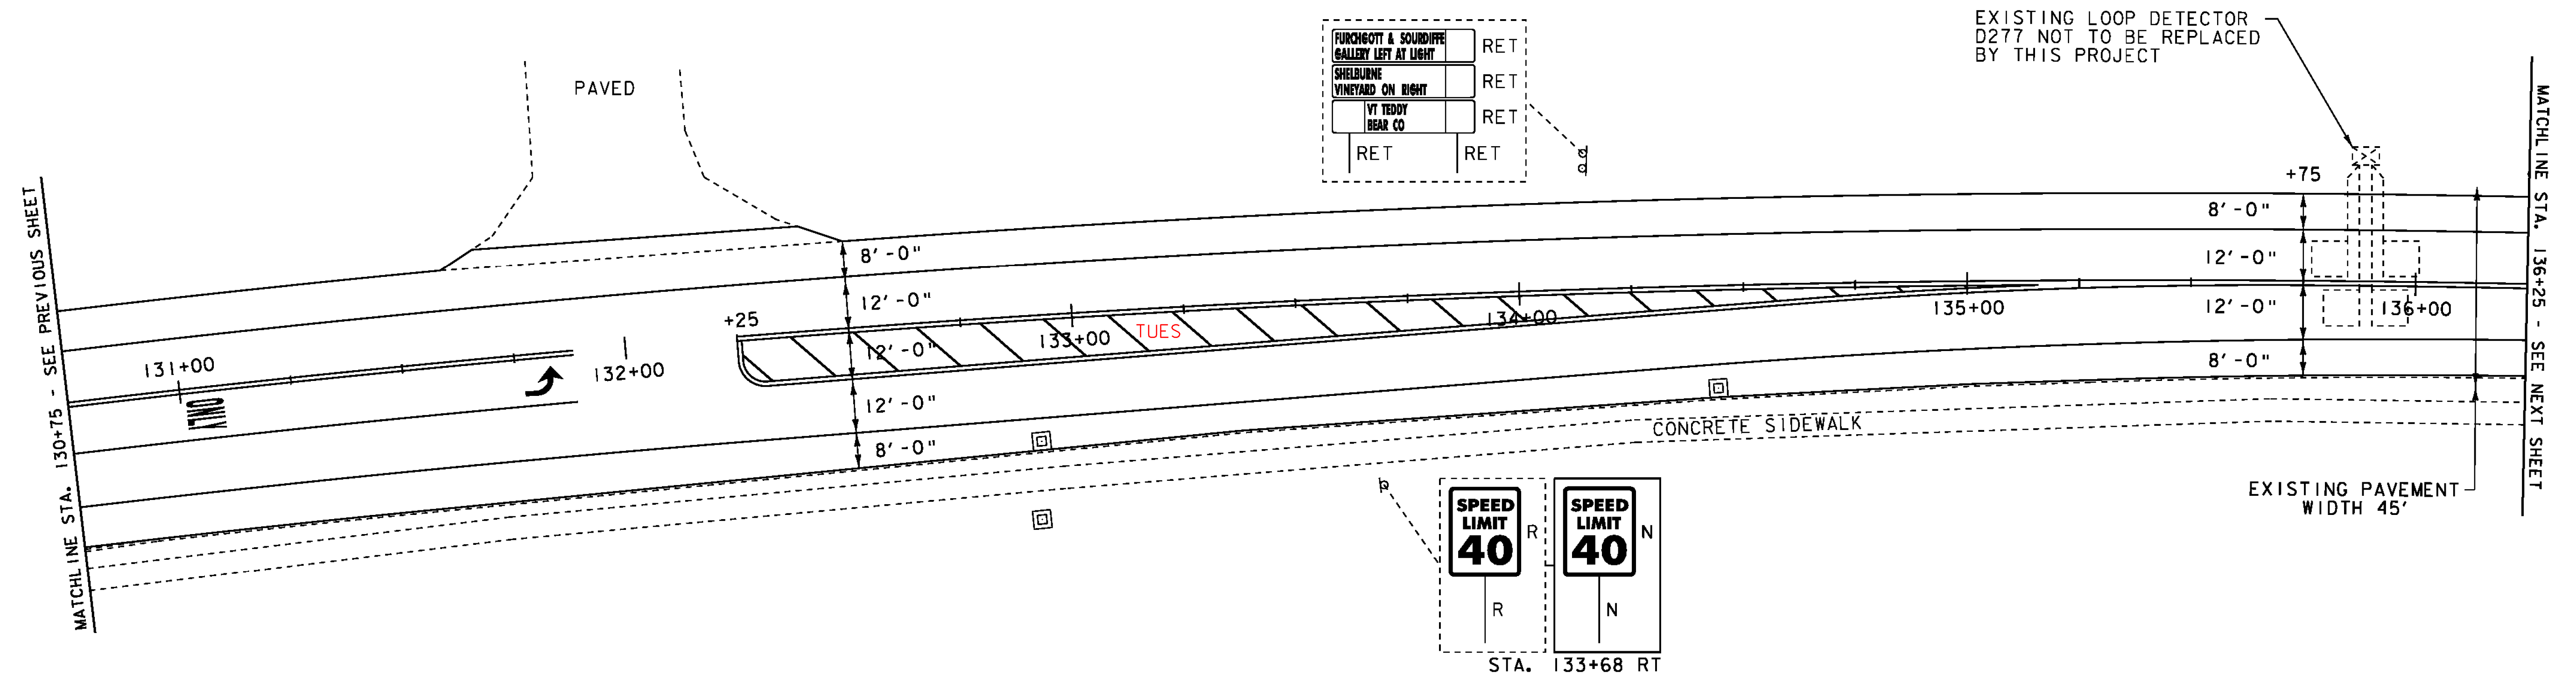

- LEGEND**
- |   |                          |     |                         |
|---|--------------------------|-----|-------------------------|
| ○ | SIGN                     | ●   | LIGHT POLE              |
| ⊙ | HYDRANT                  | ■   | EX. DETECTABLE WARNINGS |
| ⊖ | MANHOLE                  | □   | JUNCTION BOX            |
| ⊕ | VALVE                    | ⊞   | PED BUTTON              |
| ⊗ | GAS PIPELINE MARKER      | ⊞   | ELECTRICAL BOX          |
| ⊠ | CATCH BASIN / DROP INLET | ⊞   | SIGNAL                  |
| — | CURB INLET               | ⊞   | PEDESTAL POST           |
| ⊞ | TRAFFIC CONTROL BOX      | ⊞   | STRAIN POLE             |
| ⊞ | PARKING METER            | →   | CAMERA                  |
| ⊞ | UTILITY POLE             | VDZ | VIDEO DETECTION ZONE    |
- SIGN LEGEND**
- R = REMOVE  
 R&S = REMOVE AND SALVAGE  
 RET = RETAIN  
 S = SALVAGE  
 N = NEW  
 B-B = BACK TO BACK

NOT TO SCALE

**PROJECT LAYOUT SHEET 24**

PROJECT NAME: CHARLOTTE-SOUTH BURLINGTON  
 PROJECT NUMBER: NH 2907(1)  
 FILE NAME: p10B206.dgn  
 PROJECT LEADER: CDL  
 DESIGNED BY: BMB  
 PLOT FILE: p10B206\_40.I  
 PLOT DATE: 4/19/12  
 DRAWN BY: BMB  
 CHECKED BY: EPD  
 SHEET 40 OF 107