

DURABLE 4 INCH WHITE LINE, TYPE I TAPE
 STA. 136+25 - STA. 137+73.00 (SOLID LT & RT)


TEMPORARY 4 INCH WHITE LINE, PAINT
 STA. 136+25 - STA. 137+73.00 (SOLID LT & RT)

REHAB, DROP INLETS, CATCH BASINS, OR
 MANHOLES, CLASS I OR CLASS II
 STA. 136+85 RT

DURABLE 4 INCH YELLOW LINE, TYPE I TAPE
 STA. 136+25 - STA. 137+60 (SOLID LT & RT)

TEMPORARY 4 INCH YELLOW LINE, PAINT
 STA. 136+25 - STA. 137+60 (SOLID LT & RT)

REMOVAL OF EXISTING CURB
 STA. 136+80 - STA. 136+90 RT

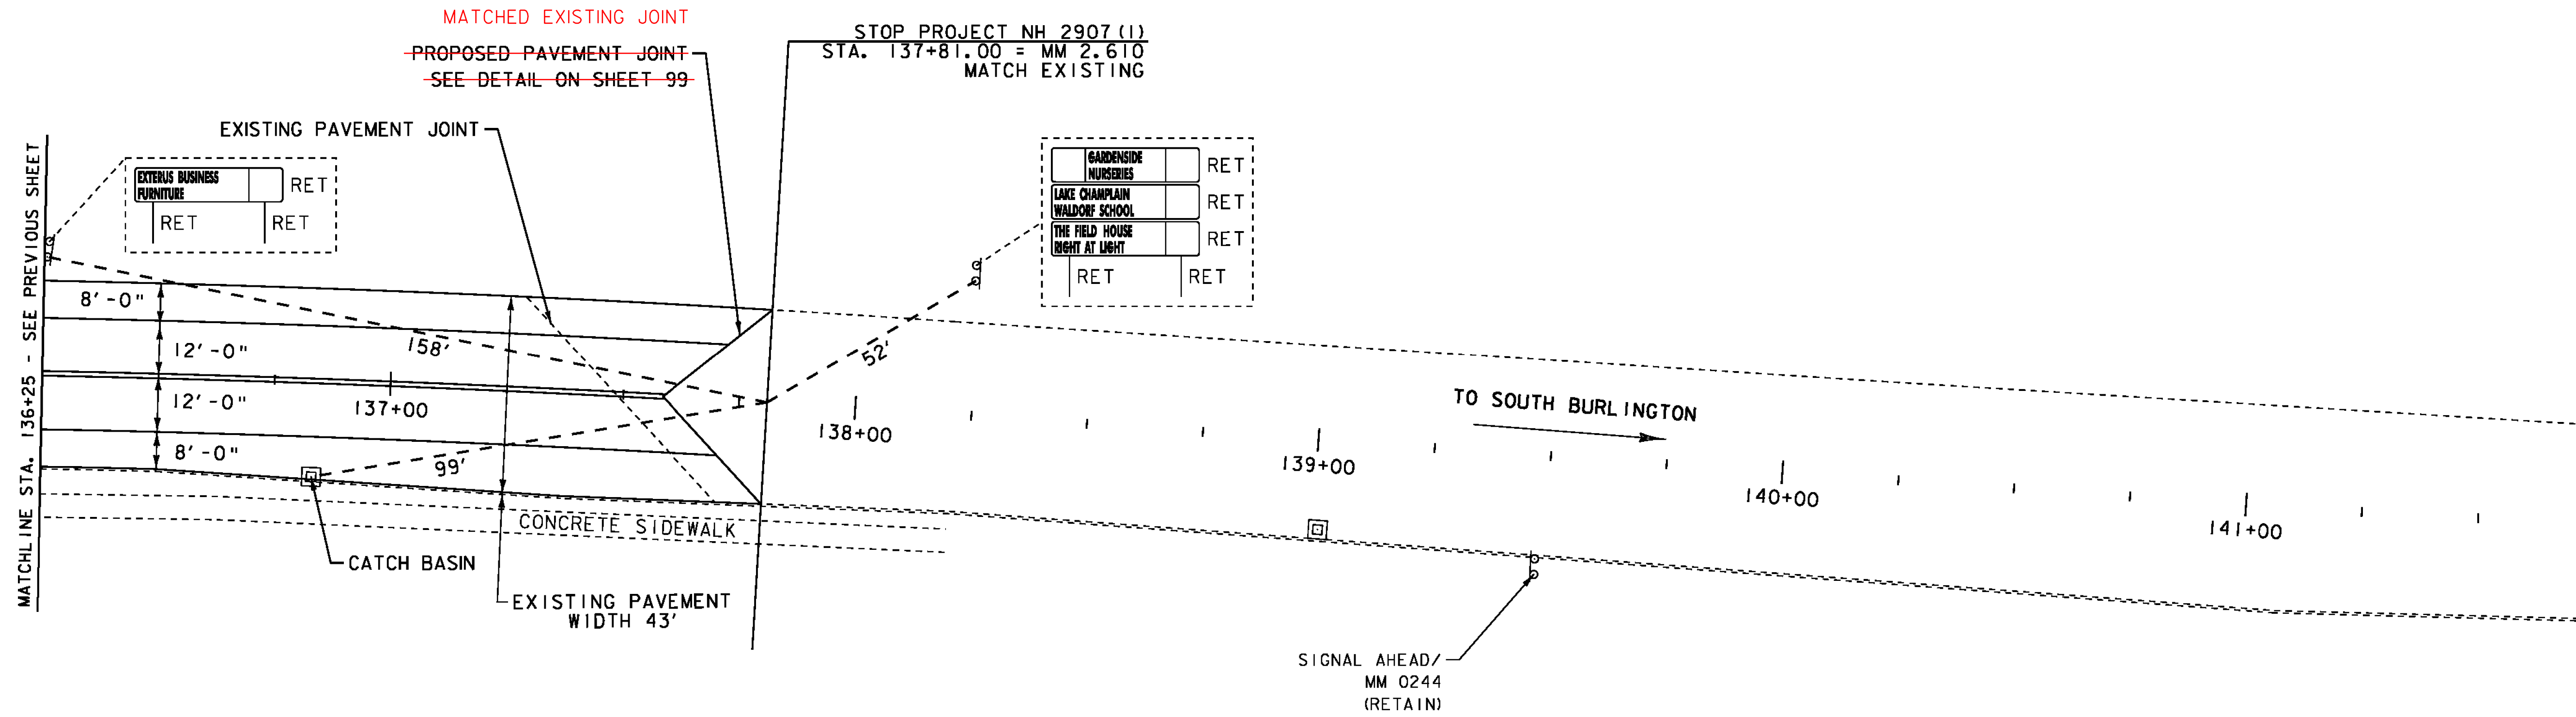

LEGEND

- | | | | |
|---|--------------------------|---|-------------------------|
| ○ | SIGN | ● | LIGHT POLE |
| ○ | HYDRANT | ■ | EX. DETECTABLE WARNINGS |
| ○ | MANHOLE | □ | JUNCTION BOX |
| ○ | VALVE | ⊞ | PED BUTTON |
| ○ | GAS PIPELINE MARKER | ⊞ | ELECTRICAL BOX |
| □ | CATCH BASIN / DROP INLET | ⊞ | SIGNAL |
| — | CURB INLET | ⊞ | PEDESTAL POST |
| ⊞ | TRAFFIC CONTROL BOX | ⊞ | STRAIN POLE |
| ⊞ | PARKING METER | → | CAMERA |
| ⊞ | UTILITY POLE | → | VIDEO DETECTION ZONE |

- SIGN LEGEND**
- R = REMOVE
 - R&S = REMOVE AND SALVAGE
 - RET = RETAIN
 - S = SALVAGE
 - N = NEW
 - B-B = BACK TO BACK

NOT TO SCALE

PROJECT LAYOUT SHEET 25	PROJECT NAME: CHARLOTTE-SOUTH BURLINGTON	PLOT DATE: 4/19/12
	PROJECT NUMBER: NH 2907(1)	DRAWN BY: BMB
	FILE NAME: p10B206.dgn	CHECKED BY: EPD
	PROJECT LEADER: CDL	SHEET 41 OF 107
	DESIGNED BY: BMB	
	PLOT FILE: p10B206_41.J	