

**COMMON EXCAVATION**  
 STA. 51+65 - STA. 51+76 LT  
 STA. 52+08 - STA. 52+25 LT

**SUBBASE OF CRUSHED GRAVEL,  
 FINE GRADED**  
 STA. 51+65 - STA. 51+73 LT  
 STA. 52+09 - STA. 52+25 LT

**PORTLAND CEMENT  
 CONCRETE SIDEWALK, 5 INCH**  
 STA. 51+65 - STA. 51+73 LT  
 STA. 52+09 - STA. 52+25 LT

**DETECTABLE  
 WARNING SURFACE**  
 STA. 51+68 LT (8 SF)  
 STA. 52+15 LT (8 SF)

**REHAB. DROP INLETS, CATCH BASINS,  
 OR MANHOLES, CLASS I OR CLASS II**  
 STA. 51+78 RT

**CAST-IN-PLACE CONCRETE CURB, TYPE B**  
 STA. 51+65 - STA. 51+76 LT  
 STA. 52+08 - STA. 52+23 LT

**REMOVAL OF EXISTING CURB**  
 STA. 51+73 - STA. 51+83 RT

**DURABLE 4 INCH WHITE LINE, TYPE I TAPE**  
 STA. 51+61.58 - STA. 51+70 (SOLID LT)  
 STA. 51+61.58 - STA. 53+25 (DASHED LT & RT)  
 STA. 52+09 - STA. 53+02 (SOLID LT)  
 STA. 52+16 - STA. 53+25 (SOLID LT)  
 STA. 53+02 - STA. 53+25 (DOTTED LT)

**DURABLE 4 INCH YELLOW LINE, TYPE I TAPE**  
 STA. 51+61.58 - STA. 53+25 (SOLID LT, DASHED LT)  
 STA. 51+61.58 - STA. 53+25 (DASHED LT, SOLID RT)

**DURABLE LETTER OR SYMBOL, TYPE I TAPE**  
 STA. 52+17 LT ARROW  
 STA. 52+23 LT ARROW  
 STA. 52+48 LT ARROW  
 STA. 52+58 LT "ONLY"  
 STA. 52+98 LT ARROW


**TEMPORARY 4 INCH WHITE LINE, PAINT**  
 STA. 51+61.58 - STA. 51+70 (SOLID LT)  
 STA. 51+61.58 - STA. 53+25 (DASHED LT & RT)  
 STA. 52+09 - STA. 53+02 (SOLID LT)  
 STA. 52+16 - STA. 53+25 (SOLID LT)  
 STA. 53+02 - STA. 53+25 (DOTTED LT)

**TEMPORARY 4 INCH YELLOW LINE, PAINT**  
 STA. 51+61.58 - STA. 53+25 (SOLID LT & RT)  
 STA. 51+61.58 - STA. 53+25 (DASHED LT & RT)

**TEMPORARY LETTER OR SYMBOL, PAINT**  
 STA. 52+17 LT ARROW  
 STA. 52+23 LT ARROW  
 STA. 52+48 LT ARROW  
 STA. 52+58 LT "ONLY"  
 STA. 52+98 LT ARROW

**REMOVING SIGNS**  
 AS SHOWN - 2

**ERECTING SALVAGED SIGNS**  
 AS SHOWN - 1

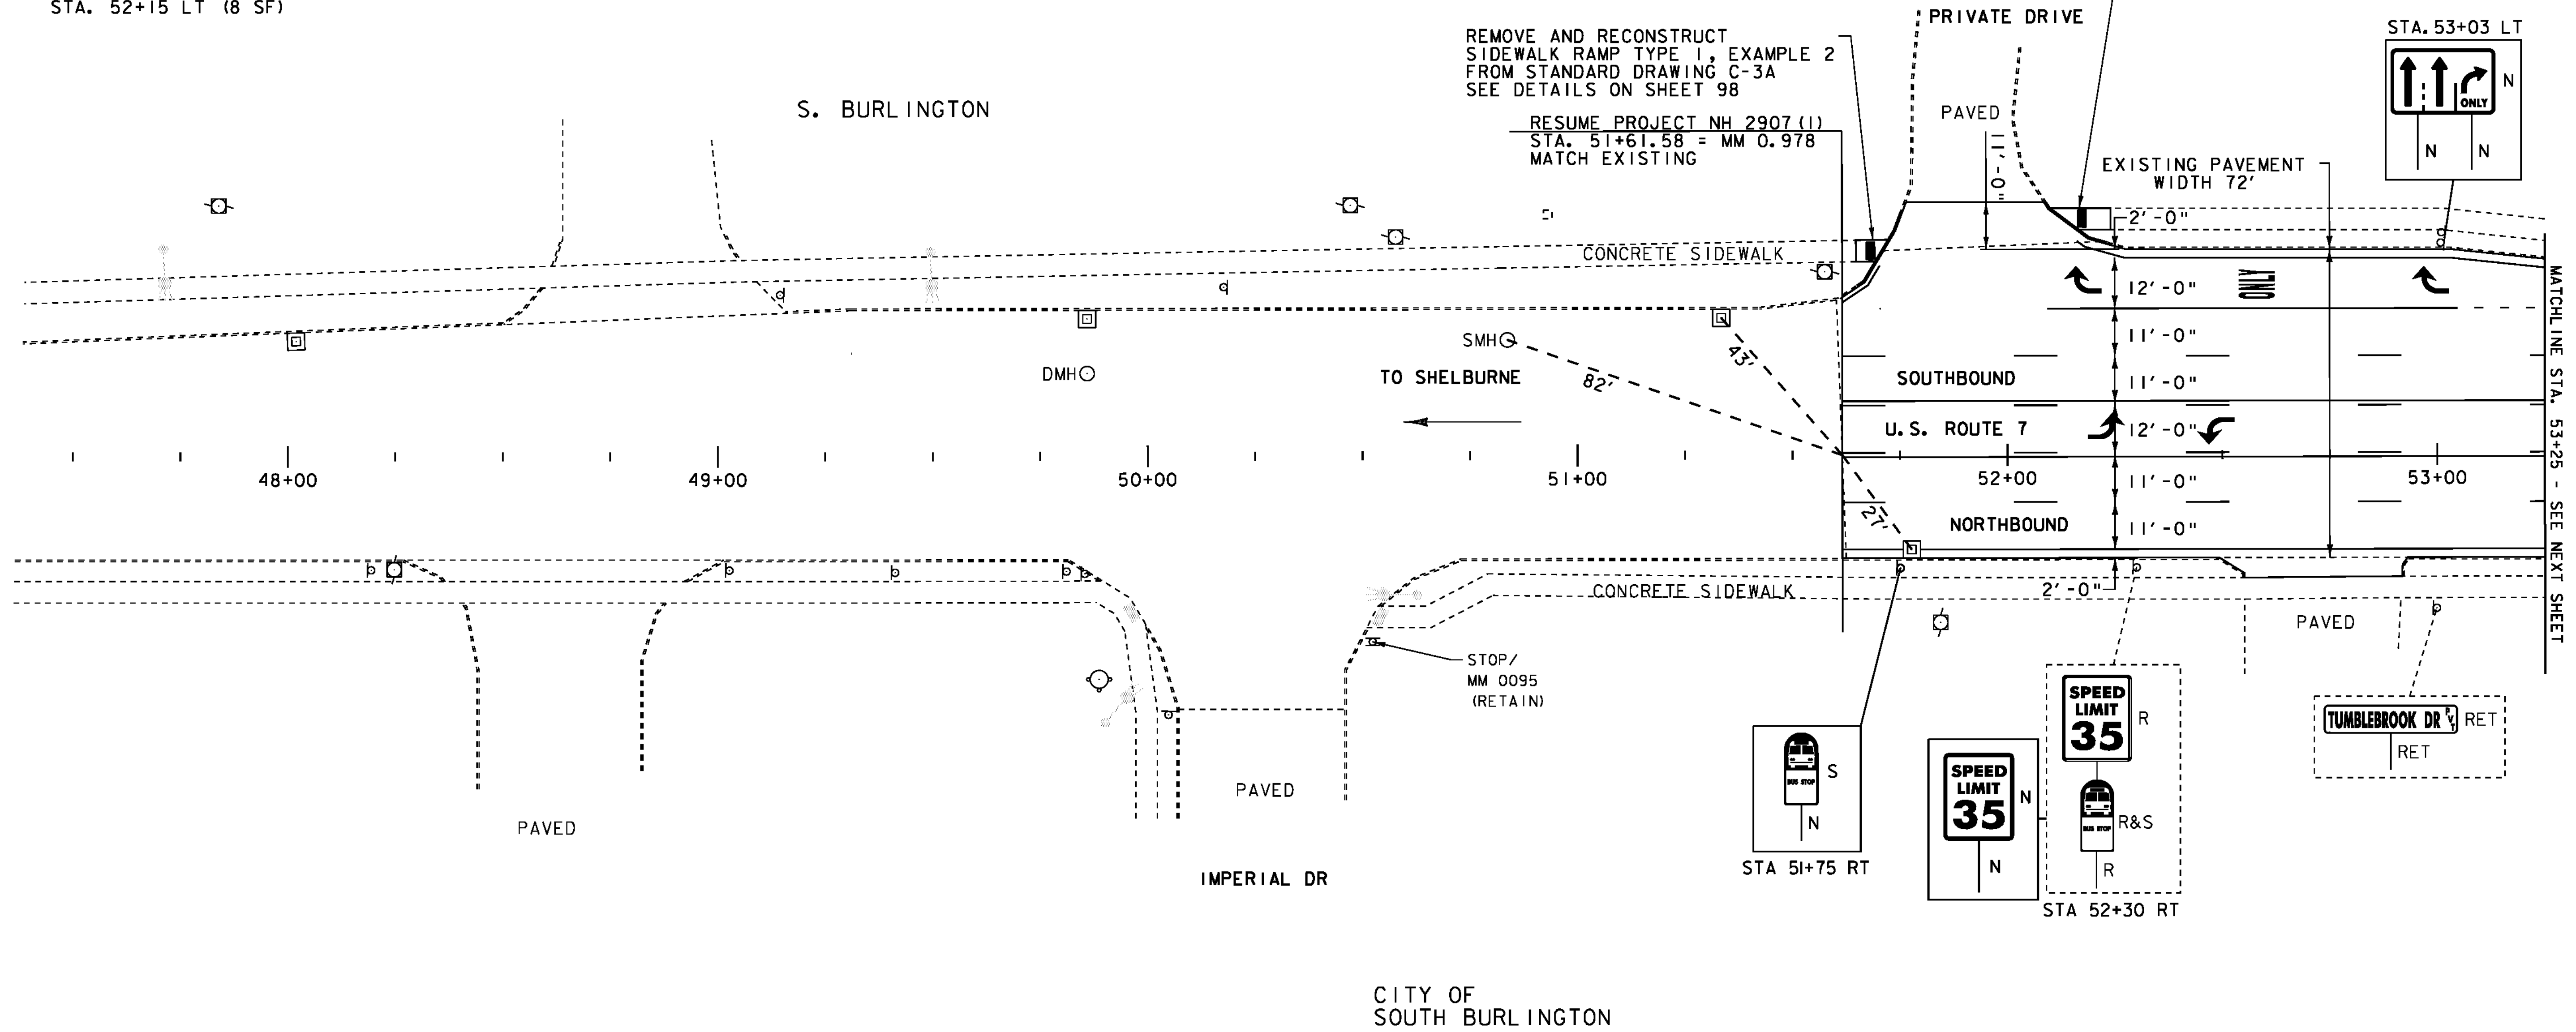

LEGEND		SIGN LEGEND	
○	SIGN	○	R = REMOVE
○	HYDRANT	○	R&S = REMOVE AND SALVAGE
○	MANHOLE	○	RET = RETAIN
○	VALVE	○	S = SALVAGE
○	GAS PIPELINE MARKER	○	N = NEW
○	CATCH BASIN / DROP INLET	○	B-B = BACK TO BACK
○	CURB INLET	○	
○	TRAFFIC CONTROL BOX	○	
○	PARKING METER	○	
○	UTILITY POLE	○	
○	LIGHT POLE	○	
○	EX. DETECTABLE WARNINGS	○	
○	JUNCTION BOX	○	
○	PED BUTTON	○	
○	ELECTRICAL BOX	○	
○	SIGNAL	○	
○	PEDESTAL POST	○	
○	STRAIN POLE	○	
○	CAMERA	○	
○	VIDEO DETECTION ZONE	○	

**NOT TO SCALE**

<b>PROJECT LAYOUT SHEET 26</b>	PROJECT NAME: CHARLOTTE-SOUTH BURLINGTON
	PROJECT NUMBER: NH 2907(I)
FILE NAME: p10B206.dgn	PLOT DATE: 4/19/12
PROJECT LEADER: CDL	DRAWN BY: BMB
DESIGNED BY: BMB	CHECKED BY: EPD
PLOT FILE: p10B206_42.1	SHEET 42 OF 107