

DURABLE 24 INCH STOP BAR, TYPE I TAPE
 STA. 59+63 LT & RT
 STA. 59+87 - STA. 60+11 LT
 STA. 60+04 - STA. 60+26 RT
 STA. 60+55 LT

CHANGING ELEVATION OF SEWER MANHOLES
 STA. 58+85 LT
 STA. 60+06 RT
 STA. 62+83 LT

CHANGING ELEVATION OF DROP INLETS, CATCH BASINS, OR MANHOLES
 STA. 60+27 LT (DMH)

ADJUST ELEVATION OF VALVE BOX
 STA. 60+16 RT (WSV)

ADJUST ELEVATION OF GAS VALVE (TO BE DONE BY OTHERS)
 STA. 59+95 RT (GSV)

COMMON EXCAVATION
 STA. 59+68 - STA. 59+87 LT
 STA. 59+73 - STA. 59+92 RT
 STA. 60+26 - STA. 60+37 RT
 STA. 60+46 - STA. 60+71 LT
 STA. 63+41 - STA. 63+46 RT

SUBBASE OF CRUSHED GRAVEL, FINE GRADED
 STA. 59+69 - STA. 59+85 LT
 STA. 59+75 - STA. 59+92 RT
 STA. 60+26 - STA. 60+37 RT
 STA. 60+51 - STA. 60+69 LT

PORTLAND CEMENT CONCRETE SIDEWALK, 5 INCH
 STA. 59+69 - STA. 59+85 LT
 STA. 59+75 - STA. 59+92 RT
 STA. 60+26 - STA. 60+37 RT
 STA. 60+51 - STA. 60+69 LT

DETECTABLE WARNING SURFACE
 STA. 59+79 LT (28 SF)
 STA. 59+83 RT (10 SF)
 STA. 59+91 RT (8 SF)
 STA. 60+28 RT (8 SF)
 STA. 60+61 LT (18 SF)

DURABLE LETTER OR SYMBOL, TYPE I TAPE

STA. 58+86 LT "ONLY"	STA. 61+04 LT "ONLY"
STA. 59+54 LT ARROW	STA. 61+04 LT "ONLY"
STA. 59+96 LT ARROW	STA. 61+48 LT ARROW
STA. 60+05 LT ARROW	STA. 61+51 LT ARROW
STA. 60+05 LT ARROW	STA. 61+93 LT "ONLY"
STA. 60+09 RT ARROW	STA. 62+33 LT ARROW
STA. 60+09 RT ARROW	STA. 63+19 LT ARROW
STA. 60+19 RT ARROW	STA. 63+59 LT "ONLY"
STA. 60+64 LT ARROW	STA. 64+03 LT ARROW
STA. 60+64 LT ARROW	STA. 64+43 LT "ONLY"

TEMPORARY LETTER OR SYMBOL, PAINT

STA. 58+86 LT "ONLY"	STA. 61+04 LT "ONLY"
STA. 59+54 LT ARROW	STA. 61+04 LT "ONLY"
STA. 59+96 LT ARROW	STA. 61+48 LT ARROW
STA. 60+05 LT ARROW	STA. 61+51 LT ARROW
STA. 60+05 LT ARROW	STA. 61+93 LT "ONLY"
STA. 60+09 RT ARROW	STA. 62+33 LT ARROW
STA. 60+09 RT ARROW	STA. 63+19 LT ARROW
STA. 60+19 RT ARROW	STA. 63+59 LT "ONLY"
STA. 60+64 LT ARROW	STA. 64+03 LT ARROW
STA. 60+64 LT ARROW	STA. 64+43 LT "ONLY"


TEMPORARY CROSSWALK MARKING, PAINT

STA. 59+79 LT - STA. 59+83 RT
 STA. 59+84 - STA. 60+51 LT
 STA. 59+93 - STA. 60+24 RT

REMOVING SIGNS AS SHOWN - 8

EXISTING PAVEMENT WIDTH 60'

36" RCP 3' COVER

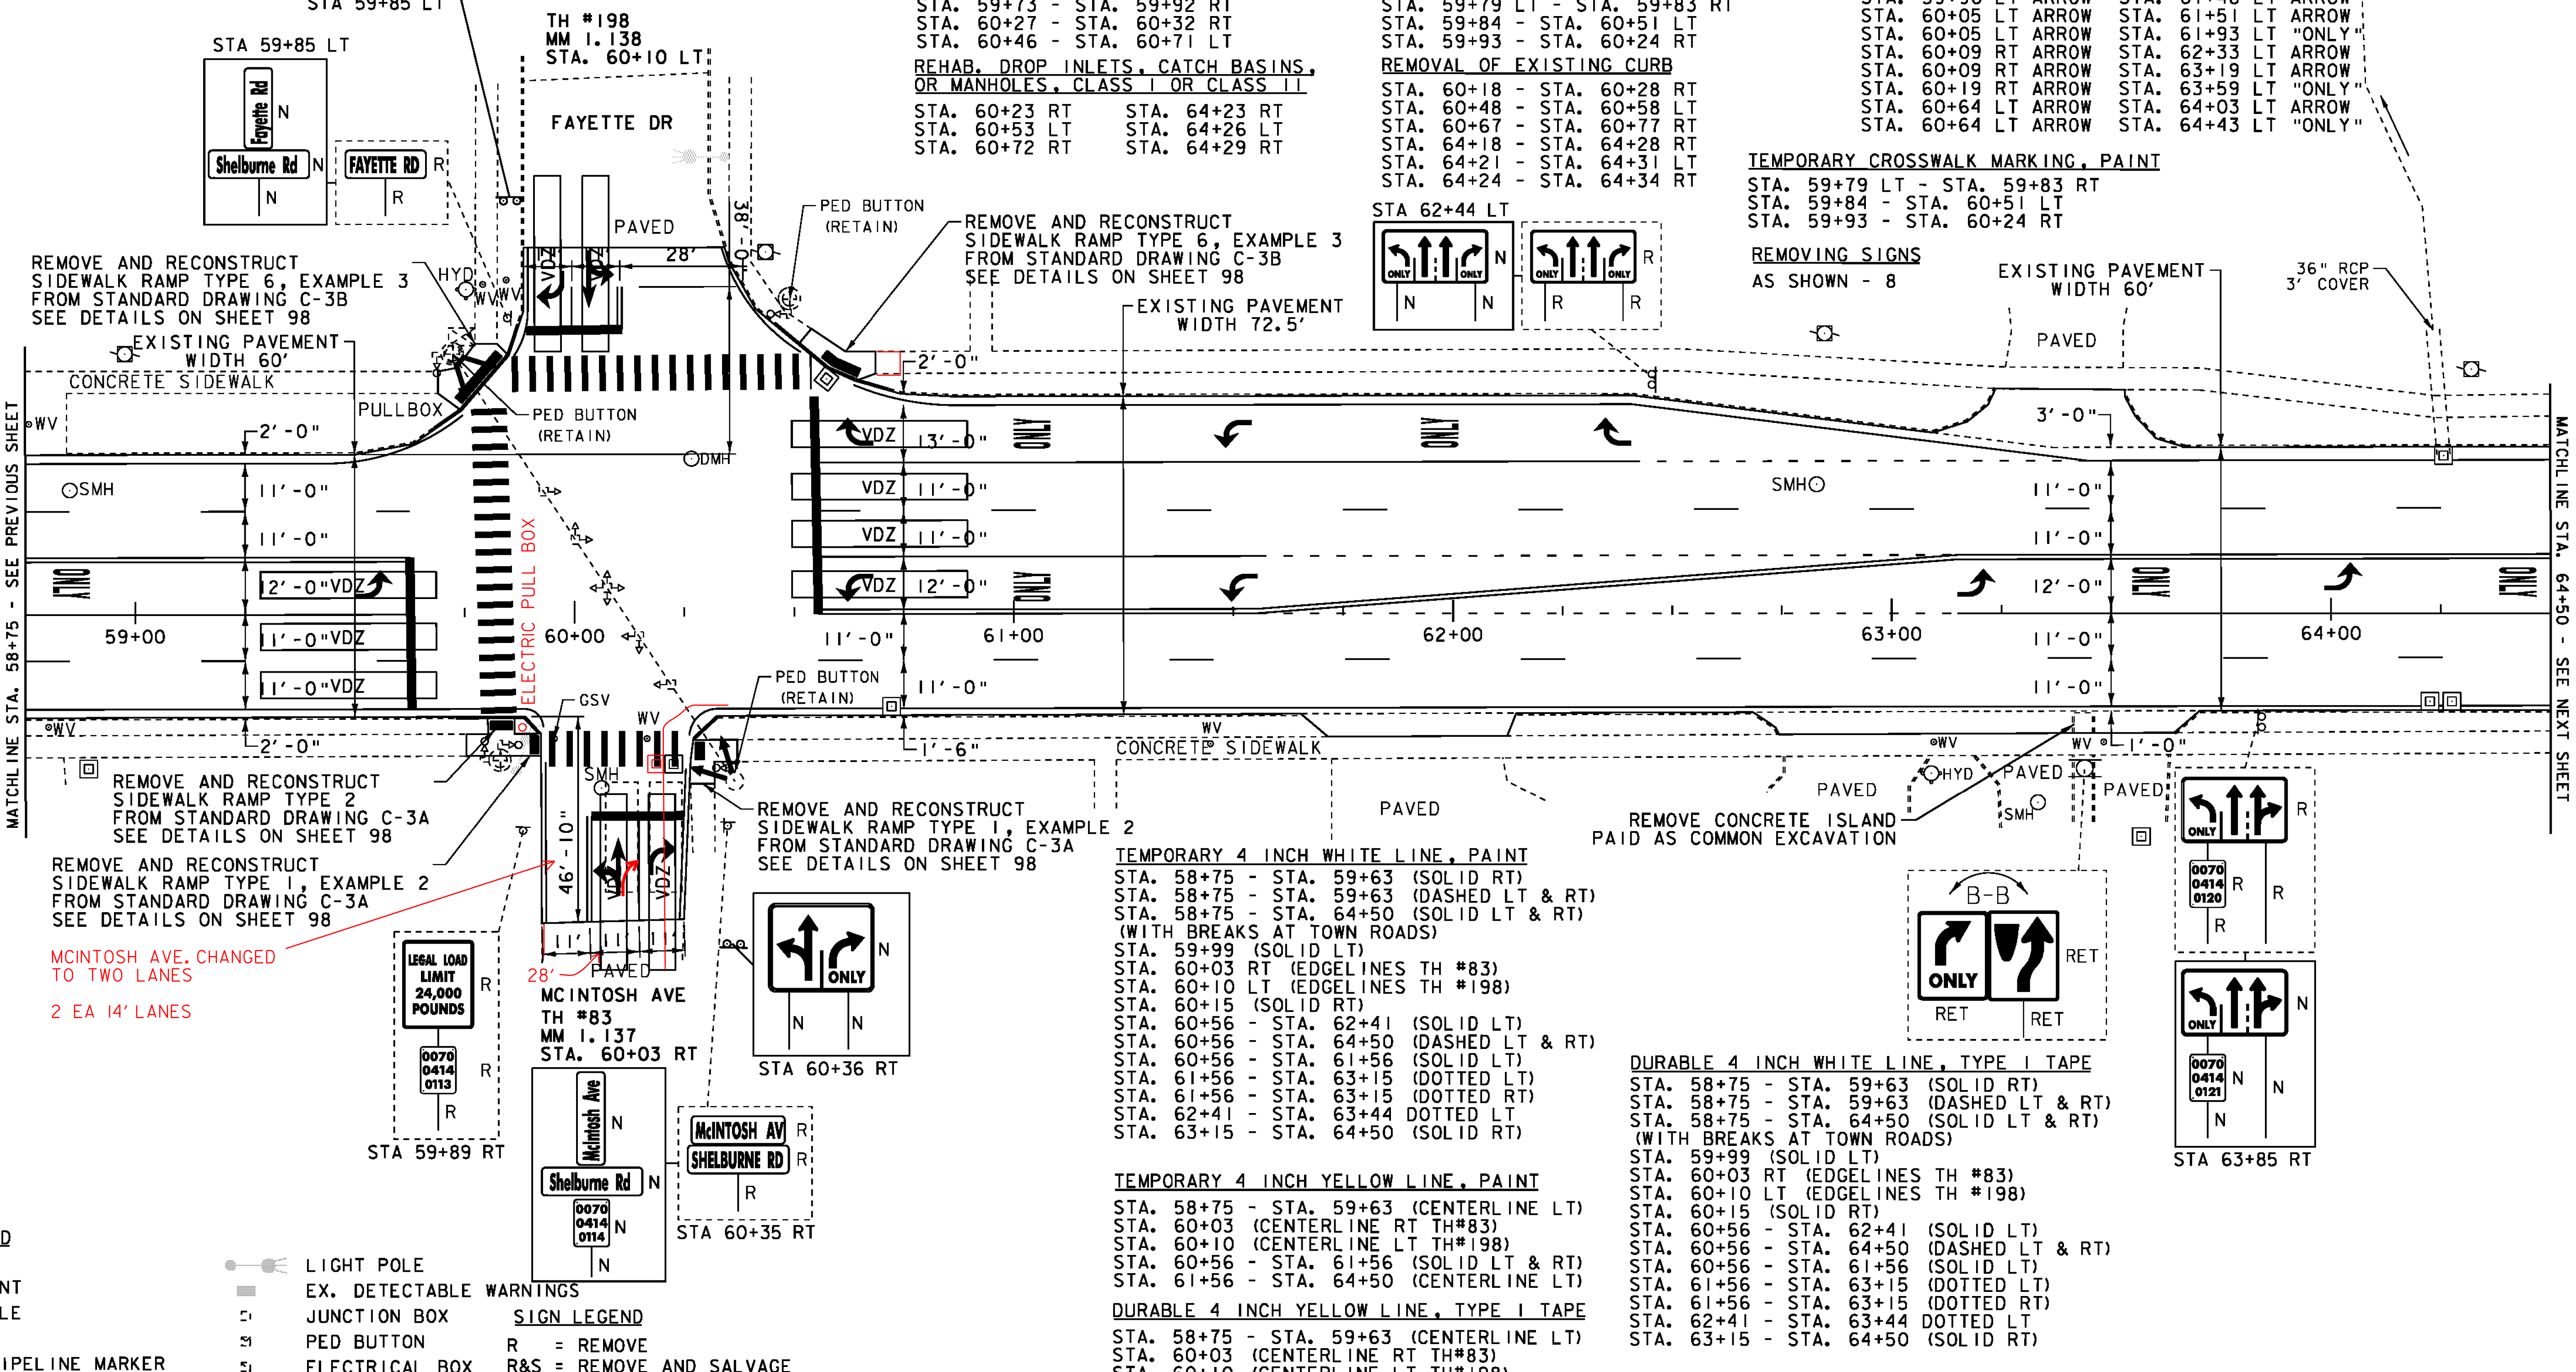

MATCHLINE STA. 58+75 - SEE PREVIOUS SHEET

MATCHLINE STA. 64+50 - SEE NEXT SHEET

- LEGEND**
- SIGN
 - ⊕ HYDRANT
 - MANHOLE
 - VALVE
 - GAS PIPELINE MARKER
 - ⊠ CATCH BASIN / DROP INLET
 - CURB INLET
 - ⊠ TRAFFIC CONTROL BOX
 - ⊠ PARKING METER
 - ⊠ UTILITY POLE
 - LIGHT POLE
 - ⊠ EX. DETECTABLE WARNINGS
 - ⊠ JUNCTION BOX
 - ⊠ PED BUTTON
 - ⊠ ELECTRICAL BOX
 - ⊠ SIGNAL
 - ⊠ PEDESTAL POST
 - ⊠ STRAIN POLE
 - ⊠ CAMERA
 - ⊠ VIDEO DETECTION ZONE
- SIGN LEGEND**
- R = REMOVE
 - R&S = REMOVE AND SALVAGE
 - RET = RETAIN
 - S = SALVAGE
 - N = NEW
 - B-B = BACK TO BACK

TEMPORARY 4 INCH WHITE LINE, PAINT

STA. 58+75 - STA. 59+63 (SOLID RT)
 STA. 58+75 - STA. 59+63 (DASHED LT & RT)
 STA. 58+75 - STA. 64+50 (SOLID LT & RT) (WITH BREAKS AT TOWN ROADS)
 STA. 59+99 (SOLID LT)
 STA. 60+03 RT (EDGE LINES TH #83)
 STA. 60+10 LT (EDGE LINES TH #198)
 STA. 60+15 (SOLID RT)
 STA. 60+56 - STA. 62+41 (SOLID LT)
 STA. 60+56 - STA. 64+50 (DASHED LT & RT)
 STA. 60+56 - STA. 61+56 (SOLID LT)
 STA. 61+56 - STA. 63+15 (DOTTED LT)
 STA. 61+56 - STA. 63+15 (DOTTED RT)
 STA. 62+41 - STA. 63+44 (DOTTED LT)
 STA. 63+15 - STA. 64+50 (SOLID RT)

TEMPORARY 4 INCH YELLOW LINE, PAINT

STA. 58+75 - STA. 59+63 (CENTERLINE LT)
 STA. 60+03 (CENTERLINE RT TH#83)
 STA. 60+10 (CENTERLINE LT TH#198)
 STA. 60+56 - STA. 61+56 (SOLID LT & RT)
 STA. 61+56 - STA. 64+50 (CENTERLINE LT)

DURABLE 4 INCH YELLOW LINE, TYPE I TAPE

STA. 58+75 - STA. 59+63 (CENTERLINE LT)
 STA. 60+03 (CENTERLINE RT TH#83)
 STA. 60+10 (CENTERLINE LT TH#198)
 STA. 60+56 - STA. 61+56 (SOLID LT & RT)
 STA. 61+56 - STA. 64+50 (CENTERLINE LT)

TEMPORARY 24 INCH STOP BAR, PAINT

STA. 59+63 LT & RT
 STA. 59+87 - STA. 60+11 LT
 STA. 60+04 - STA. 60+26 RT
 STA. 60+55 LT

DURABLE 4 INCH WHITE LINE, TYPE I TAPE

STA. 58+75 - STA. 59+63 (SOLID RT)
 STA. 58+75 - STA. 59+63 (DASHED LT & RT)
 STA. 58+75 - STA. 64+50 (SOLID LT & RT) (WITH BREAKS AT TOWN ROADS)
 STA. 59+99 (SOLID LT)
 STA. 60+03 RT (EDGE LINES TH #83)
 STA. 60+10 LT (EDGE LINES TH #198)
 STA. 60+15 (SOLID RT)
 STA. 60+56 - STA. 62+41 (SOLID LT)
 STA. 60+56 - STA. 64+50 (DASHED LT & RT)
 STA. 60+56 - STA. 61+56 (SOLID LT)
 STA. 61+56 - STA. 63+15 (DOTTED LT)
 STA. 61+56 - STA. 63+15 (DOTTED RT)
 STA. 62+41 - STA. 63+44 (DOTTED LT)
 STA. 63+15 - STA. 64+50 (SOLID RT)

PROJECT LAYOUT SHEET 28	PROJECT NAME: CHARLOTTE-SOUTH BURLINGTON
	PROJECT NUMBER: NH 2907(I)
	FILE NAME: p10B206.dgn
	PLOT DATE: 4/19/12
	DESIGNED BY: BMB
	CHECKED BY: EPD
	PLOT FILE: p10B206_44.I
	SHEET 44 OF 107

NOT TO SCALE