

REHAB. DROP INLETS, CATCH BASINS,
OR MANHOLES, CLASS I OR CLASS II

STA. 70+86 RT
STA. 70+90 RT
STA. 72+56 RT
STA. 73+83 LT
STA. 73+83 RT

REMOVAL OF EXISTING CURB

STA. 70+81 - STA. 70+91 RT
STA. 70+85 - STA. 70+95 RT
STA. 72+51 - STA. 72+61 RT
STA. 73+78 - STA. 73+88 LT
STA. 73+78 - STA. 73+88 RT

ADJUST ELEVATION OF VALVE BOX

STA. 72+49 RT (WSV)




REMOVING SIGNS

AS SHOWN - 5

CHANGING ELEVATION

OF SEWER MANHOLES

STA. 72+32 LT

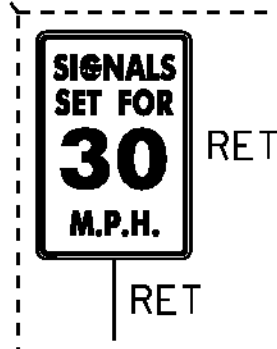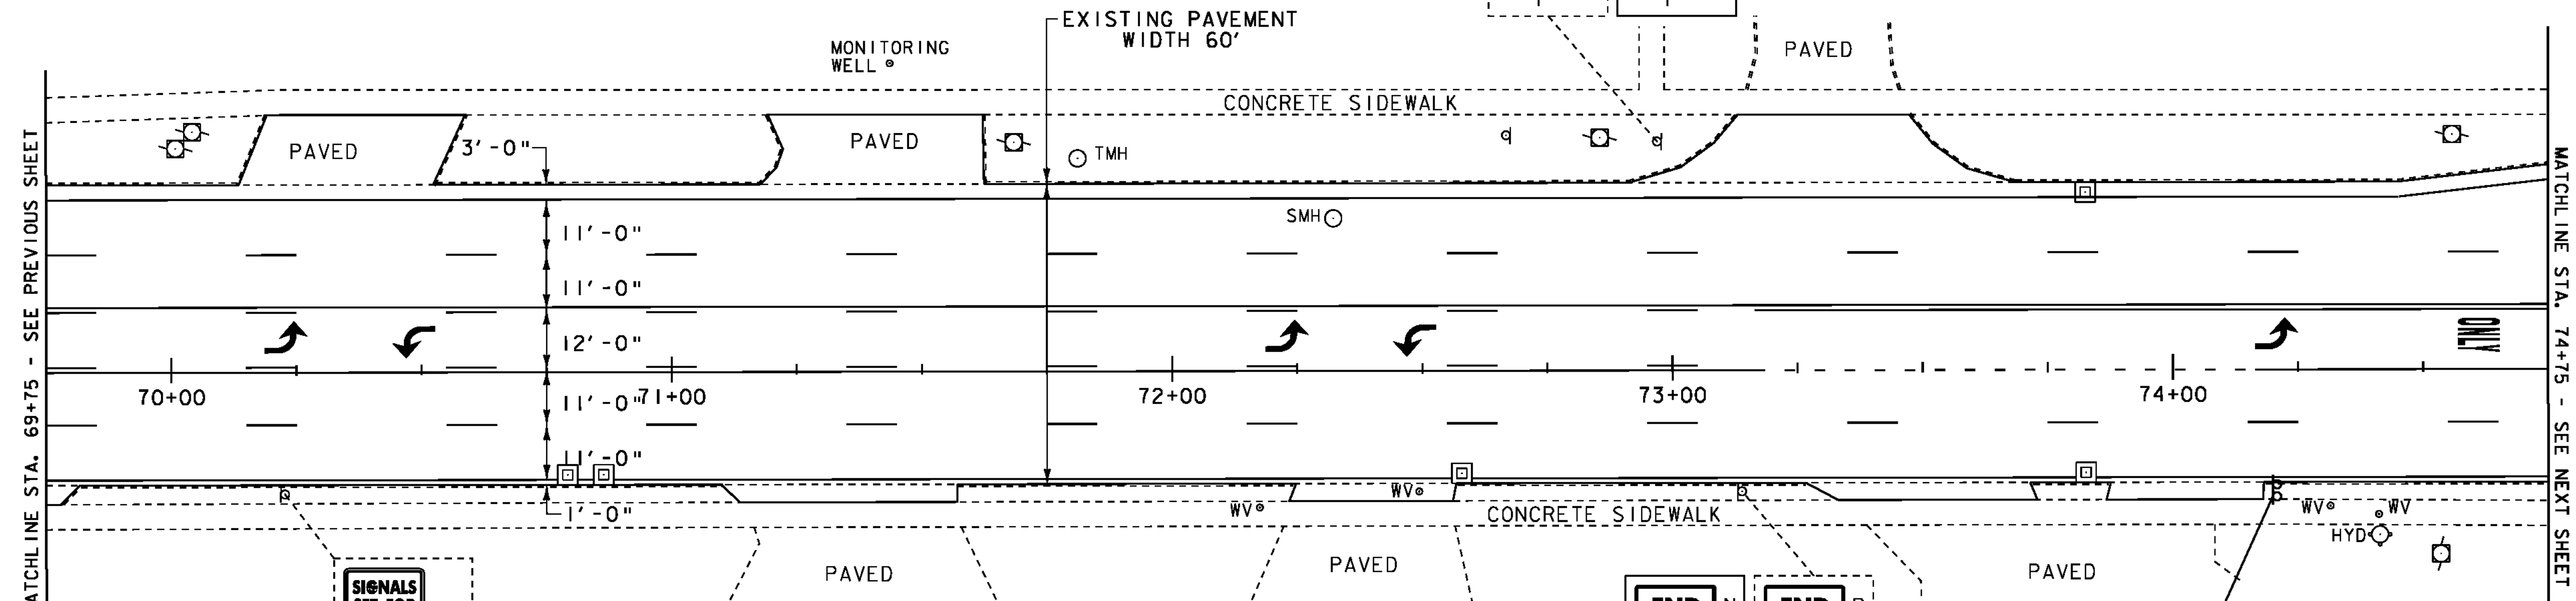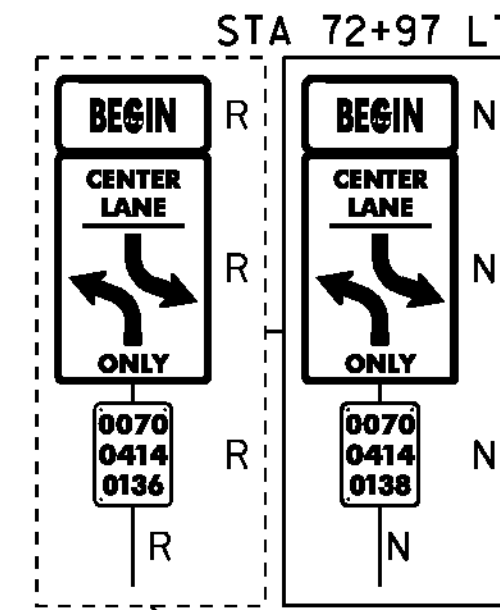

DURABLE 4 INCH WHITE LINE, TYPE I TAPE



STA. 69+75 - STA. 74+75 (SOLID LT & RT)
STA. 69+75 - STA. 74+75 (DASHED LT & RT)
STA. 73+16 - STA. 74+16 (DOTTED RT)
STA. 74+16 - STA. 74+75 (SOLID RT)

DURABLE 4 INCH YELLOW LINE, TYPE I TAPE

STA. 69+75 - STA. 73+16 (DASHED LT, SOLID RT)
STA. 69+75 - STA. 73+16 (DASHED LT, SOLID LT)
STA. 73+16 - STA. 74+75 (CENTERLINE LT)

DURABLE LETTER OR SYMBOL, TYPE I TAPE

STA. 70+23 LT ARROW
STA. 70+48 LT ARROW
STA. 72+23 LT ARROW
STA. 72+48 LT ARROW
STA. 74+21 LT ARROW
STA. 74+61 LT "ONLY"

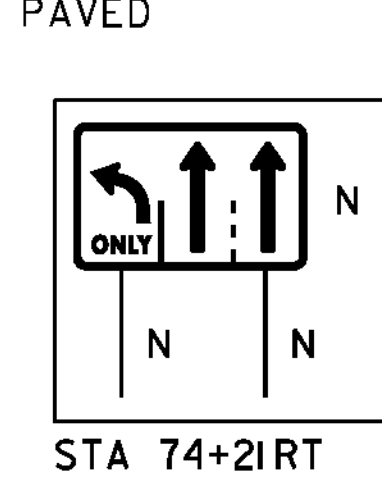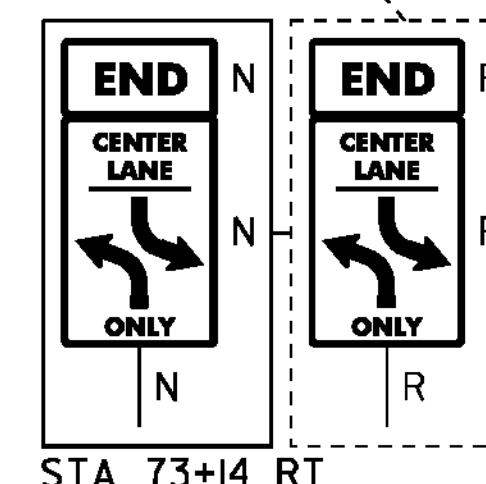

TEMPORARY 4 INCH WHITE LINE, PAINT

STA. 69+75 - STA. 74+75 (SOLID LT & RT)
STA. 69+75 - STA. 74+75 (DASHED LT & RT)
STA. 73+16 - STA. 74+16 (DOTTED RT)
STA. 74+16 - STA. 74+75 (SOLID RT)

TEMPORARY 4 INCH YELLOW LINE, PAINT

STA. 69+75 - STA. 73+16 (DASHED LT, SOLID RT)
STA. 69+75 - STA. 73+16 (DASHED LT, SOLID LT)
STA. 73+16 - STA. 74+75 (CENTERLINE LT)

TEMPORARY LETTER OR SYMBOL, PAINT

STA. 70+23 LT ARROW
STA. 70+48 LT ARROW
STA. 72+23 LT ARROW
STA. 72+48 LT ARROW
STA. 74+21 LT ARROW
STA. 74+61 LT "ONLY"

LEGEND

- | | | | | | |
|---|--------------------------|---|-------------------------|--------------------------|--|
| ○ | SIGN | ⊙ | LIGHT POLE | | |
| ⊙ | HYDRANT | ■ | EX. DETECTABLE WARNINGS | | |
| ○ | MANHOLE | □ | JUNCTION BOX | <u>SIGN LEGEND</u> | |
| ○ | VALVE | ⊙ | PED BUTTON | R = REMOVE | |
| ⊙ | GAS PIPELINE MARKER | ⊙ | ELECTRICAL BOX | R&S = REMOVE AND SALVAGE | |
| ⊙ | CATCH BASIN / DROP INLET | ⊙ | SIGNAL | RET = RETAIN | |
| ⊙ | CURB INLET | ⊙ | PEDESTAL POST | S = SALVAGE | |
| ⊙ | TRAFFIC CONTROL BOX | ⊙ | STRAIN POLE | N = NEW | |
| ⊙ | PARKING METER | ⊙ | CAMERA | B-B = BACK TO BACK | |
| ⊙ | UTILITY POLE | → | VIDEO DETECTION ZONE | | |

NOT TO SCALE

PROJECT LAYOUT SHEET 30

PROJECT NAME: CHARLOTTE-SOUTH BURLINGTON

PROJECT NUMBER: NH 2907(I)

FILE NAME: p10B206.dgn
PROJECT LEADER: CDL
DESIGNED BY: BMB
PLOT FILE: p10B206_46.1

PLOT DATE: 4/19/12
DRAWN BY: BMB
CHECKED BY: EPD
SHEET 46 OF 107