


LIST OF MAJOR EQUIPMENT	QUANTITY
ITEM 900.620 SPECIAL PROVISION (VIDEO VEHICLE DETECTION SYSTEM) (US ROUTE 7 @ HARBOR RD/ FALLS RD)	
VIDEO VEHICLE DETECTION CAMERAS	4

ITEM 900.620 SPECIAL PROVISION (PEDESTAL MOUNTED PEDESTRIAN SIGNAL HEAD, COUNTDOWN) (US ROUTE 7 @ HARBOR RD & FALLS RD)	
PEDESTRIAN POLES/FOUNDATIONS	2
ADA PEDESTRIAN PUSH BUTTON/SIGN ASSEMBLY (HAND/MAN PEDESTRIAN HEADS (SIGNAL FACE, LED, WITH 150 SYMBOLS) WITH ALL RELATED MOUNTING HARDWARE	2


NOTES:  
1. SEE SHEET 50A FOR NOTES.

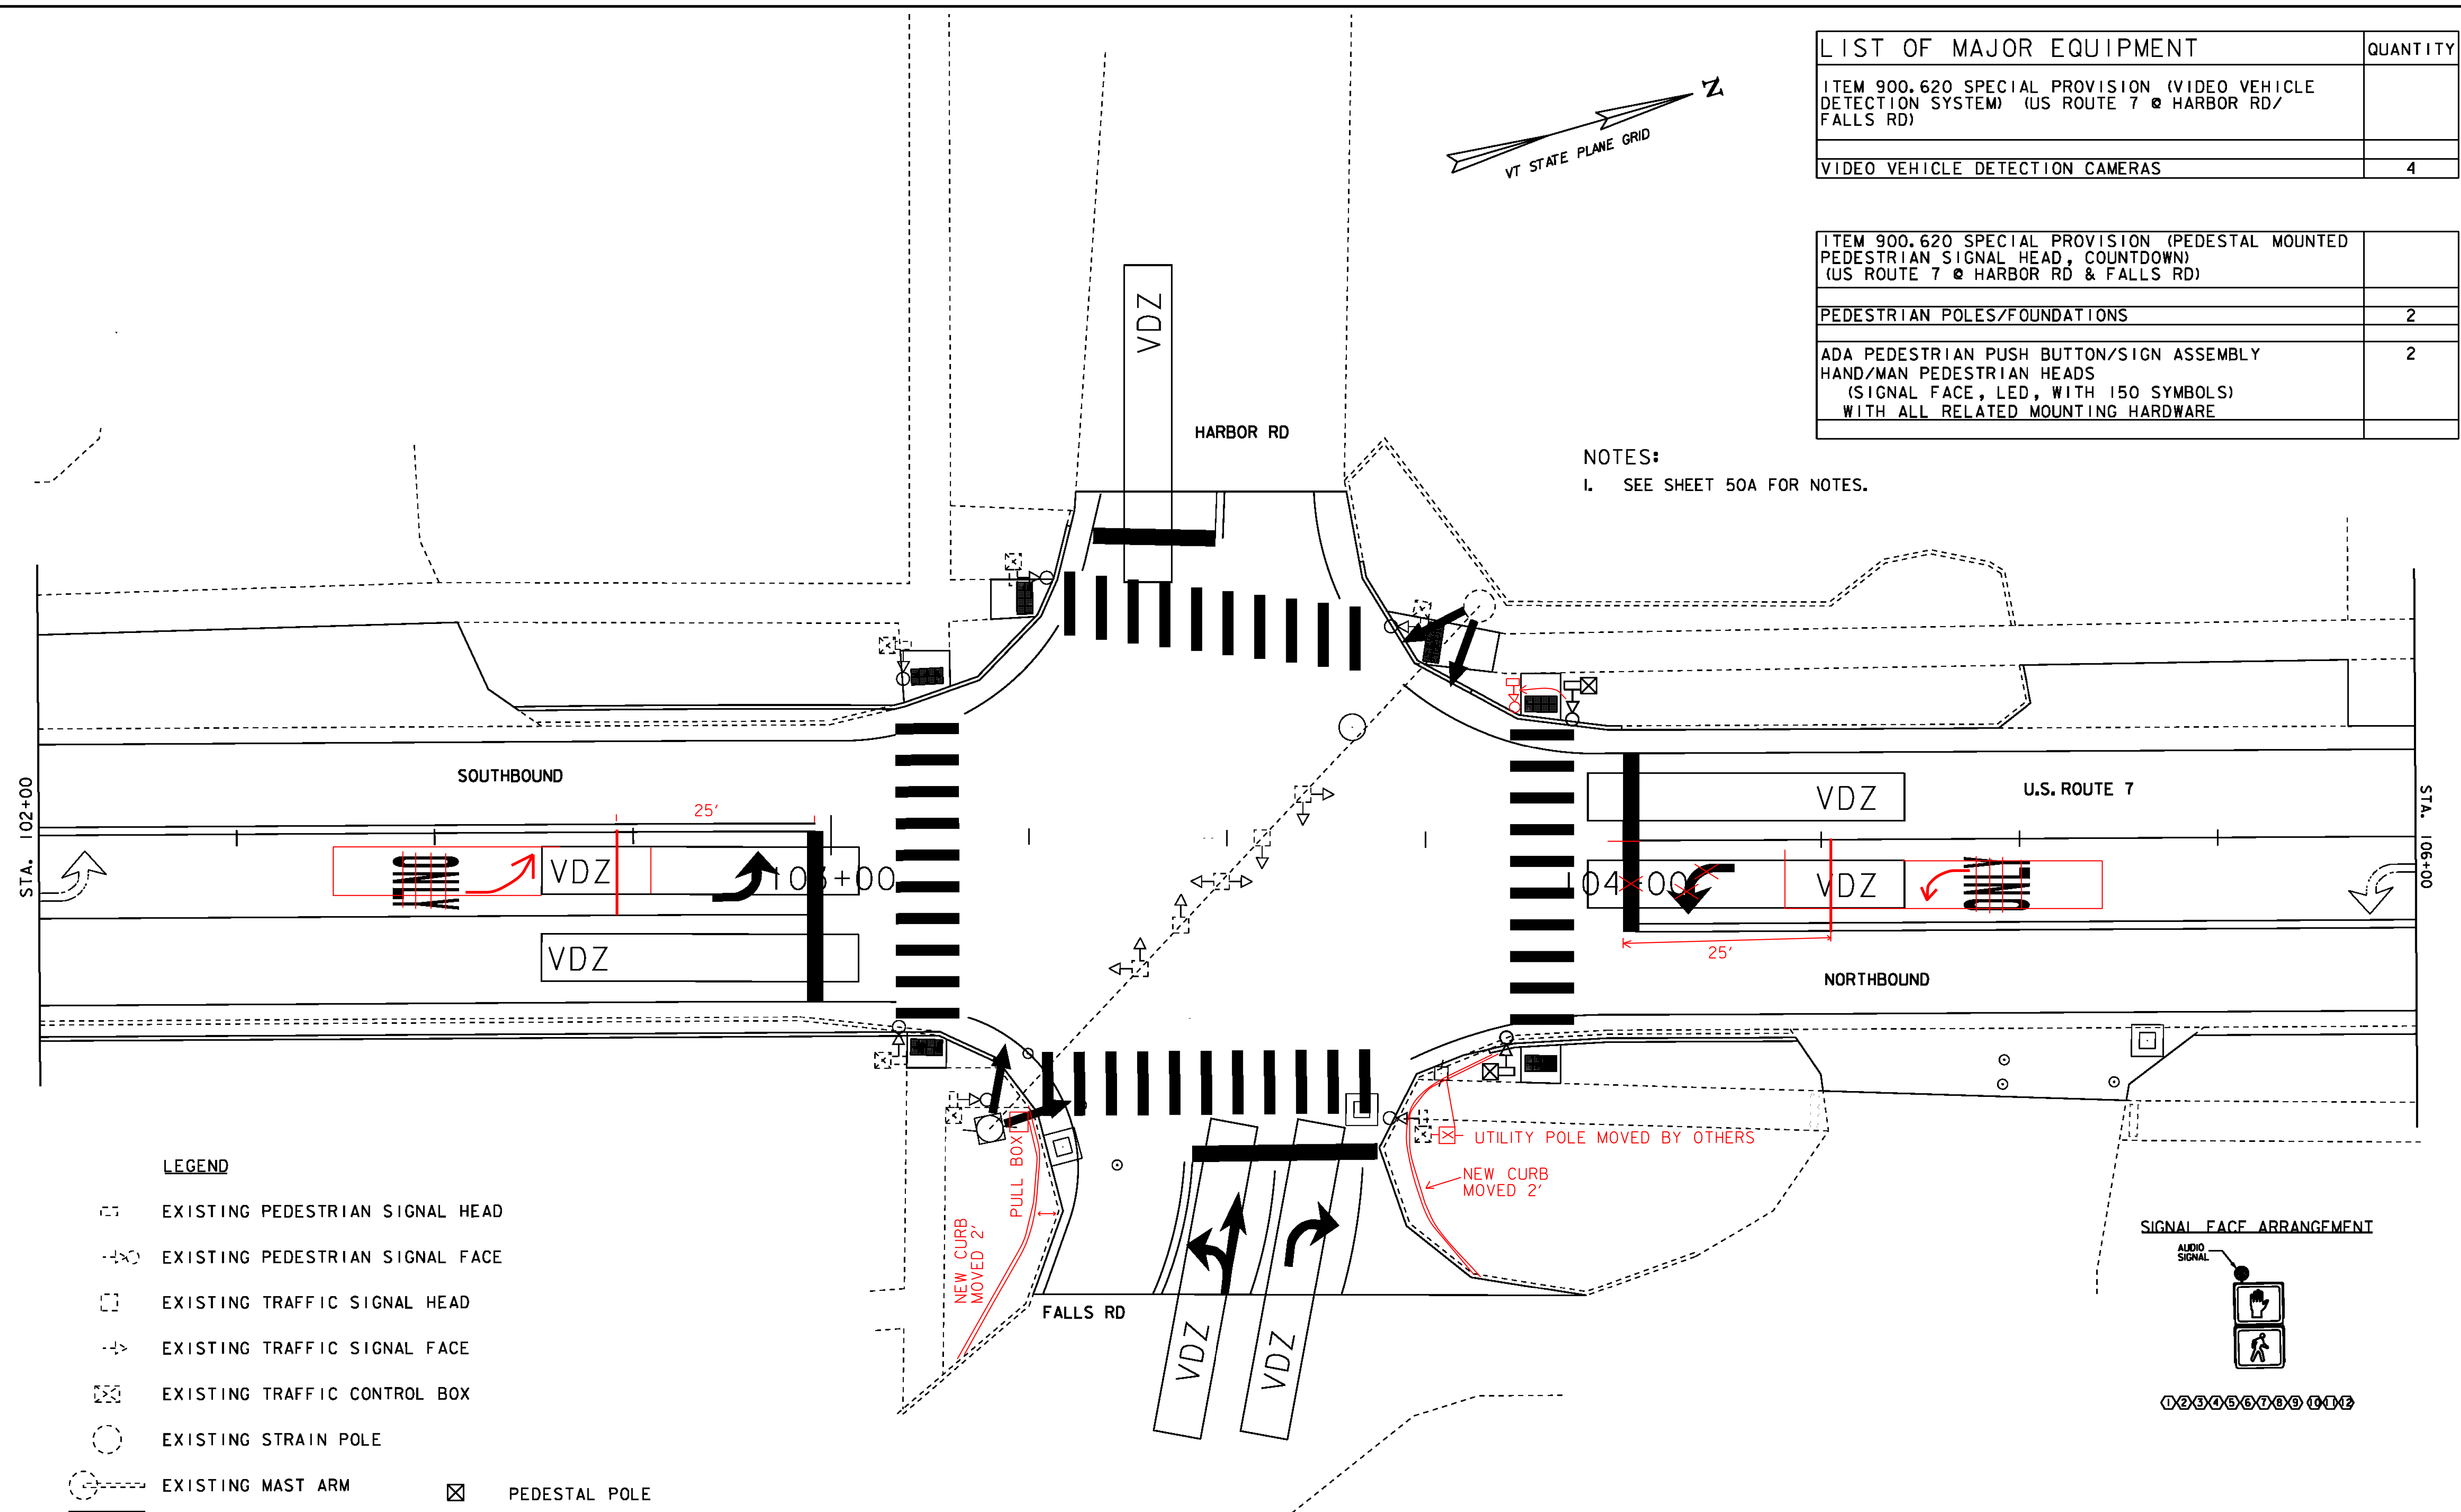

**LEGEND**

- EXISTING PEDESTRIAN SIGNAL HEAD
- EXISTING PEDESTRIAN SIGNAL FACE
- EXISTING TRAFFIC SIGNAL HEAD
- EXISTING TRAFFIC SIGNAL FACE
- EXISTING TRAFFIC CONTROL BOX
- EXISTING STRAIN POLE
- EXISTING MAST ARM
- VIDEO DETECTION ZONE
- VIDEO CAMERA
- PEDESTAL POLE
- PEDESTRIAN SIGNAL HEAD
- PEDESTRIAN SIGNAL FACE

**SIGNAL FACE ARRANGEMENT**

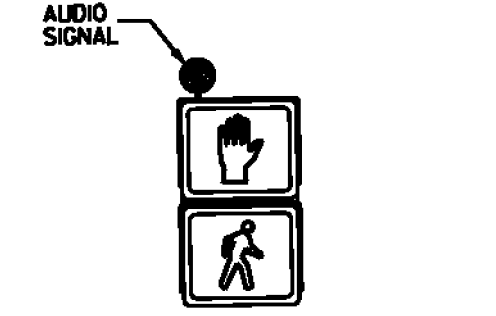

0 2 3 4 5 6 7 8 9 0 1 2

NOT TO SCALE

**INTERSECTION TRAFFIC SIGNAL EQUIPMENT SHEET 3**

PROJECT NAME: CHARLOTTE - SOUTH BURLINGTON  
 PROJECT NUMBER: NH 2907(1)  
 FILE NAME: piOB206.dgn  
 PROJECT LEADER: CDL  
 DESIGNED BY: BMB  
 PLOT FILE: piOB206\_52.f  
 PLOT DATE: 4/19/12  
 DRAWN BY: BMB  
 CHECKED BY: EPD  
 SHEET 52 OF 107