


LIST OF MAJOR EQUIPMENT	QUANTITY
ITEM 900.620 SPECIAL PROVISION (VIDEO VEHICLE DETECTION SYSTEM) (US ROUTE 7 @ MCINTOSH AVE & FAYETT DR)	
VIDEO VEHICLE DETECTION CAMERAS	4

NOTES:
1. SEE SHEET 50A FOR NOTES.

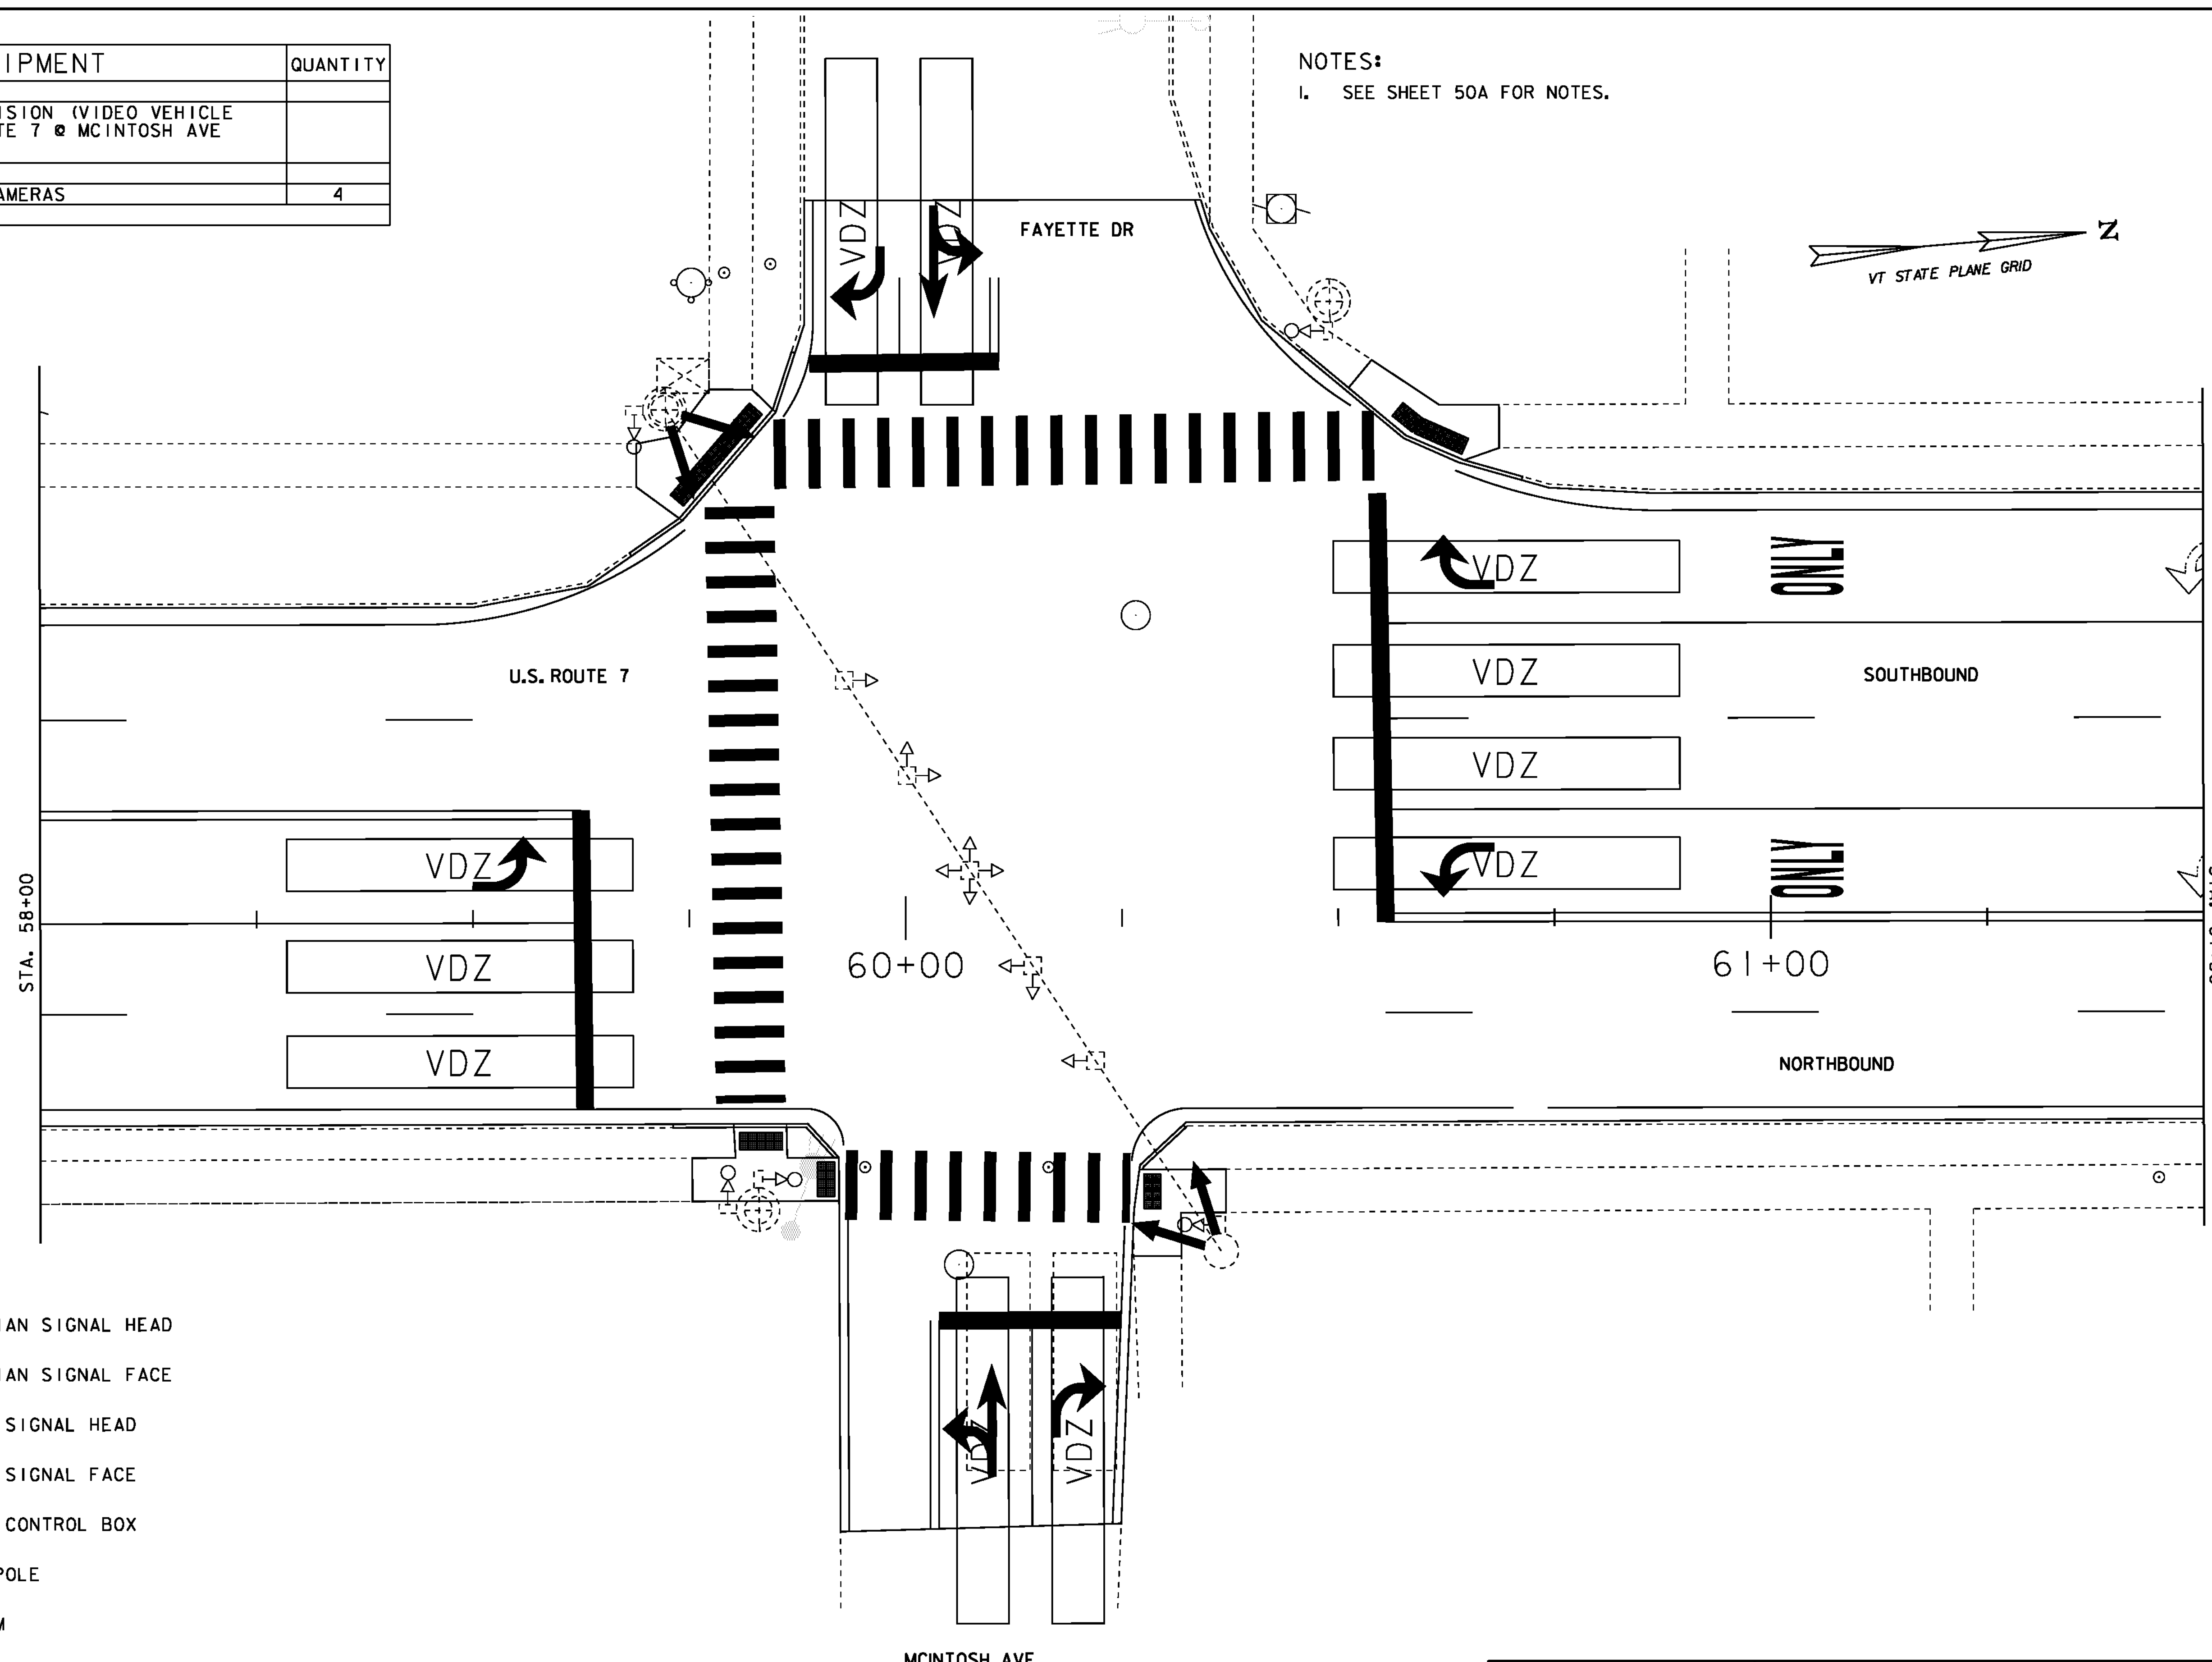

LEGEND

- EXISTING PEDESTRIAN SIGNAL HEAD
- EXISTING PEDESTRIAN SIGNAL FACE
- EXISTING TRAFFIC SIGNAL HEAD
- EXISTING TRAFFIC SIGNAL FACE
- EXISTING TRAFFIC CONTROL BOX
- EXISTING STRAIN POLE
- EXISTING MAST ARM
- VIDEO DETECTION ZONE
- VIDEO CAMERA

NOT TO SCALE

**INTERSECTION
TRAFFIC SIGNAL
EQUIPMENT
SHEET 4**

PROJECT NAME: CHARLOTTE - SOUTH BURLINGTON
PROJECT NUMBER: NH 2907(I)

FILE NAME: p10B206.dgn
PROJECT LEADER: CDL
DESIGNED BY: BMB
PLOT FILE: p10B206_53.I

PLOT DATE: 4/19/12
DRAWN BY: BMB
CHECKED BY: EPD
SHEET 53 OF 107