


LIST OF MAJOR EQUIPMENT	QUANTITY
ITEM 900.620 SPECIAL PROVISION (VIDEO VEHICLE DETECTION SYSTEM) (US ROUTE 7 @ BREWER PRKWY)	
VIDEO VEHICLE DETECTION CAMERAS	4

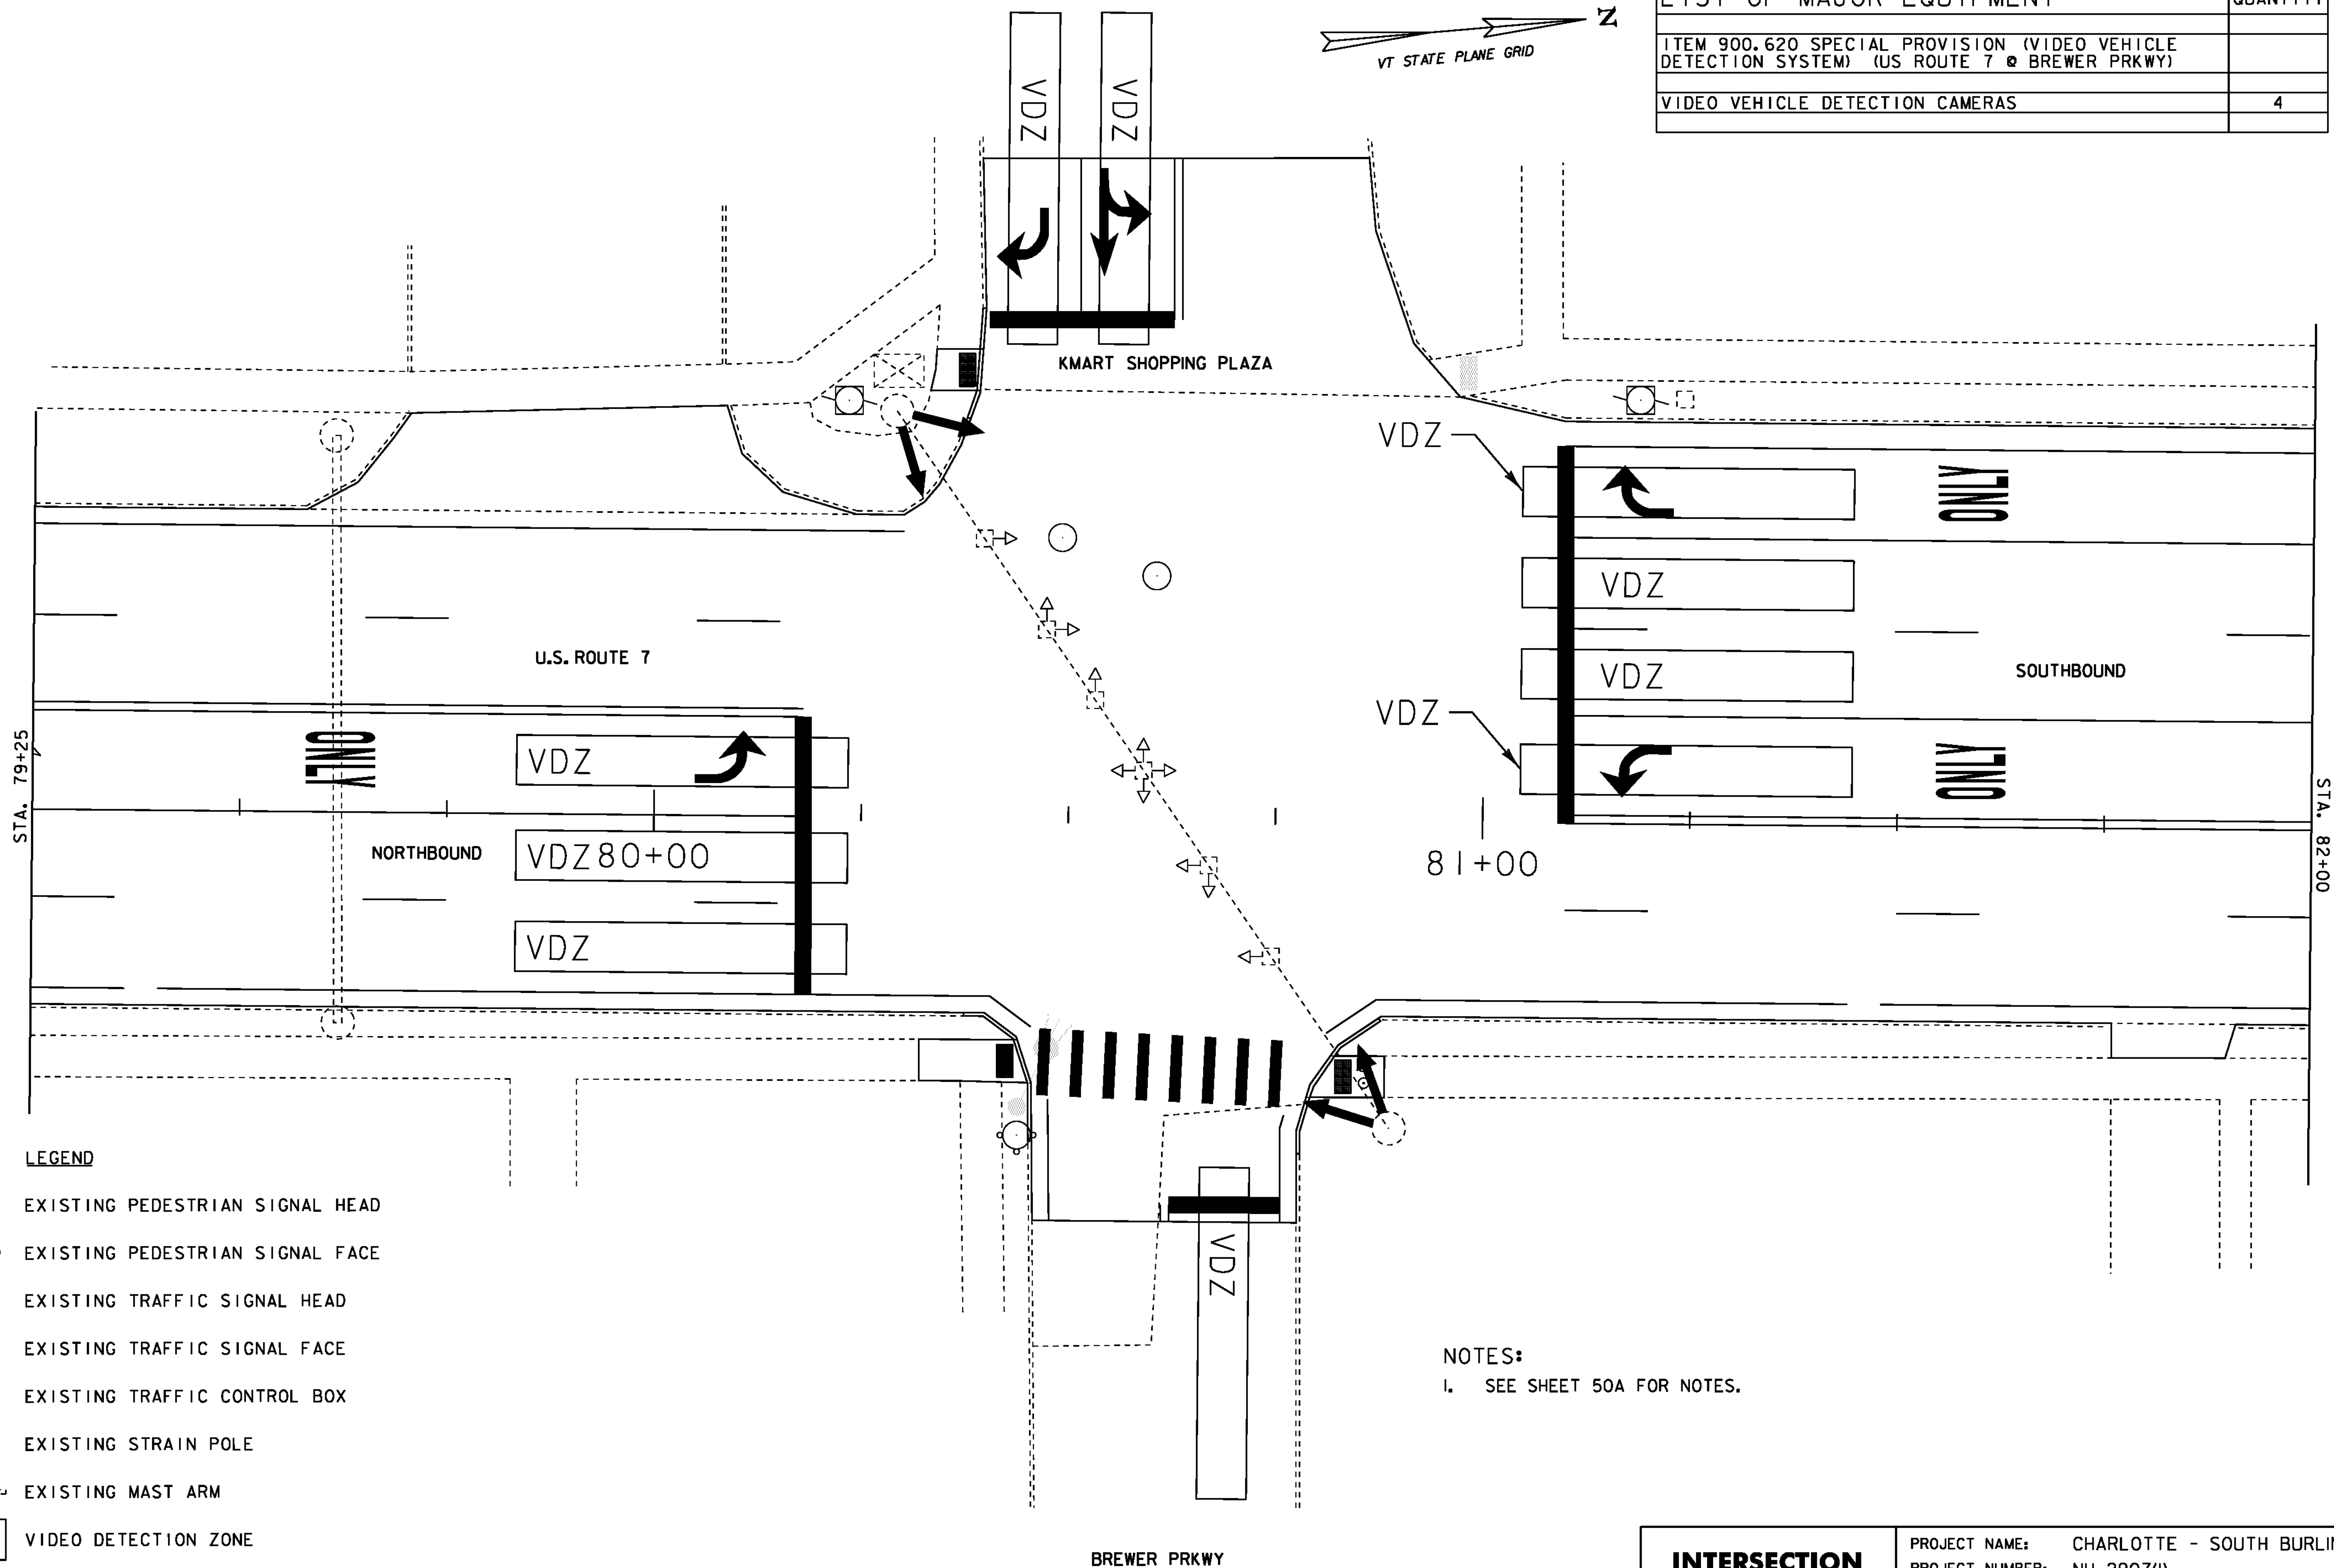

**LEGEND**

- EXISTING PEDESTRIAN SIGNAL HEAD
- EXISTING PEDESTRIAN SIGNAL FACE
- EXISTING TRAFFIC SIGNAL HEAD
- EXISTING TRAFFIC SIGNAL FACE
- EXISTING TRAFFIC CONTROL BOX
- EXISTING STRAIN POLE
- EXISTING MAST ARM
- VIDEO DETECTION ZONE
- VIDEO CAMERA

NOTES:  
1. SEE SHEET 50A FOR NOTES.

NOT TO SCALE

**INTERSECTION  
TRAFFIC SIGNAL  
EQUIPMENT  
SHEET 7**

PROJECT NAME: CHARLOTTE - SOUTH BURLINGTON	PLOT DATE: 4/19/12
PROJECT NUMBER: NH 2907(I)	DRAWN BY: BMB
FILE NAME: p10B206.dgn	CHECKED BY: EPD
PROJECT LEADER: CDL	SHEET 56 OF 107
DESIGNED BY: BMB	
PLOT FILE: p10B206_56.I	