


LEDGE CUT DETAIL

VT. ROUTE 107 STOCKBRIDGE: STA 308+00.0 - STA 313+50.0, RT


LOCATION	HEADWALL		PIPE SIZE	CONCRETE (CY)	REINFORCEMENT (LB)
	HEIGHT	LENGTH			
B 18+24.60	8'-0"	12'-0"	36"	5.63	800

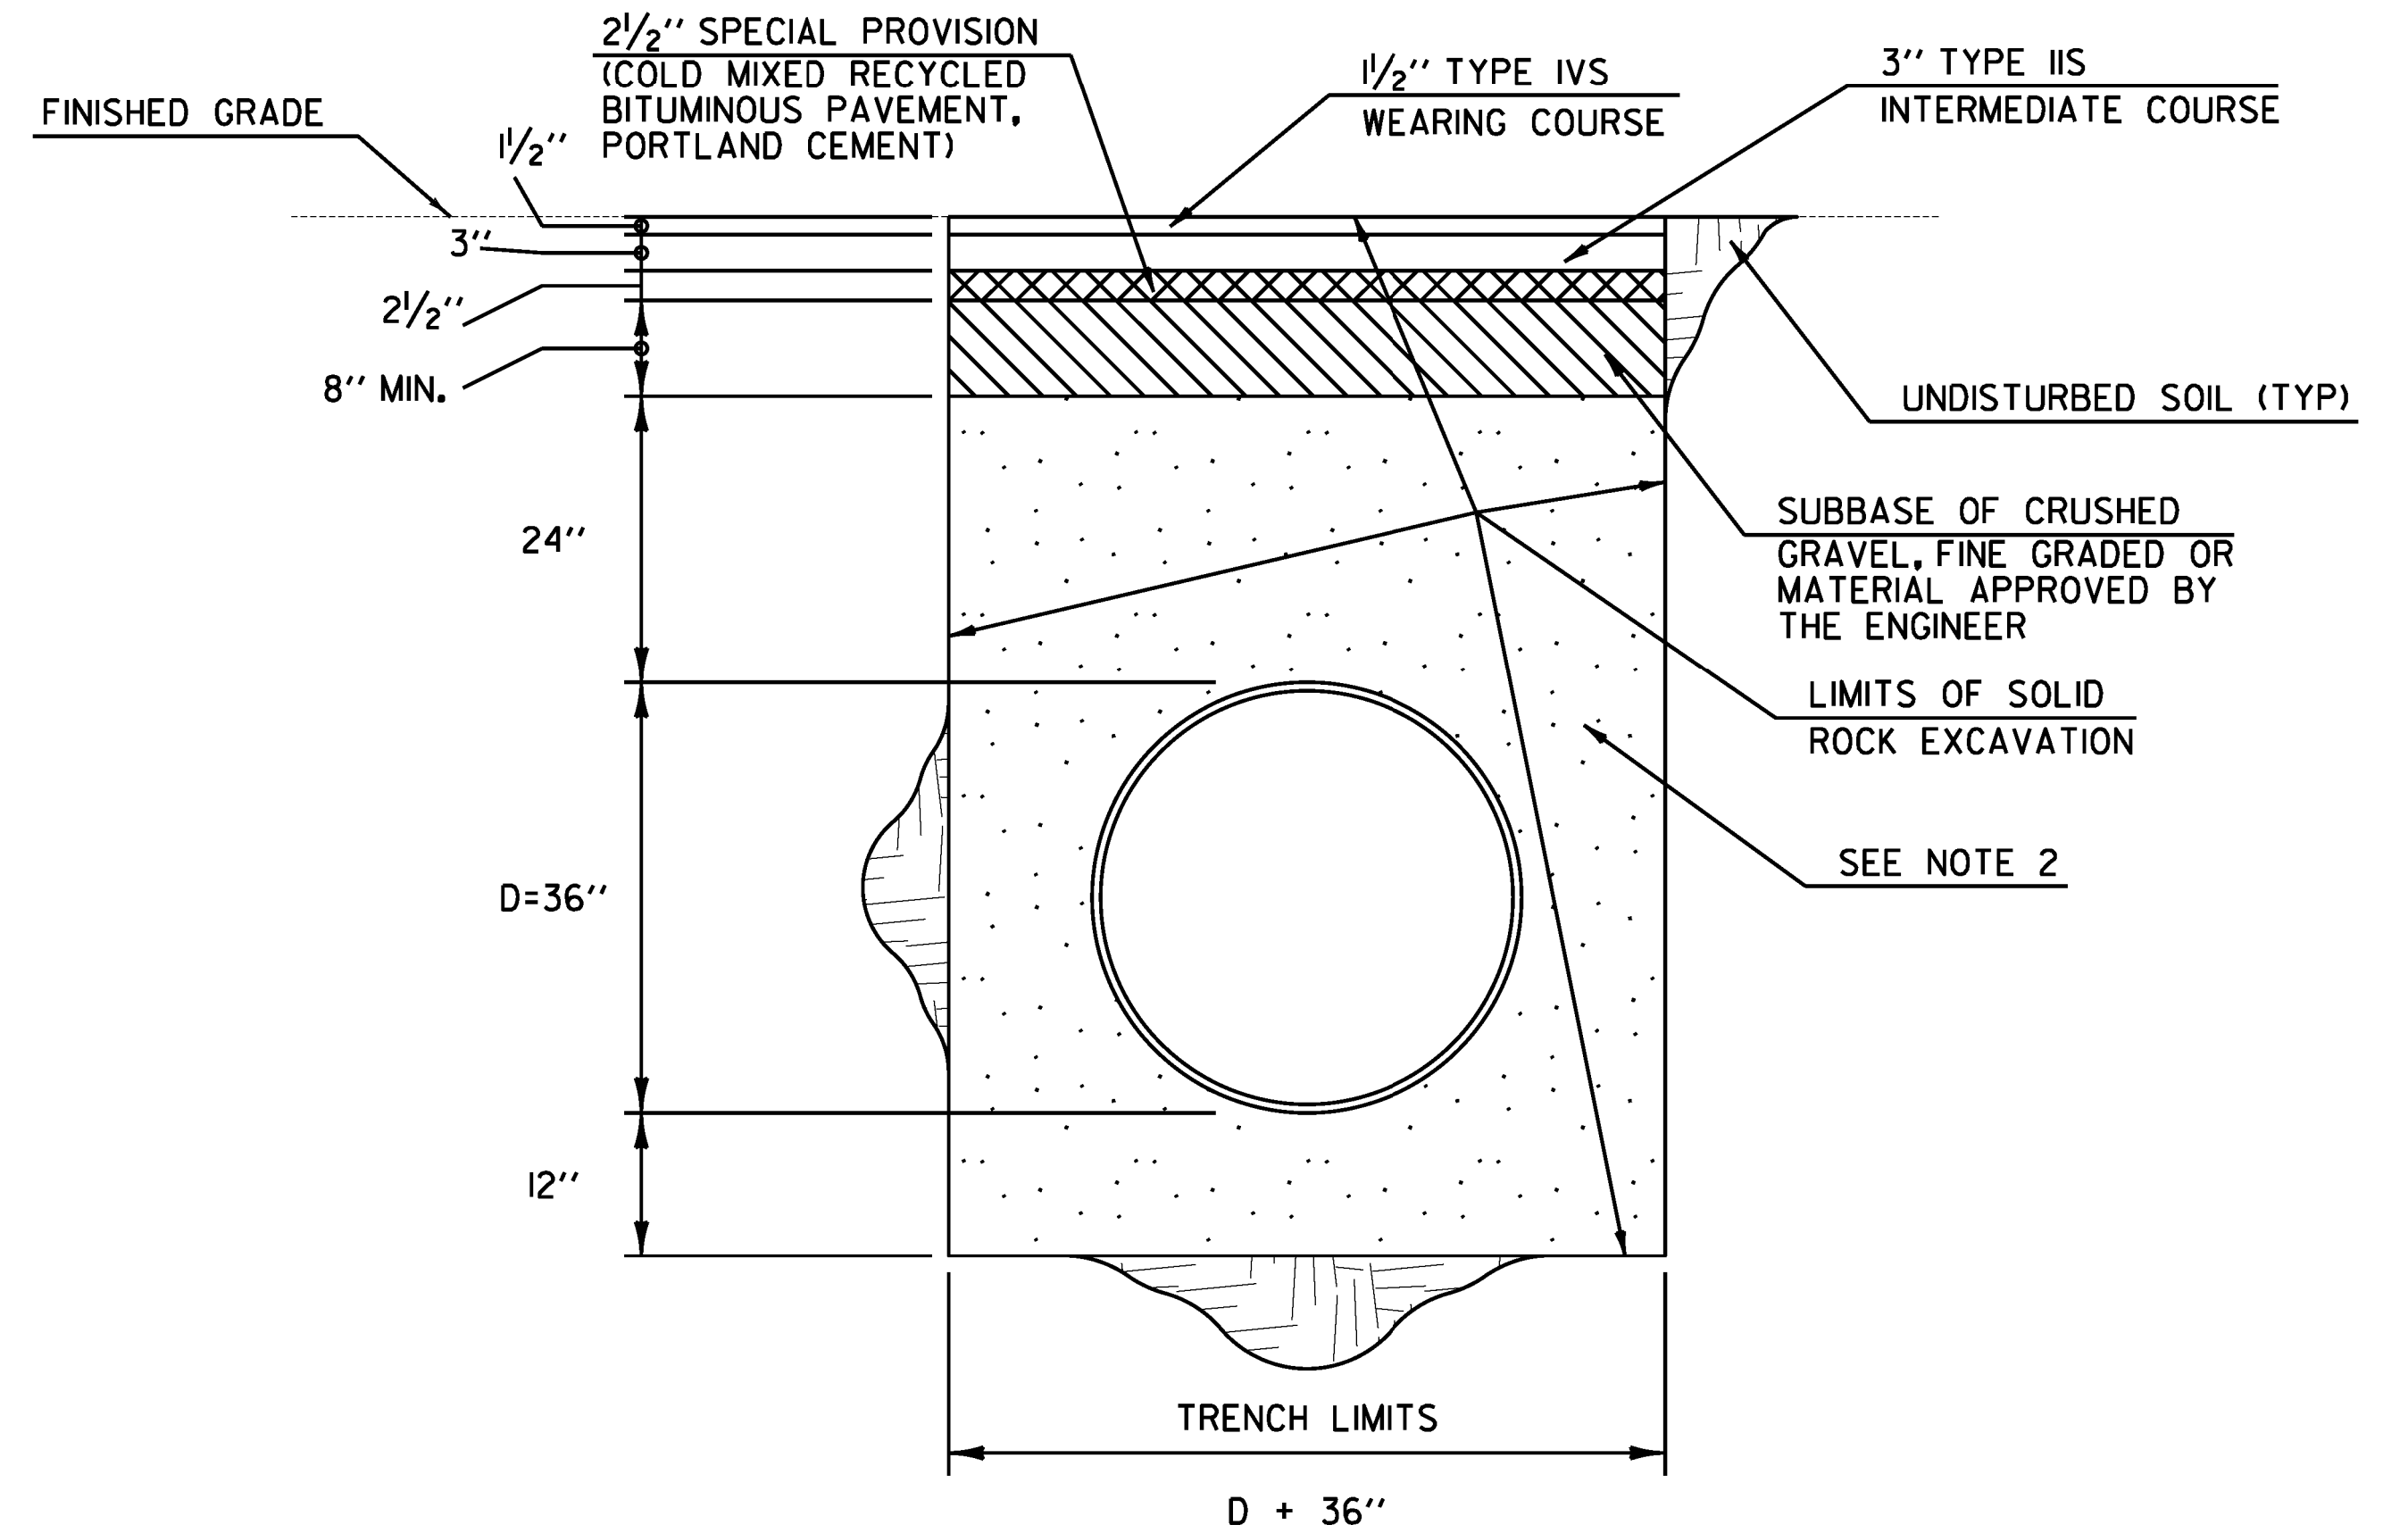


TYPICAL RCP TRENCH DETAIL

NOTES: VT. ROUTE 107 BETHEL: STA B 18+24.6, LT & RT

1. THE CONTRACTOR SHALL KEEP THE TRENCH ENTIRELY FREE OF WATER AT ALL TIMES UNTIL ALL WORK IS FINISHED & READY FOR BACKFILLING.
2. GRANULAR BACKFILL FOR STRUCTURES OR MATERIAL APPROVED BY THE ENGINEER COMPACTED IN 6" LIFTS.

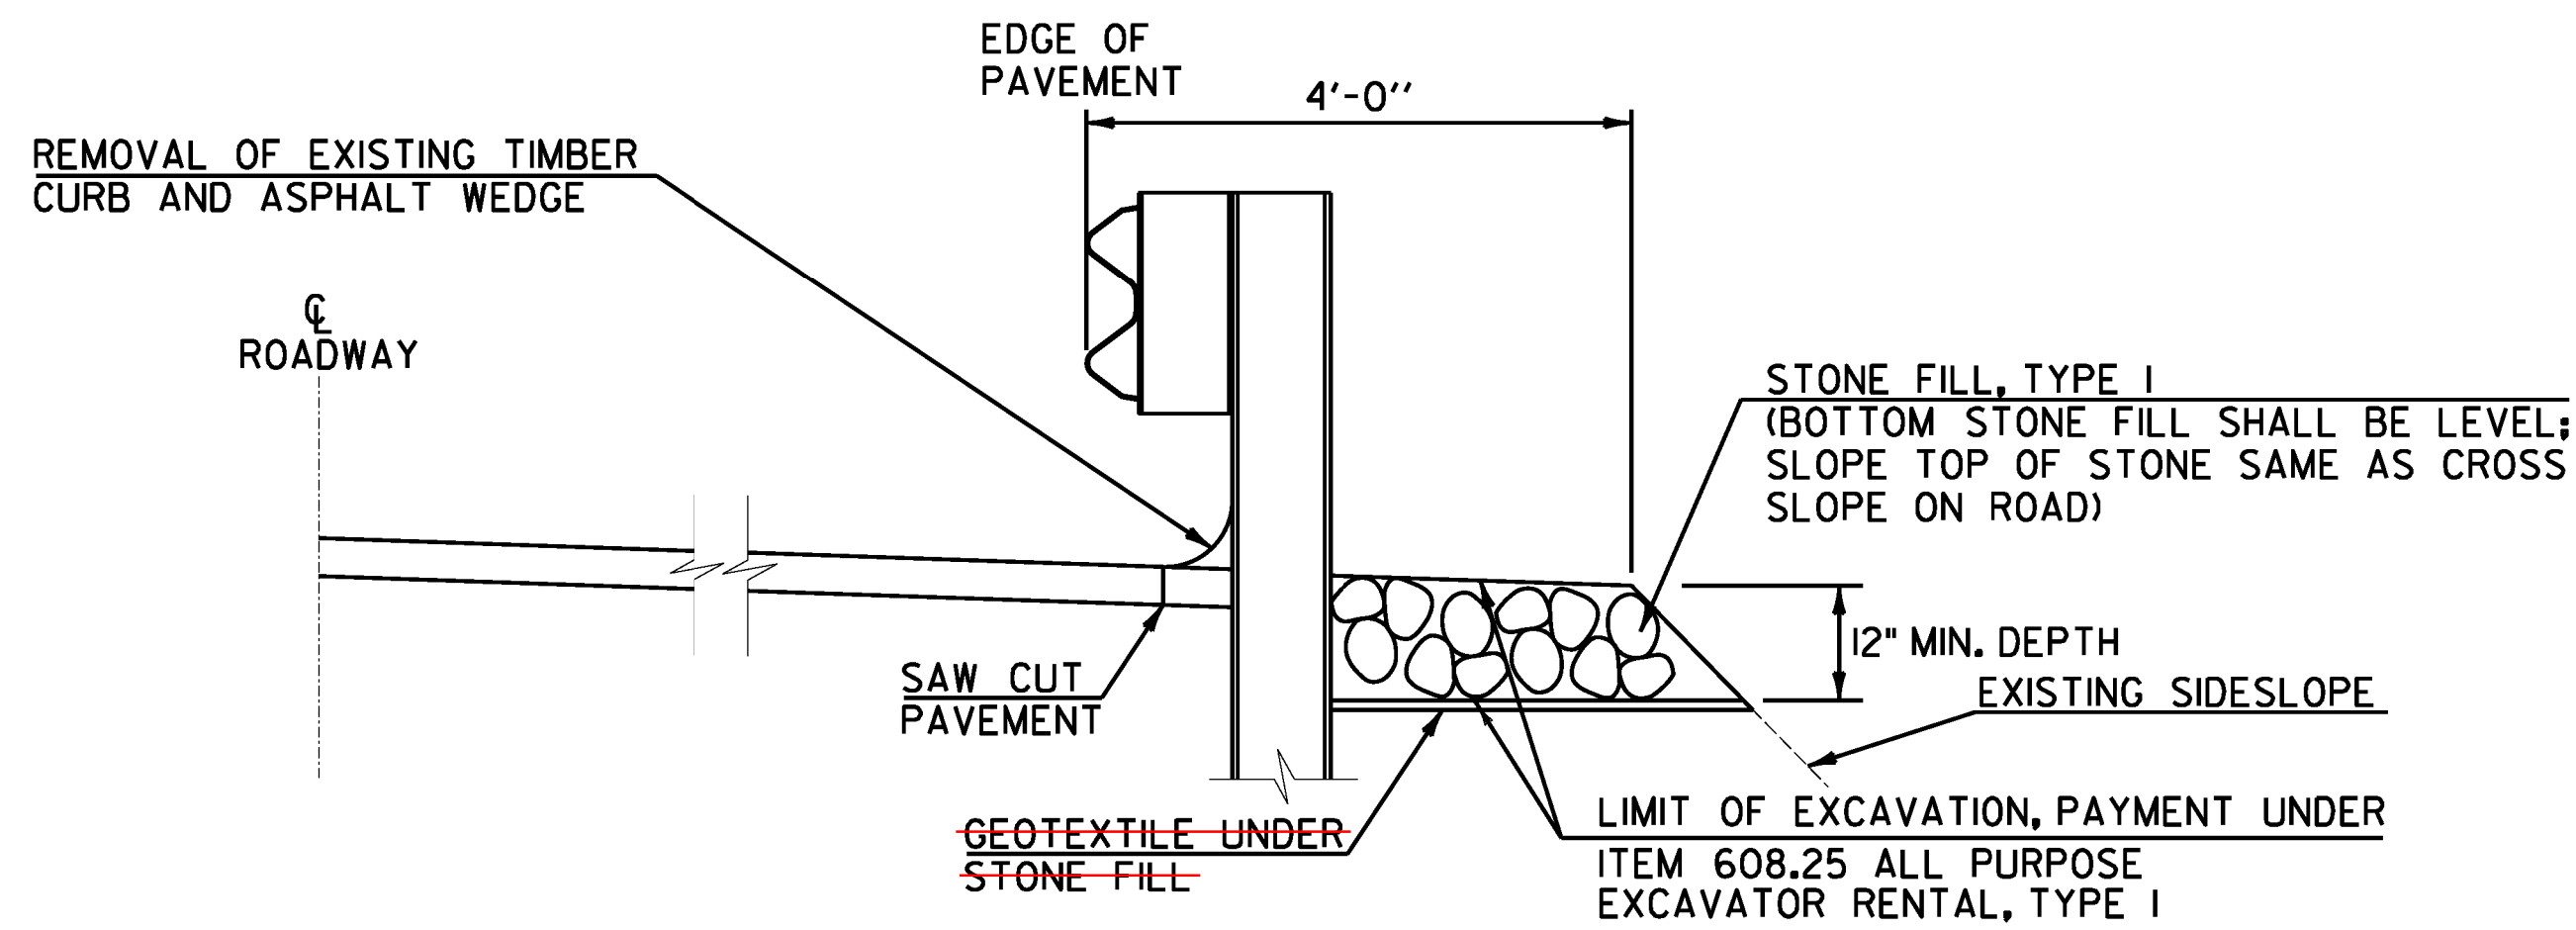

CURB REMOVAL AND STONE FILL BACKING DETAIL

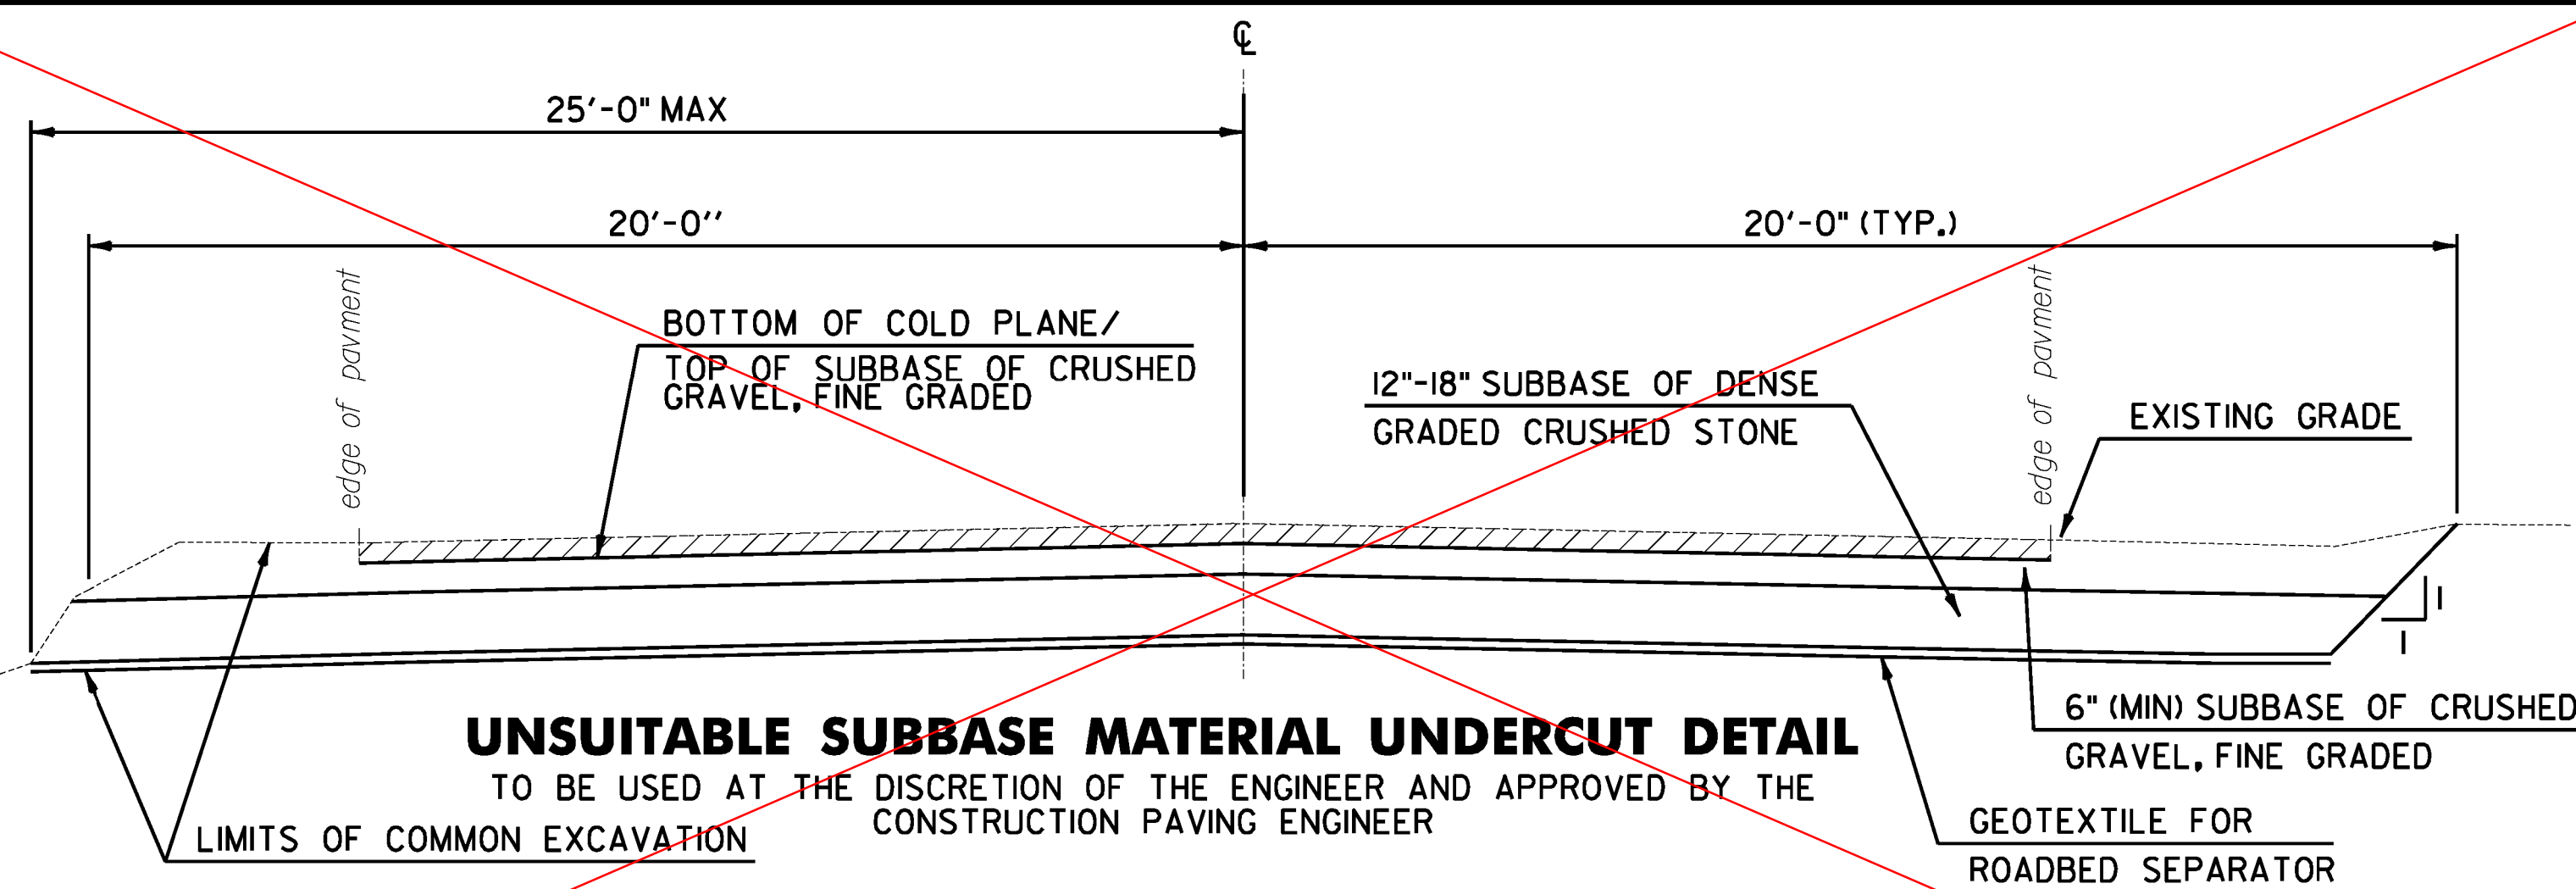


UNSUITABLE SUBBASE MATERIAL UNDERCUT DETAIL

TO BE USED AT THE DISCRETION OF THE ENGINEER AND APPROVED BY THE CONSTRUCTION PAVING ENGINEER

NOTES:

1. UNDERCUT CANDIDATE AREAS ENCOUNTERED DURING CONSTRUCTION SHALL BE REVIEWED AND APPROVED BY THE VTRANS CONSTRUCTION PAVING ENGINEER PRIOR TO TREATMENT.
2. ALL DEPTHS TO BE APPROVED BY ENGINEER PRIOR TO WORK BEING PERFORMED
3. ALL UNDERCUTS SHALL BE FULL WIDTH AS DIRECTED BY THE ENGINEER.

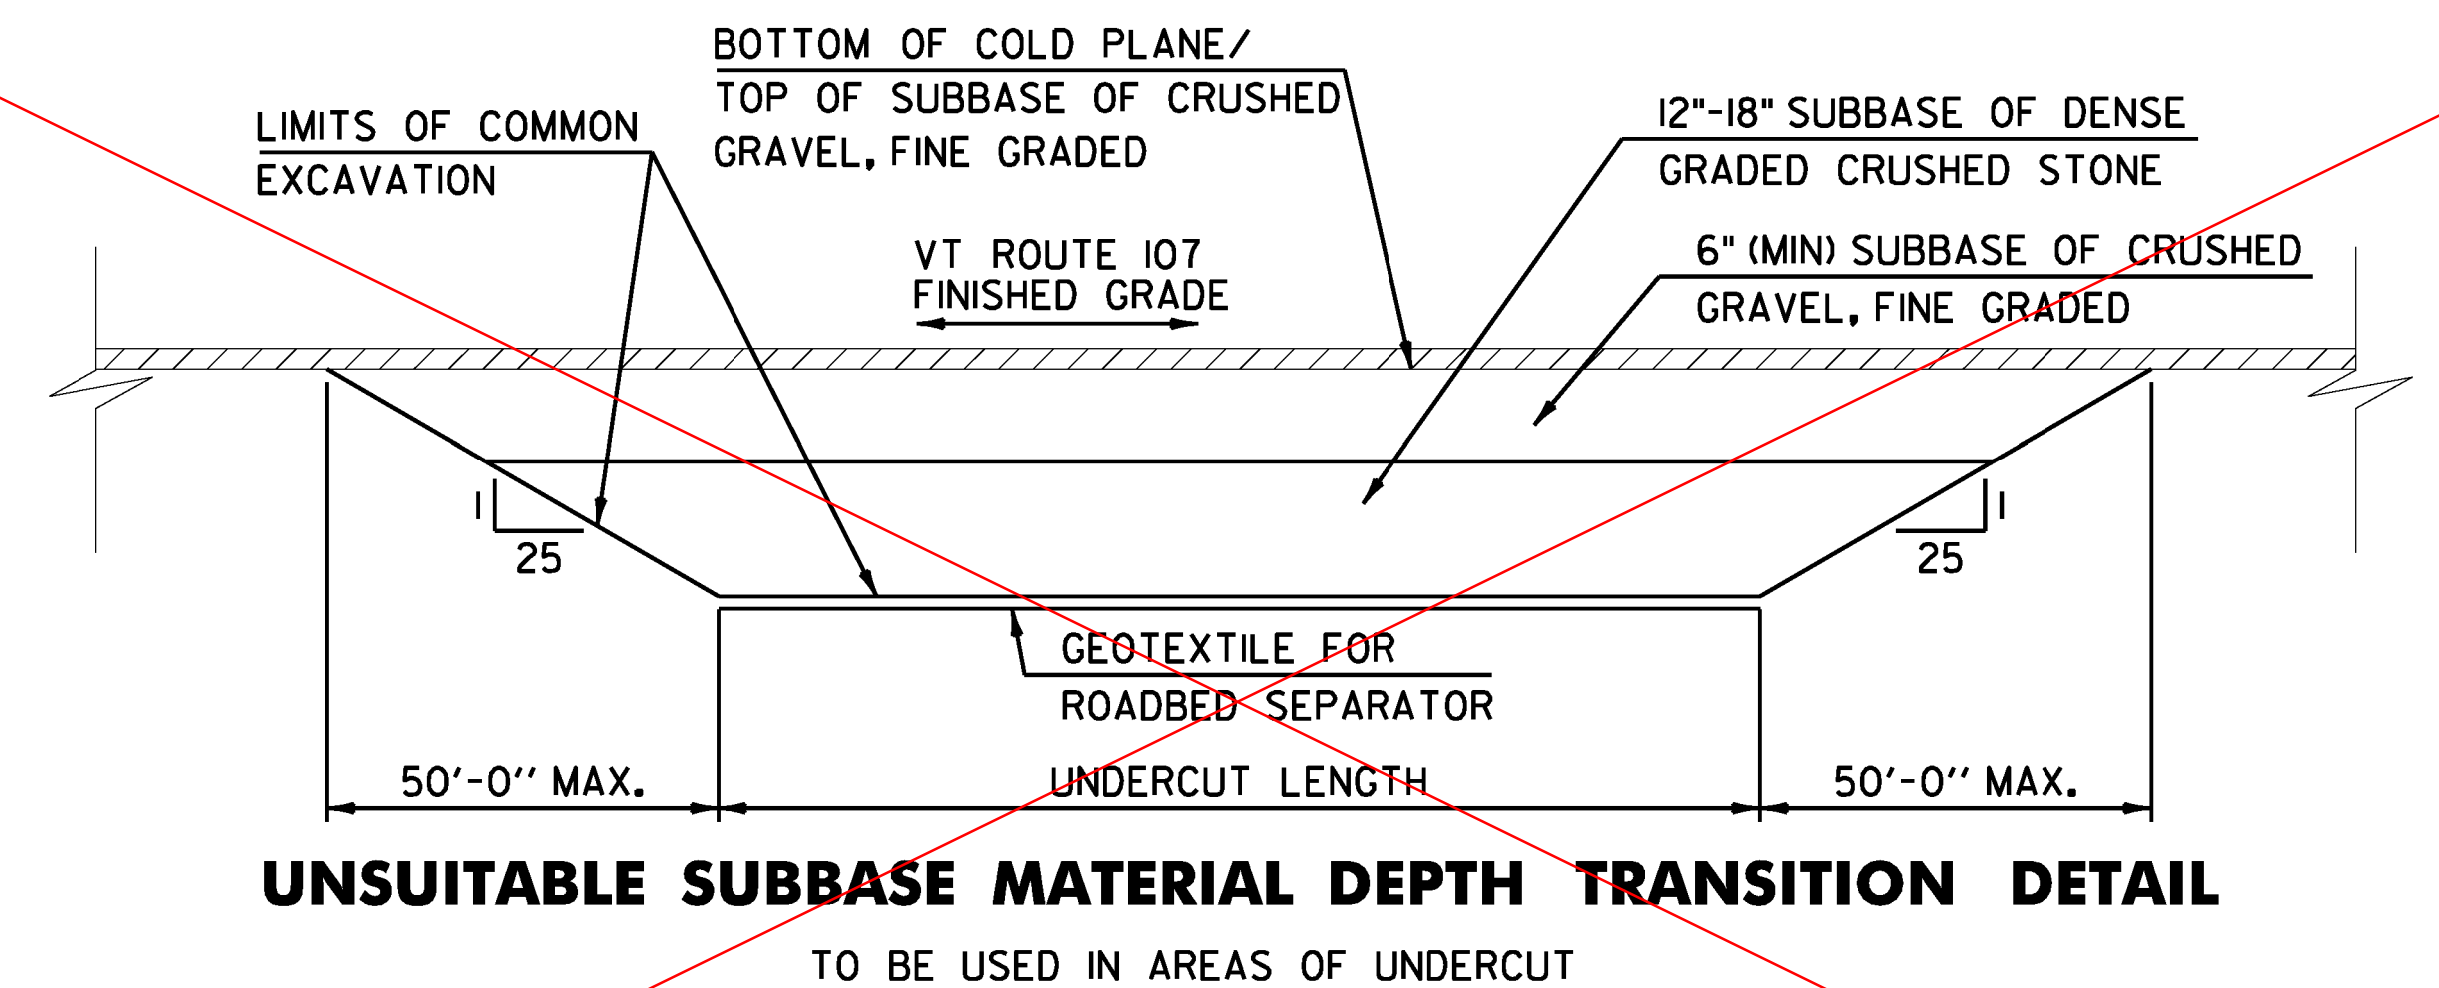

UNSUITABLE SUBBASE MATERIAL DEPTH TRANSITION DETAIL

FILE NAME = V:\Projects\107\10722426\CADD\MSTN\z10b214.mdt.dgn
DATE = 3/17/2014
USER = 14916

MISCELLANEOUS DETAILS SHEET #2

PROJECT NAME: STOCKBRIDGE-BETHEL

PROJECT NUMBER: STP 2910(1)

FILE NAME: z10b214.mdt.dgn

PROJECT LEADER: D.E.G.

DESIGNED BY: L.M.B.

IPARM FILE: z10b214mdt2.i

PLOT DATE: 3/17/2014

DRAWN BY: W.G.P.

CHECKED BY: J.P.S.

SHEET 26 OF 397