


VT. ROUTE 100  
STA V 10+00.00 =  
VT. ROUTE 107  
STA 2+88.22

**VT. ROUTE 100 /VT. ROUTE 107 INTERSECTION GRADING**

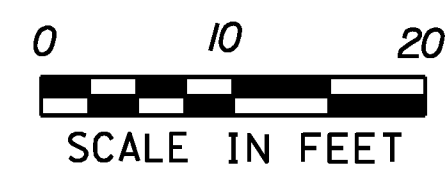

<b>VT. ROUTE 100/ VT. ROUTE 107 GRADING PLAN</b>	PROJECT NAME: STOCKBRIDGE-BETHEL
	PROJECT NUMBER: STP 2910(1)
	FILE NAME: z10b214_grad.pln.dgn
	PLOT DATE: 3/17/2014
	PROJECT LEADER: D.E.G.
	DESIGNED BY: L.M.B.
	IPARM FILE: z10b214gradpln.i
	CHECKED BY: J.P.S.
	SHEET 30 OF 397

FILE NAME: Y:\P\c\gras\ANY\K2\22425\CA001\MSTN\10b214\_grad.pln.dgn  
 DATE/TIME: 3/17/2014 4:51:16  
 USER: J.P.S.