



~~646.402 DURABLE 4 INCH WHITE LINE, THERMOPLASTIC OR~~
~~646.404 DURABLE 4 INCH WHITE LINE, POLYUREA~~
 (ALL LINES WILL INCLUDE EDGE LINE BREAKS AND
 RADIUS FOR TOWN HIGHWAYS)
 STOCKBRIDGE:
 STA 23+50.00 - STA 29+50.00 LT & RT

646.602 TEMPORARY 4 INCH WHITE LINE, PAINT
 (ALL LINES WILL INCLUDE EDGE LINE BREAKS AND
 RADIUS FOR TOWN HIGHWAYS)
 STOCKBRIDGE:
 STA 23+50.00 - STA 29+50.00 LT & RT

213.10 MILLED RUMBLE STRIPS
 (ALL CLRS WILL INCLUDE C/L
 BREAKS FOR TOWN HIGHWAYS)
 STOCKBRIDGE:
 STA 23+50.0 - STA 29+50.0 C/L (600.0 LF)

646.414 DURABLE 4 INCH YELLOW LINE, POLYUREA
 (ALL LINES WILL INCLUDE C/L BREAKS FOR
 TOWN HIGHWAYS) S=SOLID, D=DASHED
 STOCKBRIDGE:
 STA 23+50.00 - STA 27+72.00 LT ϕ RT
 S - S
 STA 27+72.00 - STA 29+50.00 S - D


646.612 TEMPORARY 4 INCH YELLOW LINE, PAINT
 (ALL LINES WILL INCLUDE C/L BREAKS FOR
 TOWN HIGHWAYS) S=SOLID, D=DASHED
 STOCKBRIDGE:
 STA 23+50.00 - STA 27+72.00 LT ϕ RT
 S - S
 STA 27+72.00 - STA 29+50.00 S - D

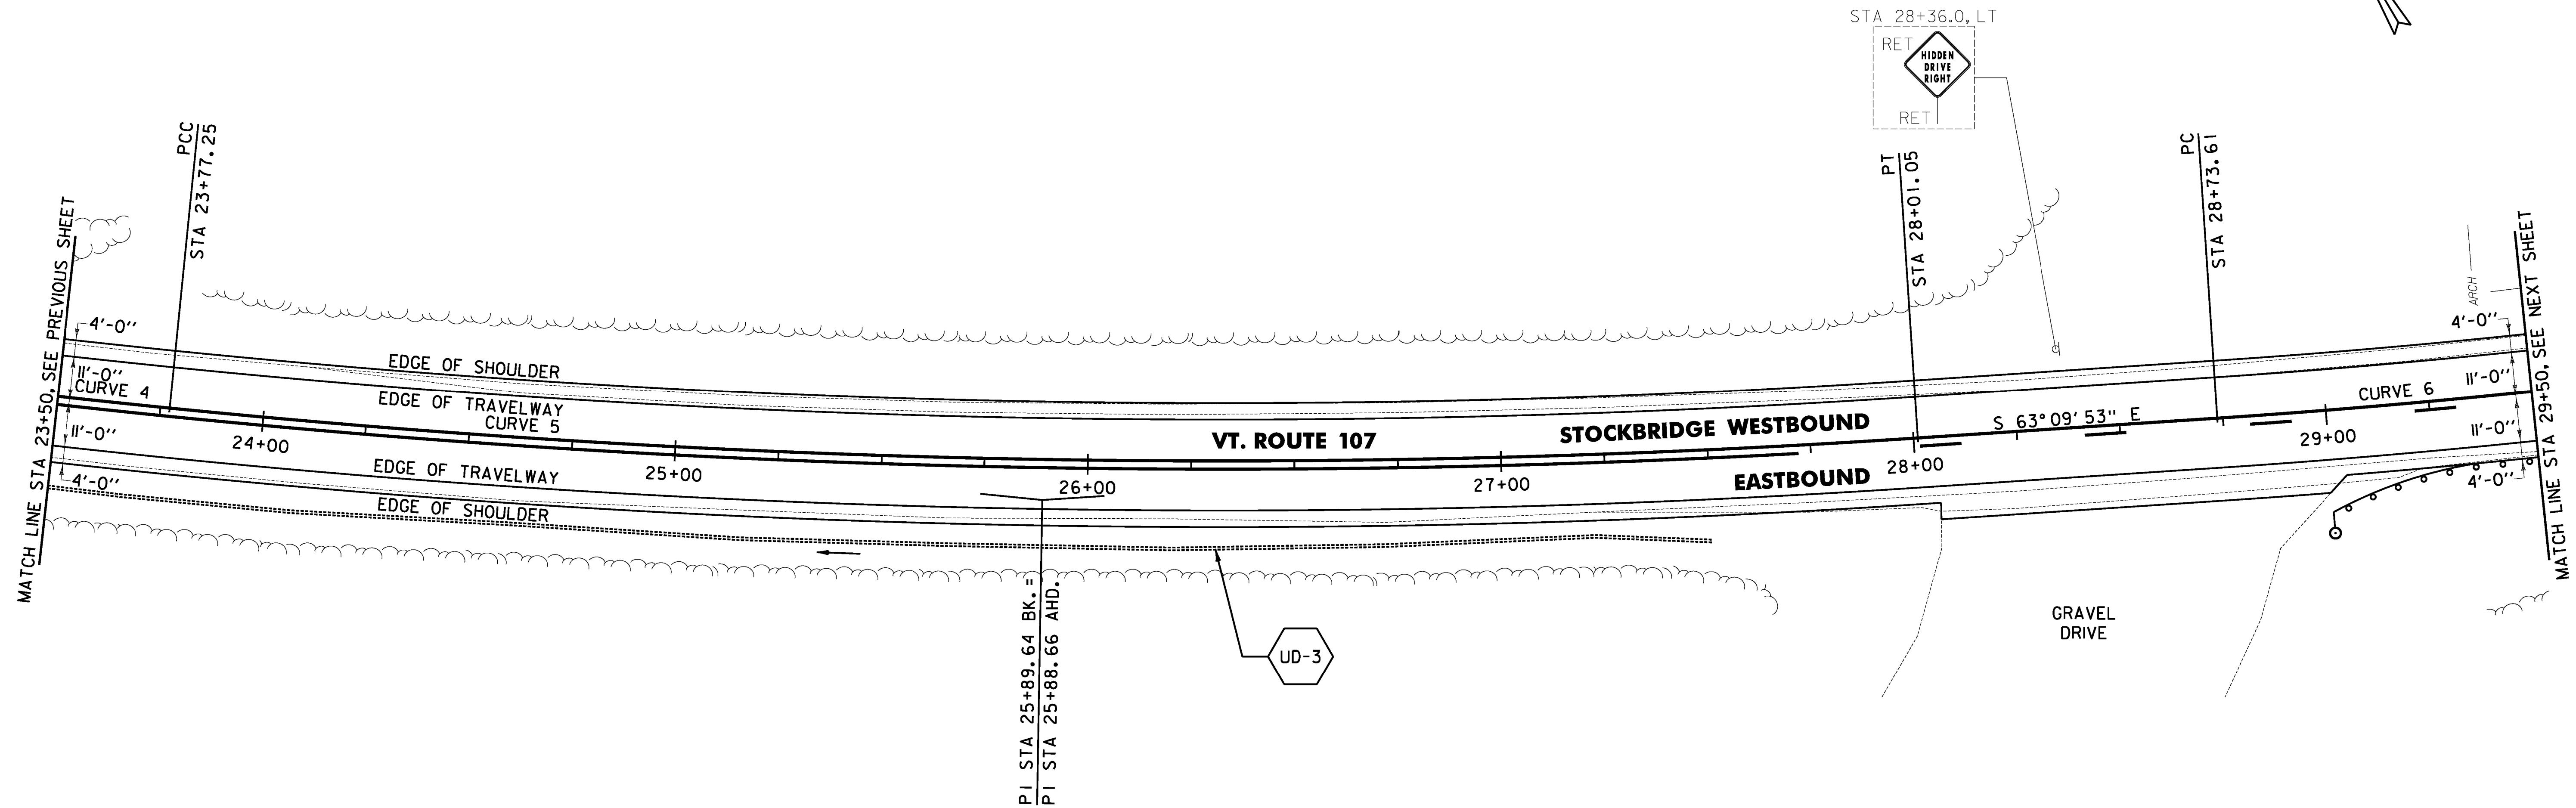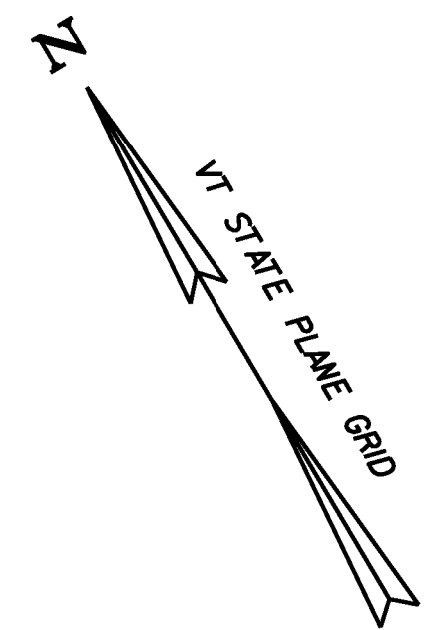

PI STA 25+89.64 BK. =
 PI STA 25+88.66 AHD.

NOTE:

1. THE CONTRACTOR SHALL BE AWARE THAT AN UNDERGROUND FIBER OPTIC FACILITY EXISTS ALONG VT 107. THE LOCATION SHOWN ON THE PLANS IS APPROXIMATE, AND THE POTENTIAL EXISTS FOR CONFLICTS WITH THE FIBER OPTIC AND THE PROPOSED UNDERDRAIN AT VARIOUS LOCATIONS THROUGHOUT THE PROJECT. THE CONTRACTOR IS ADVISED THAT, PRIOR TO CONSTRUCTION, ALL PROPOSED UNDERDRAIN LOCATIONS SHALL BE FIELD VERIFIED WITH THE ENGINEER AND RELOCATED AS NECESSARY TO ELIMINATE ANY CONFLICTS WITH THE FIBER OPTIC FACILITY.

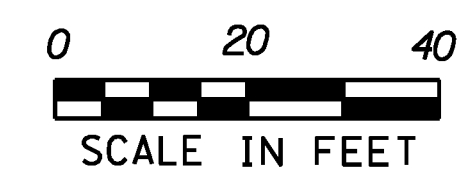

621.205 STEEL BEAM GUARDRAIL, GALVANIZED W/8 FEET POSTS

STOCKBRIDGE:
 STA 29+00.0 - STA 29+50.0 RT (50.0 LF)
 29+04.0

621.60 ANCHOR FOR STEEL BEAM RAIL

STOCKBRIDGE:
 STA 29+06.5 RT

~~653.20 TEMPORARY EROSION MATTING~~

~~STOCKBRIDGE:
 STA 26+50.0 - STA 27+50.0 RT (38.3 SY)~~

676.10 DELINEATOR WITH STEEL POST

STOCKBRIDGE:
 STA 29+00.0 RT

CURVE 4
 $\Delta = 12^{\circ} 03' 44''$
 $D = 2^{\circ} 17' 31''$
 $R = 2500.00'$
 $T = 264.13'$
 $L = 526.31'$
 $E = 13.91'$
 $e = 0.044 \text{ FT/FT}$

CURVE 5
 $\Delta = 9^{\circ} 31' 20''$
 $D = 2^{\circ} 14' 49''$
 $R = 2550.00'$
 $T = 212.39'$
 $L = 423.80'$
 $E = 8.83'$
 $e = 0.044 \text{ FT/FT}$

CURVE 6
 $\Delta = 8^{\circ} 21' 13''$
 $D = 2^{\circ} 51' 53''$
 $R = 2000.00'$
 $T = 146.06'$
 $L = 291.60'$
 $E = 5.33'$
 $e = 0.052 \text{ FT/FT}$

SIGN LEGEND
 R = REMOVE
 S = SALVAGE
 N = NEW
 RET = RETAIN
 B-B = BACK TO BACK
 EXISTING = -----
 NEW = _____

PROJECT LAYOUT SHEET #5

PROJECT NAME: STOCKBRIDGE-BETHEL

PROJECT NUMBER: STP 2910(1)

FILE NAME: z10b214_bdr_nul.05.dgn

PROJECT LEADER: D.E.G.

DESIGNED BY: L.M.B.

IPARM FILE: z10b214105.i

PLOT DATE: 3/17/2014

DRAWN BY: W.G.P.

CHECKED BY: J.P.S.

SHEET 38 OF 397