



~~646.402 DURABLE 4 INCH WHITE LINE, THERMOPLASTIC OR~~
~~646.404 DURABLE 4 INCH WHITE LINE, POLYUREA~~
 (ALL LINES WILL INCLUDE EDGE LINE BREAKS AND
 RADIUS FOR TOWN HIGHWAYS)
 STOCKBRIDGE:
 STA 293+50.00 - STA 299+50.00 LT & RT

646.602 TEMPORARY 4 INCH WHITE LINE, PAINT
 (ALL LINES WILL INCLUDE EDGE LINE BREAKS AND
 RADIUS FOR TOWN HIGHWAYS)
 STOCKBRIDGE:
 STA 293+50.00 - STA 299+50.00 LT & RT

213.10 MILLED RUMBLE STRIPS
 (ALL CLRS WILL INCLUDE C/L
 BREAKS FOR TOWN HIGHWAYS)
 STOCKBRIDGE:
 STA 293+50.0 - STA 299+50.0 C/L (600.0 LF)
 295+86.0
 STA 299+10.0 - STA 299+50.0 C/L (40.0 LF)

646.414 DURABLE 4 INCH YELLOW LINE, POLYUREA
 (ALL LINES WILL INCLUDE C/L BREAKS FOR
 TOWN HIGHWAYS) S=SOLID, D=DASHED
 STOCKBRIDGE:
 STA 293+50.00 - STA 299+50.00

646.612 TEMPORARY 4 INCH YELLOW LINE, PAINT
 (ALL LINES WILL INCLUDE C/L BREAKS FOR
 TOWN HIGHWAYS) S=SOLID, D=DASHED
 STOCKBRIDGE:
 STA 293+50.00 - STA 299+50.00

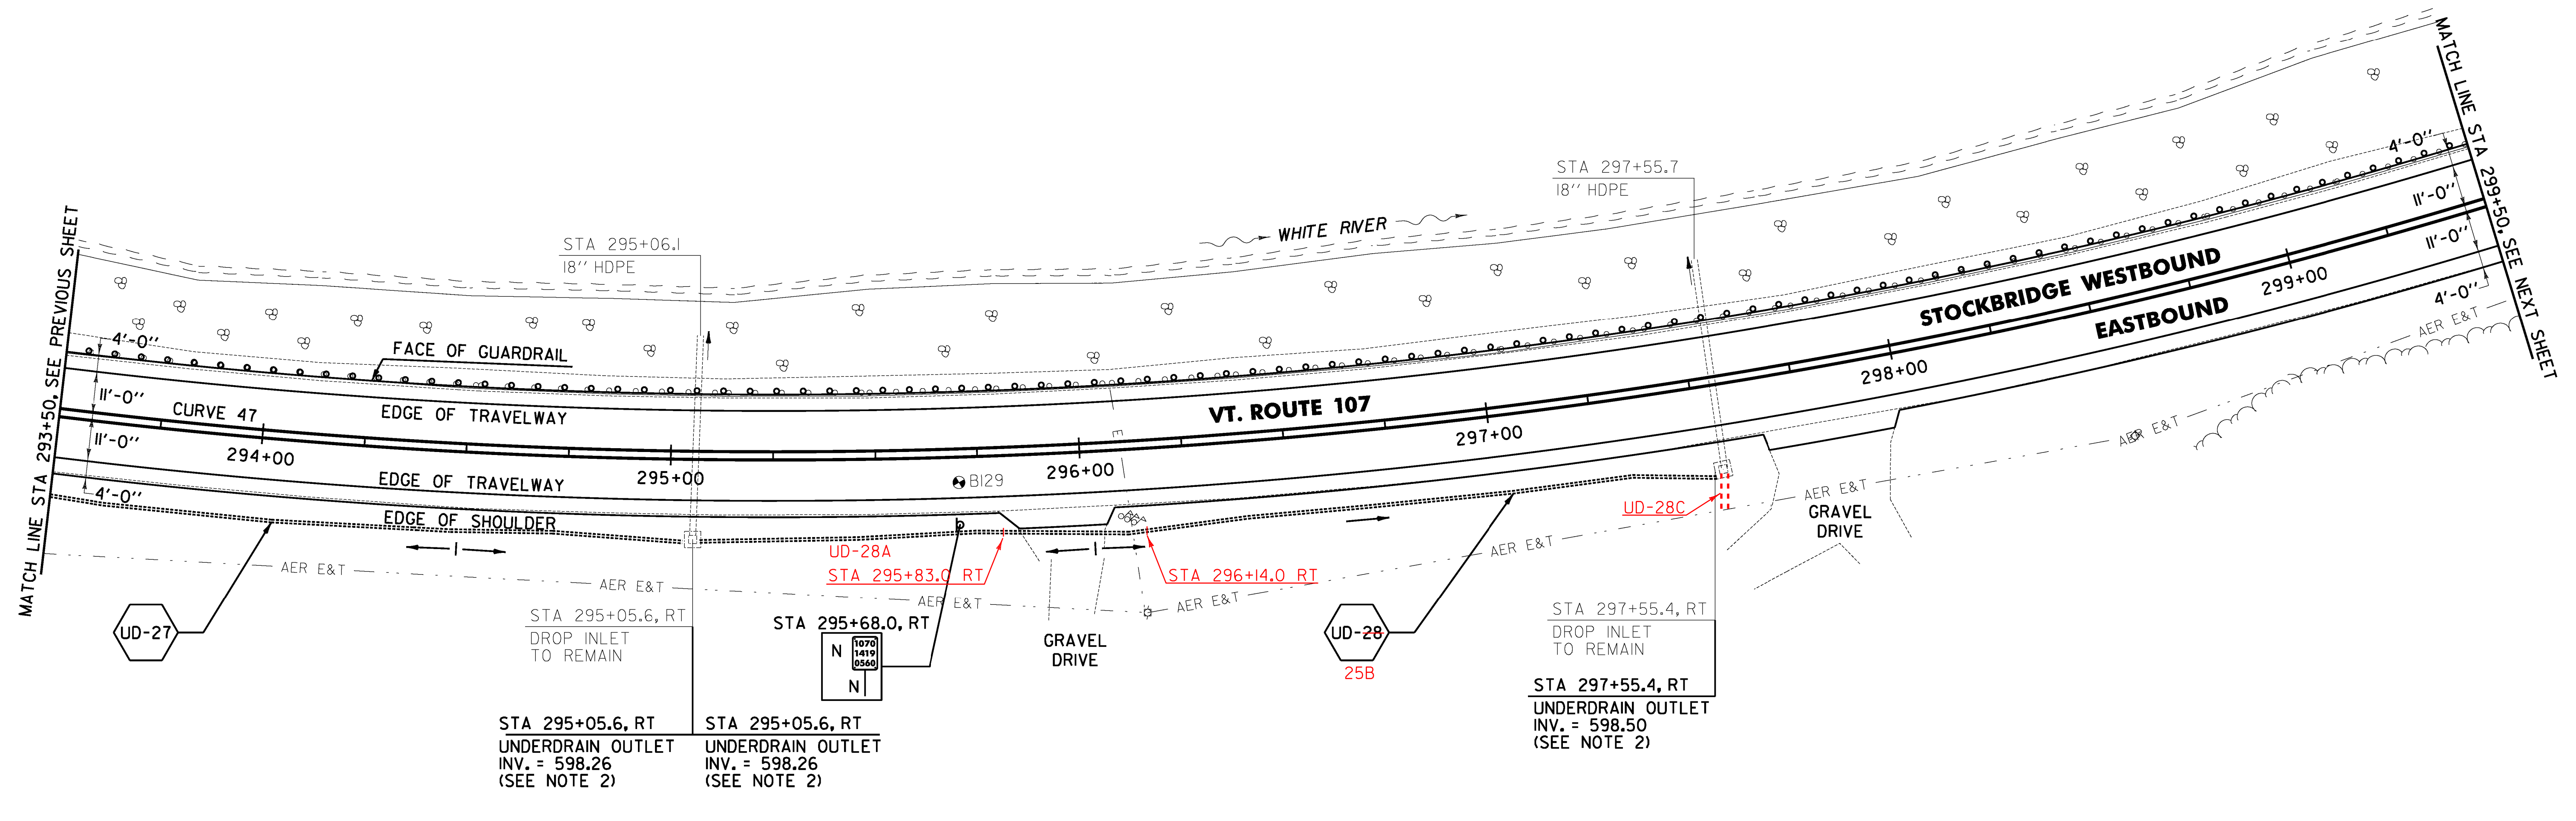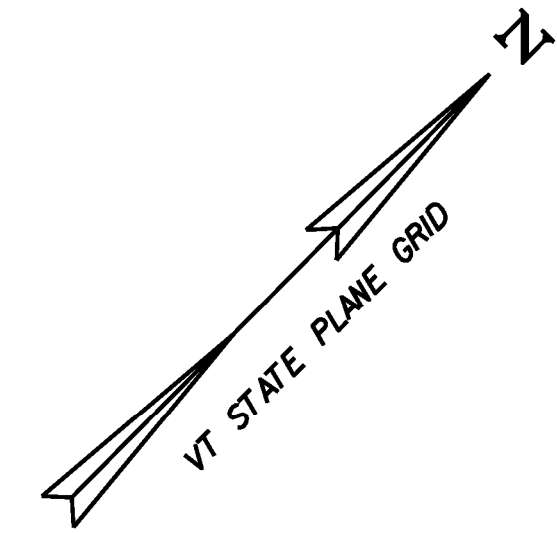

MATCH LINE STA 293+50. SEE PREVIOUS SHEET

MATCH LINE STA 299+50. SEE NEXT SHEET

FILE NAME = V:\1720\sta\1720\22426\CADD\N\STN\z10b214_bdr_nul_50.dgn
 DATE = 3/17/2014
 USER = JLR

621.75 REMOVE AND RESET GUARDRAIL
 STOCKBRIDGE:
 STA 293+50.0 - STA 299+50.0 LT (600.0 LF)

CURVE 47
 $\Delta = 44^\circ 34' 56''$
 $D = 3^\circ 57' 54''$
 $R = 1445.00'$
 $T = 592.38'$
 $L = 1124.36'$
 $E = 116.71'$
 $e = 0.064 \text{ FT/FT}$

PI STA 296+25.64 BK. =
 PI STA 295+65.25 AHD.

SOIL BORING DATA			
BORING #	DEPTH (FT.)	PCC	COMMENTS
BI29	5.0	NO	

NOTES:

- THE CONTRACTOR SHALL BE AWARE THAT AN UNDERGROUND FIBER OPTIC FACILITY EXISTS ALONG VT 107. THE LOCATION SHOWN ON THE PLANS IS APPROXIMATE, AND THE POTENTIAL EXISTS FOR CONFLICTS WITH THE FIBER OPTIC AND THE PROPOSED UNDERDRAIN AT VARIOUS LOCATIONS THROUGHOUT THE PROJECT. THE CONTRACTOR IS ADVISED THAT, PRIOR TO CONSTRUCTION, ALL PROPOSED UNDERDRAIN LOCATIONS SHALL BE FIELD VERIFIED WITH THE ENGINEER AND RELOCATED AS NECESSARY TO ELIMINATE ANY CONFLICTS WITH THE FIBER OPTIC FACILITY.
- SEE SHEET 28 FOR UNDERDRAIN DETAILS.



SIGN LEGEND
 R = REMOVE
 S = SALVAGE
 N = NEW
 RET = RETAIN
 B-B = BACK TO BACK
 EXISTING = -----
 NEW = _____

PROJECT LAYOUT SHEET #50	PROJECT NAME: STOCKBRIDGE-BETHEL	
	PROJECT NUMBER: STP 2910(1)	
	FILE NAME: z10b214_bdr_nul_50.dgn	PLOT DATE: 3/17/2014
	PROJECT LEADER: D.E.G. DESIGNED BY: L.M.B. IPARM FILE: z10b214150.1	DRAWN BY: W.G.P. CHECKED BY: J.P.S. SHEET 83 OF 397