



~~646.402 DURABLE 4 INCH WHITE LINE, THERMOPLASTIC OR~~
~~646.404 DURABLE 4 INCH WHITE LINE, POLYUREA~~
 (ALL LINES WILL INCLUDE EDGE LINE BREAKS AND
 RADIUS FOR TOWN HIGHWAYS)
 STOCKBRIDGE:
 STA 323+50.00 - STA 329+50.00 LT & RT

646.602 TEMPORARY 4 INCH WHITE LINE, PAINT
 (ALL LINES WILL INCLUDE EDGE LINE BREAKS AND
 RADIUS FOR TOWN HIGHWAYS)
 STOCKBRIDGE:
 STA 323+50.00 - STA 329+50.00 LT & RT

213.10 MILLED RUMBLE STRIPS
 (ALL CLRS WILL INCLUDE C/L
 BREAKS FOR TOWN HIGHWAYS)
 STOCKBRIDGE:
 STA 323+50.0 - STA ~~329+50.0~~ C/L (600.0 LF)
 328+00.0

646.414 DURABLE 4 INCH YELLOW LINE, POLYUREA
 (ALL LINES WILL INCLUDE C/L BREAKS FOR
 TOWN HIGHWAYS) S=SOLID, D=DASHED
 STOCKBRIDGE:
 STA 323+50.00 - STA 328+68.00
 STA 328+68.00 - STA 329+50.00


646.612 TEMPORARY 4 INCH YELLOW LINE, PAINT
 (ALL LINES WILL INCLUDE C/L BREAKS FOR
 TOWN HIGHWAYS) S=SOLID, D=DASHED
 STOCKBRIDGE:
 STA 323+50.00 - STA 328+68.00
 STA 328+68.00 - STA 329+50.00

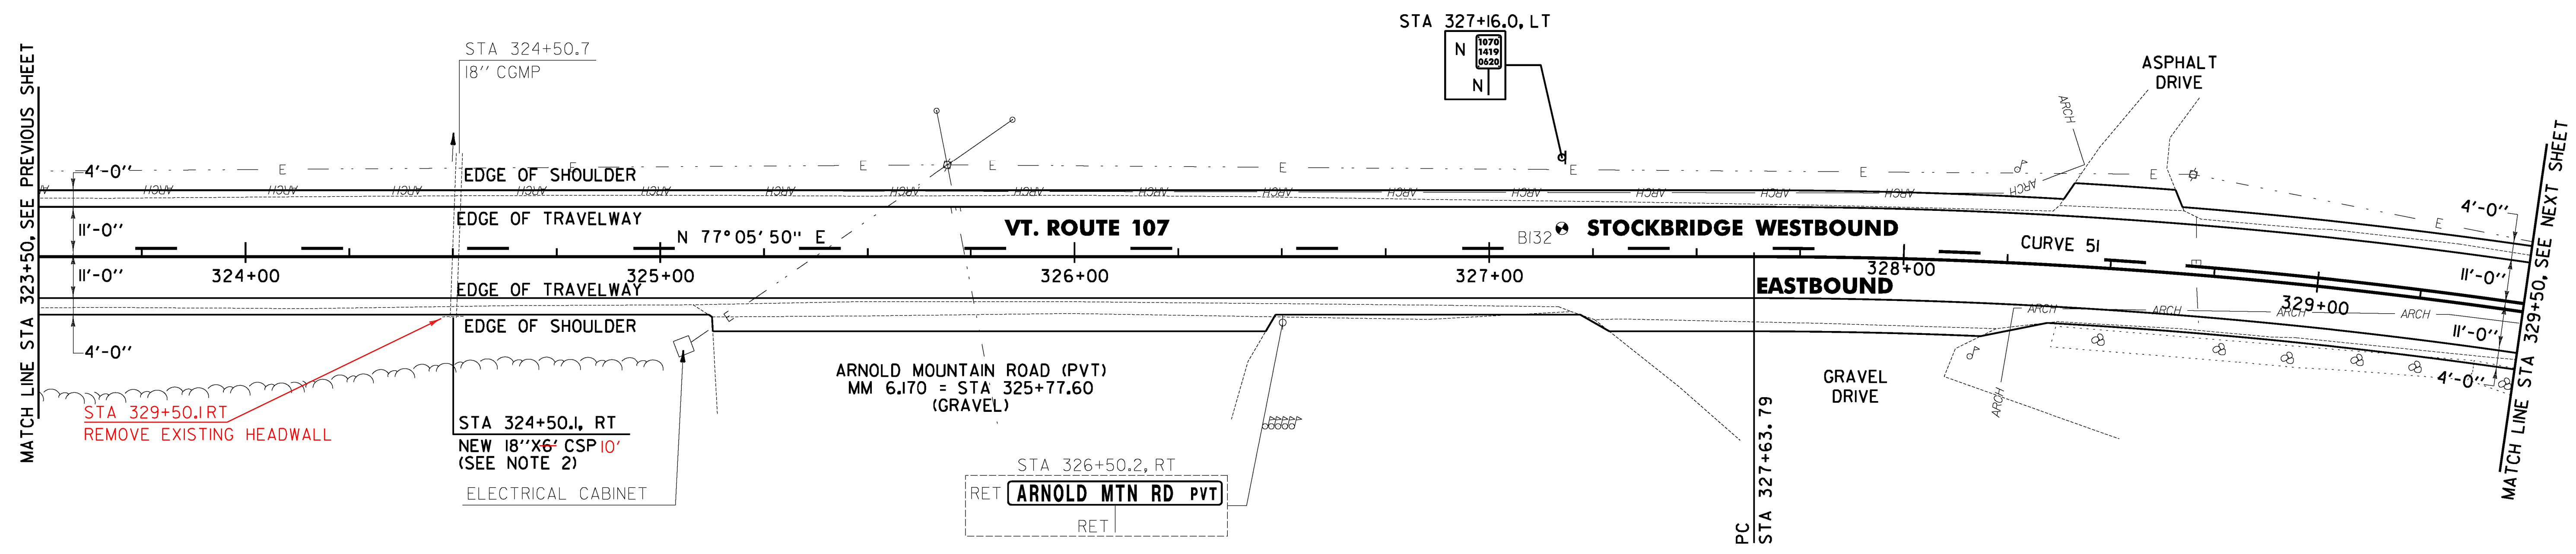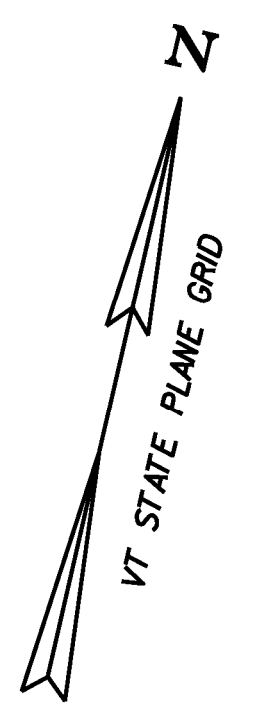

SOIL BORING DATA			
BORING #	DEPTH (FT.)	PCC	COMMENTS
BI32	5.0	NO	

NOTES:

- THE CONTRACTOR SHALL BE AWARE THAT AN UNDERGROUND FIBER OPTIC FACILITY EXISTS ALONG VT 107. THE LOCATION SHOWN ON THE PLANS IS APPROXIMATE, AND THE POTENTIAL EXISTS FOR CONFLICTS WITH THE FIBER OPTIC AND THE PROPOSED UNDERDRAIN AT VARIOUS LOCATIONS THROUGHOUT THE PROJECT. THE CONTRACTOR IS ADVISED THAT, PRIOR TO CONSTRUCTION, ALL PROPOSED UNDERDRAIN LOCATIONS SHALL BE FIELD VERIFIED WITH THE ENGINEER AND RELOCATED AS NECESSARY TO ELIMINATE ANY CONFLICTS WITH THE FIBER OPTIC FACILITY.
- SEE SHEET 25 FOR PIPE EXTENSION DETAIL FOR METAL PIPES.

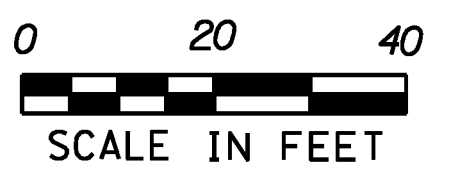

~~653.20 TEMPORARY EROSION MATTING~~
~~STOCKBRIDGE:~~
~~STA 323+50.0 - STA 324+50.0 RT (66.6 SY)~~
~~STA 324+00.0 - STA 327+50.0 LT (40.0 SY)~~
~~STA 329+00.0 - STA 329+50.0 LT (7.2 SY)~~

CURVE 51
 $\Delta = 27^\circ 19' 27''$
 $D = 4^\circ 24' 27''$
 $R = 1300.00'$
 $T = 315.99'$
 $L = 619.96'$
 $E = 37.85'$
 $e = 0.068 \text{ FT/FT}$

SIGN LEGEND
 R = REMOVE
 S = SALVAGE
 N = NEW
 RET = RETAIN
 B-B = BACK TO BACK
 EXISTING = -----
 NEW = _____

PROJECT LAYOUT SHEET #55	PROJECT NAME: STOCKBRIDGE-BETHEL
	PROJECT NUMBER: STP 2910(1)
	FILE NAME: z10b214_bdr_nul_55.dgn
	PLOT DATE: 3/17/2014
	PROJECT LEADER: D.E.G.
	DESIGNED BY: L.M.B.
	IPARM FILE: z10b214155.1
	DRAWN BY: W.G.P.
	CHECKED BY: J.P.S.
	SHEET 88 OF 397

FILE NAME: V:\Projects\10022426\CADD\10022426\MSTN\z10b214_bdr_nul_55.dgn
 DATE: 3/17/2014
 USER: J.P.S.