



~~646.402 DURABLE 4 INCH WHITE LINE, THERMOPLASTIC OR~~
 646.404 DURABLE 4 INCH WHITE LINE, POLYUREA
 (ALL LINES WILL INCLUDE EDGE LINE BREAKS AND
 RADIUS FOR TOWN HIGHWAYS)
 BETHEL:
 STA B 11+50.00 - STA B 17+50.00 LT & RT

646.602 TEMPORARY 4 INCH WHITE LINE, PAINT
 (ALL LINES WILL INCLUDE EDGE LINE BREAKS AND
 RADIUS FOR TOWN HIGHWAYS)
 BETHEL:
 STA B 11+50.00 - STA B 17+50.00 LT & RT

213.10 MILLED RUMBLE STRIPS
 (ALL CLRS WILL INCLUDE C/L
 BREAKS FOR TOWN HIGHWAYS)
 BETHEL:
 STA B 11+50.0 - STA B 17+50.0 C/L (600.0 LF)

646.414 DURABLE 4 INCH YELLOW LINE, POLYUREA
 (ALL LINES WILL INCLUDE C/L BREAKS FOR
 TOWN HIGHWAYS) S=SOLID, D=DASHED
 BETHEL:
 STA B 11+50.00 - STA B 17+50.00 LT C RT
 D - S

646.612 TEMPORARY 4 INCH YELLOW LINE, PAINT
 (ALL LINES WILL INCLUDE C/L BREAKS FOR
 TOWN HIGHWAYS) S=SOLID, D=DASHED
 BETHEL:
 STA B 11+50.00 - STA B 17+50.00 LT C RT
 D - S

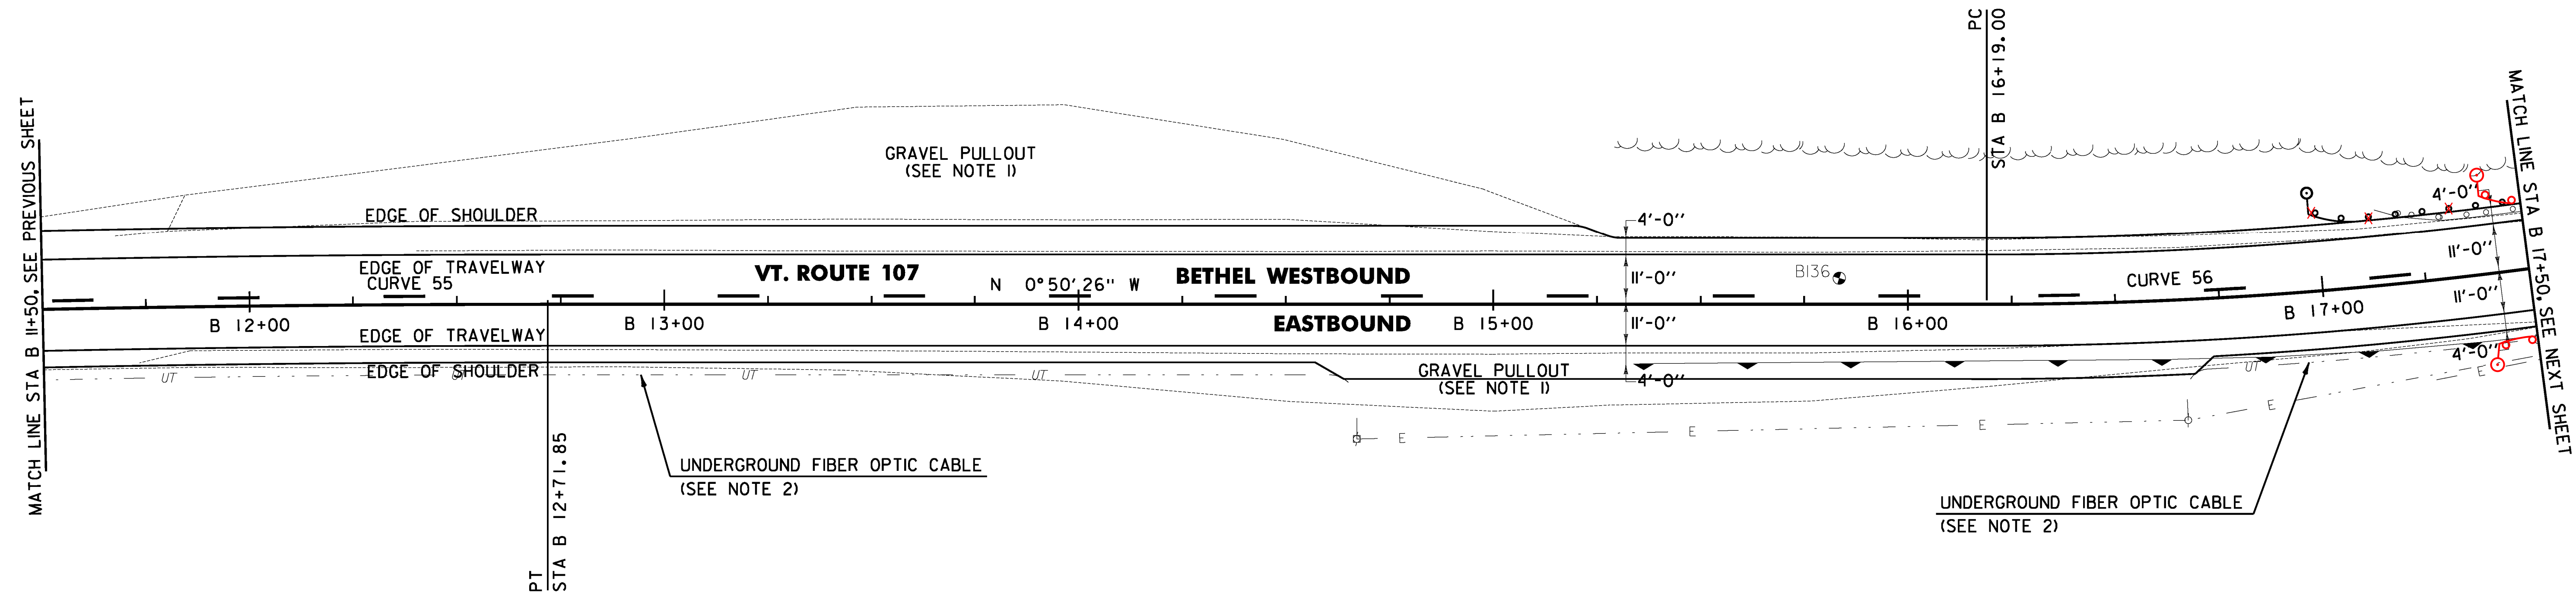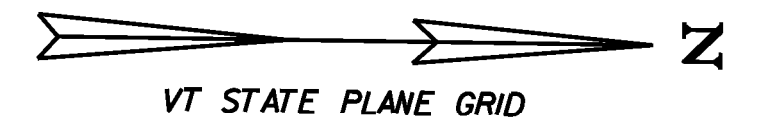

NOTES:

1. PROVIDE A 4 FT WIDE, 1/2" TYPE IVS APRON FOR THE EXISTING GRAVEL PULLOUT. ANY REQUIRED EXCAVATION SHALL BE PERFORMED AS DIRECTED BY THE ENGINEER AND PAID FOR UNDER ITEM 608.25 ALL PURPOSE EXCAVATOR RENTAL, TYPE I.
2. THE CONTRACTOR SHALL BE AWARE THAT AN UNDERGROUND FIBER OPTIC FACILITY EXISTS ALONG VT 107. THE LOCATION SHOWN ON THE PLANS IS APPROXIMATE, AND THE POTENTIAL EXISTS FOR CONFLICTS WITH THE FIBER OPTIC AND THE PROPOSED UNDERDRAIN AT VARIOUS LOCATIONS THROUGHOUT THE PROJECT. THE CONTRACTOR IS ADVISED THAT, PRIOR TO CONSTRUCTION, ALL PROPOSED UNDERDRAIN LOCATIONS SHALL BE FIELD VERIFIED WITH THE ENGINEER AND RELOCATED AS NECESSARY TO ELIMINATE ANY CONFLICTS WITH THE FIBER OPTIC FACILITY.

SOIL BORING DATA			
BORING #	DEPTH (FT.)	PCC	COMMENTS
BI36	5.0	NO	

621.205 STEEL BEAM GUARDRAIL, GALVANIZED W/8 FEET POSTS

BETHEL: 17+43.0
 STA B 16+98.0 - STA B 17+50.0 LT (52.0 LF)
 STA 17+46.0 - STA 17+50.0 RT

621.80 REMOVAL AND DISPOSAL OF GUARDRAIL

BETHEL:
 STA B 17+15.0 - STA B 17+50.0 LT (35.0 LF)

621.60 ANCHOR FOR STEEL BEAM RAIL

BETHEL:
 STA B 17+04.5 LT

676.10 DELINEATOR WITH STEEL POST

BETHEL:
 STA B 16+98.0 LT

CURVE 55


Δ = 4° 18' 13"
 D = 0° 57' 18"
 R = 6000.00'
 T = 225.44'
 L = 450.67'
 E = 4.23'
 e = 0.020 FT/FT

CURVE 56

Δ = 21° 19' 32"
 D = 5° 43' 46"
 R = 1000.00'
 T = 188.28'
 L = 372.20'
 E = 17.57'
 e = 0.076 FT/FT

SIGN LEGEND

R = REMOVE
 S = SALVAGE
 N = NEW
 RET = RETAIN
 B-B = BACK TO BACK
 EXISTING = -----
 NEW = _____

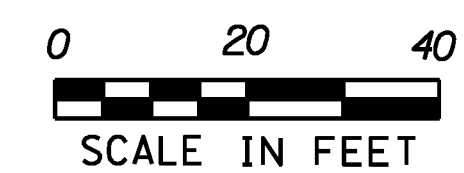

PROJECT LAYOUT SHEET #62

PROJECT NAME: STOCKBRIDGE-BETHEL

PROJECT NUMBER: STP 2910(1)

FILE NAME: z10b214_bdr_nul_62.dgn

PROJECT LEADER: D.E.G.

DESIGNED BY: L.M.B.

IPARM FILE: z10b214162.i

PLOT DATE: 3/17/2014

DRAWN BY: W.G.P.

CHECKED BY: J.P.S.

SHEET 95 OF 397

FILE NAME: \\1720\projects\1720\22426\CADD\MSTN\z10b214_bdr_nul_62.dgn
 DATE: 3/17/2014
 USER: j4916