
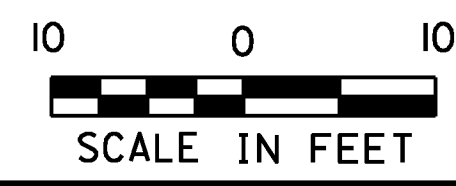
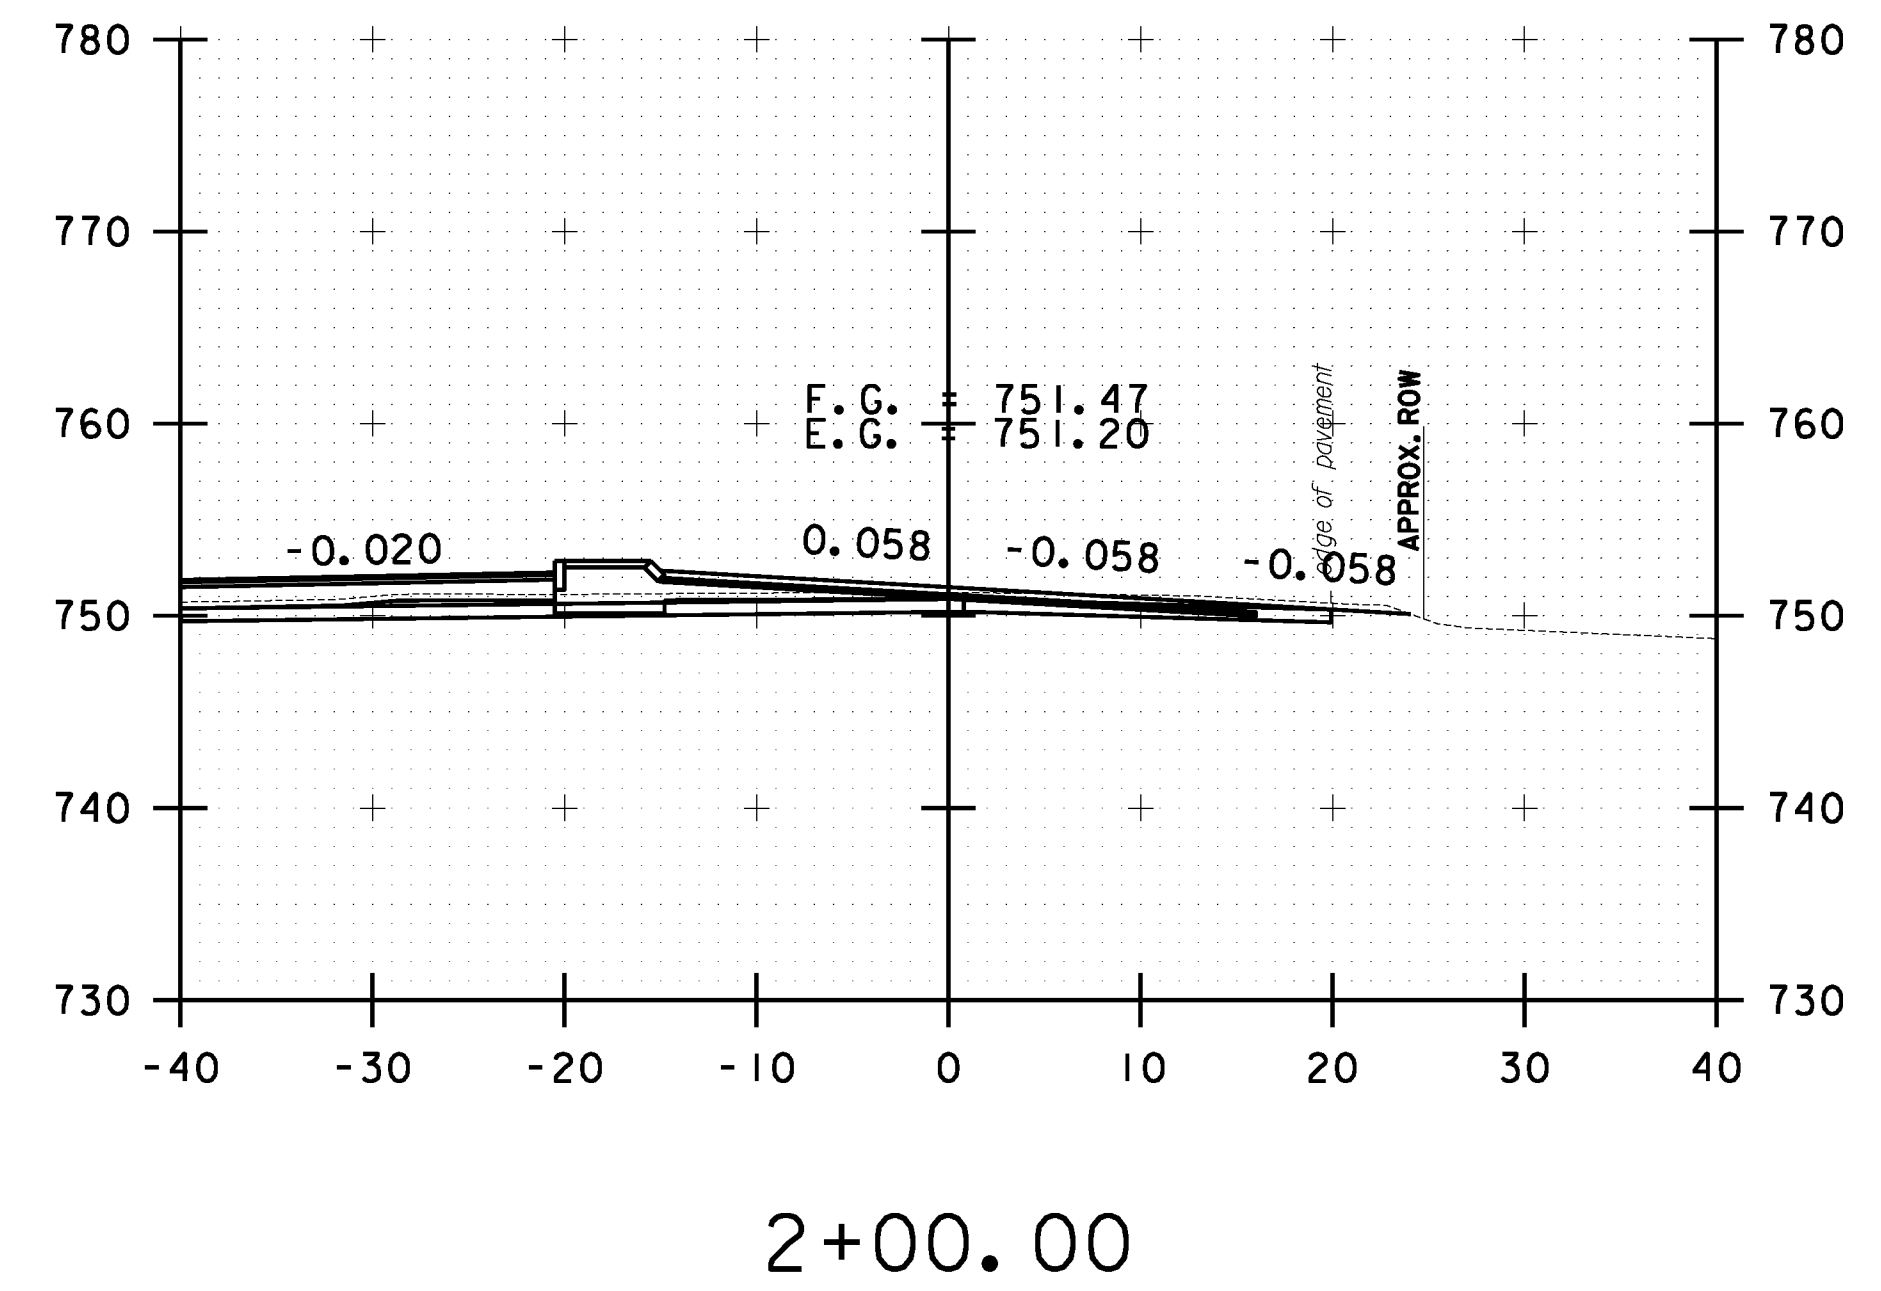
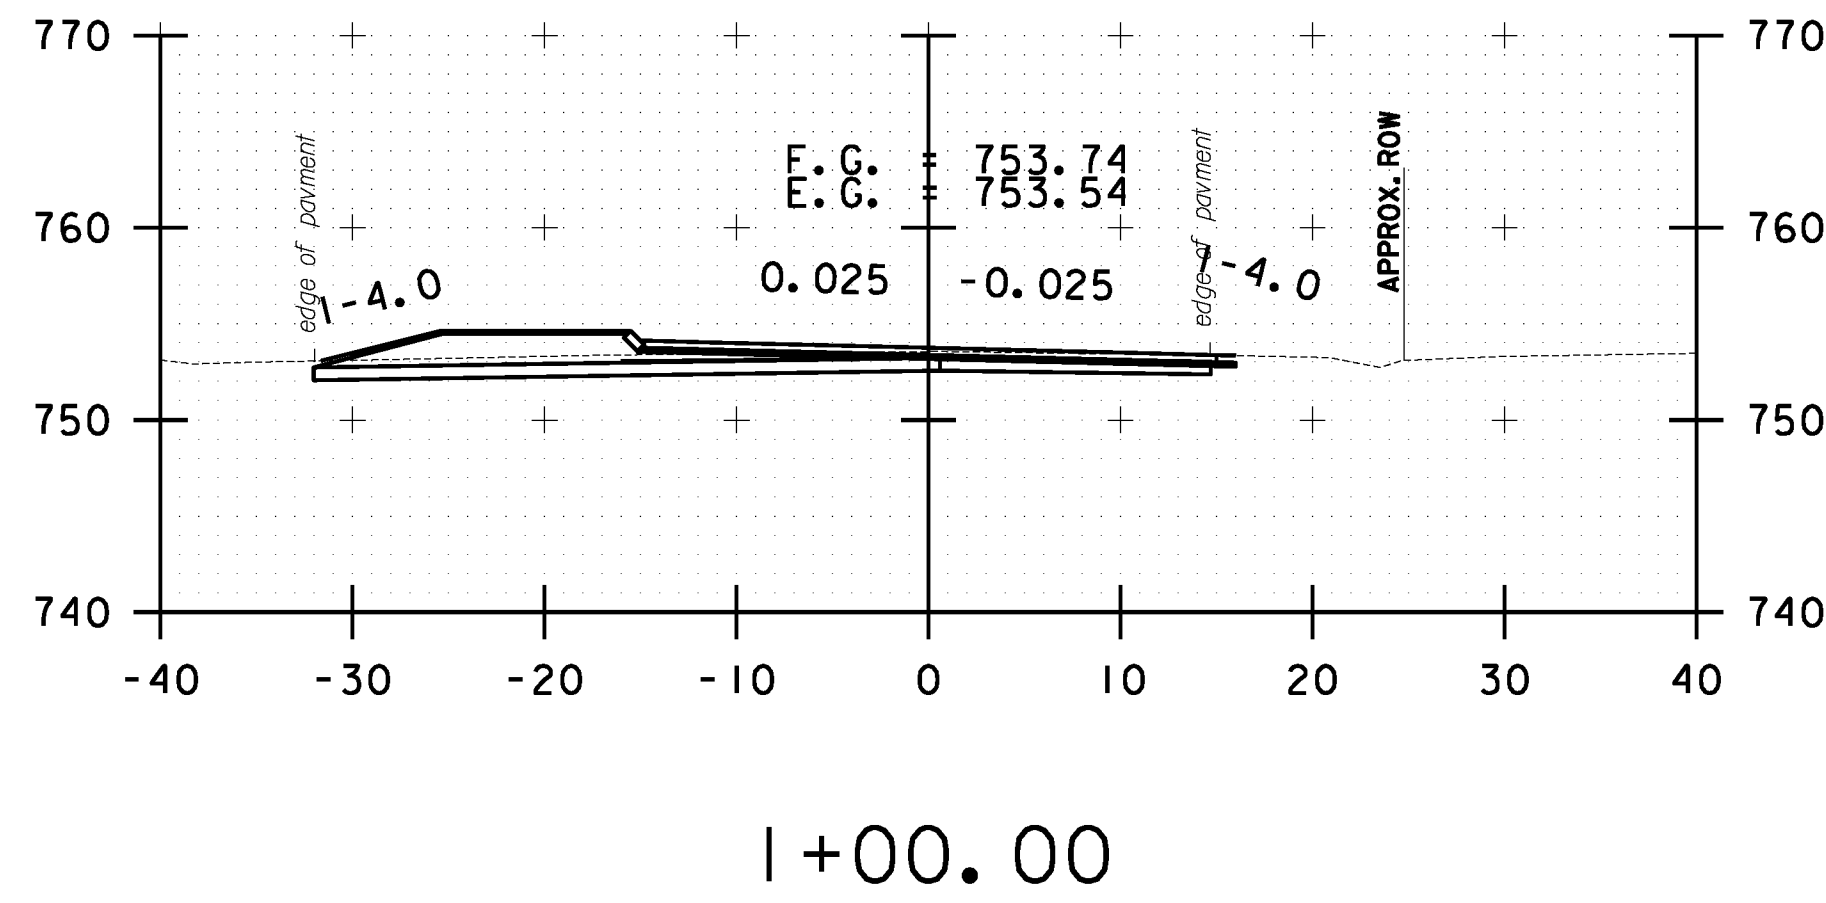
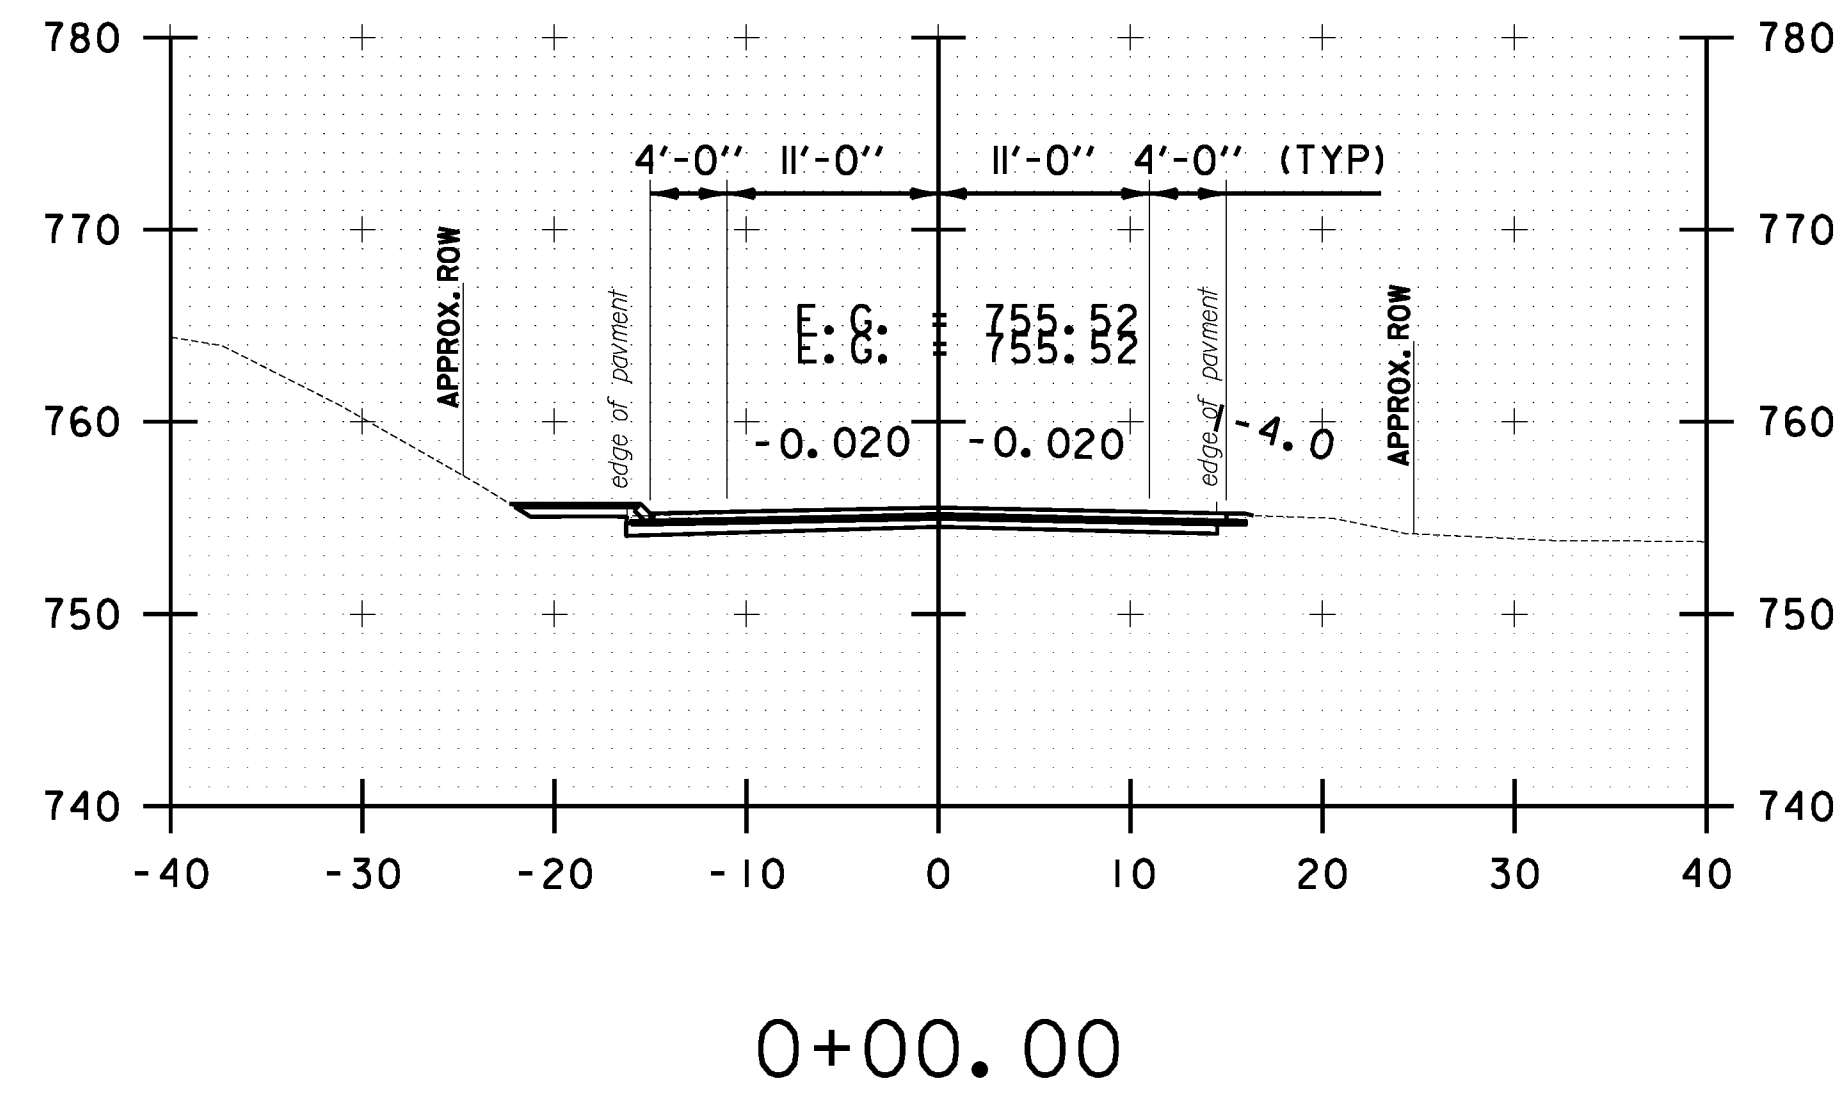
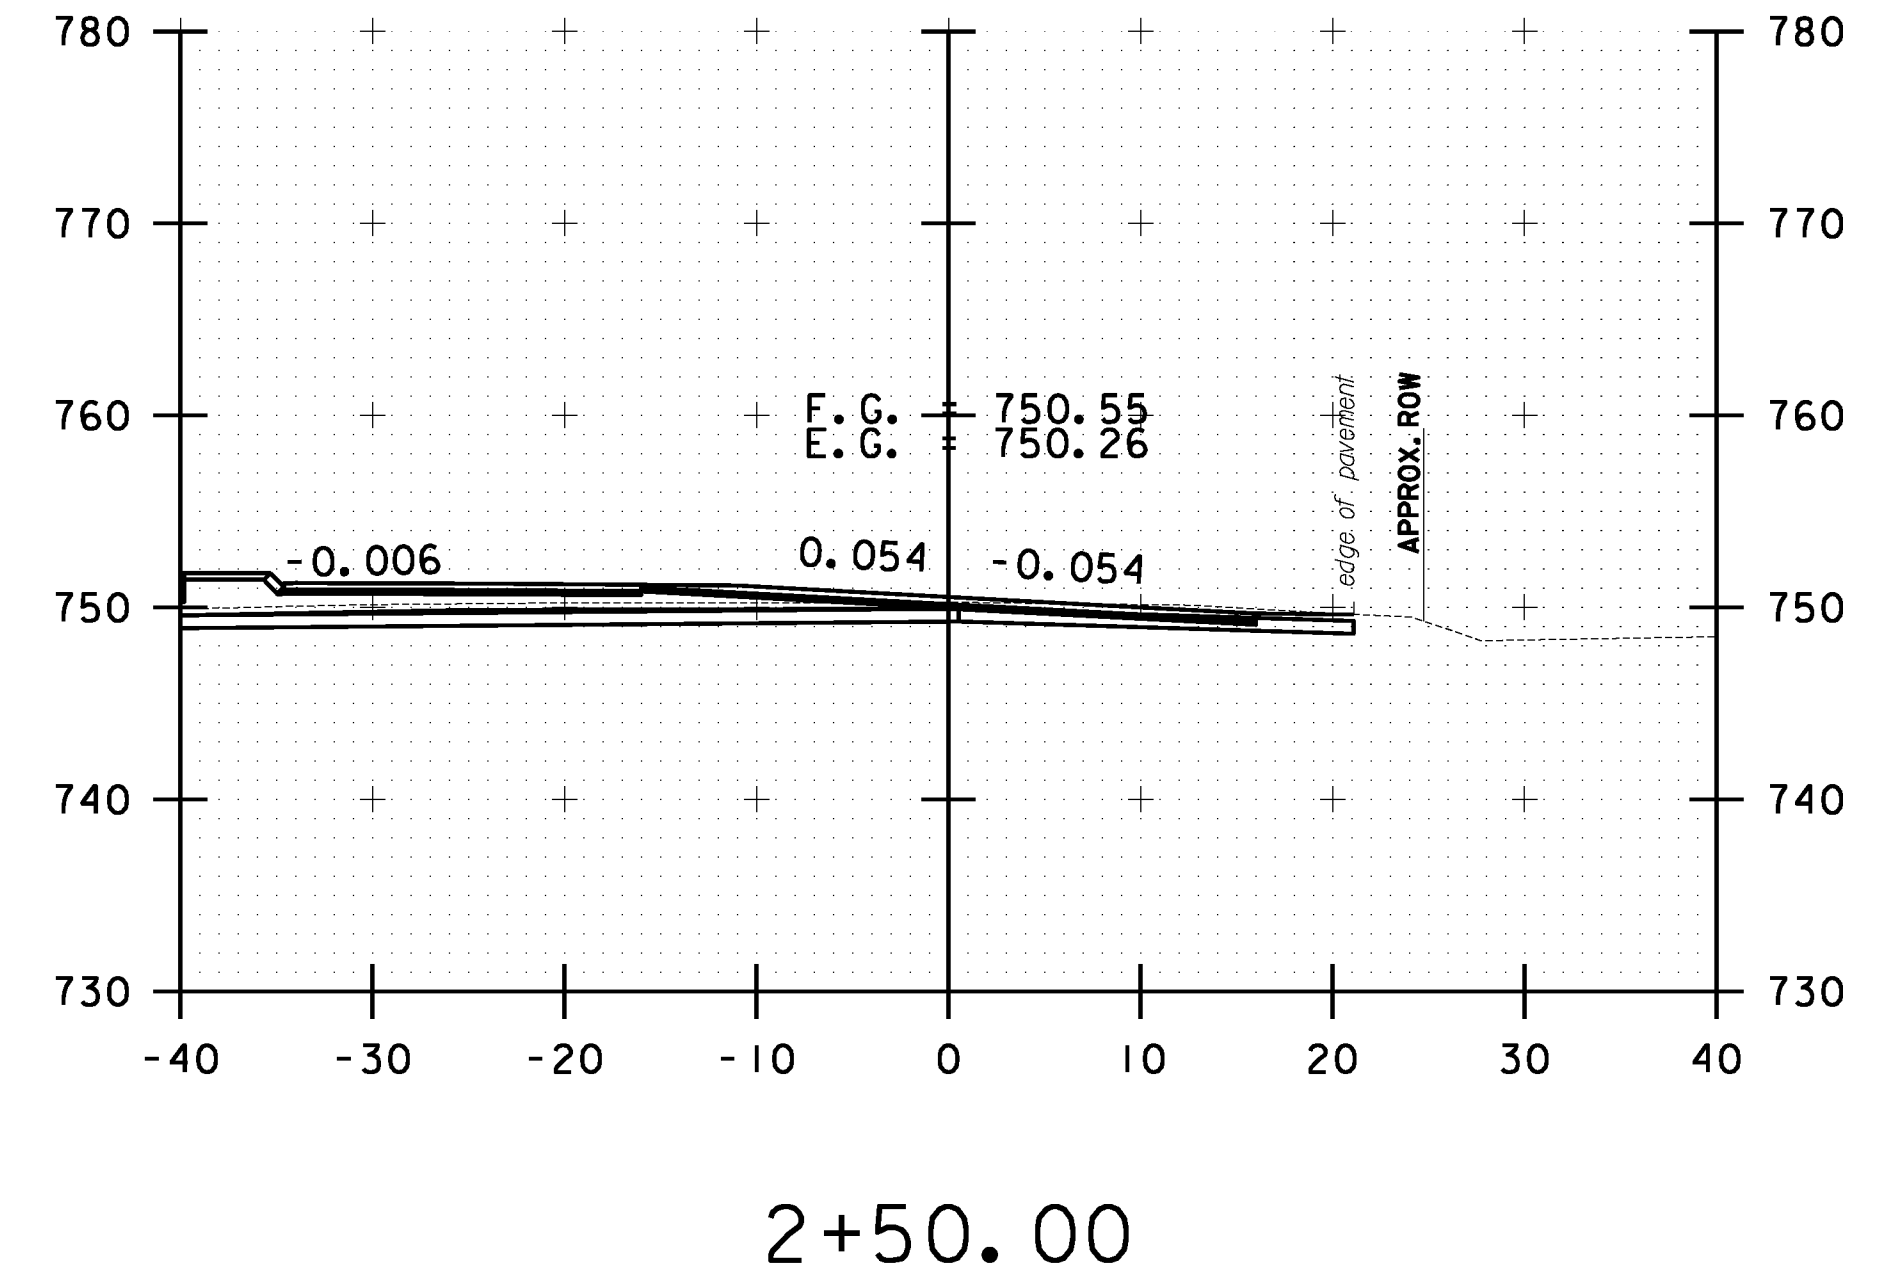
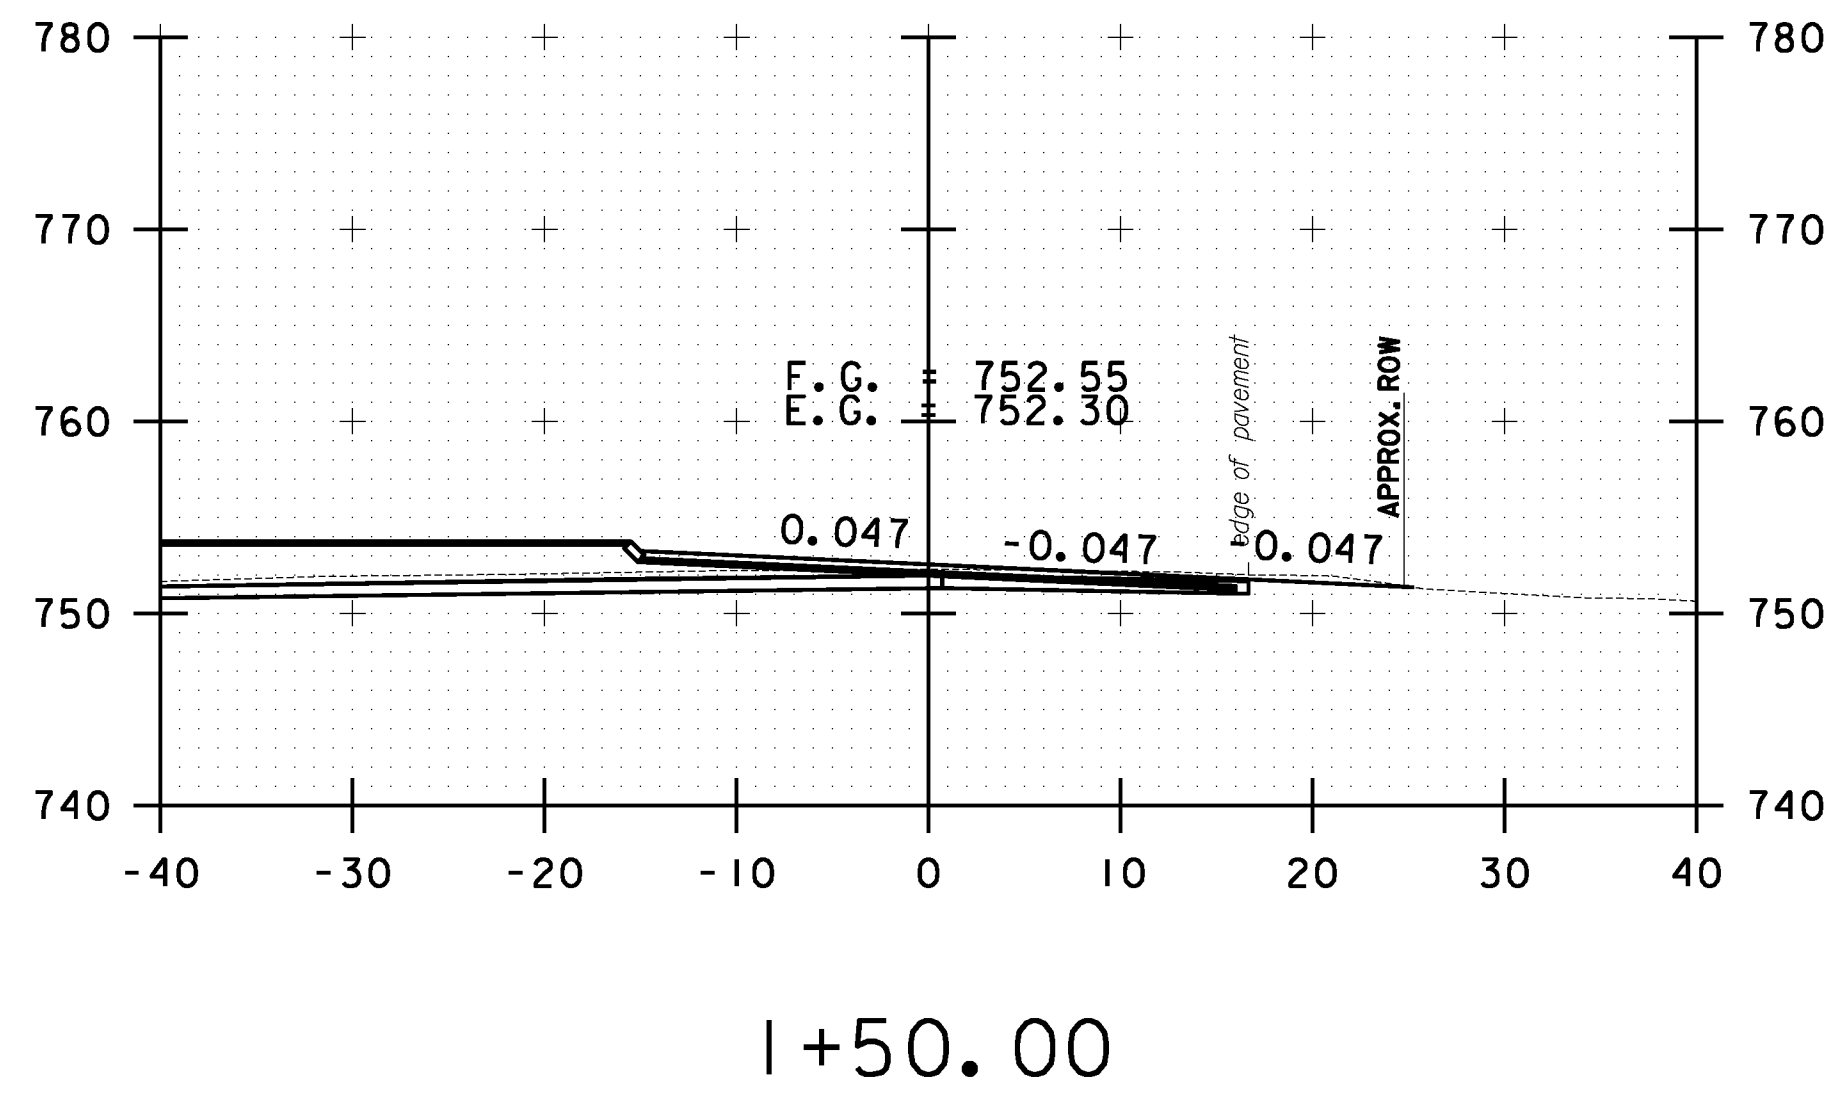


FILE NAME = Y:\P\c\g\sc\any\k2\22425\CADD\MSTN\10b214_stock.nc.dgn
 DATE/TIME = 3/17/2014
 USER = 4916

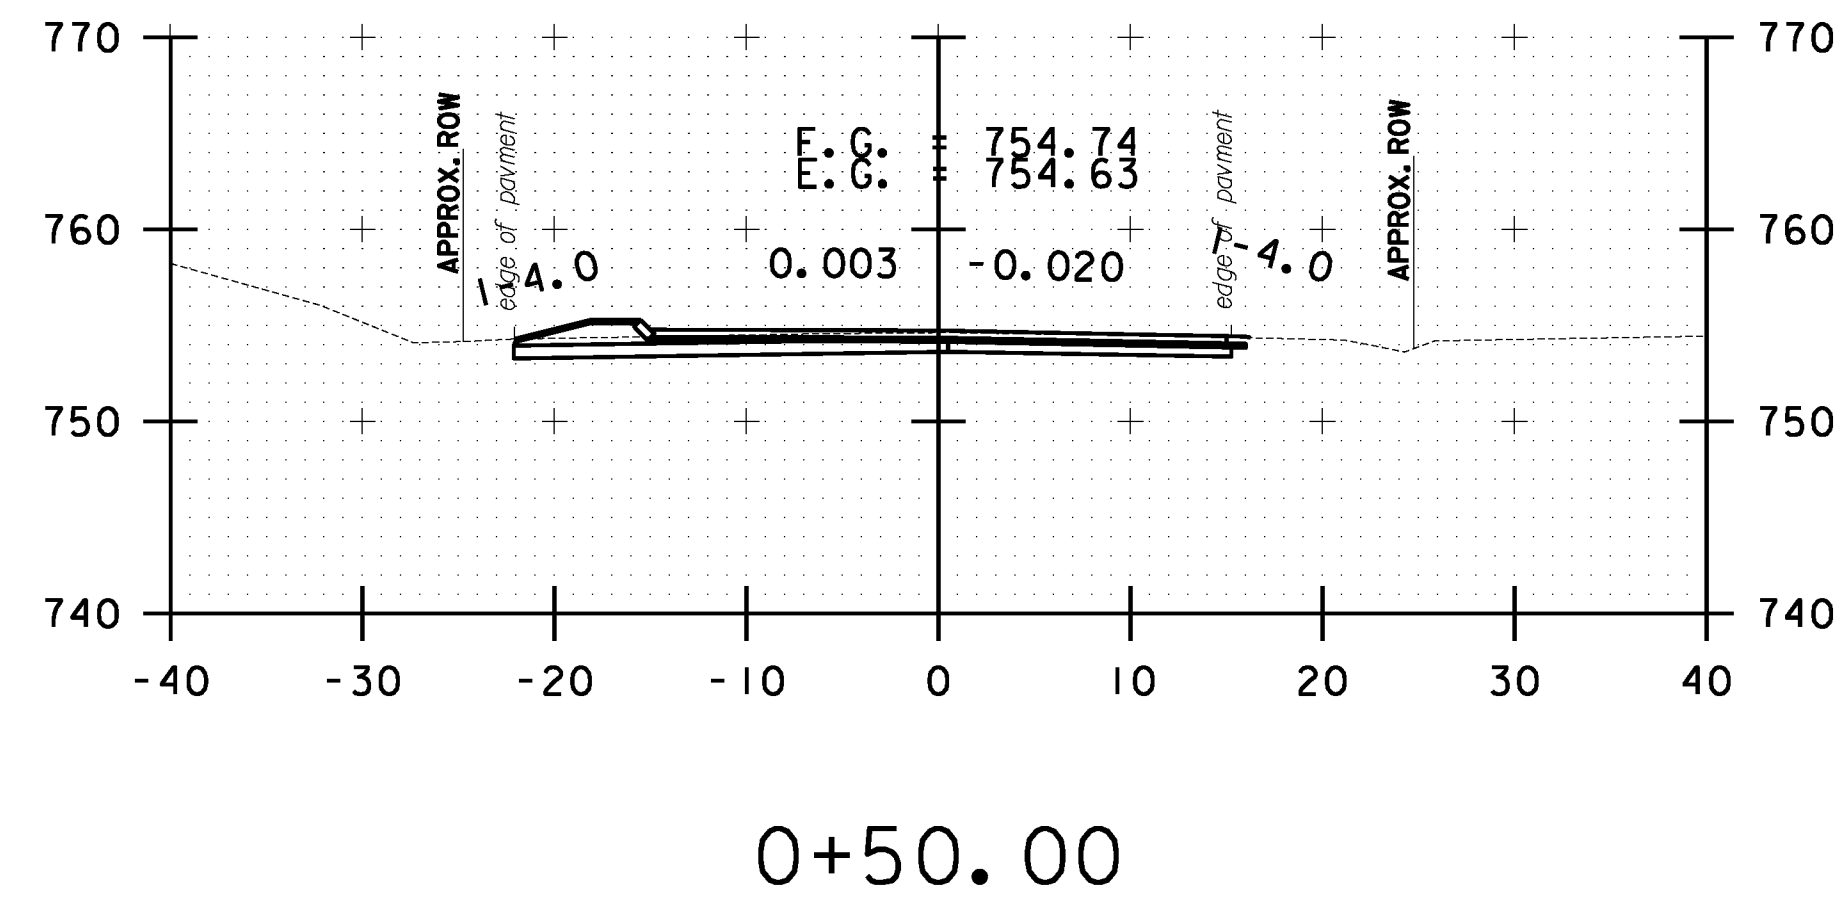

| | |
|---|----------------------------------|
| STOCKBRIDGE CROSS SECTION SHEET #1 | PROJECT NAME: STOCKBRIDGE-BETHEL |
| | PROJECT NUMBER: STP 2910(1) |
| | FILE NAME: z10b214_stock.nc.dgn |
| | DESIGNED BY: L.M.B. |
| | PLOT DATE: 3/17/2014 |
| | DRAWN BY: W.G.P. |
| | CHECKED BY: J.P.S. |
| | SHEET 214 OF 397 |