




FILE NAME = Y:\P\c\stc\stc\ANY\X2\22425\CADD\MSTN\10b214_stock_xc.dgn
 DATE/TIME = 3/17/2014
 USER = 4916

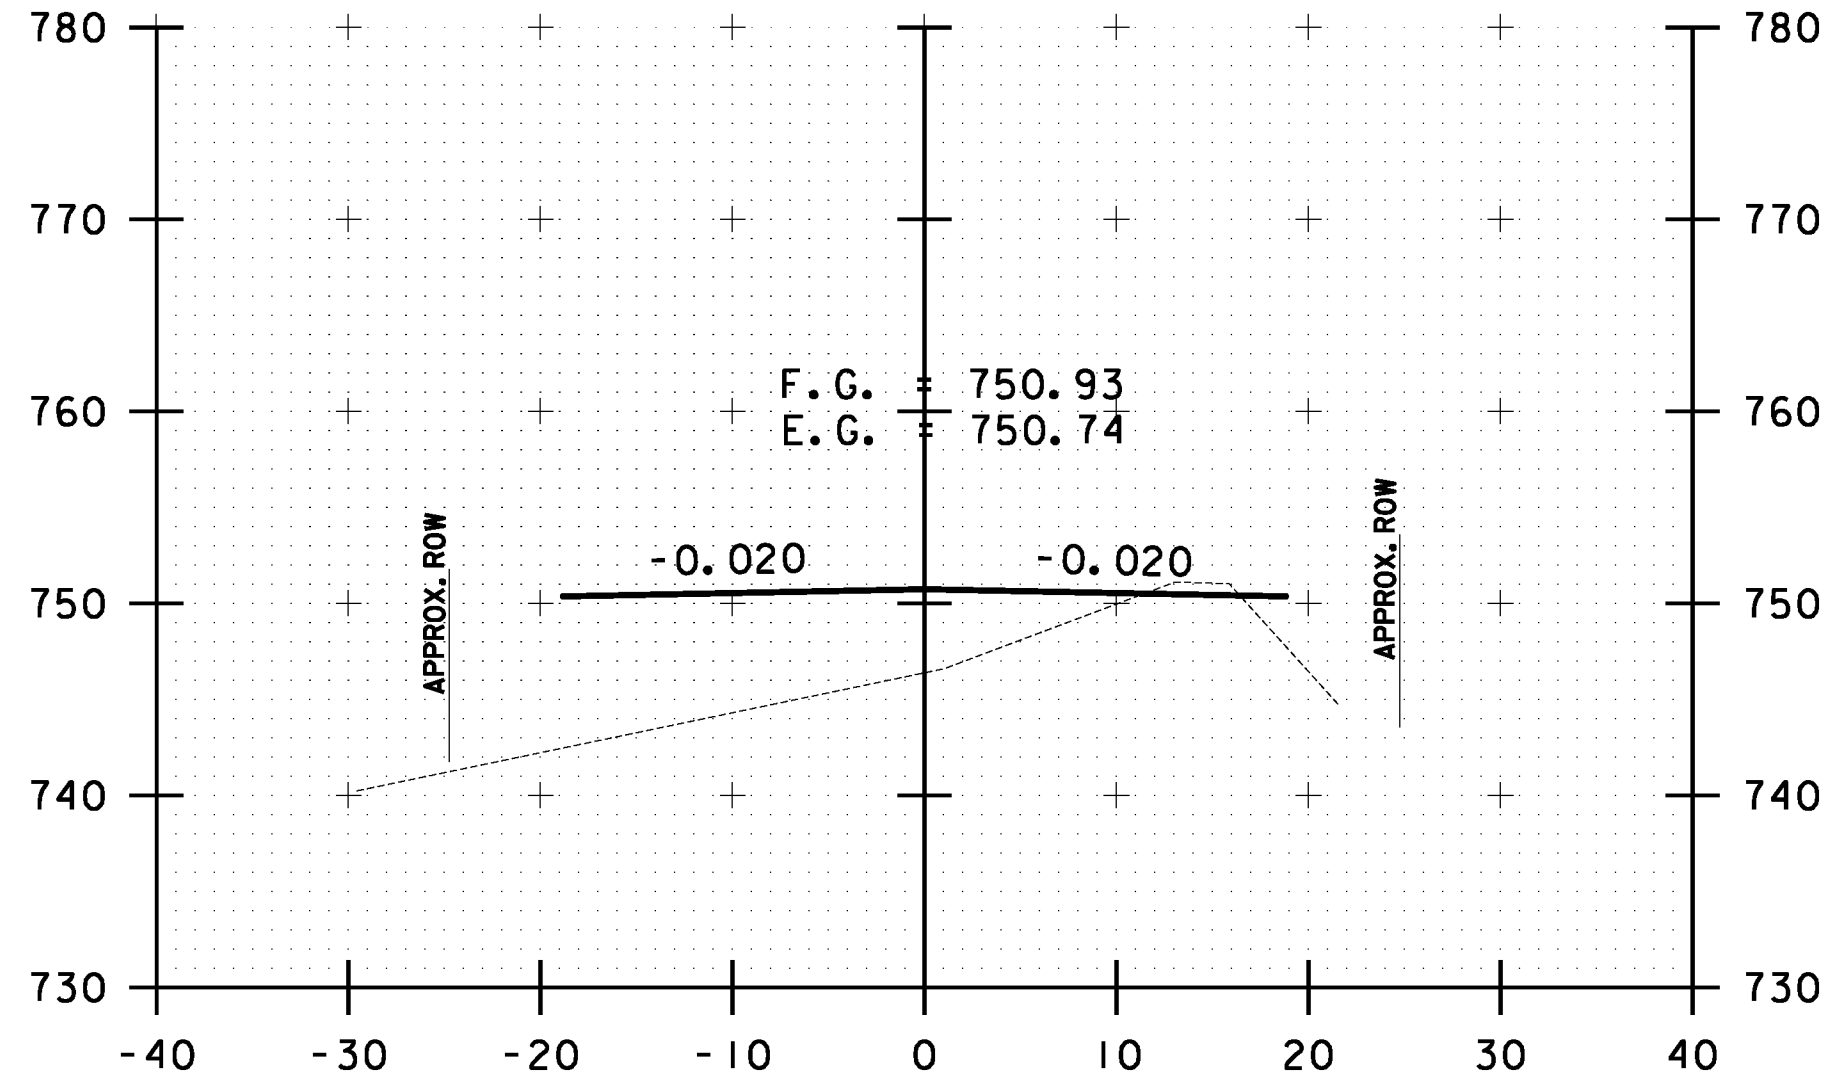


11+50.00
(BR 1)

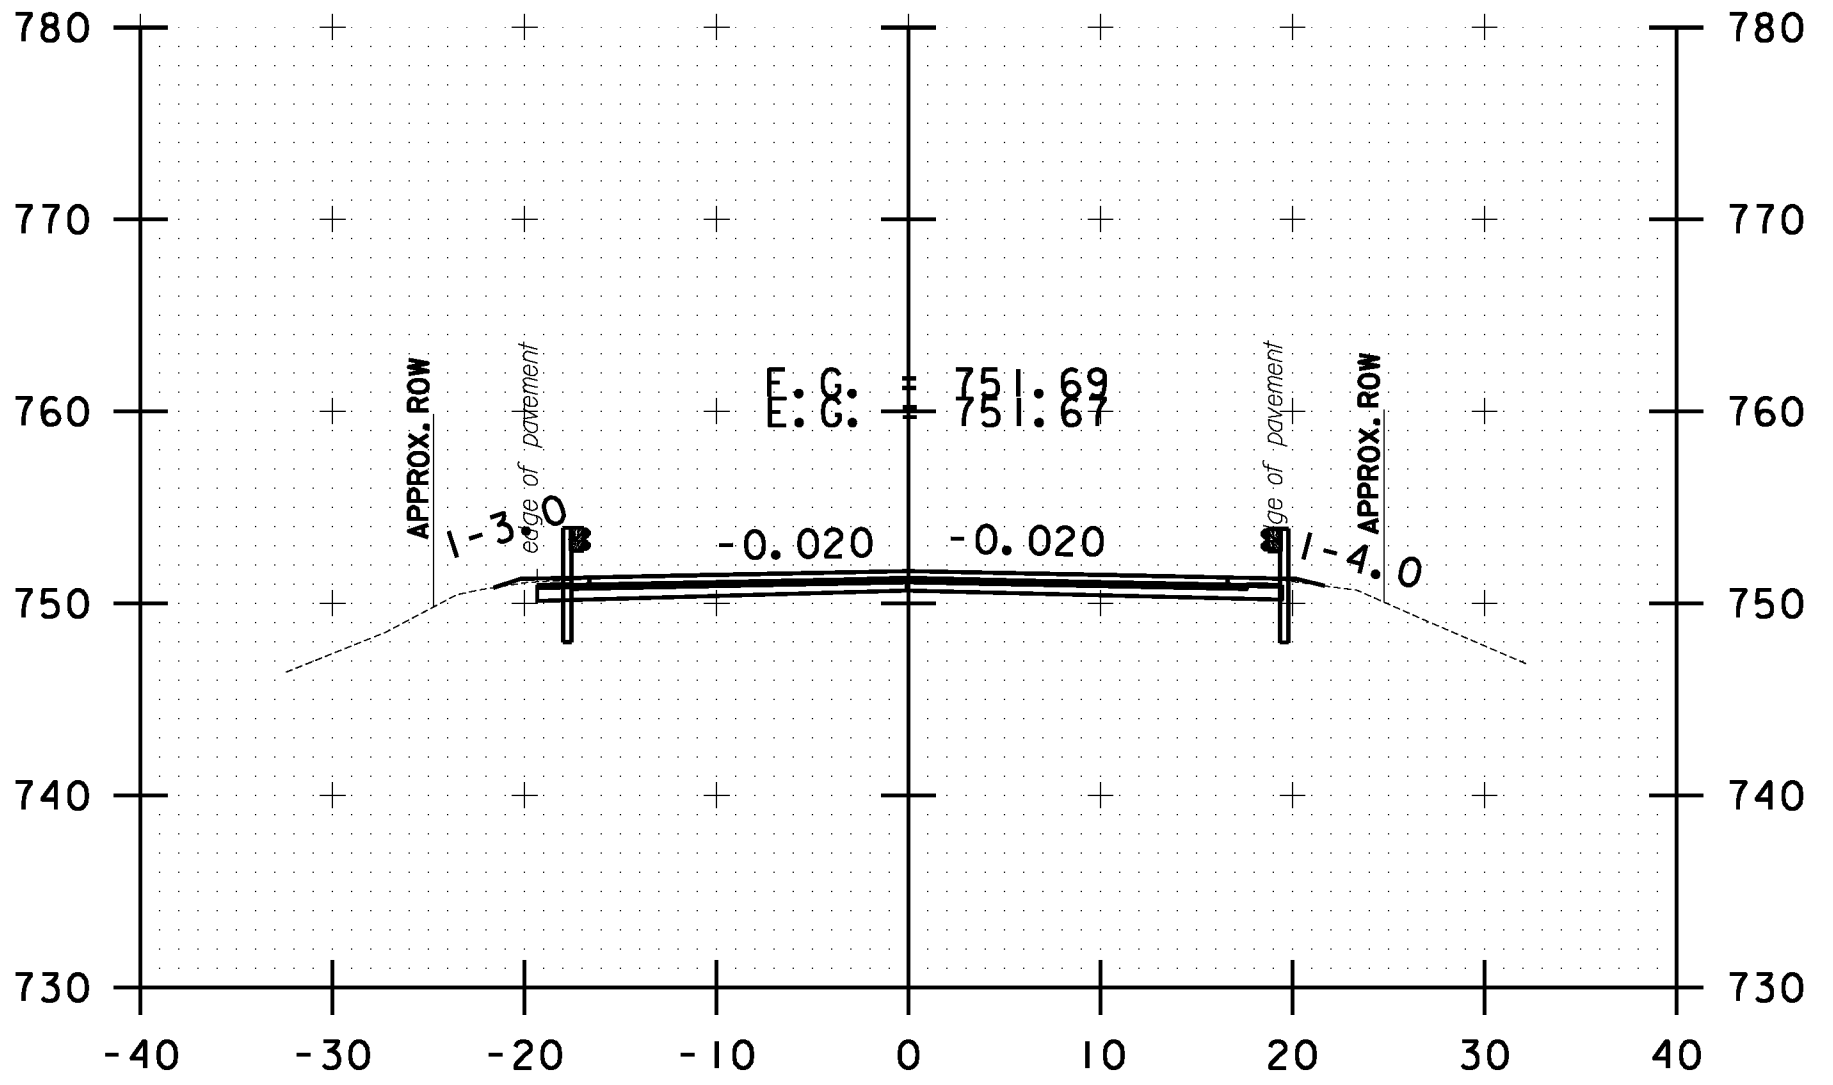


12+50.00

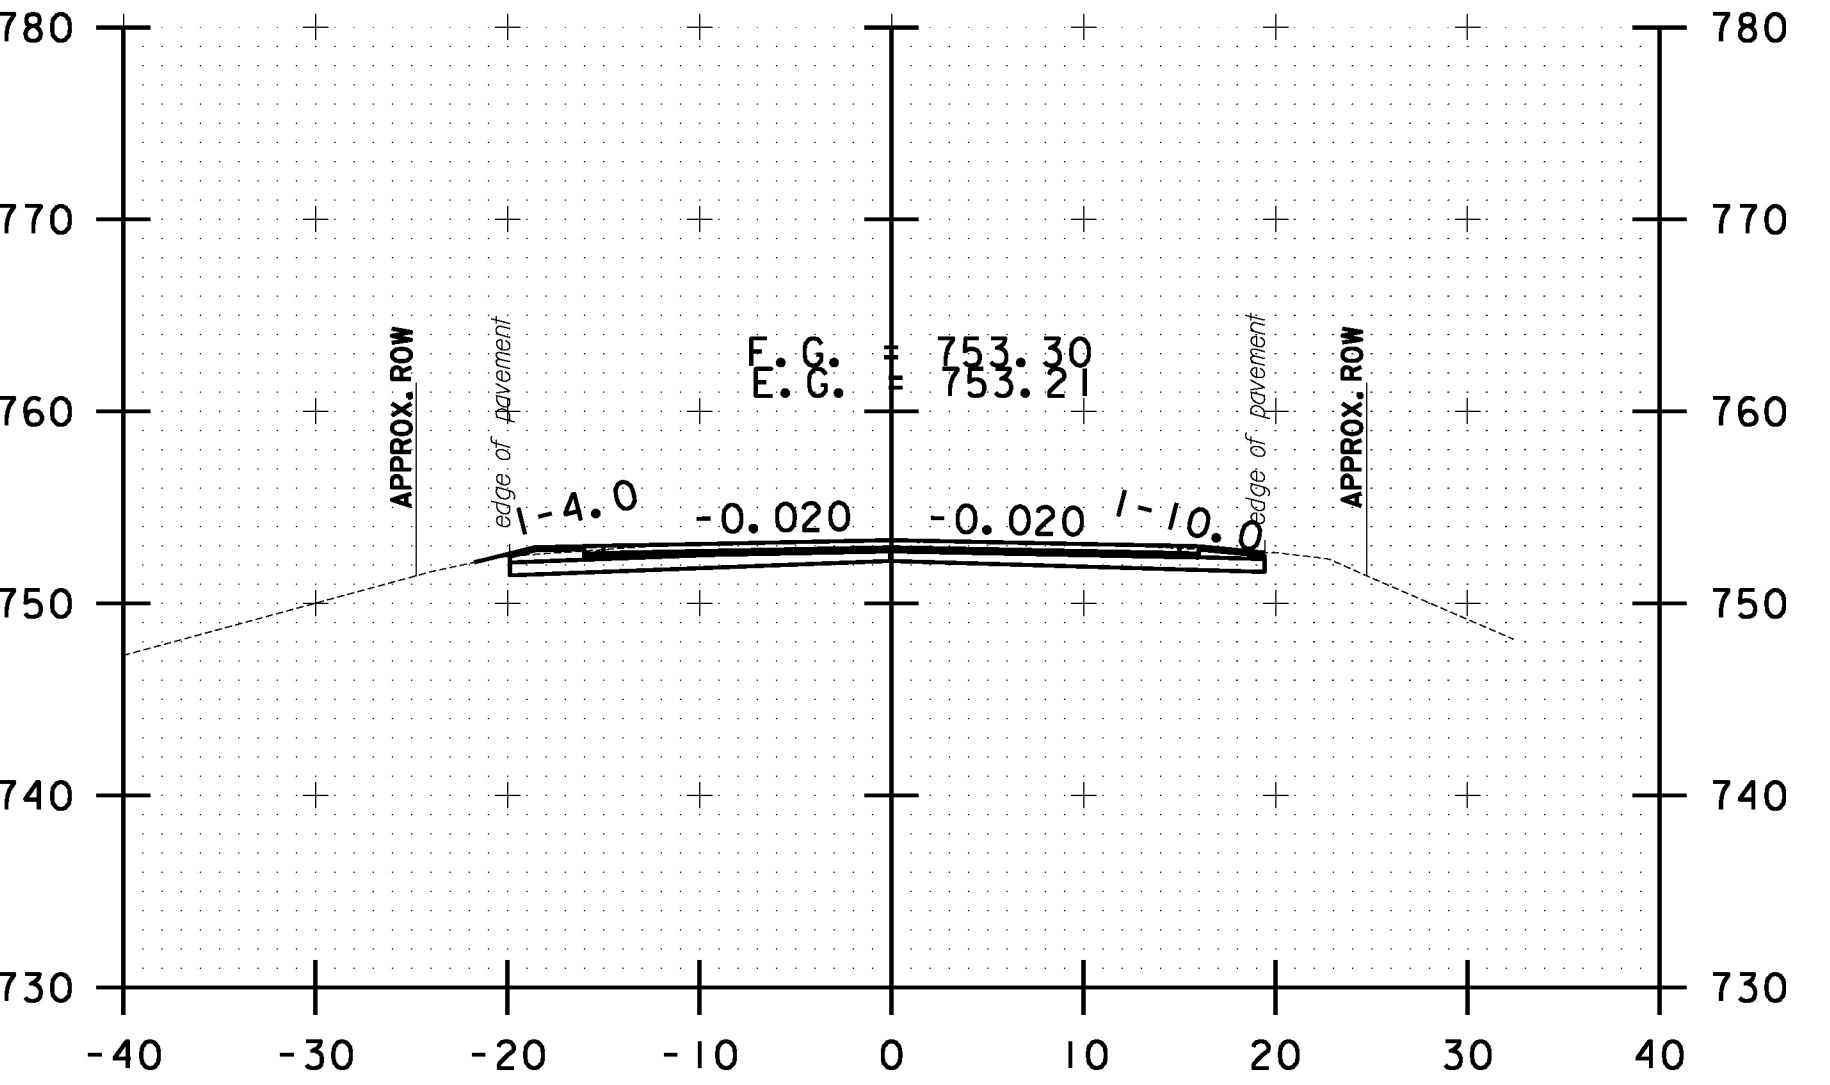


13+50.00

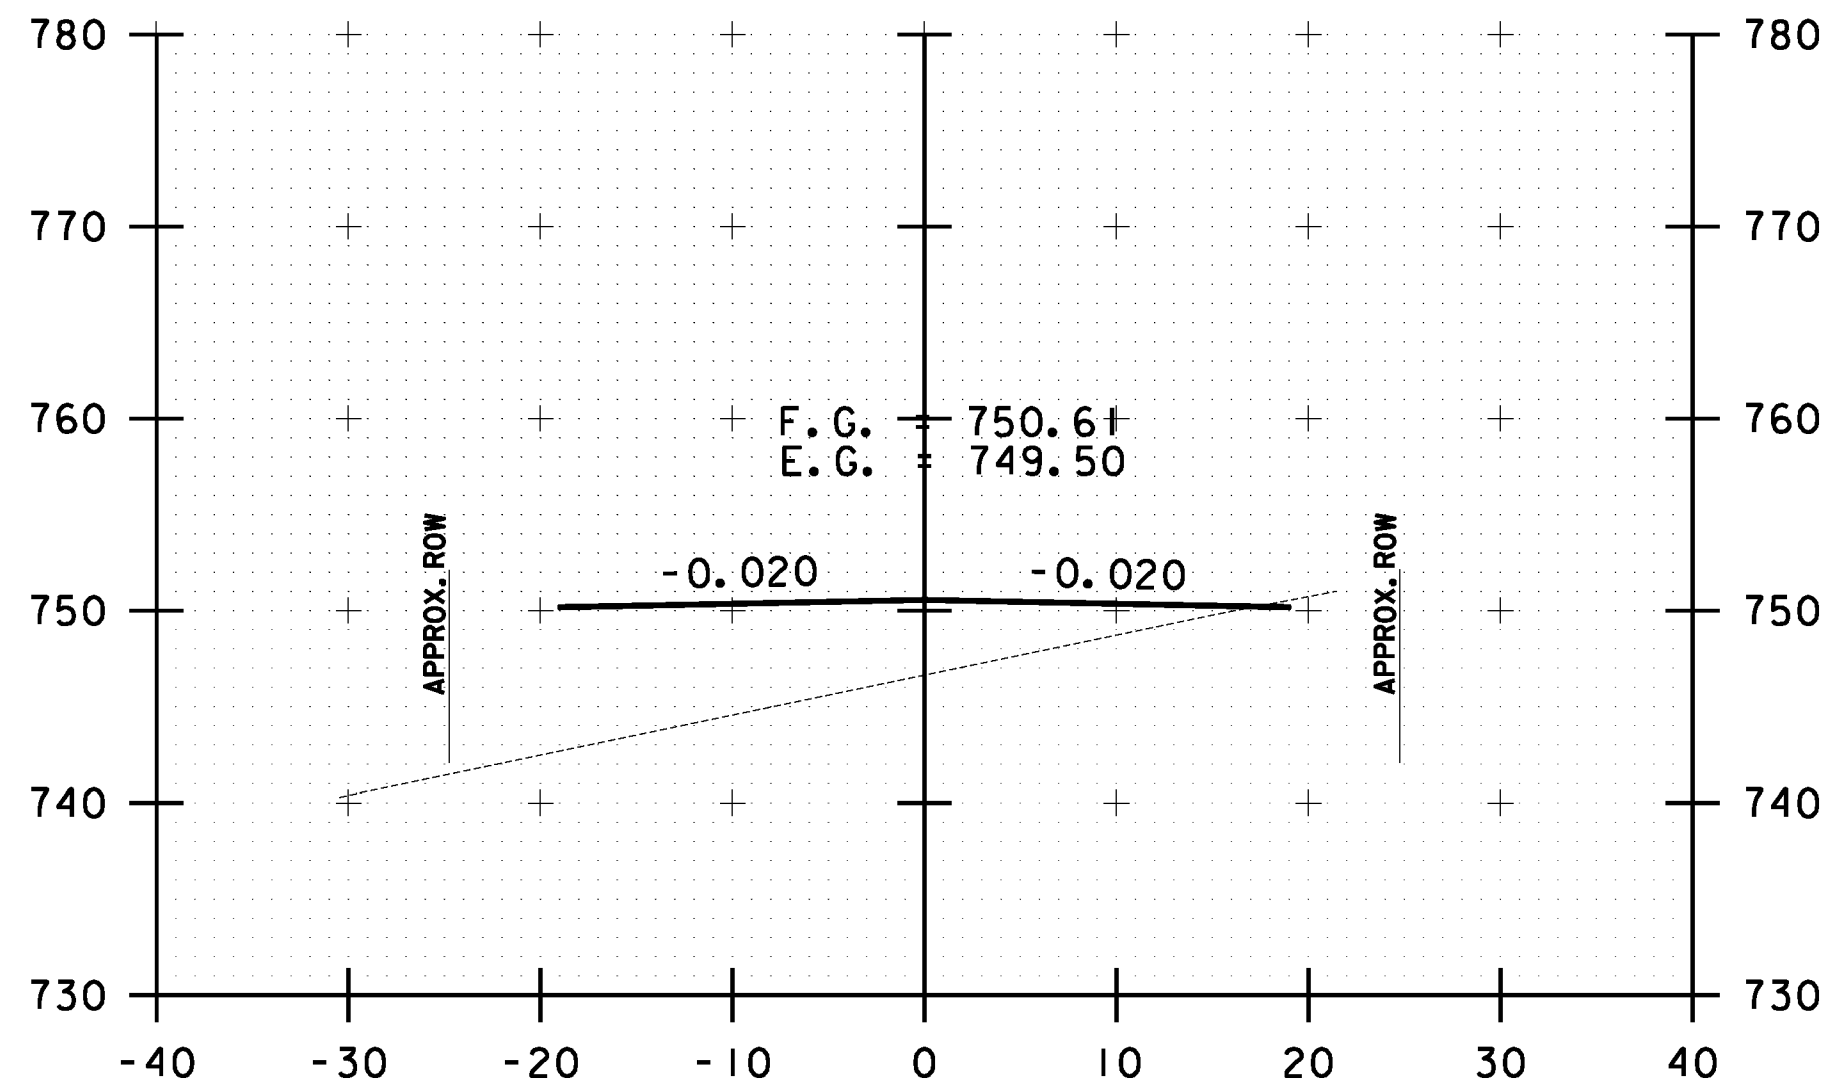


11+00.00
(BR 1)

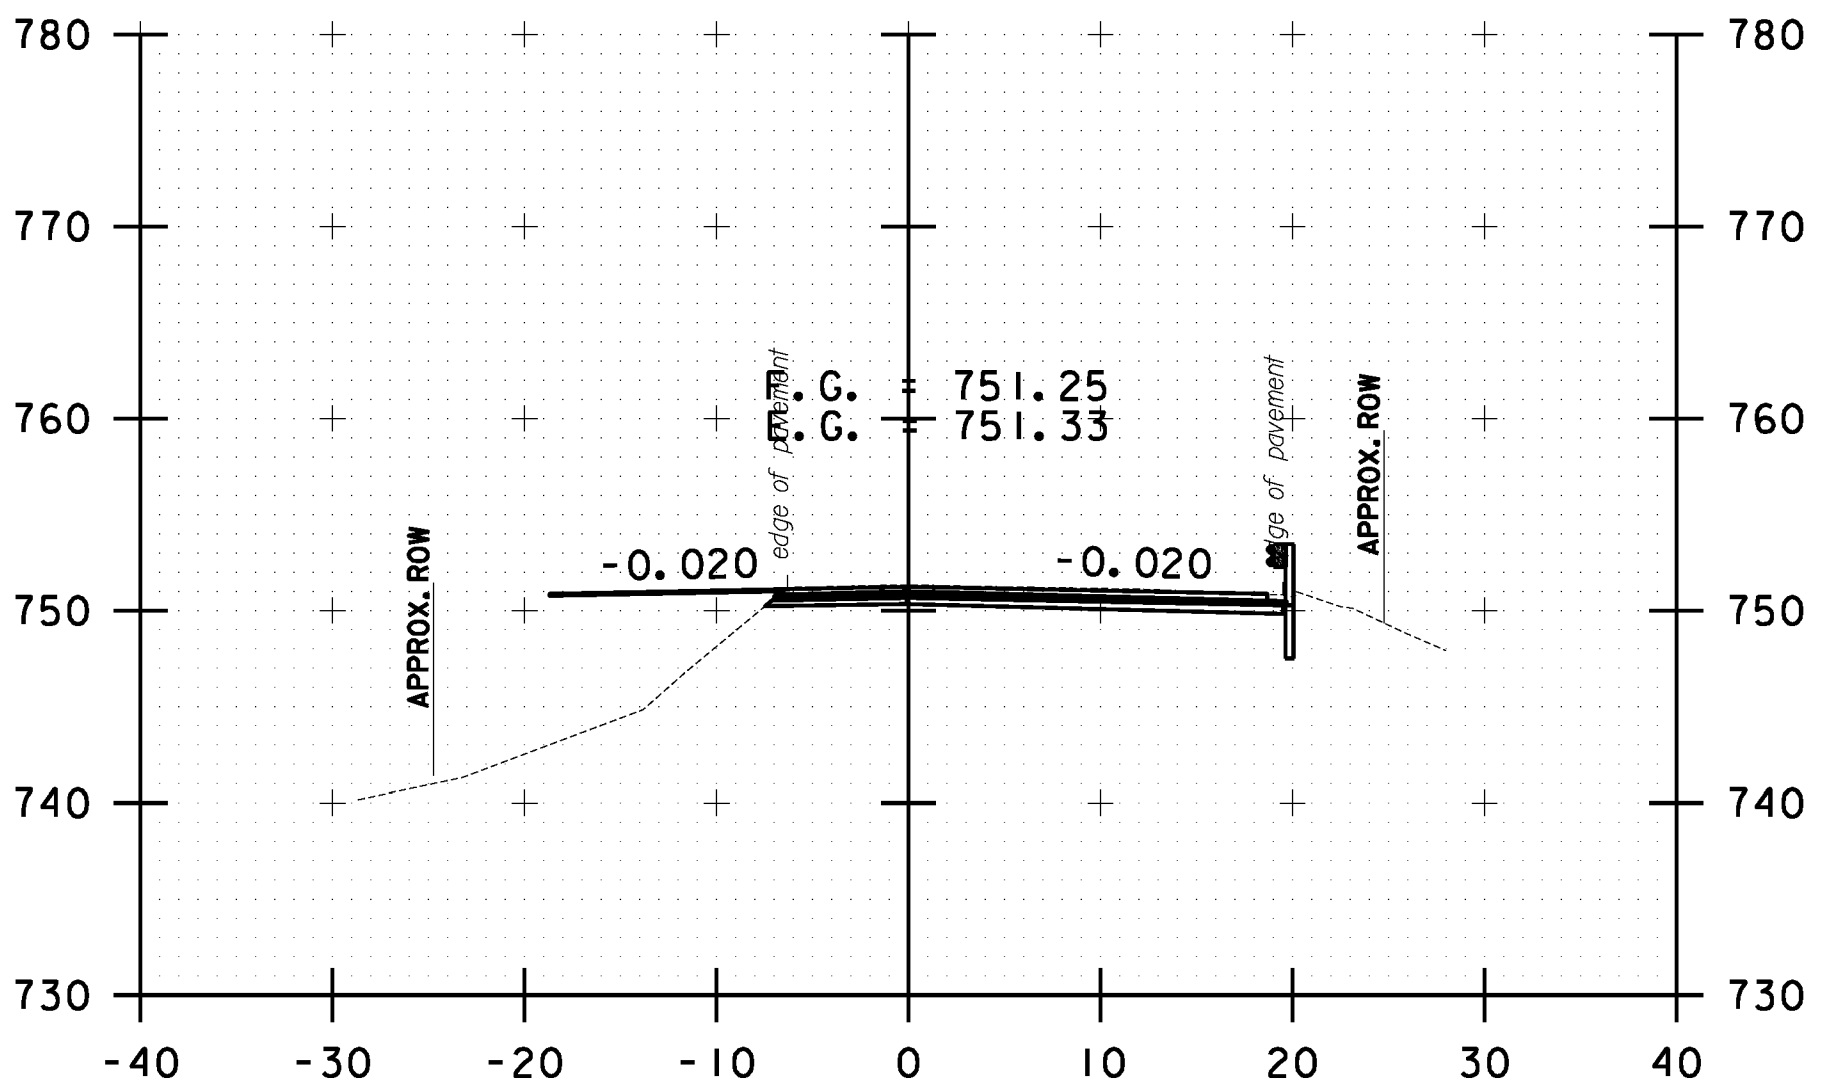

12+00.00
(BR 1)

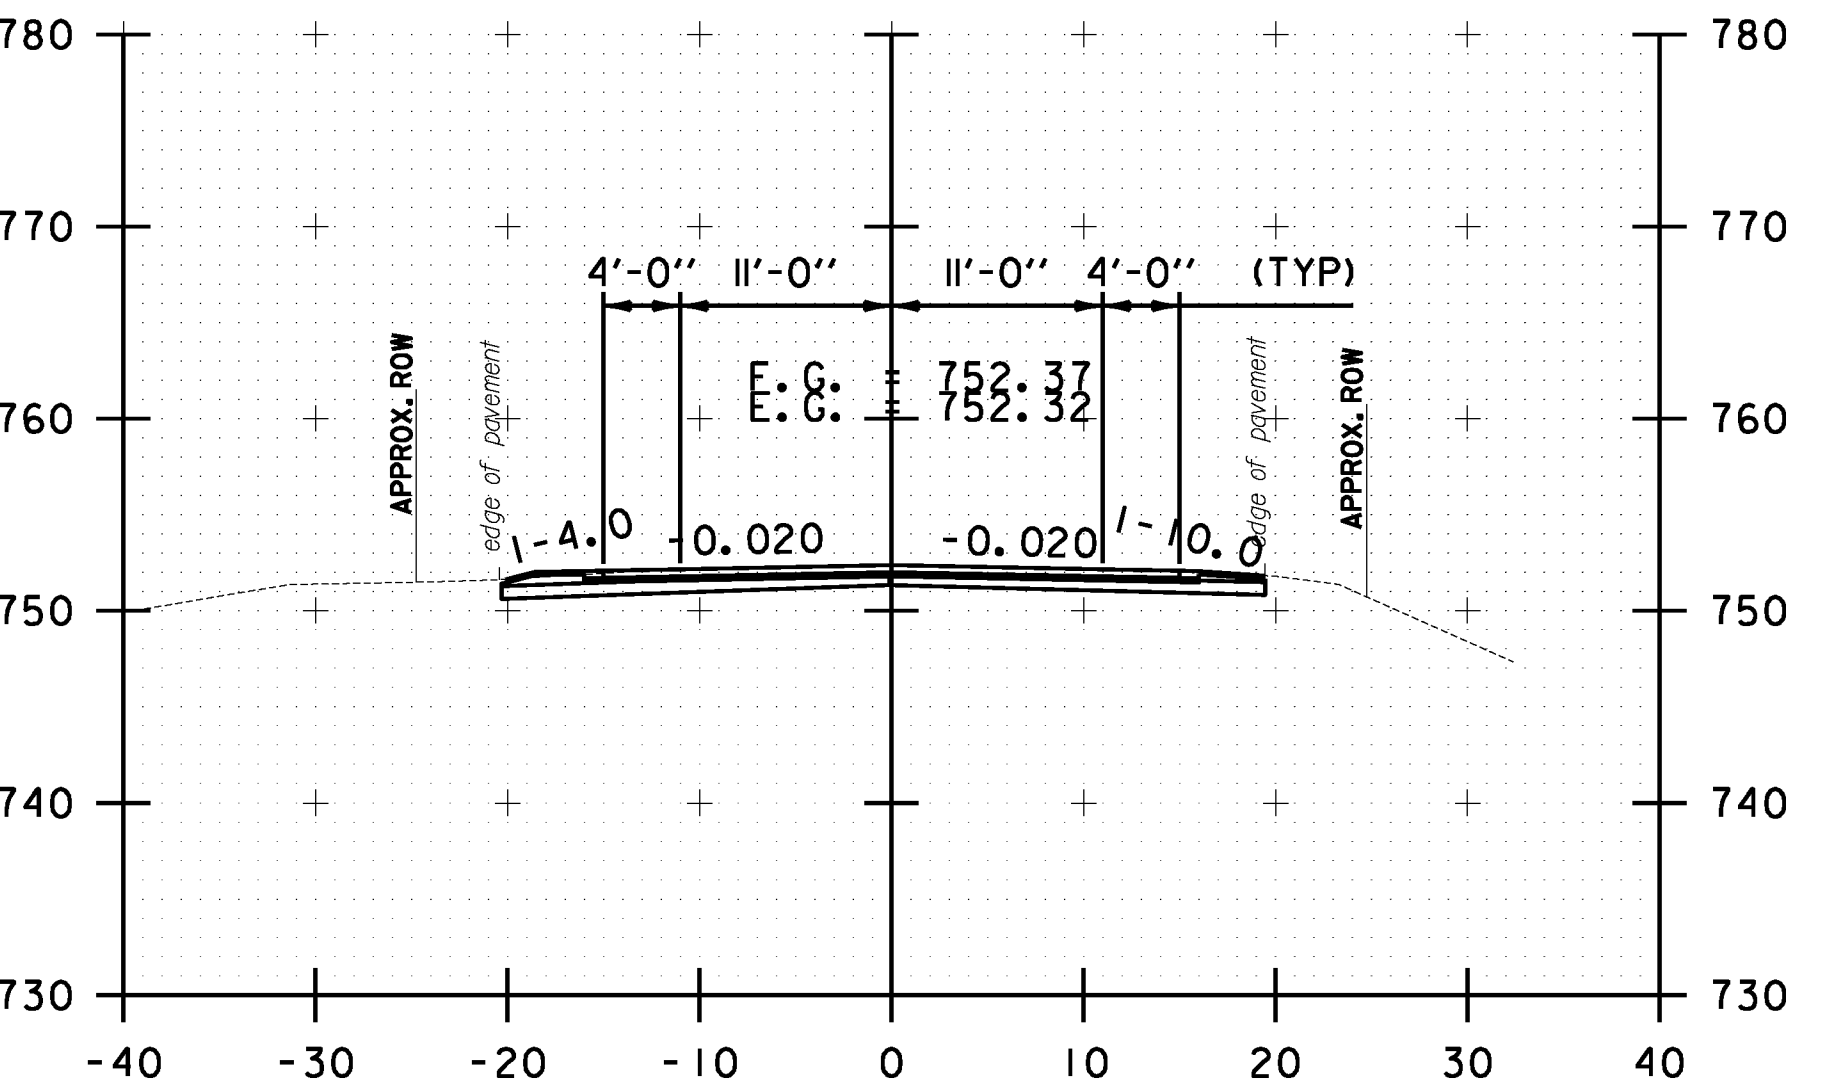

13+00.00

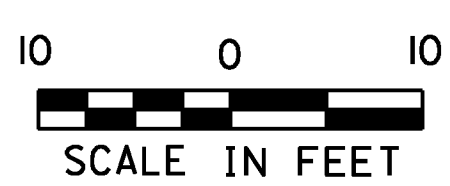

STOCKBRIDGE CROSS SECTION SHEET #4	PROJECT NAME: STOCKBRIDGE-BETHEL
	PROJECT NUMBER: STP 2910(1)
	FILE NAME: z10b214_stock_xc.dgn
	PLOT DATE: 3/17/2014
DESIGNED BY: L.M.B.	DRAWN BY: W.G.P.
IPARM FILE: z10b214xs4.1	CHECKED BY: J.P.S.
	SHEET 217 OF 397