




FILE NAME = Y:\P\c\ass\ANY\K2\22425\CADD\MSTN\10b214\_stock\_xc.dgn  
 DATE/TIME = 3/17/2014  
 USER = 4916

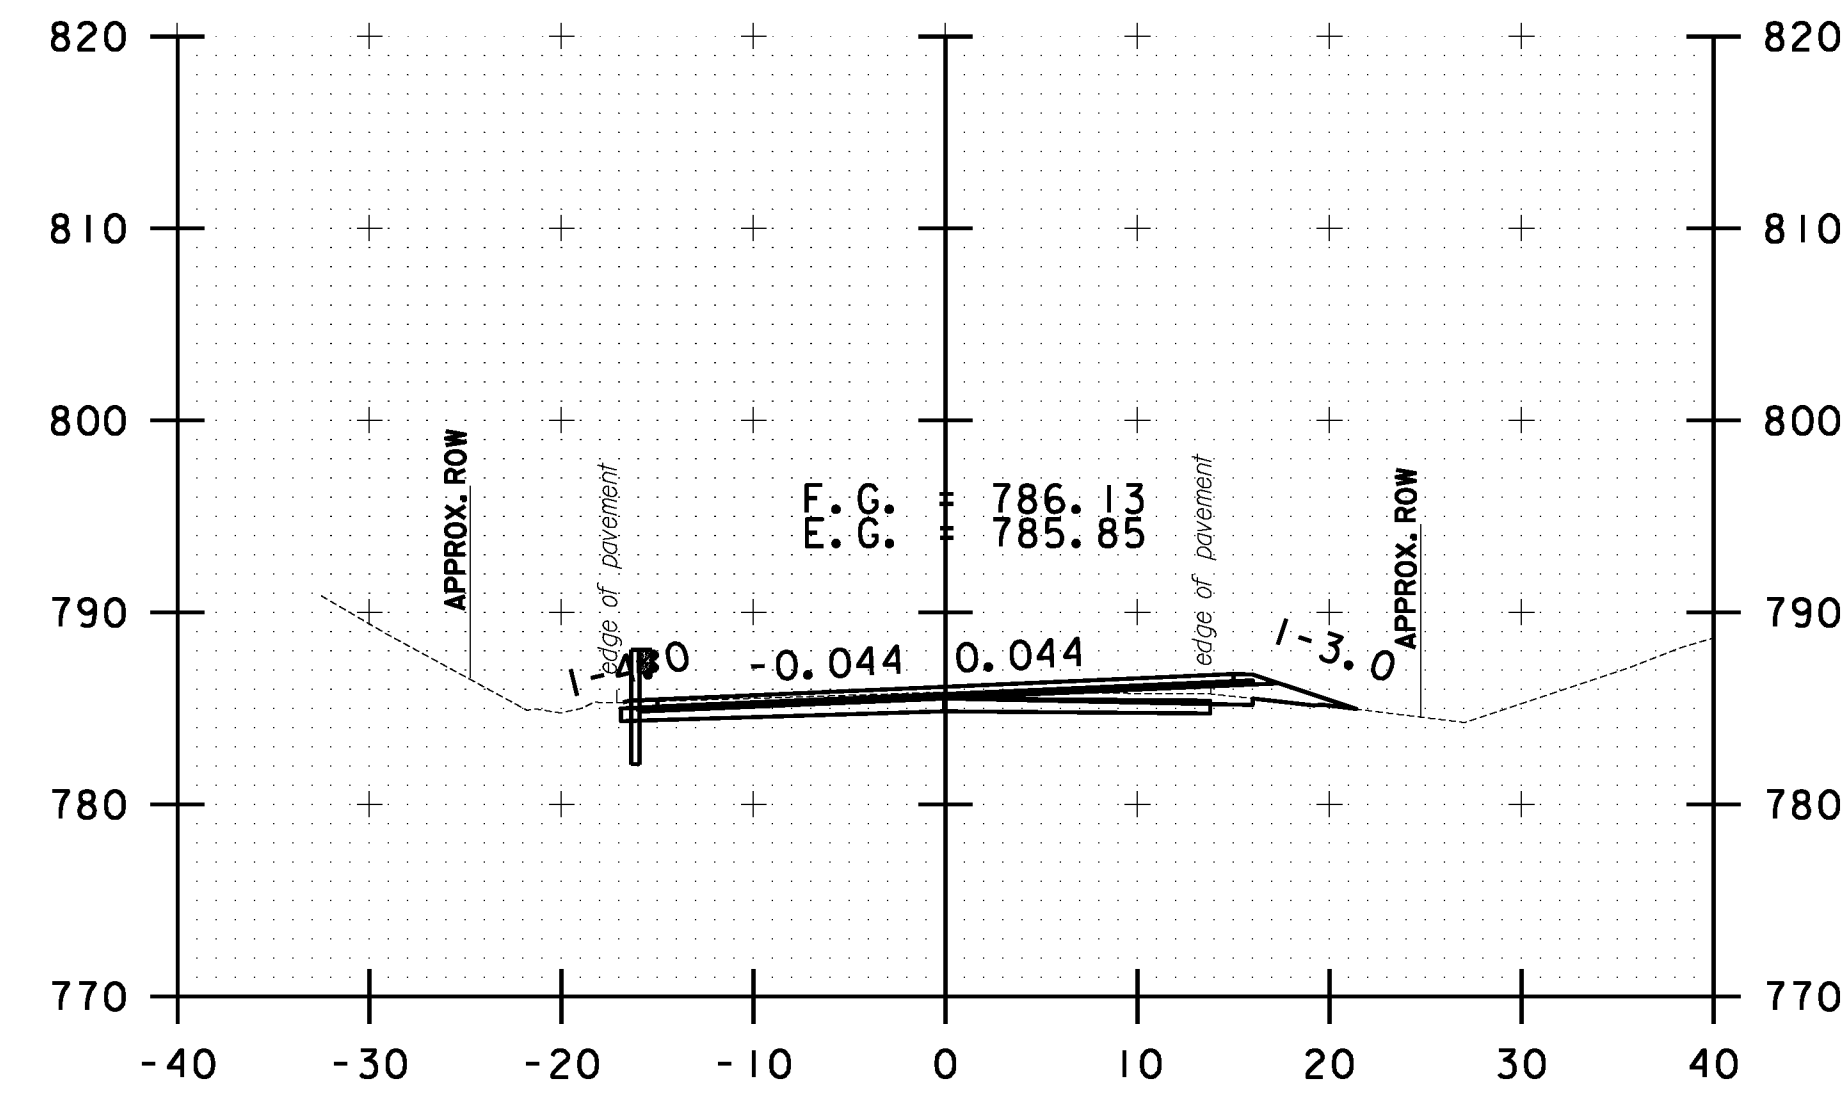


20+00.00

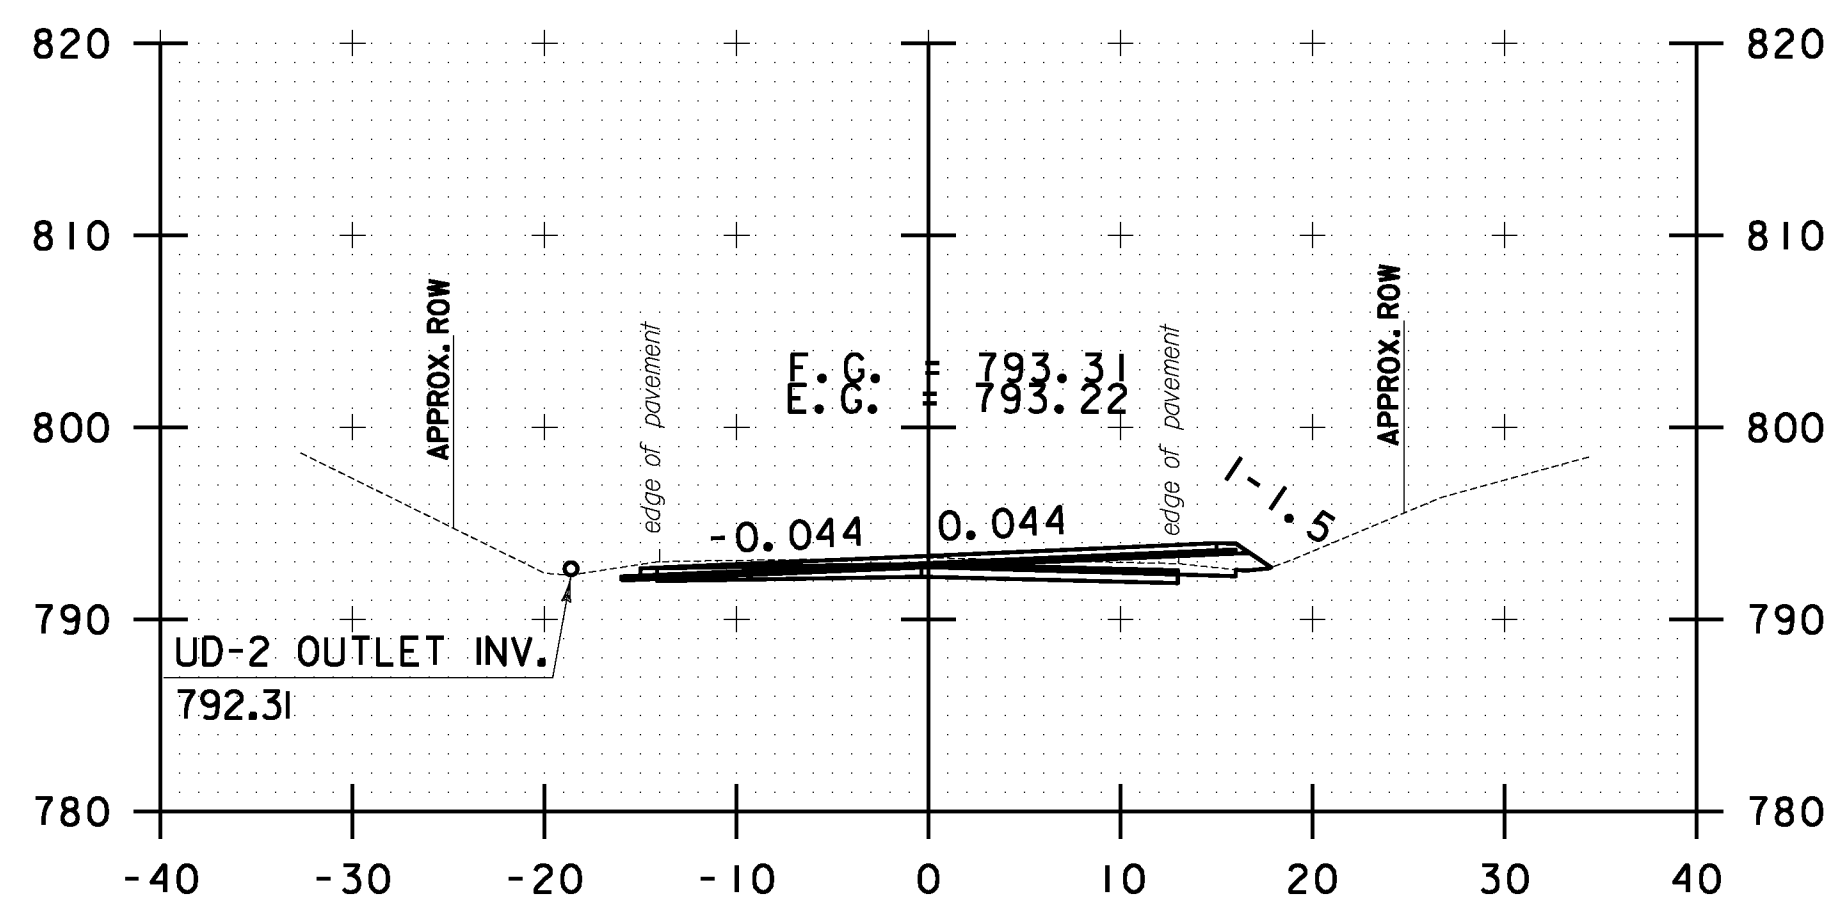


21+00.00

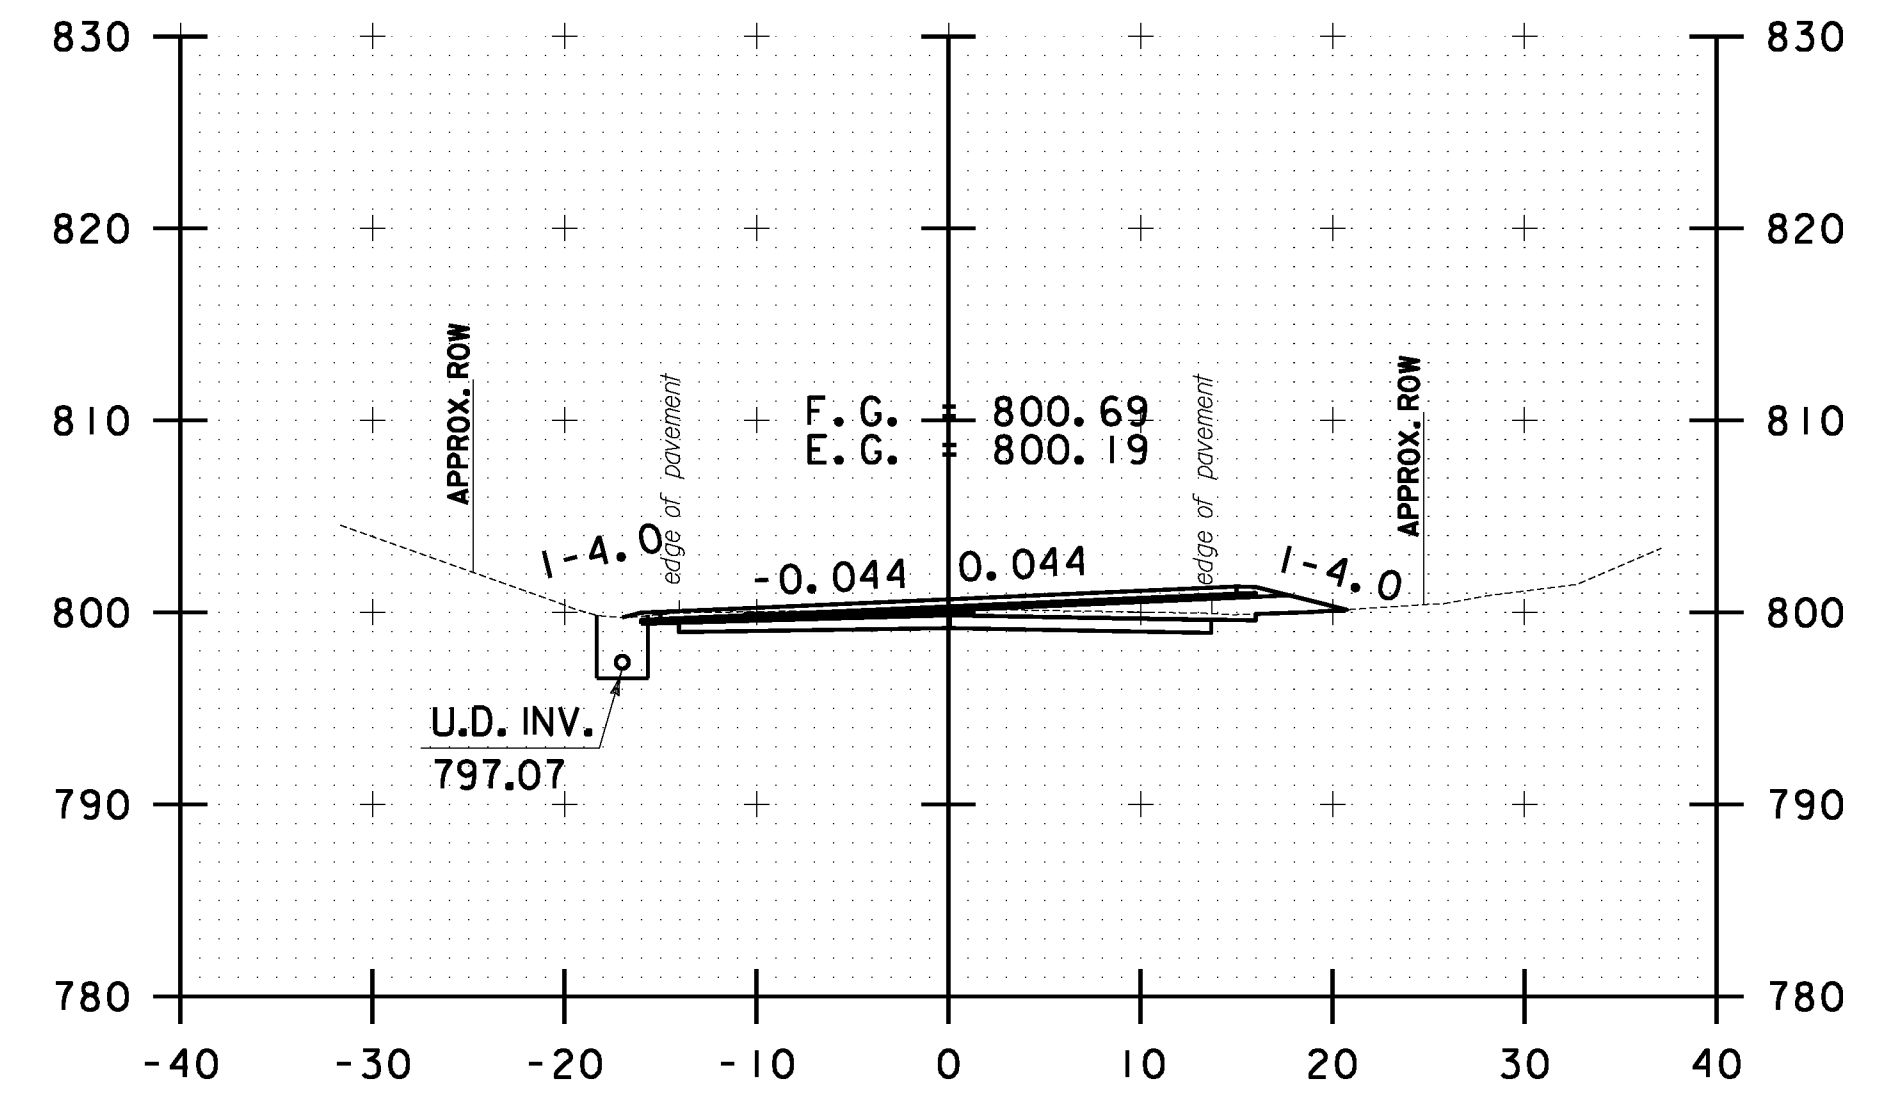


22+00.00

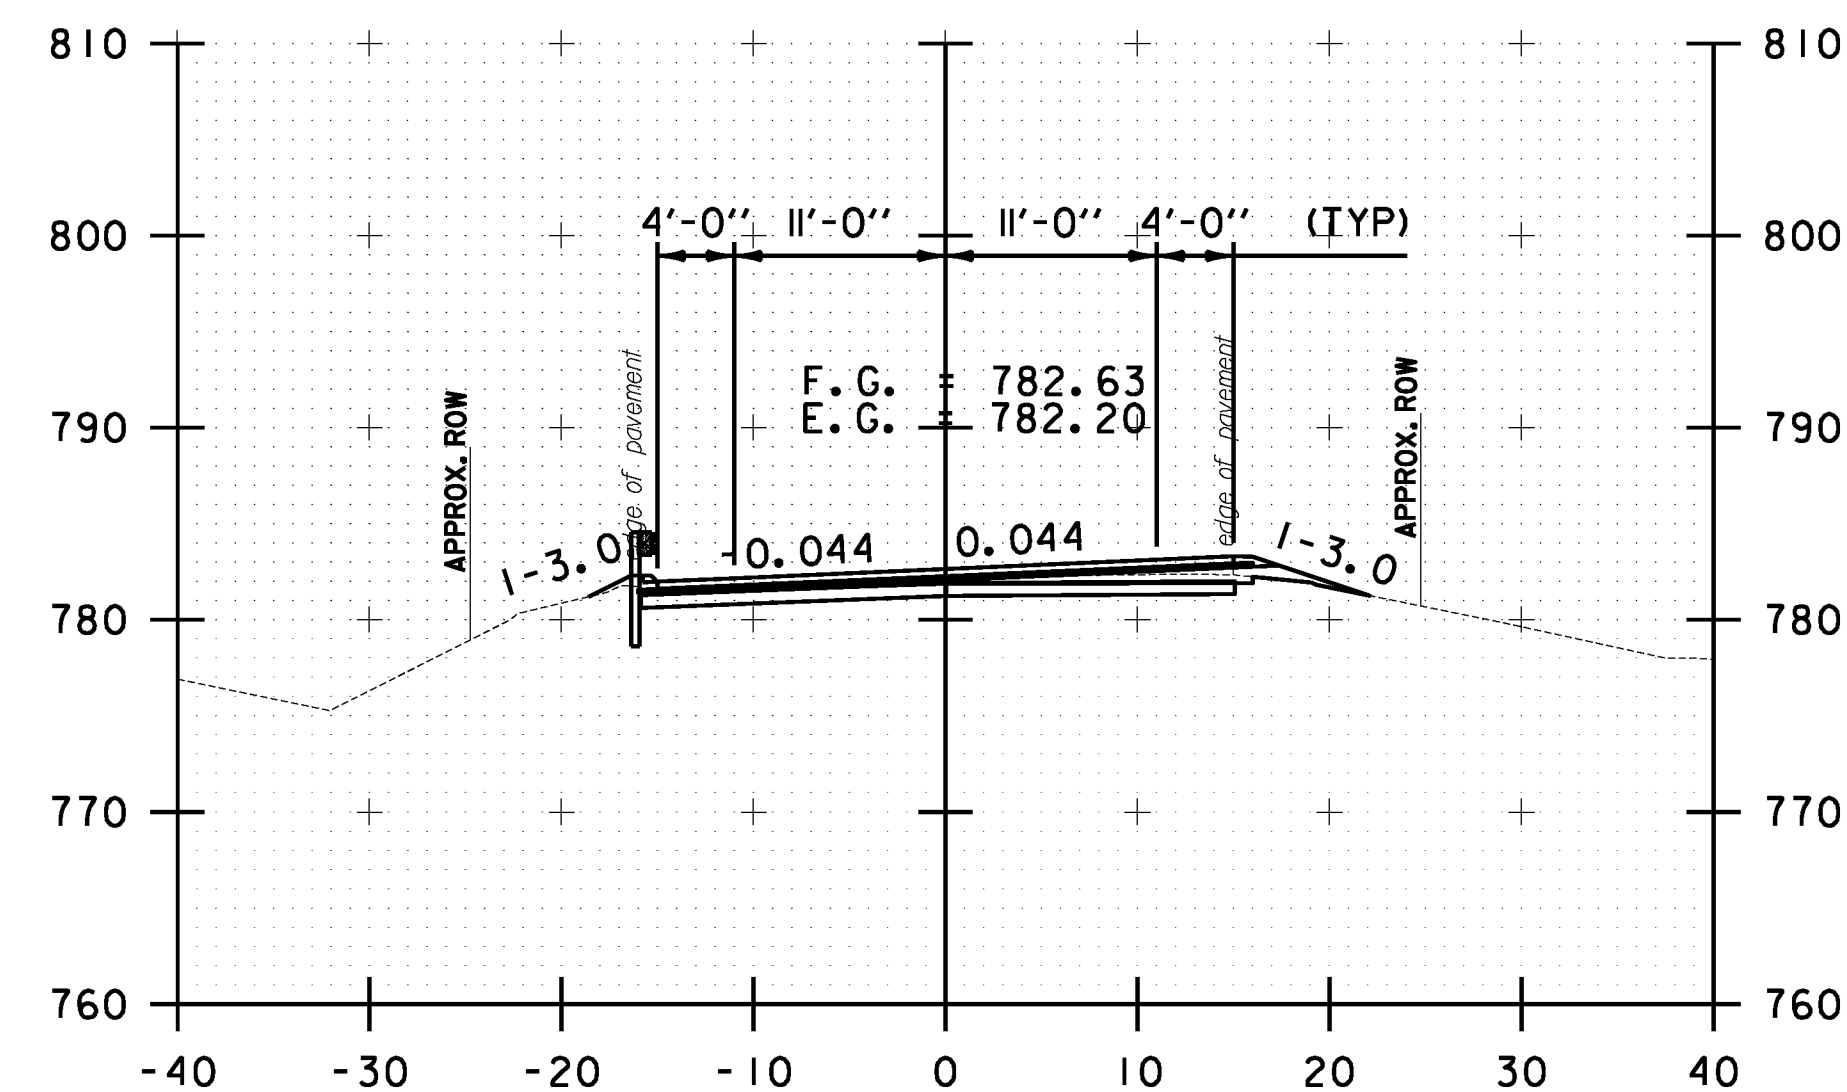


19+50.00

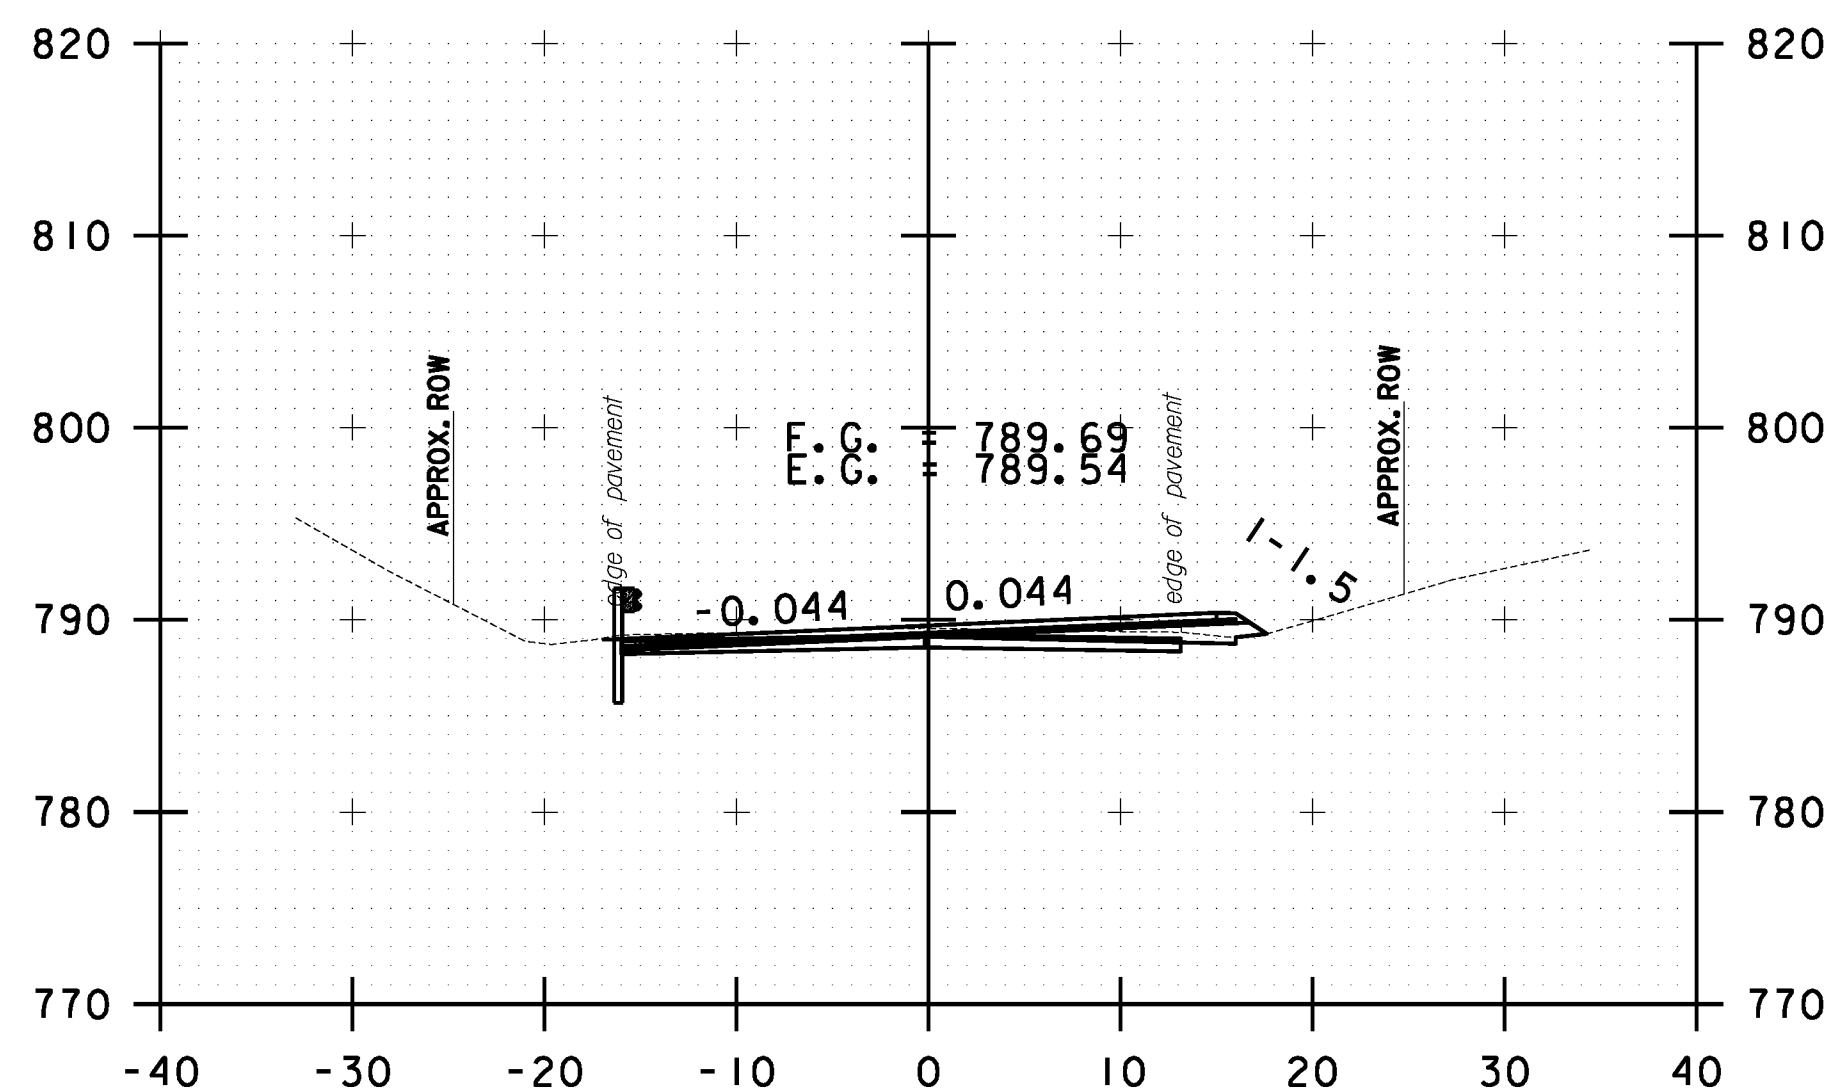

20+50.00

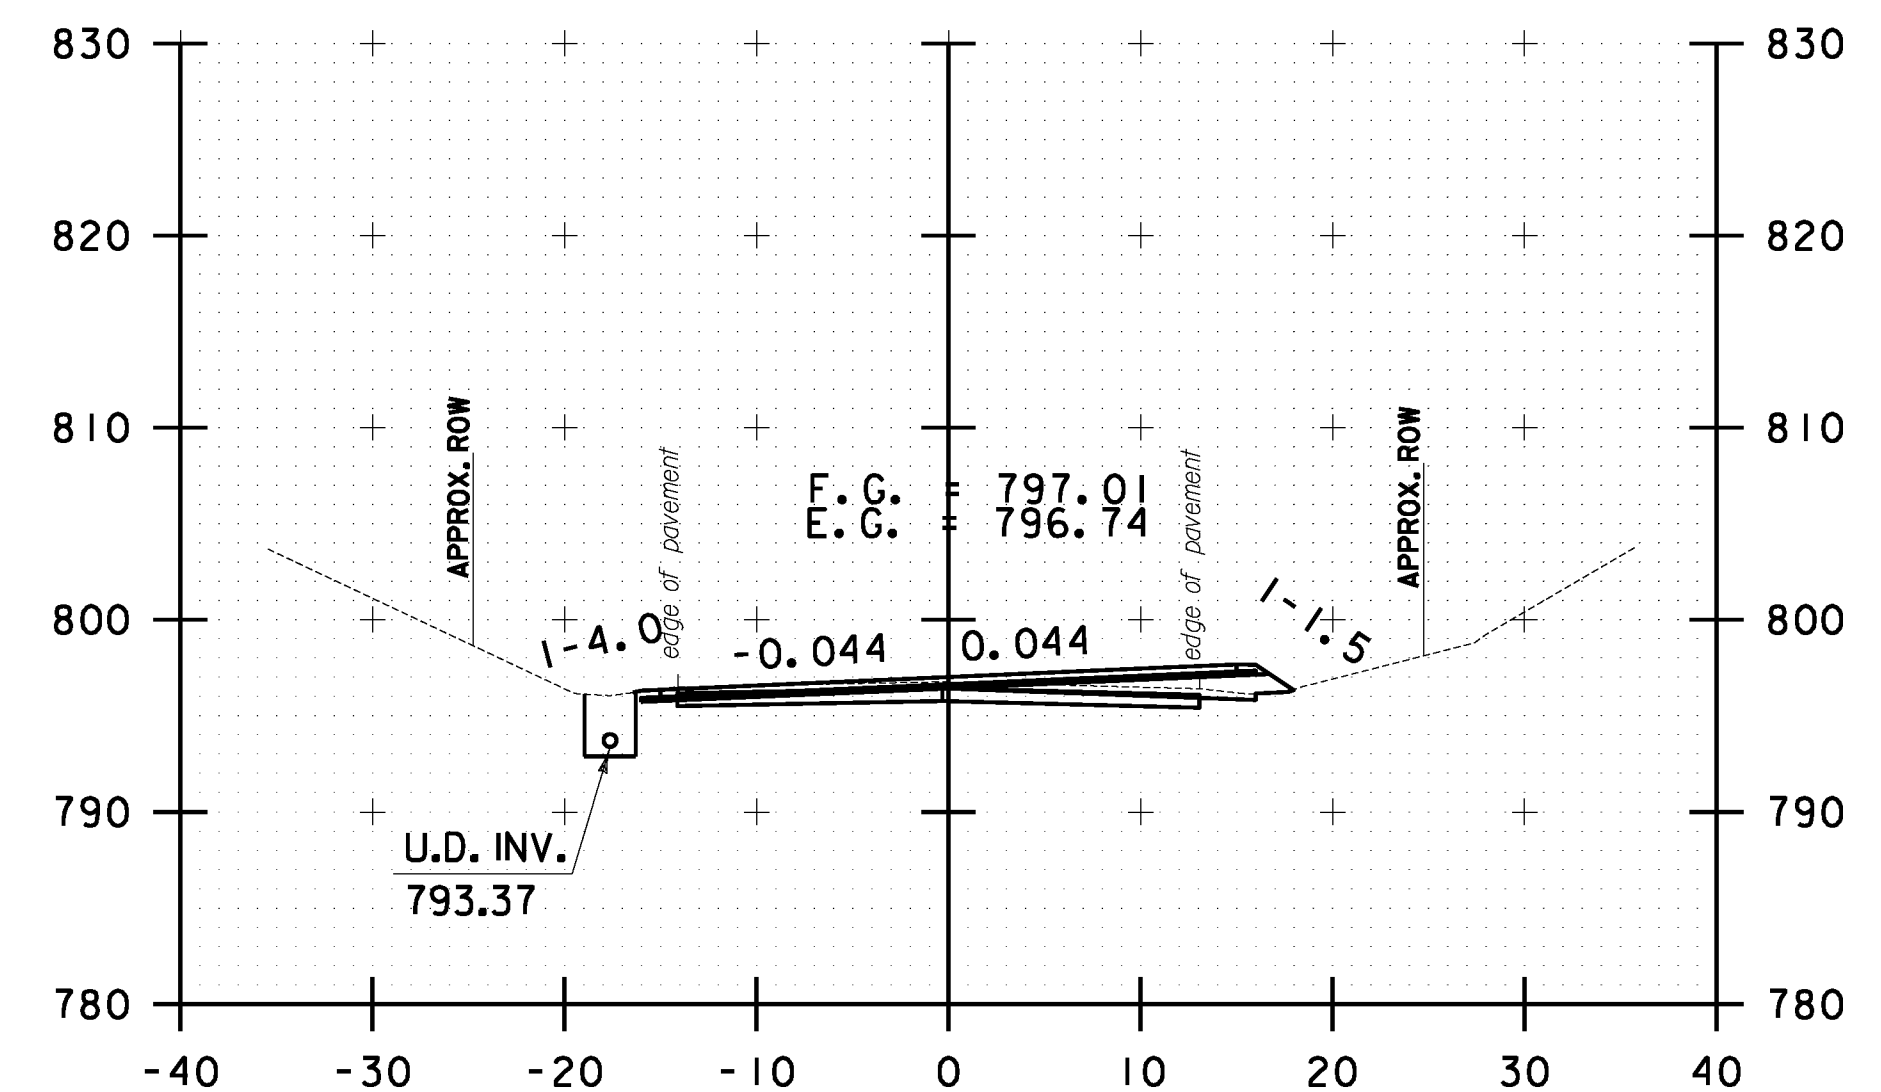

21+50.00

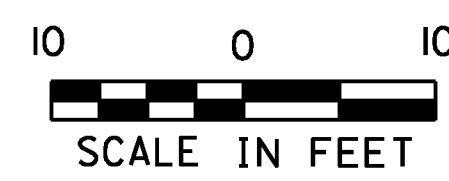

<b>STOCKBRIDGE CROSS SECTION SHEET #7</b>	PROJECT NAME: STOCKBRIDGE-BETHEL
	PROJECT NUMBER: STP 2910(1)
	FILE NAME: z10b214_stock_xc.dgn
DESIGNED BY: L.M.B.	PLOT DATE: 3/17/2014
IPARM FILE: z10b214xs7.1	DRAWN BY: W.G.P.
	CHECKED BY: J.P.S.
	SHEET 220 OF 397