




FILE NAME = Y:\P\c\ass\ANY\K2\22425\CA001\MSTN\10b214_stock.nc.dgn
 DATE/TIME = 3/17/2014
 USER = 4916

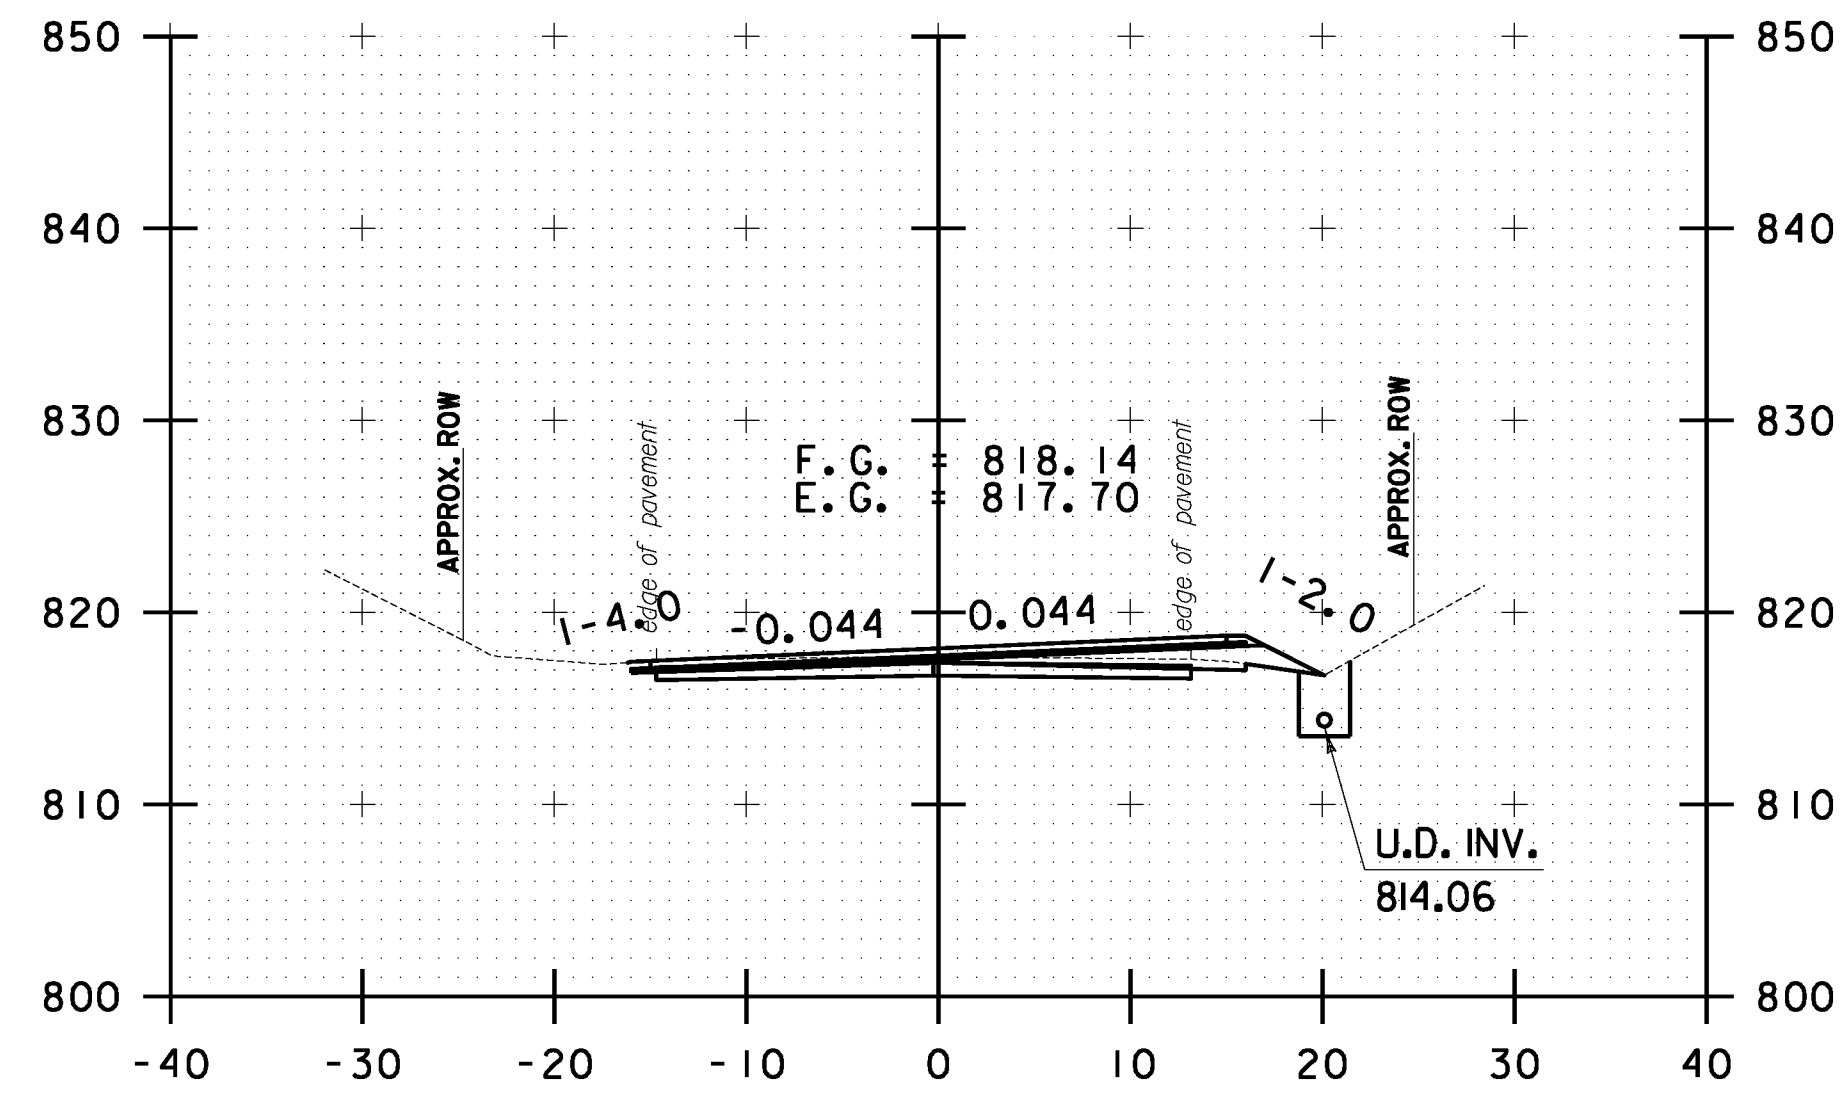


26+00.00

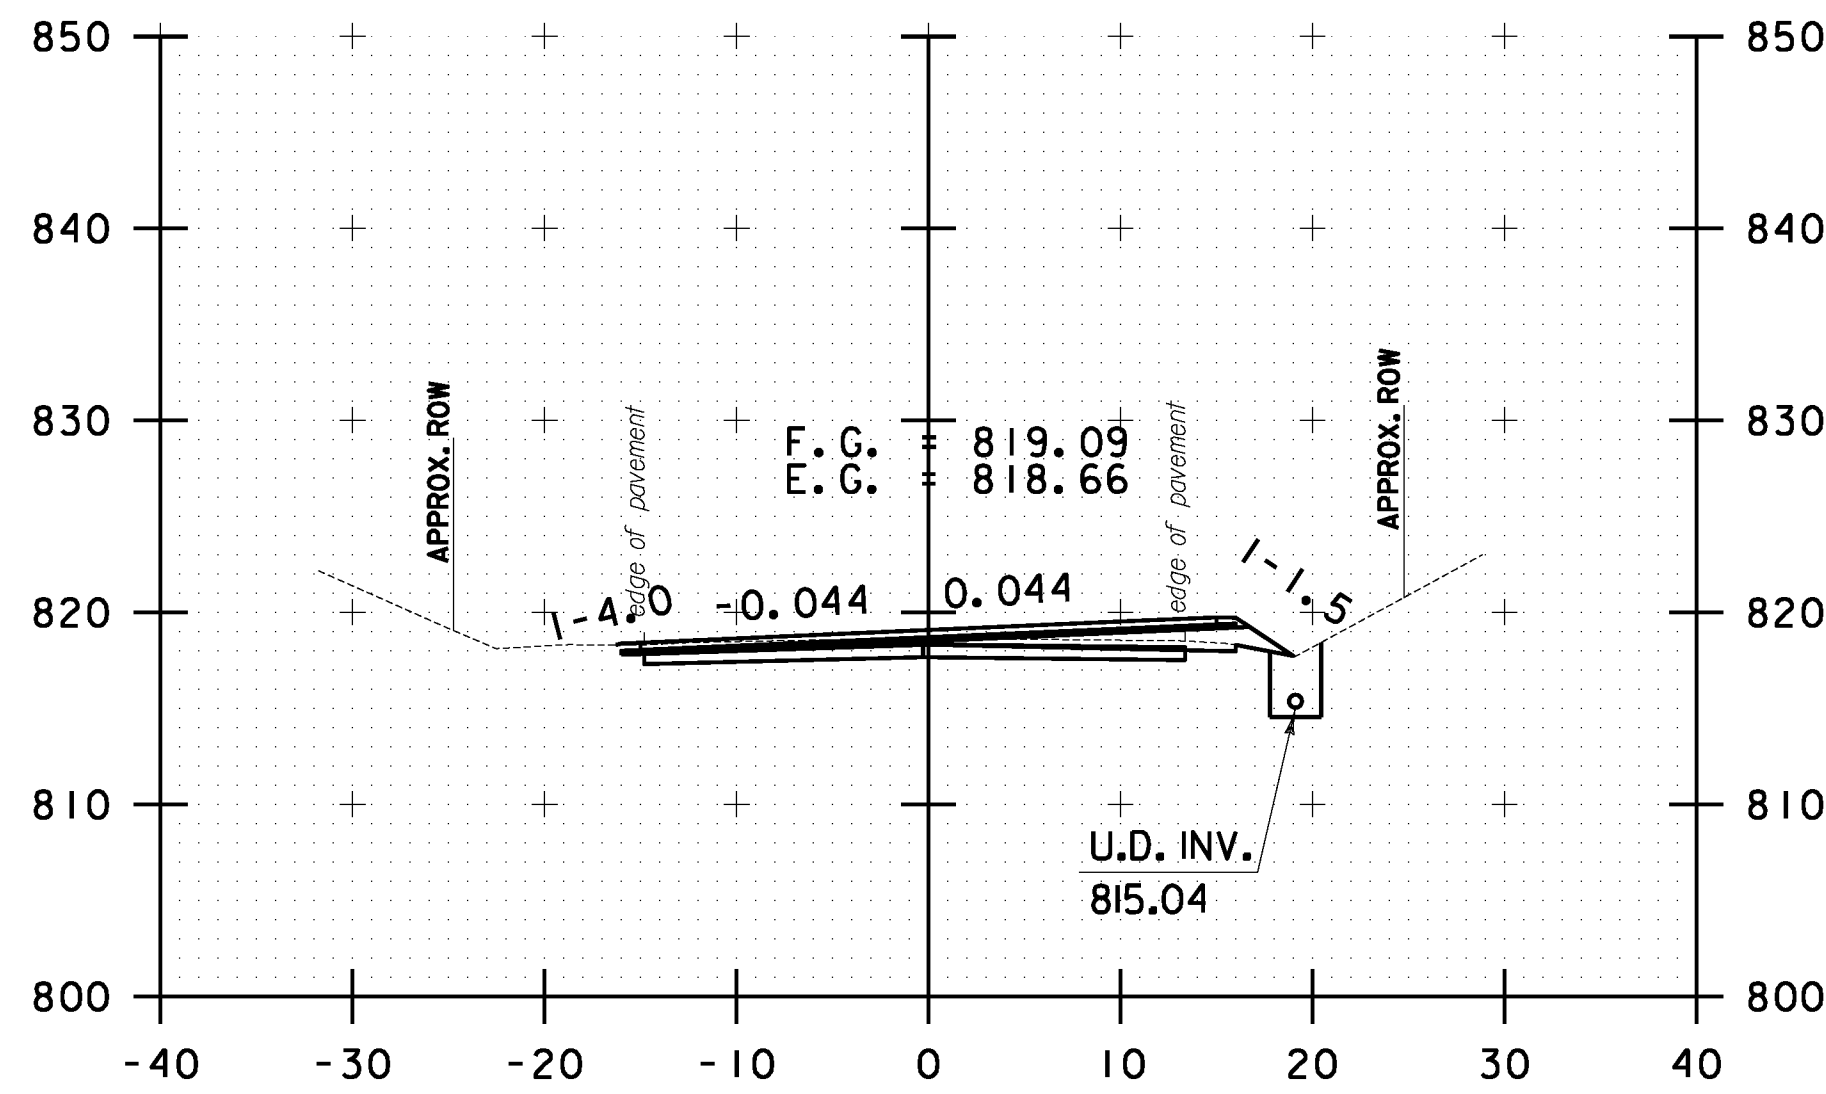


27+00.00

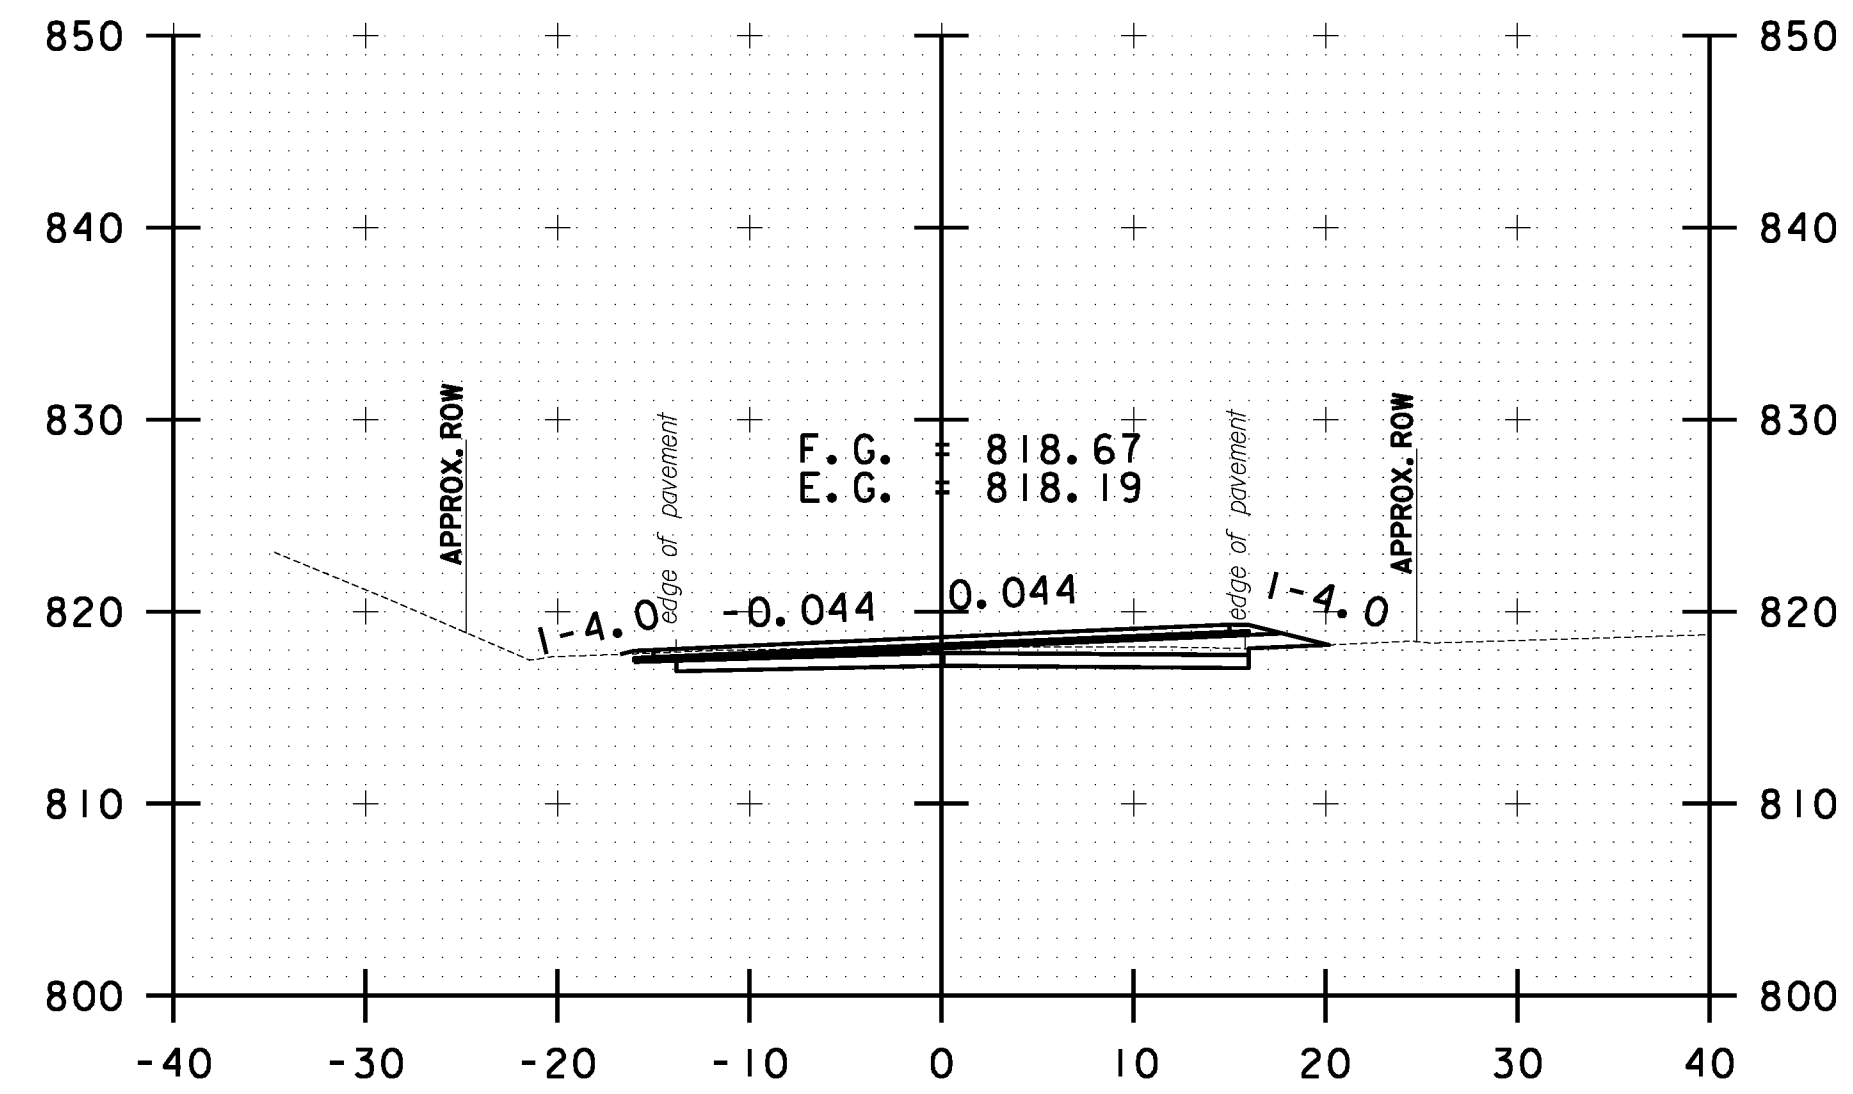


28+00.00

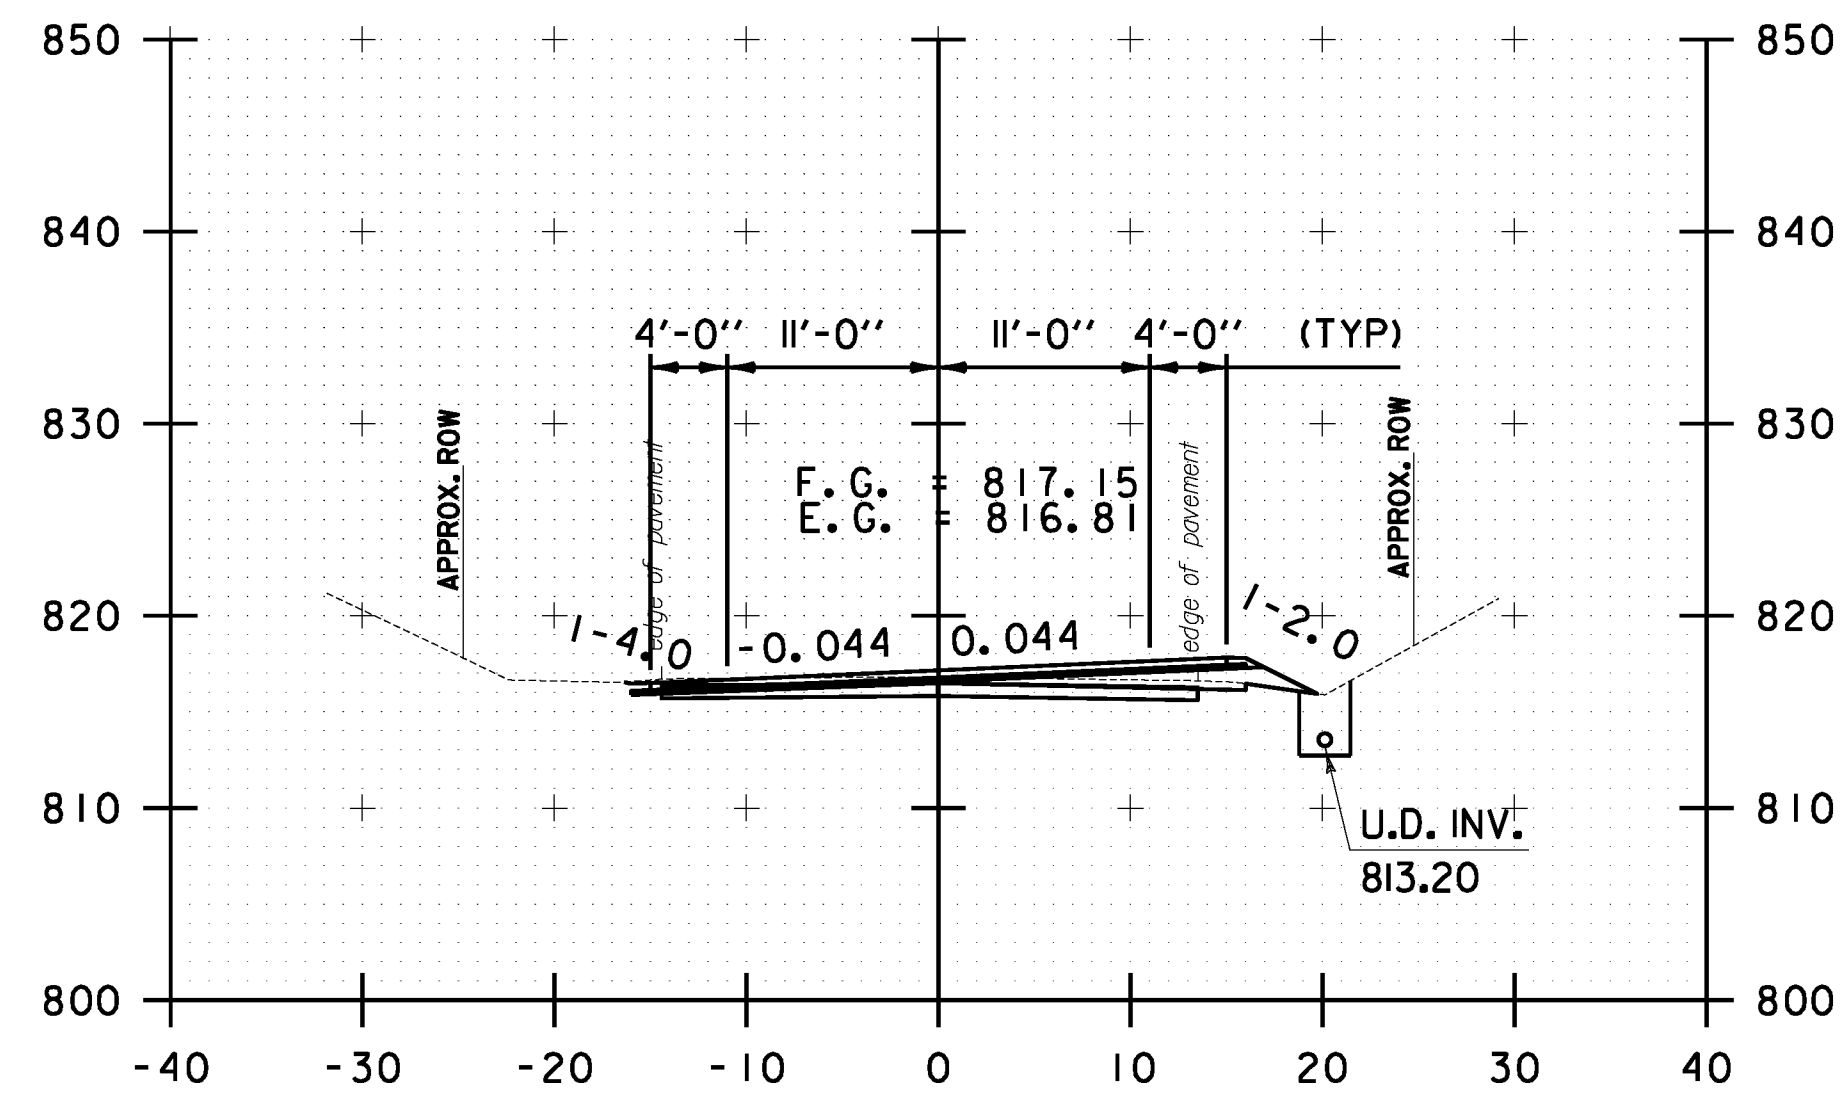


25+50.00

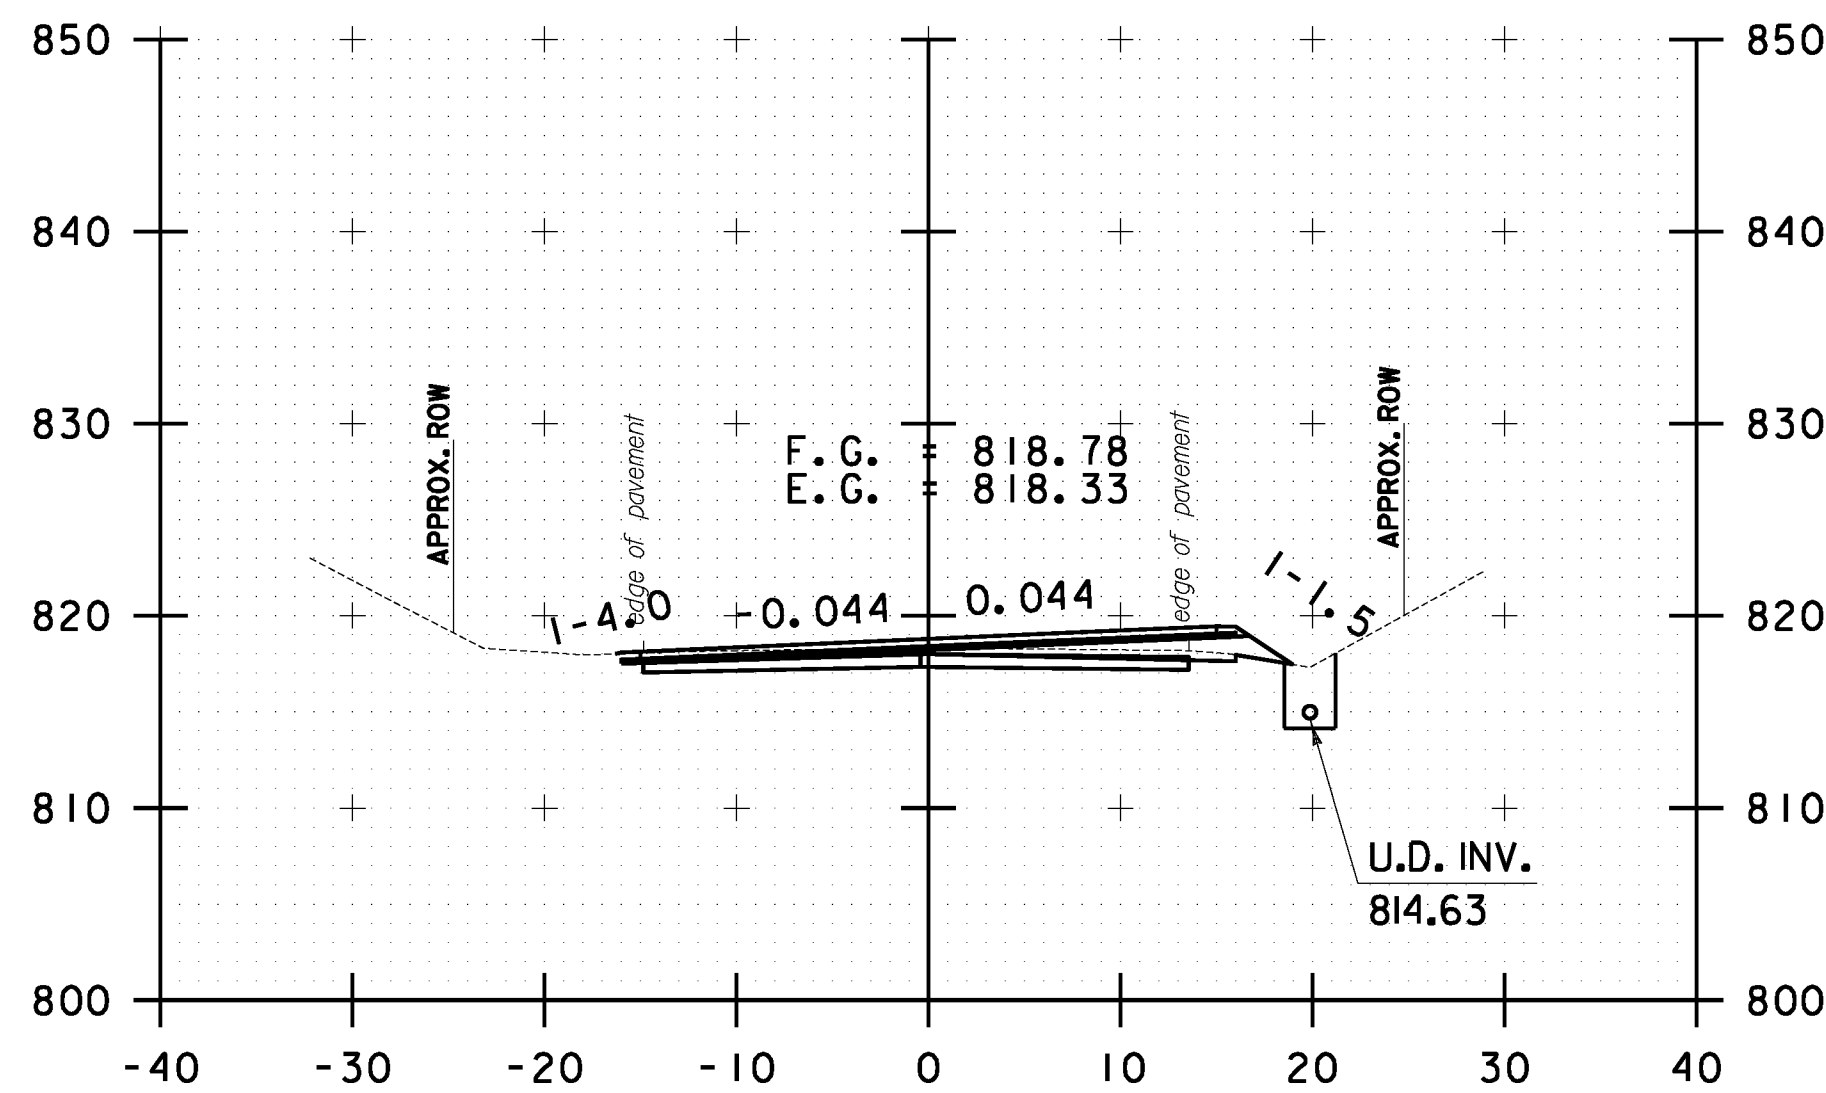

26+50.00

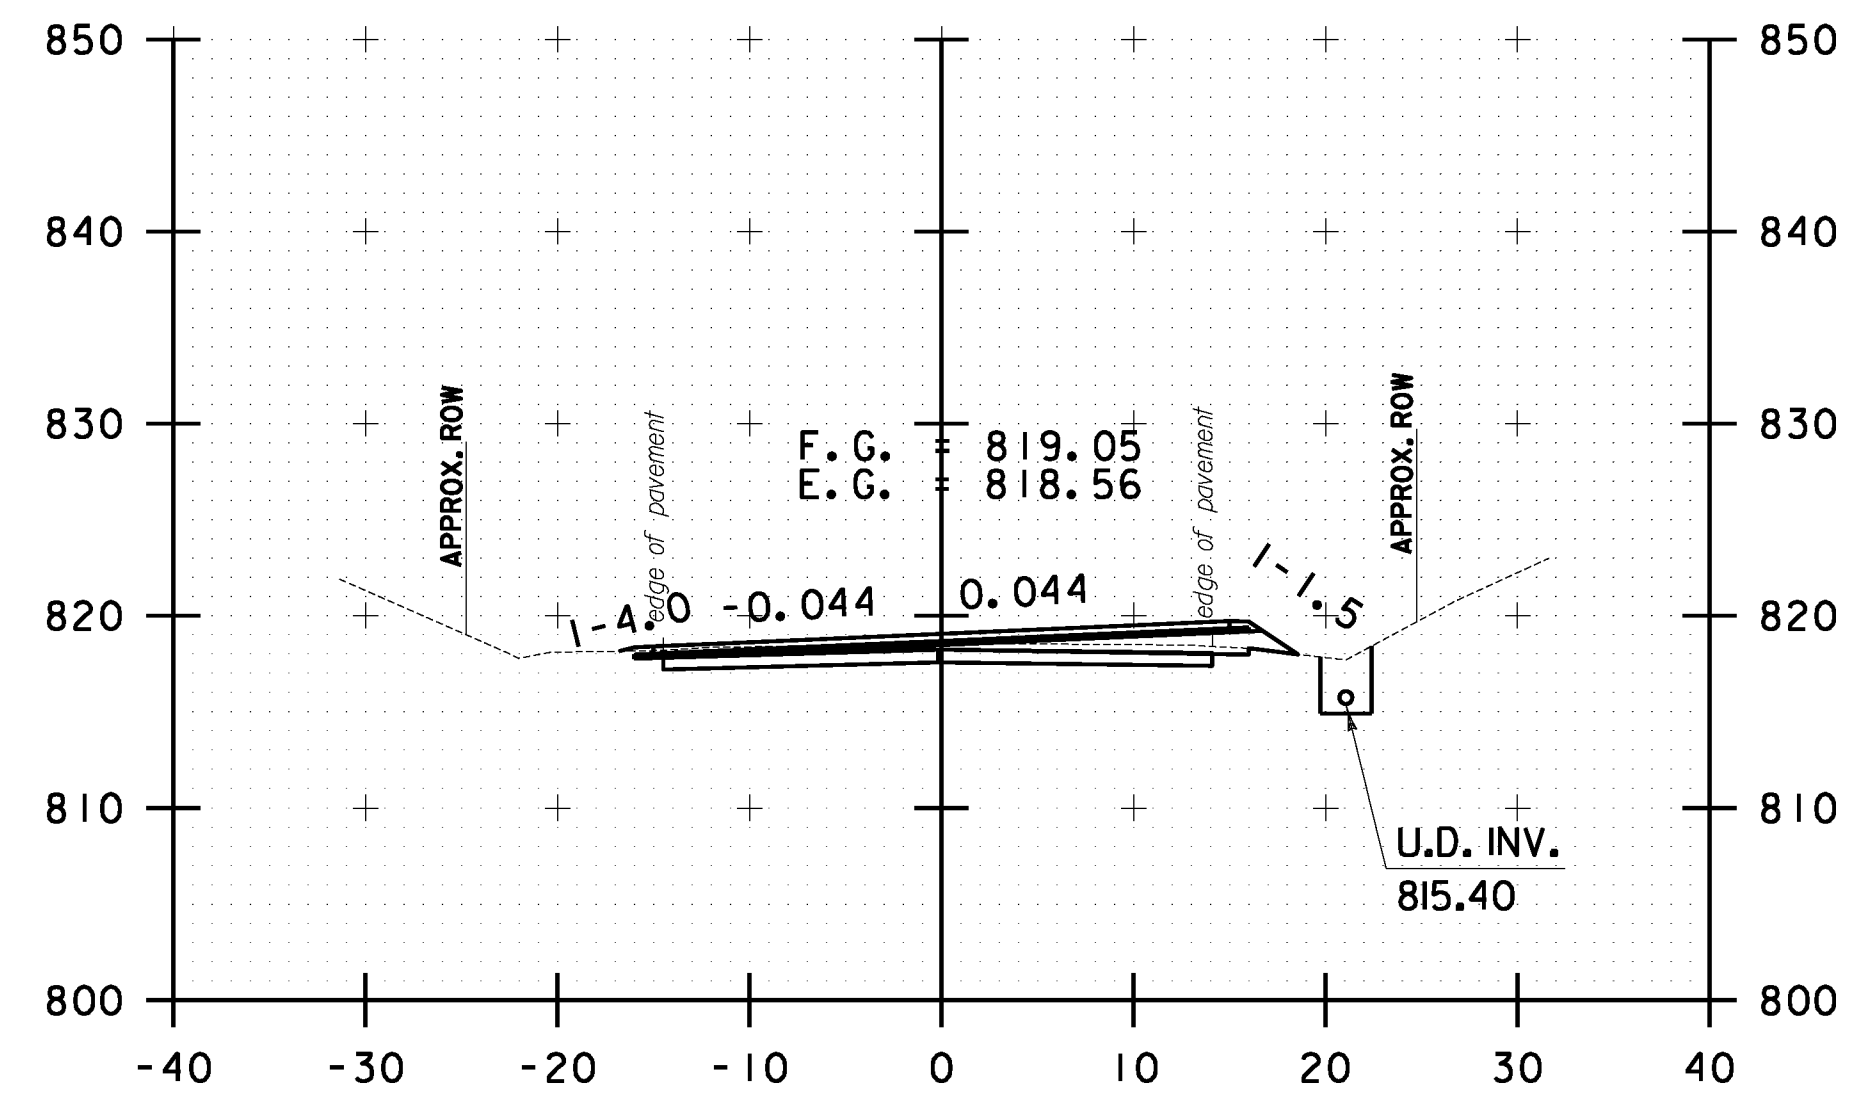

27+50.00

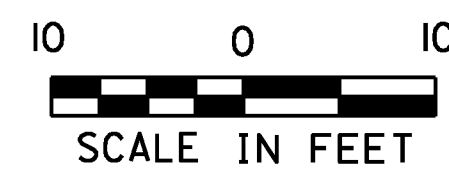

**STOCKBRIDGE
 CROSS SECTION
 SHEET #9**

PROJECT NAME: STOCKBRIDGE-BETHEL	
PROJECT NUMBER: STP 2910(1)	
FILE NAME: z10b214_stock.nc.dgn	PLOT DATE: 3/17/2014
PROJECT LEADER: D.E.G.	DRAWN BY: W.C.P.
DESIGNED BY: L.M.B.	CHECKED BY: J.P.S.
IPARM FILE: z10b214xs9.1	SHEET 222 OF 397