




FILE NAME = Y:\P\c\g\ass\any\k2\22425\CA001\_MSTN\10b214\_stock\_xc.dgn  
 DATE/TIME = 3/17/2014  
 USER = 4916

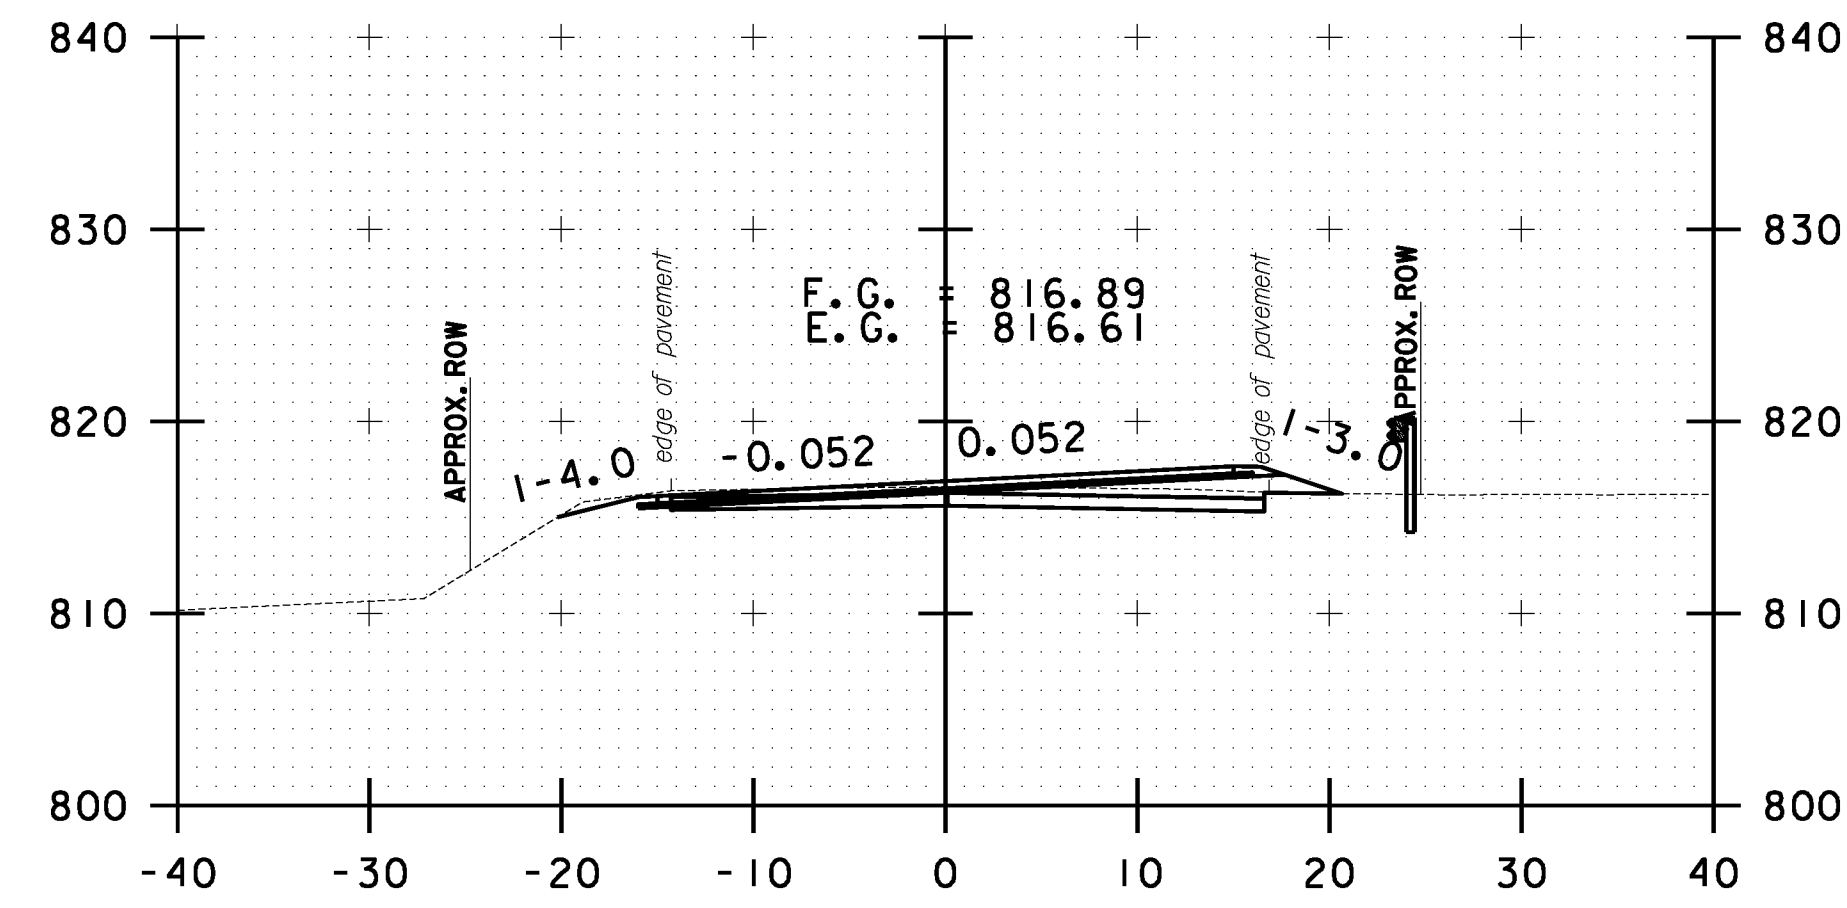


29+00.00

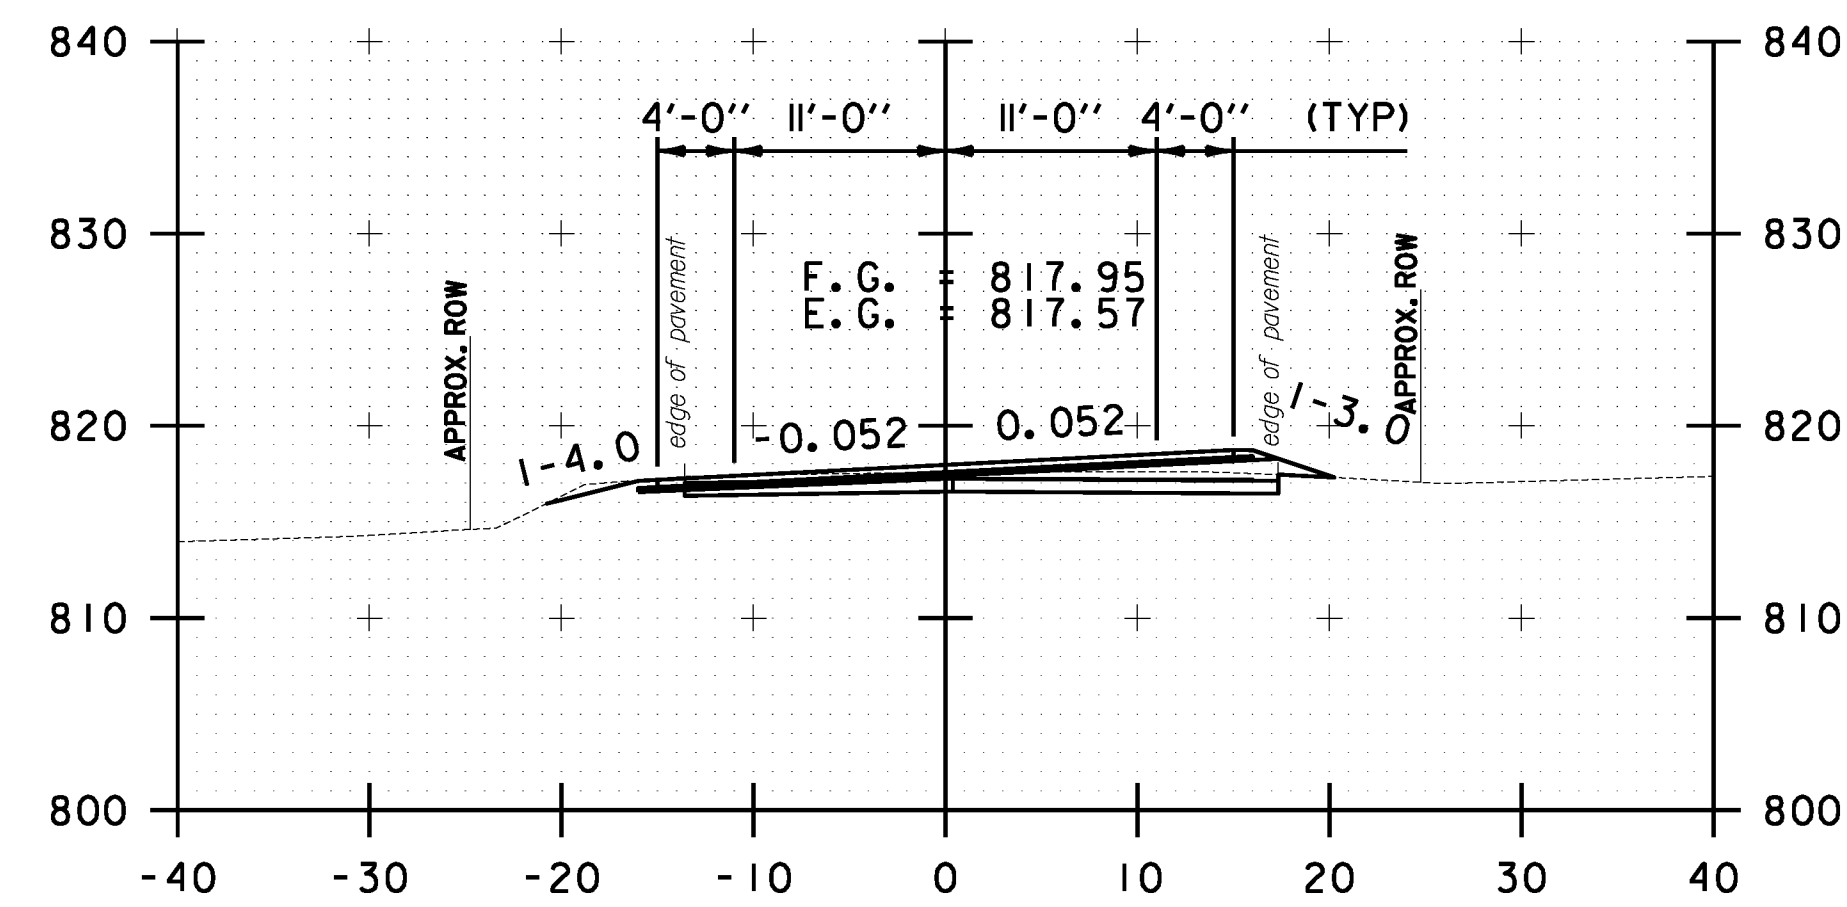


28+50.00

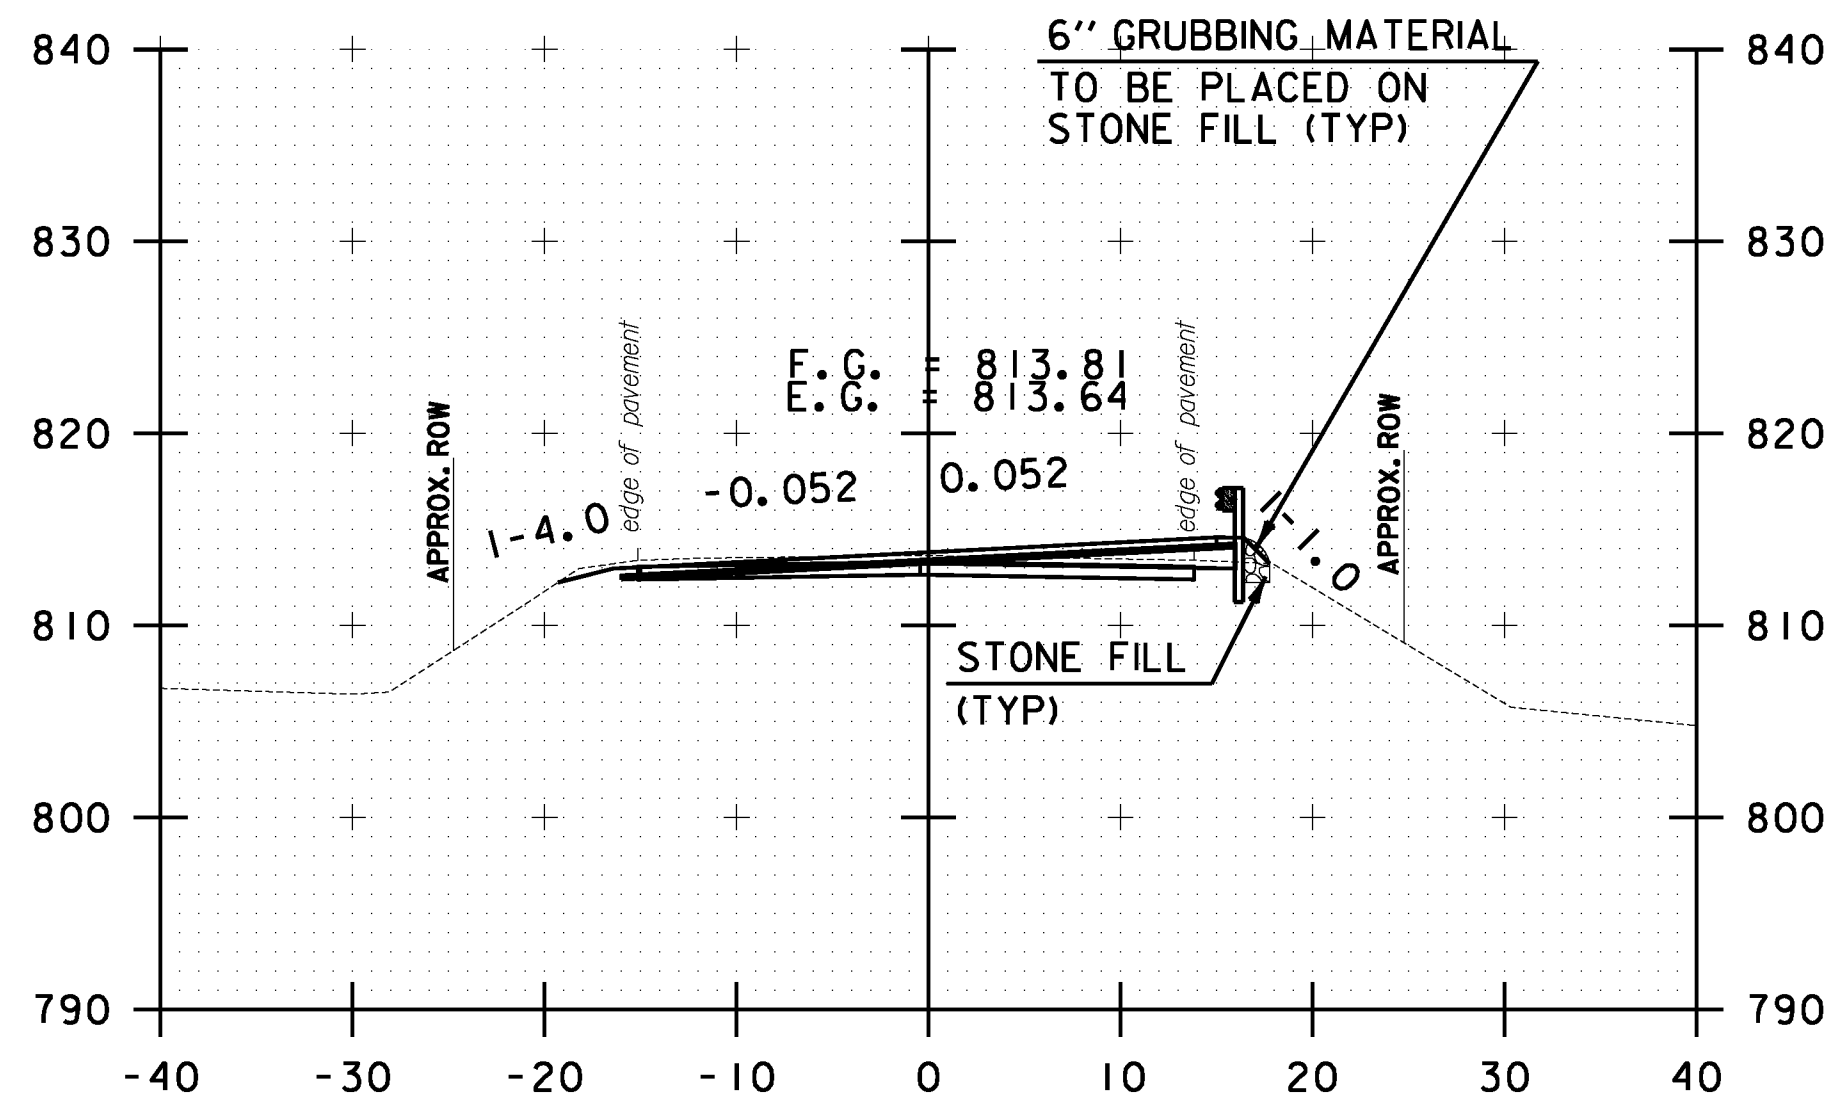


30+00.00

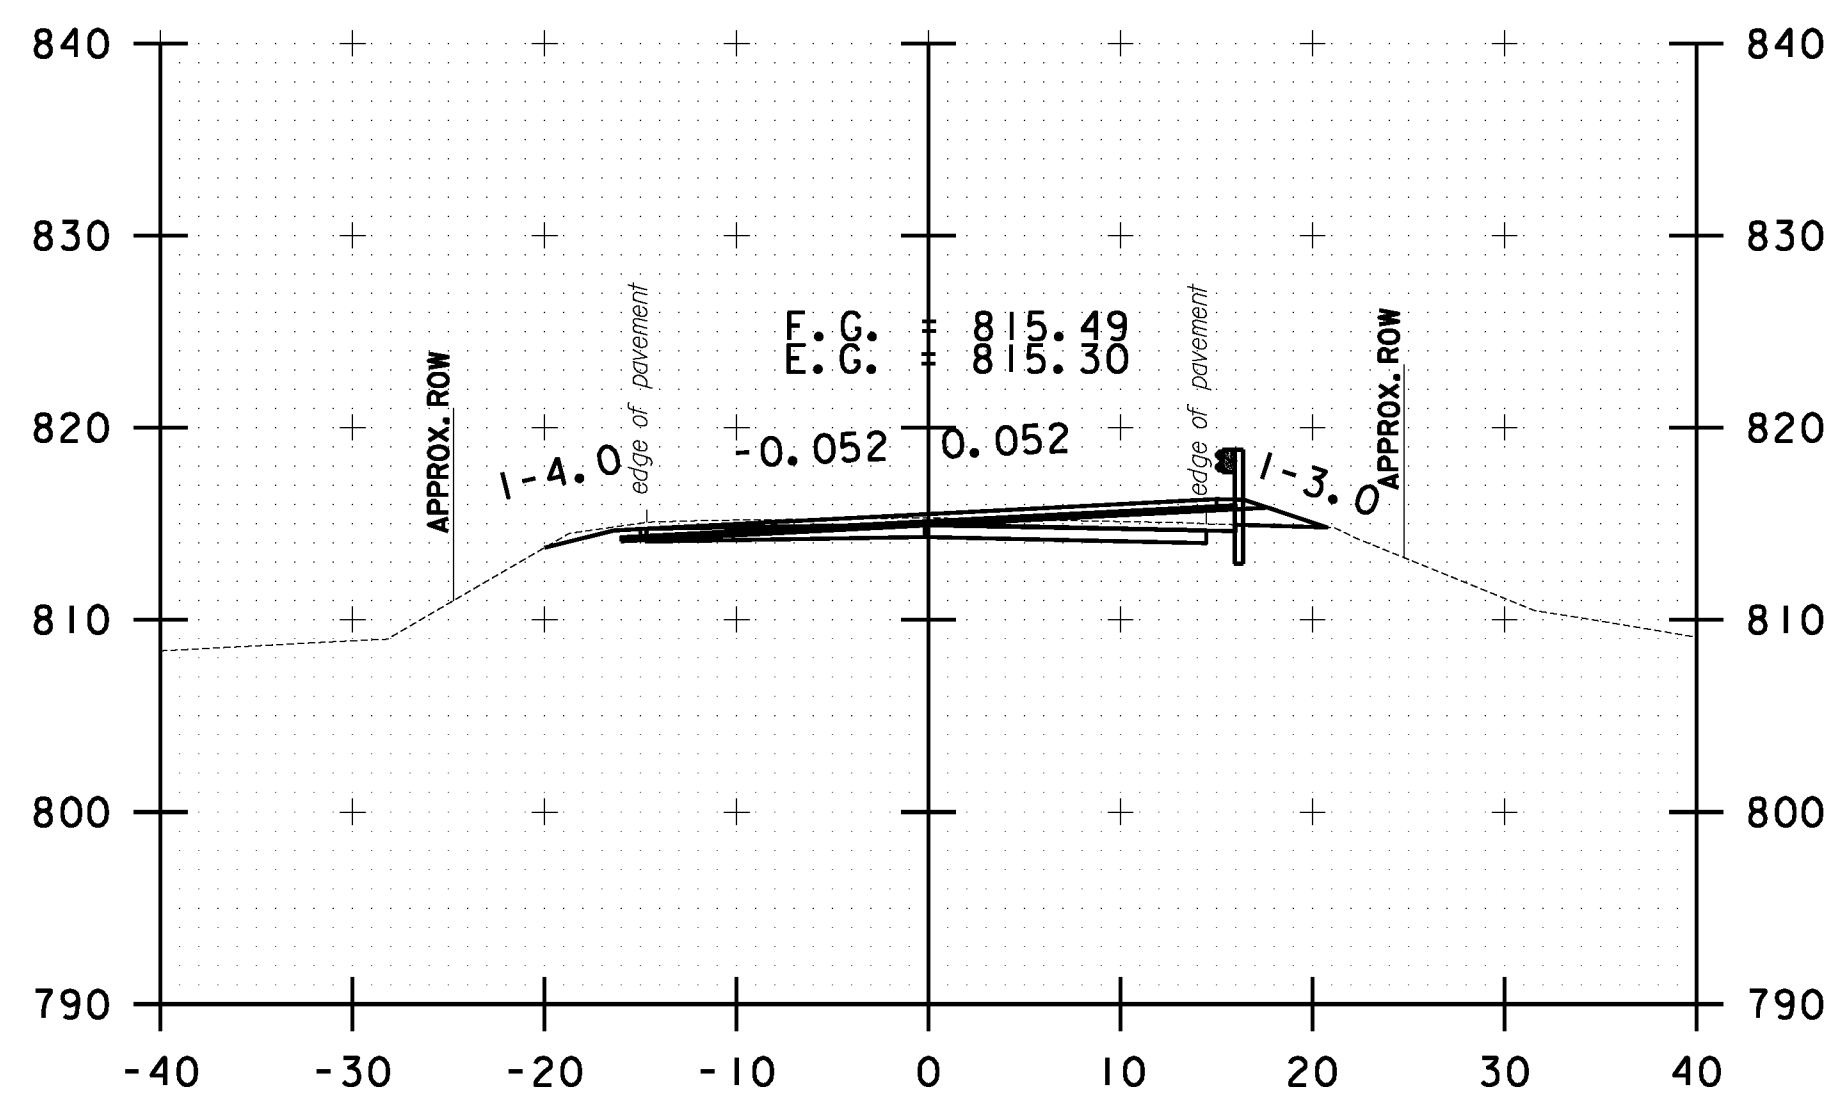


29+50.00

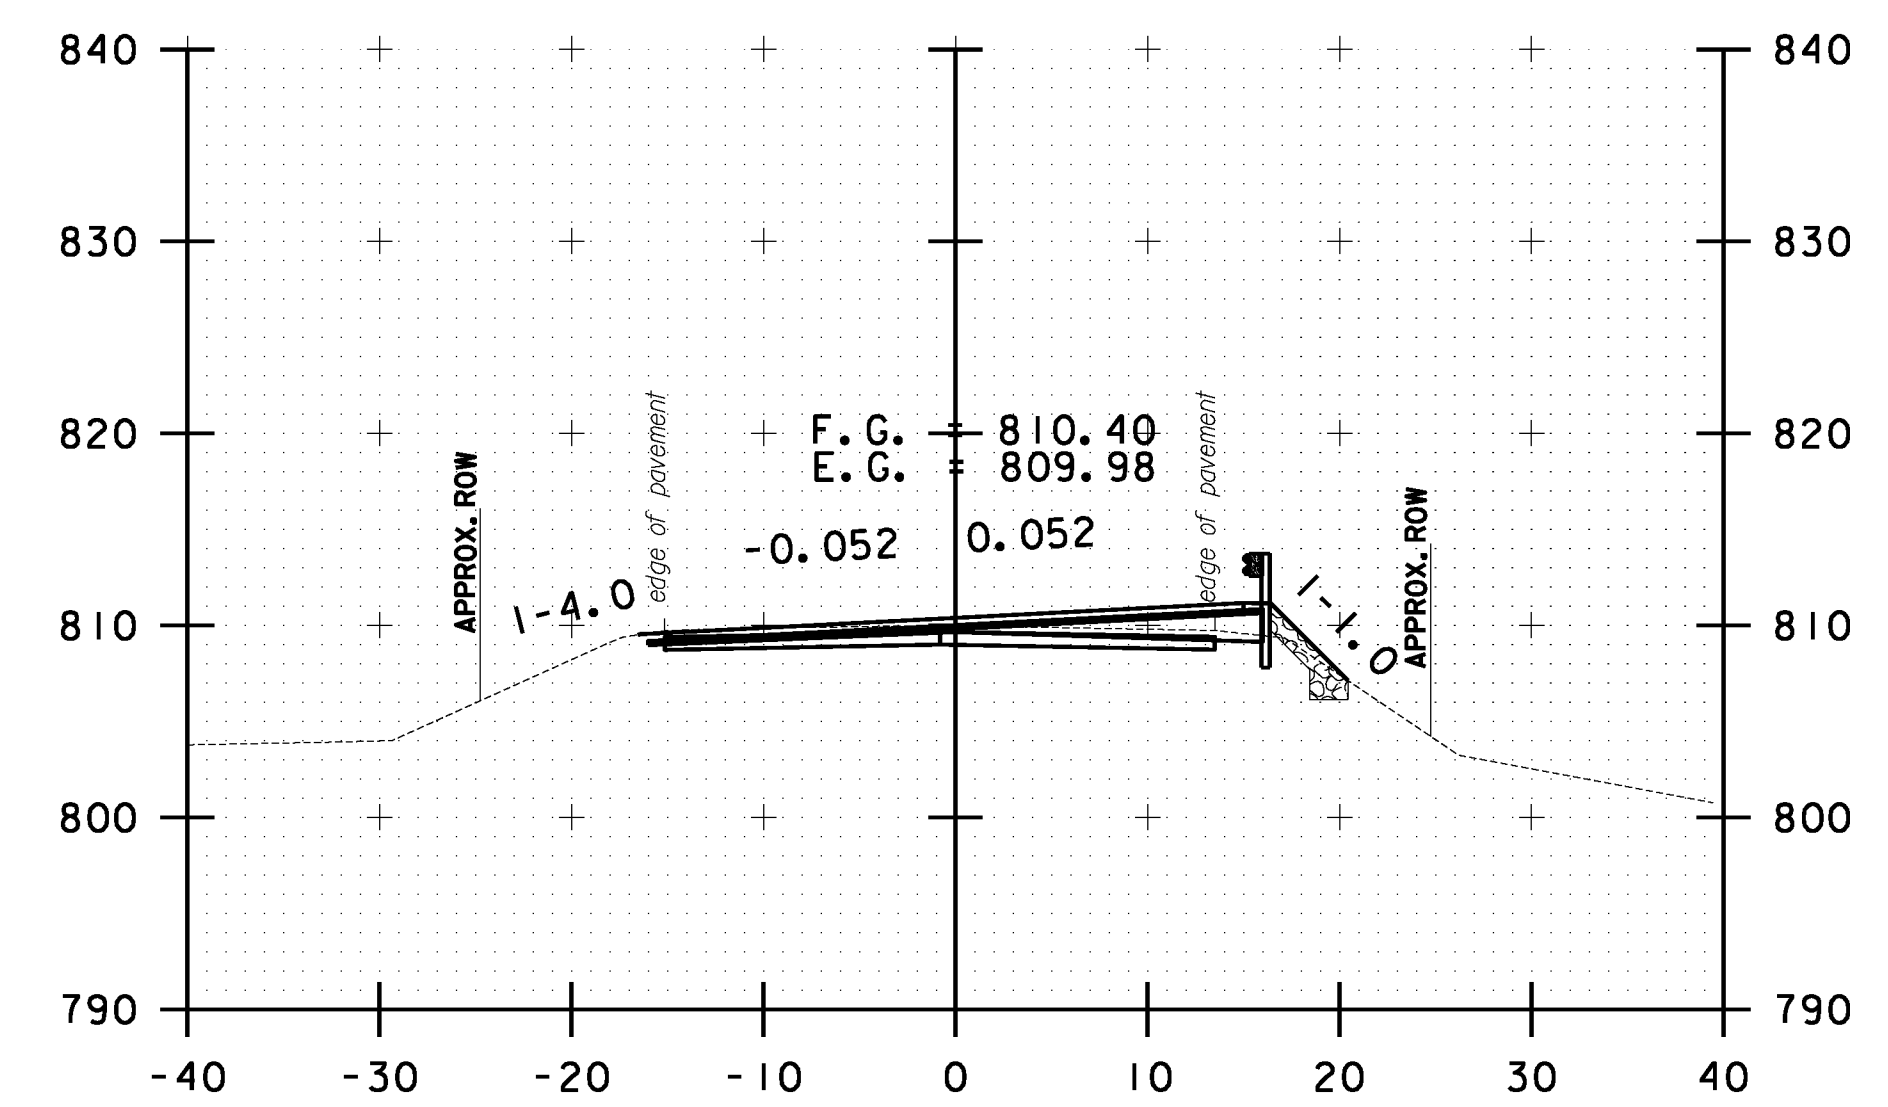

31+00.00

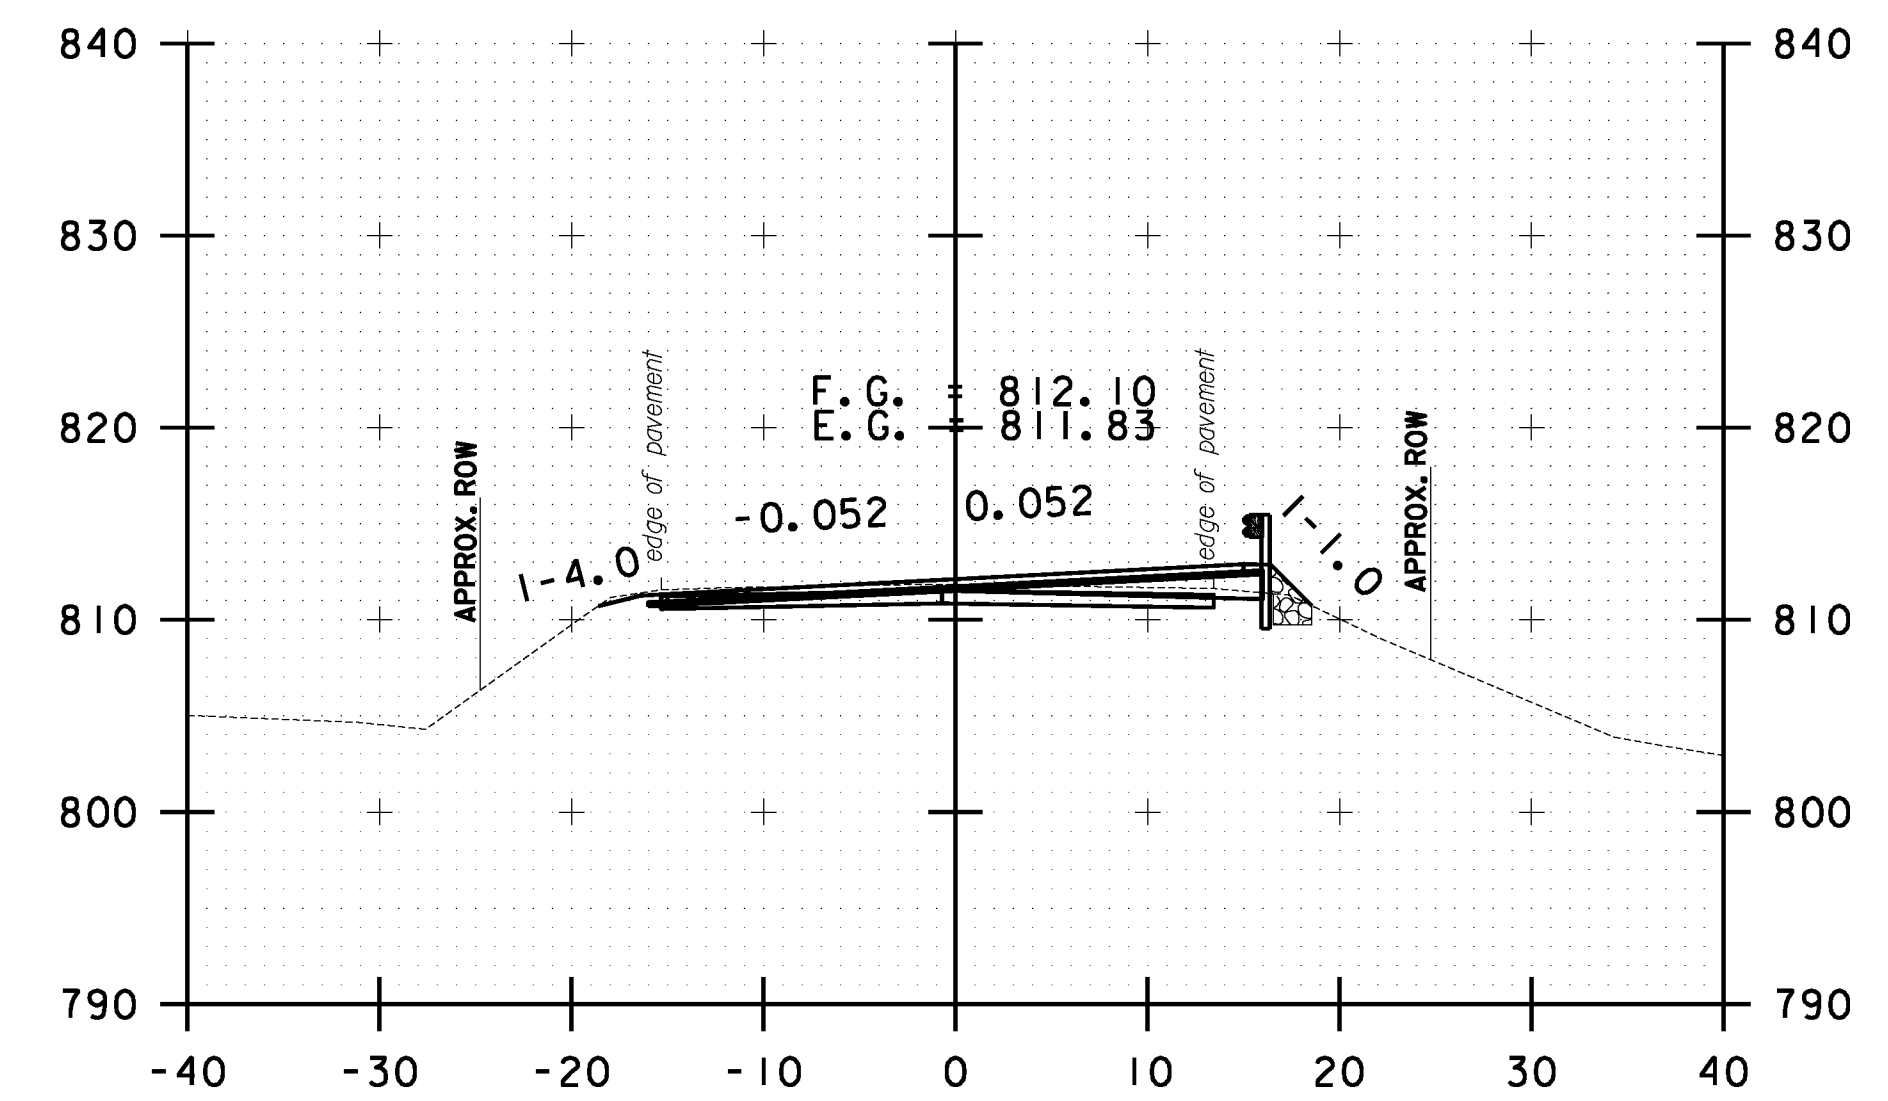

30+50.00

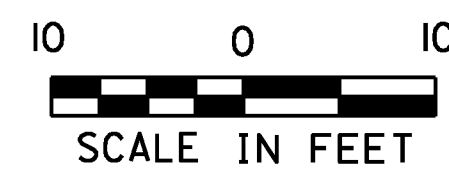

**STOCKBRIDGE  
CROSS SECTION  
SHEET #10**

PROJECT NAME: STOCKBRIDGE-BETHEL	
PROJECT NUMBER: STP 2910(1)	
FILE NAME: z10b214_stock_xc.dgn	PLOT DATE: 3/17/2014
PROJECT LEADER: D.E.G.	DRAWN BY: W.G.P.
DESIGNED BY: L.M.B.	CHECKED BY: J.P.S.
IPARM FILE: z10b214xs10.1	SHEET 223 OF 397