




FILE NAME = V:\P\c\ass\ANY\X2\22425\CADD\MSTN\10b214\_stock\_wcdgn  
 DATE/TIME = 3/17/2014  
 USER = 4916

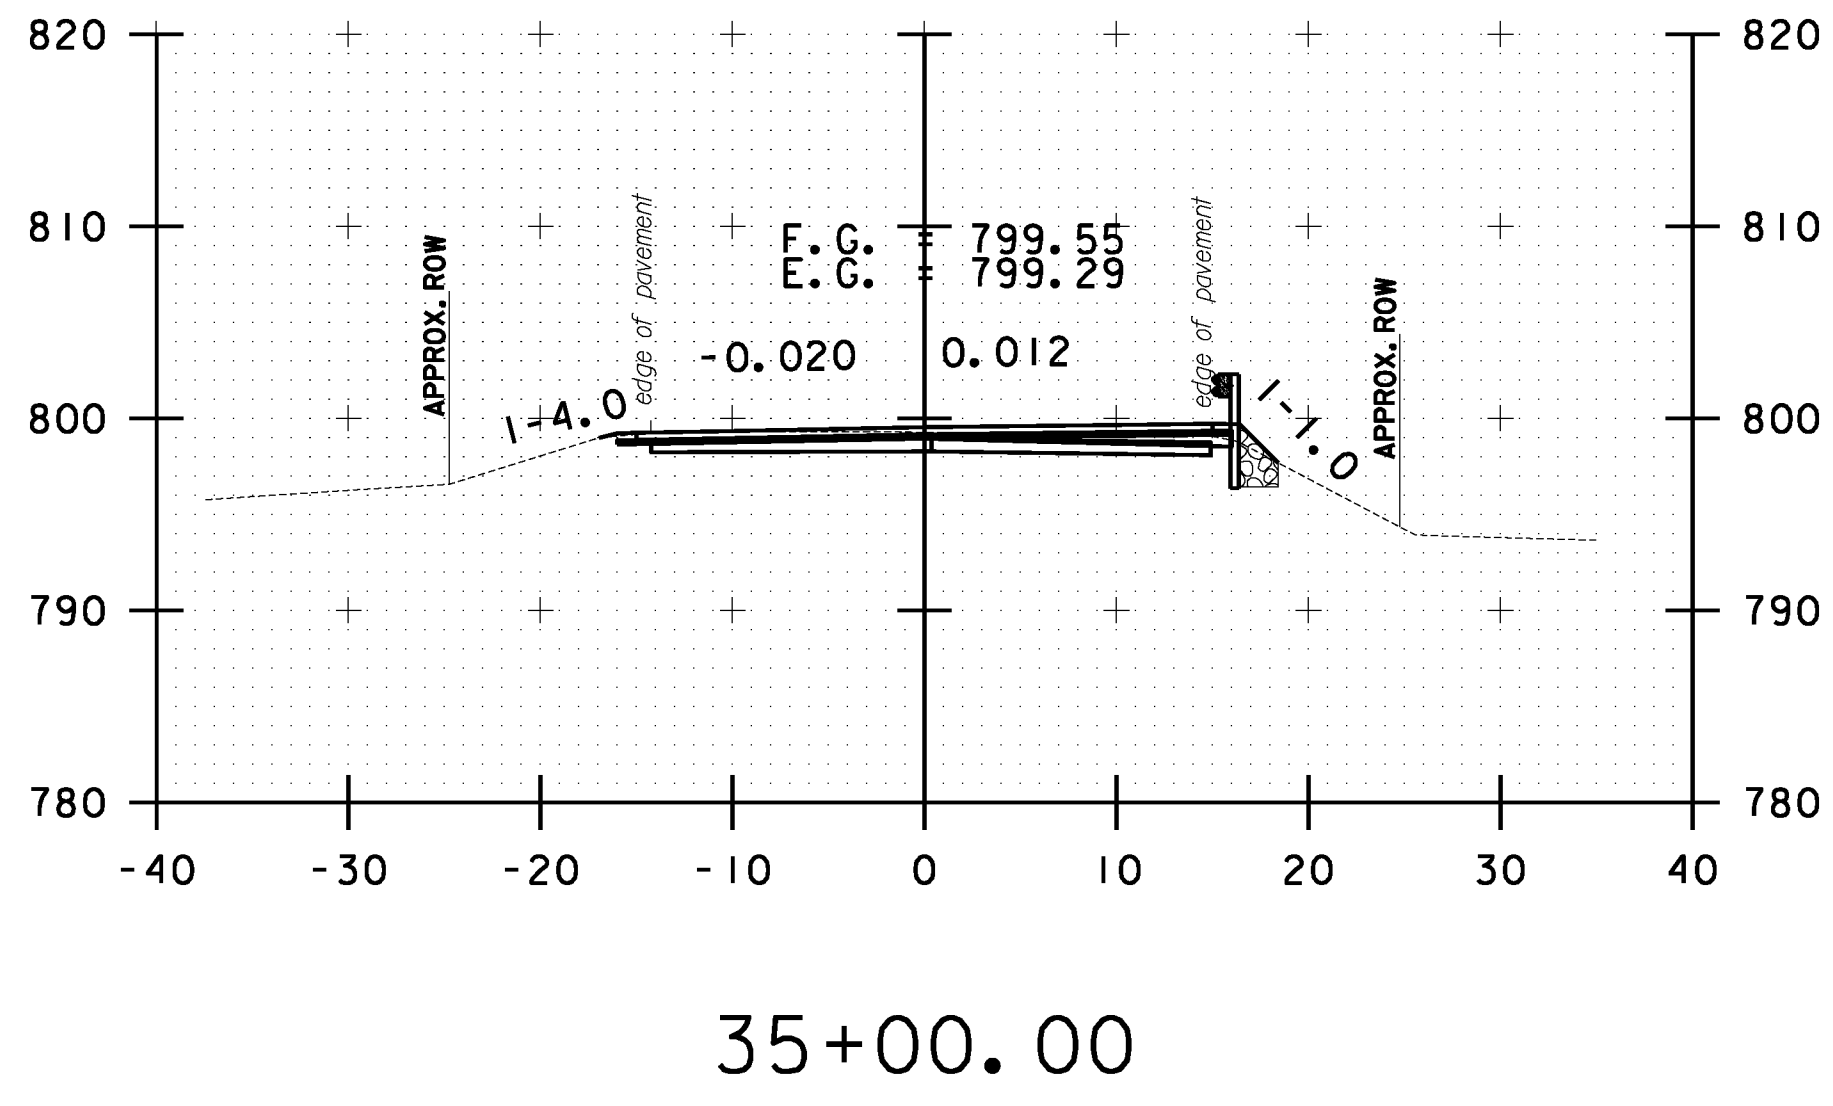


35+00.00

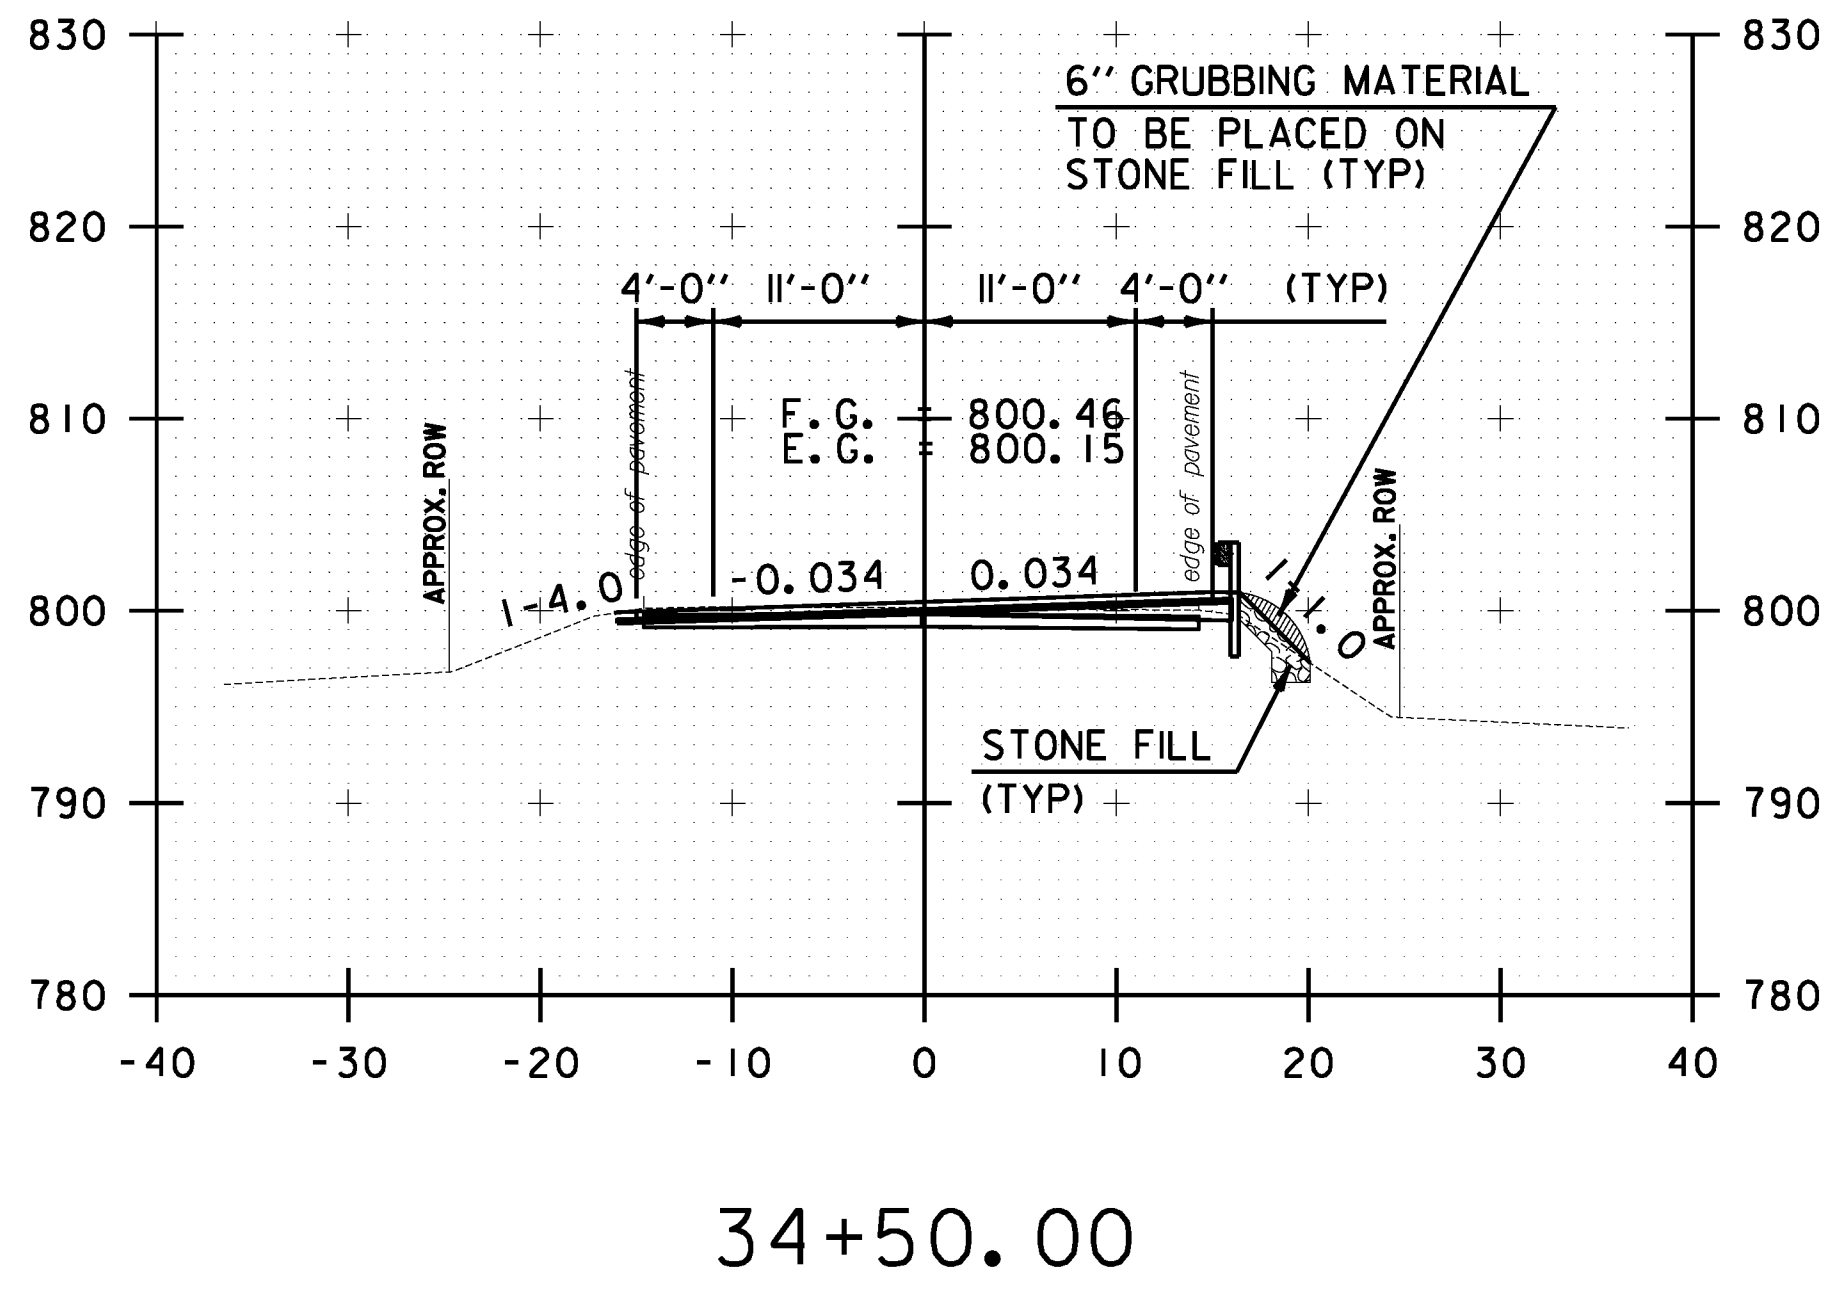


34+50.00

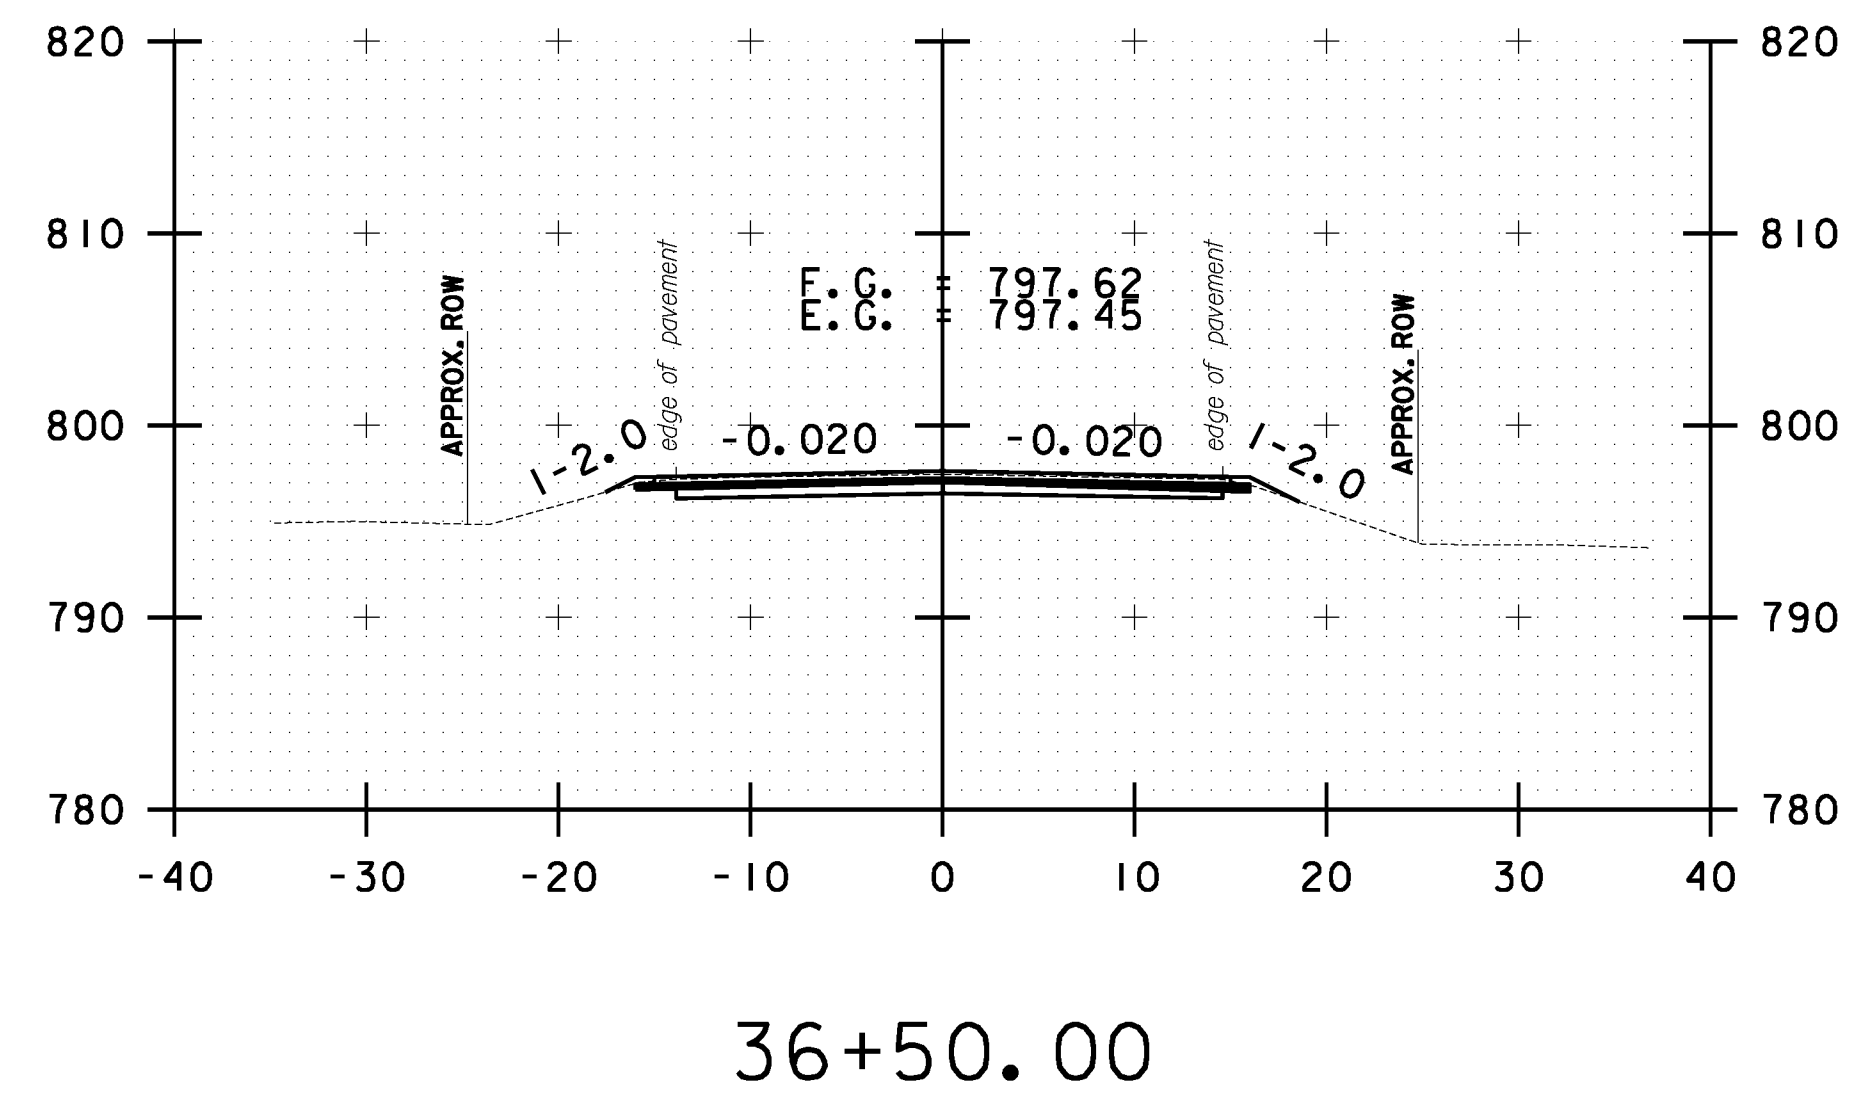


36+50.00

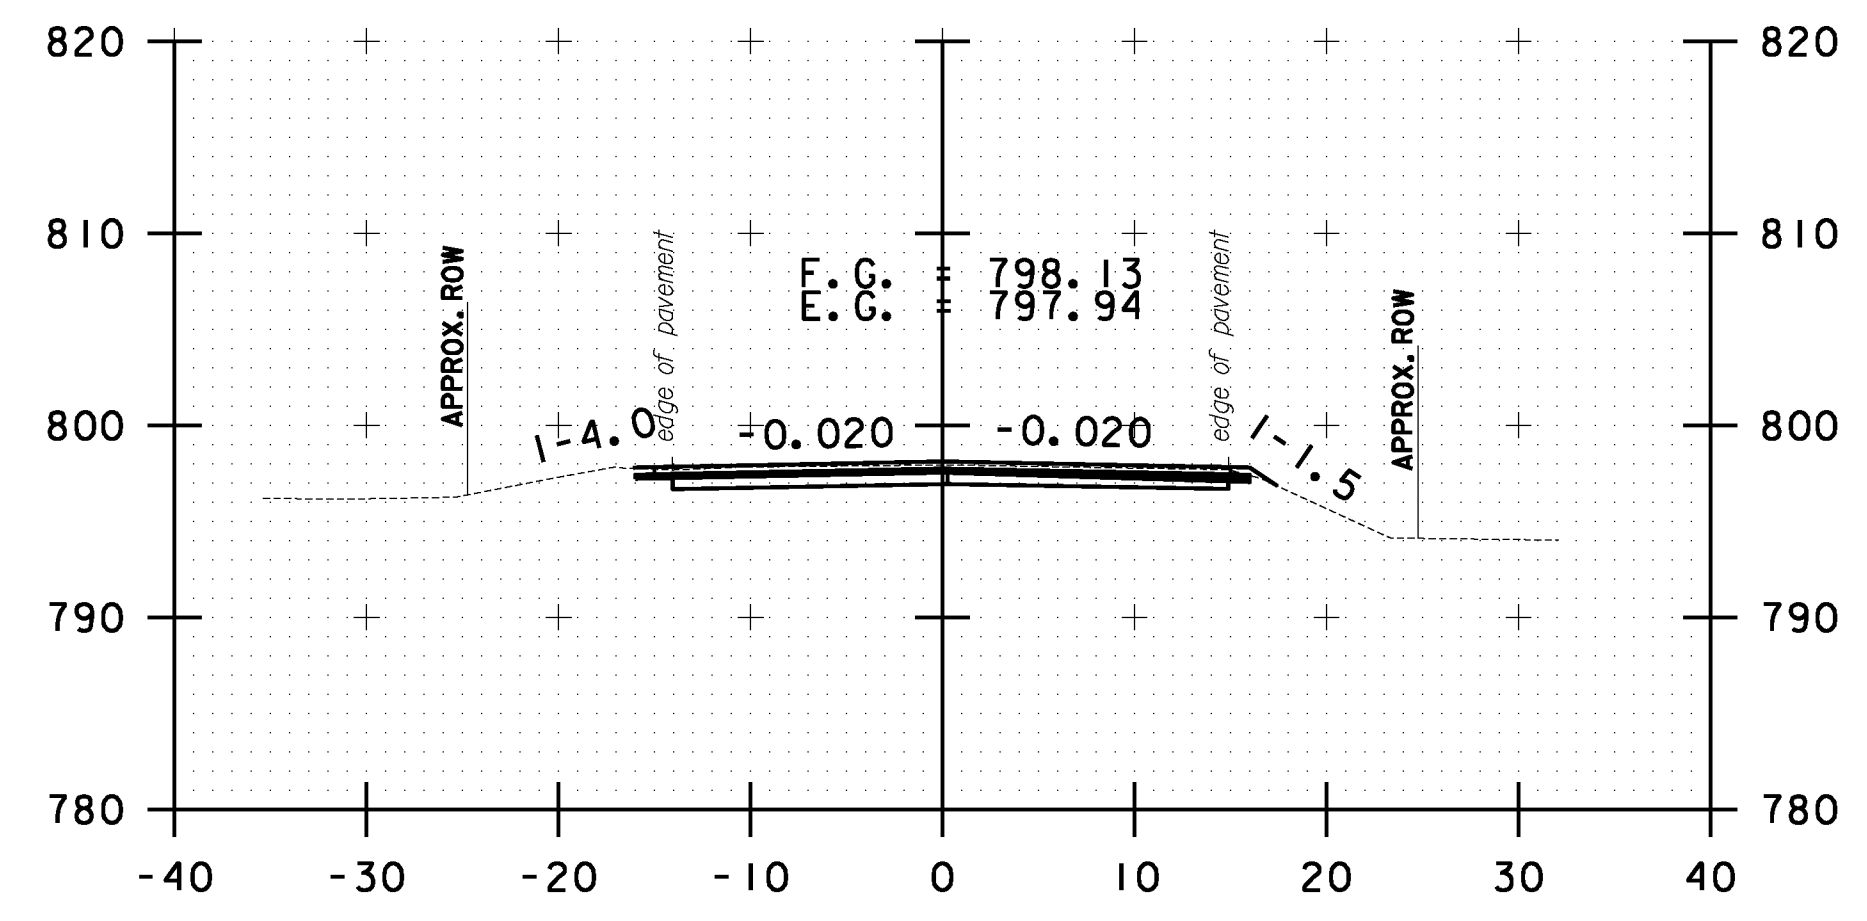


36+00.00

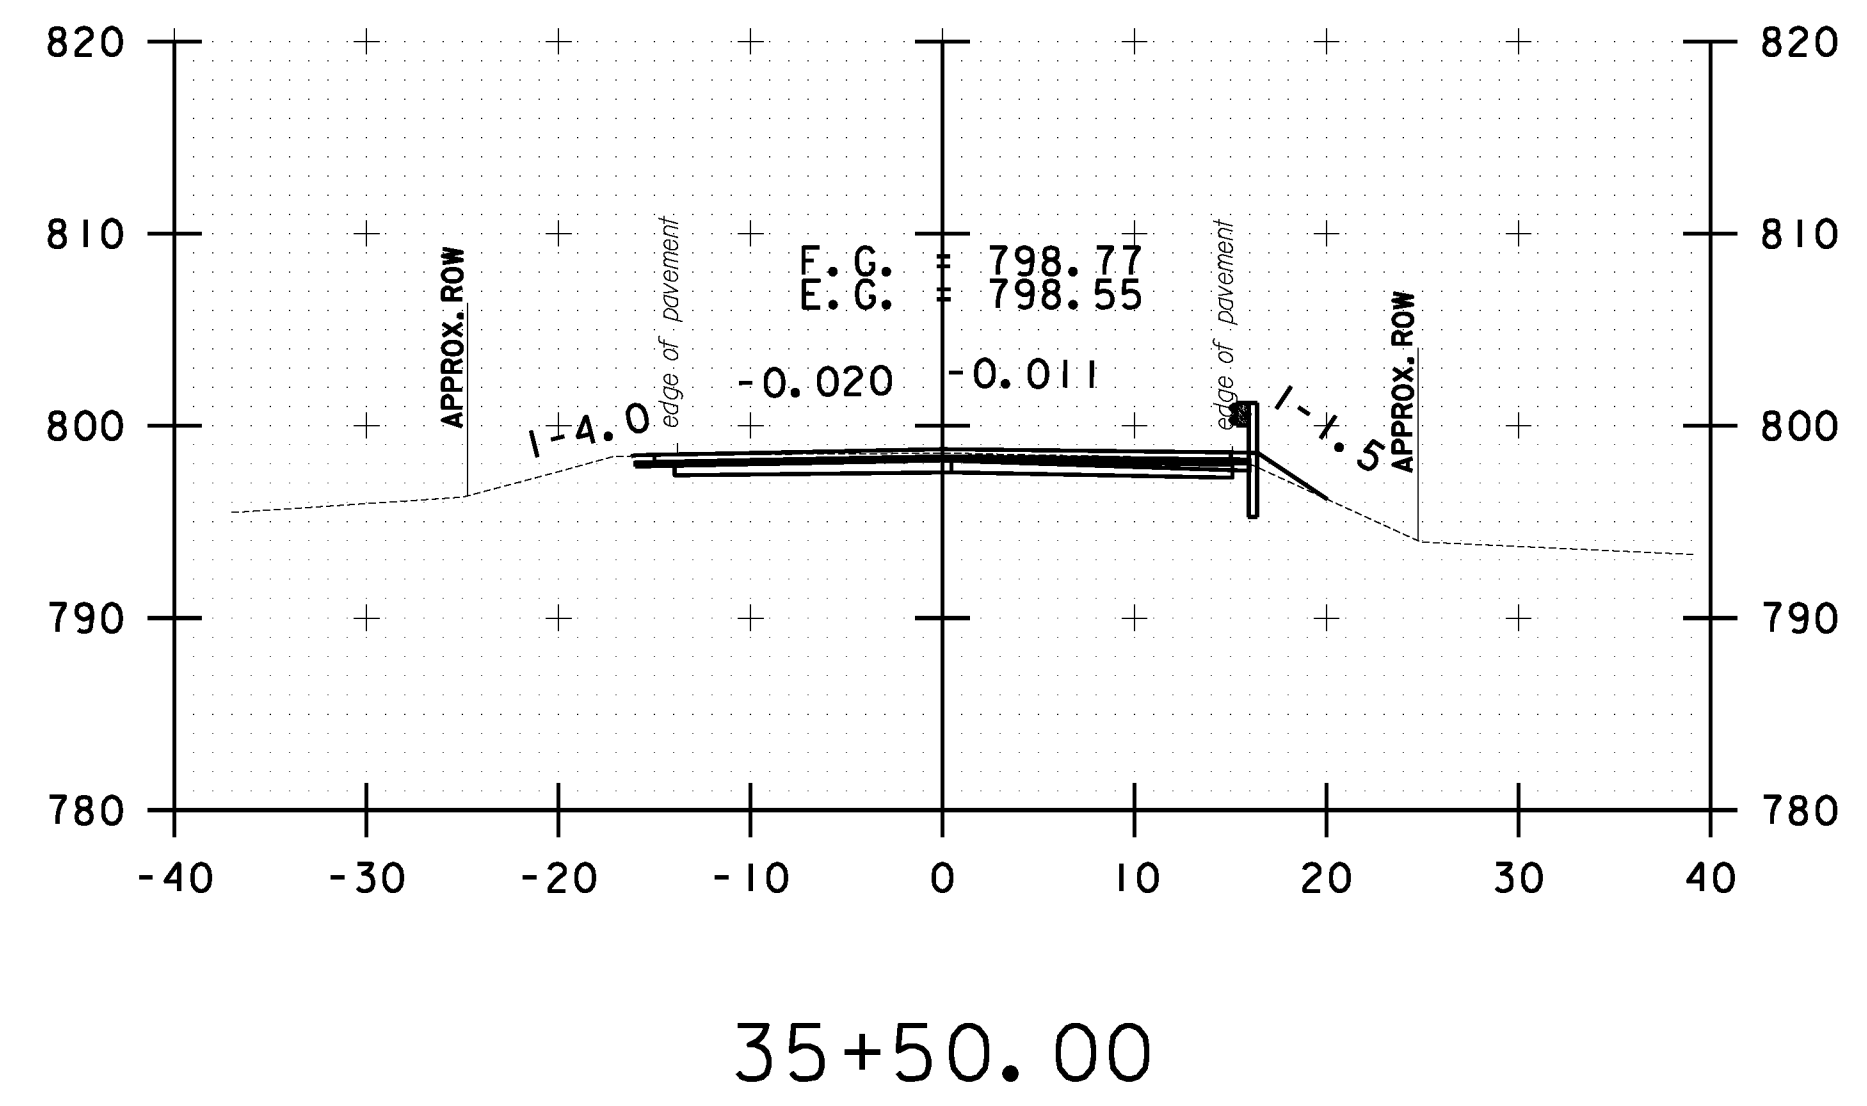


35+50.00

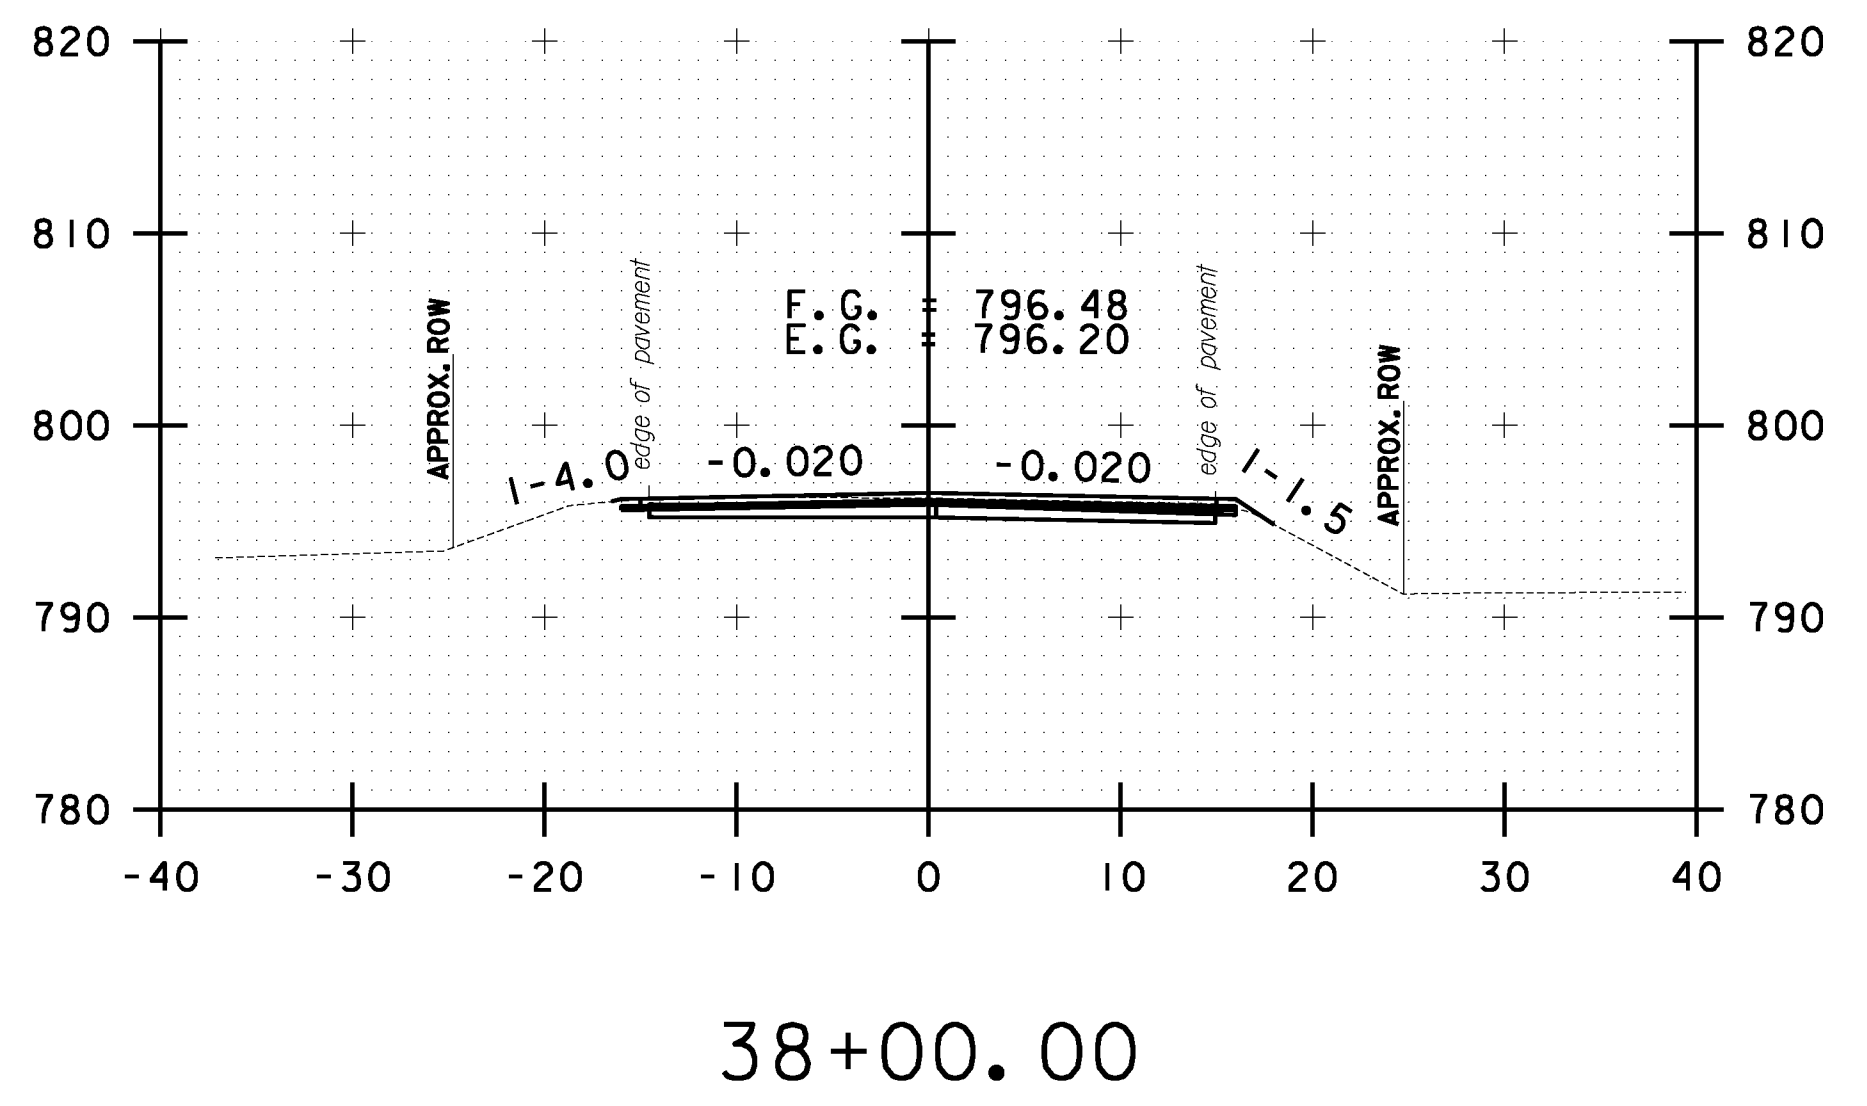


38+00.00

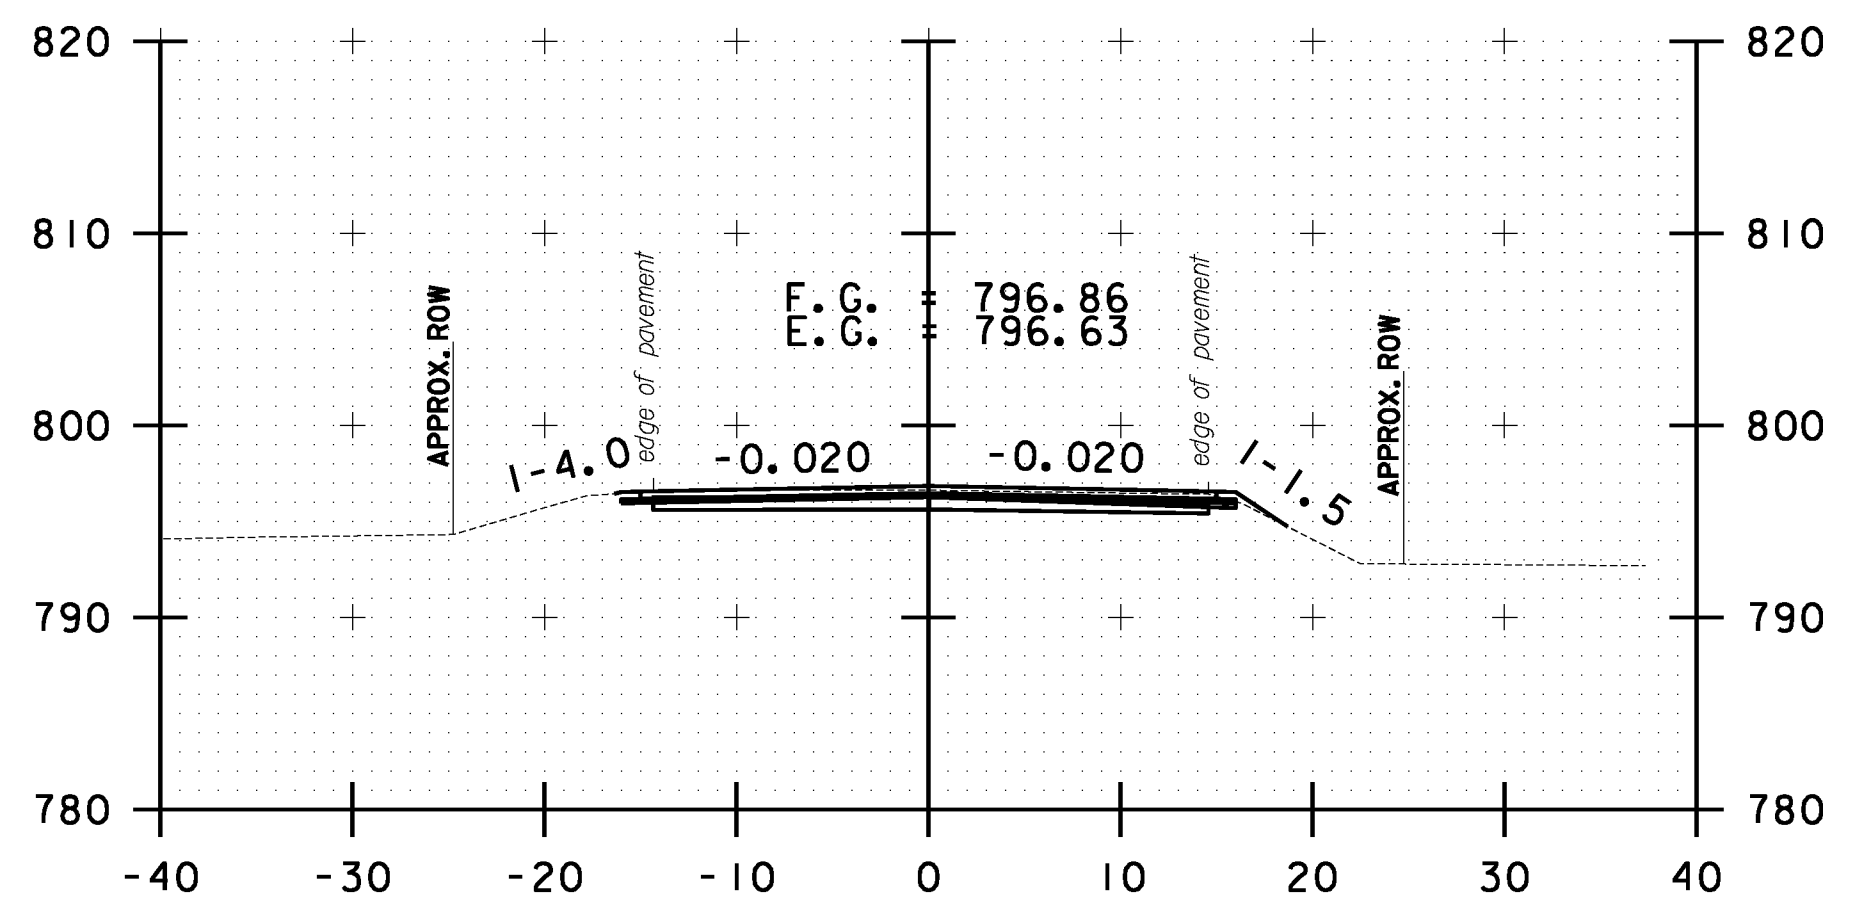

37+50.00

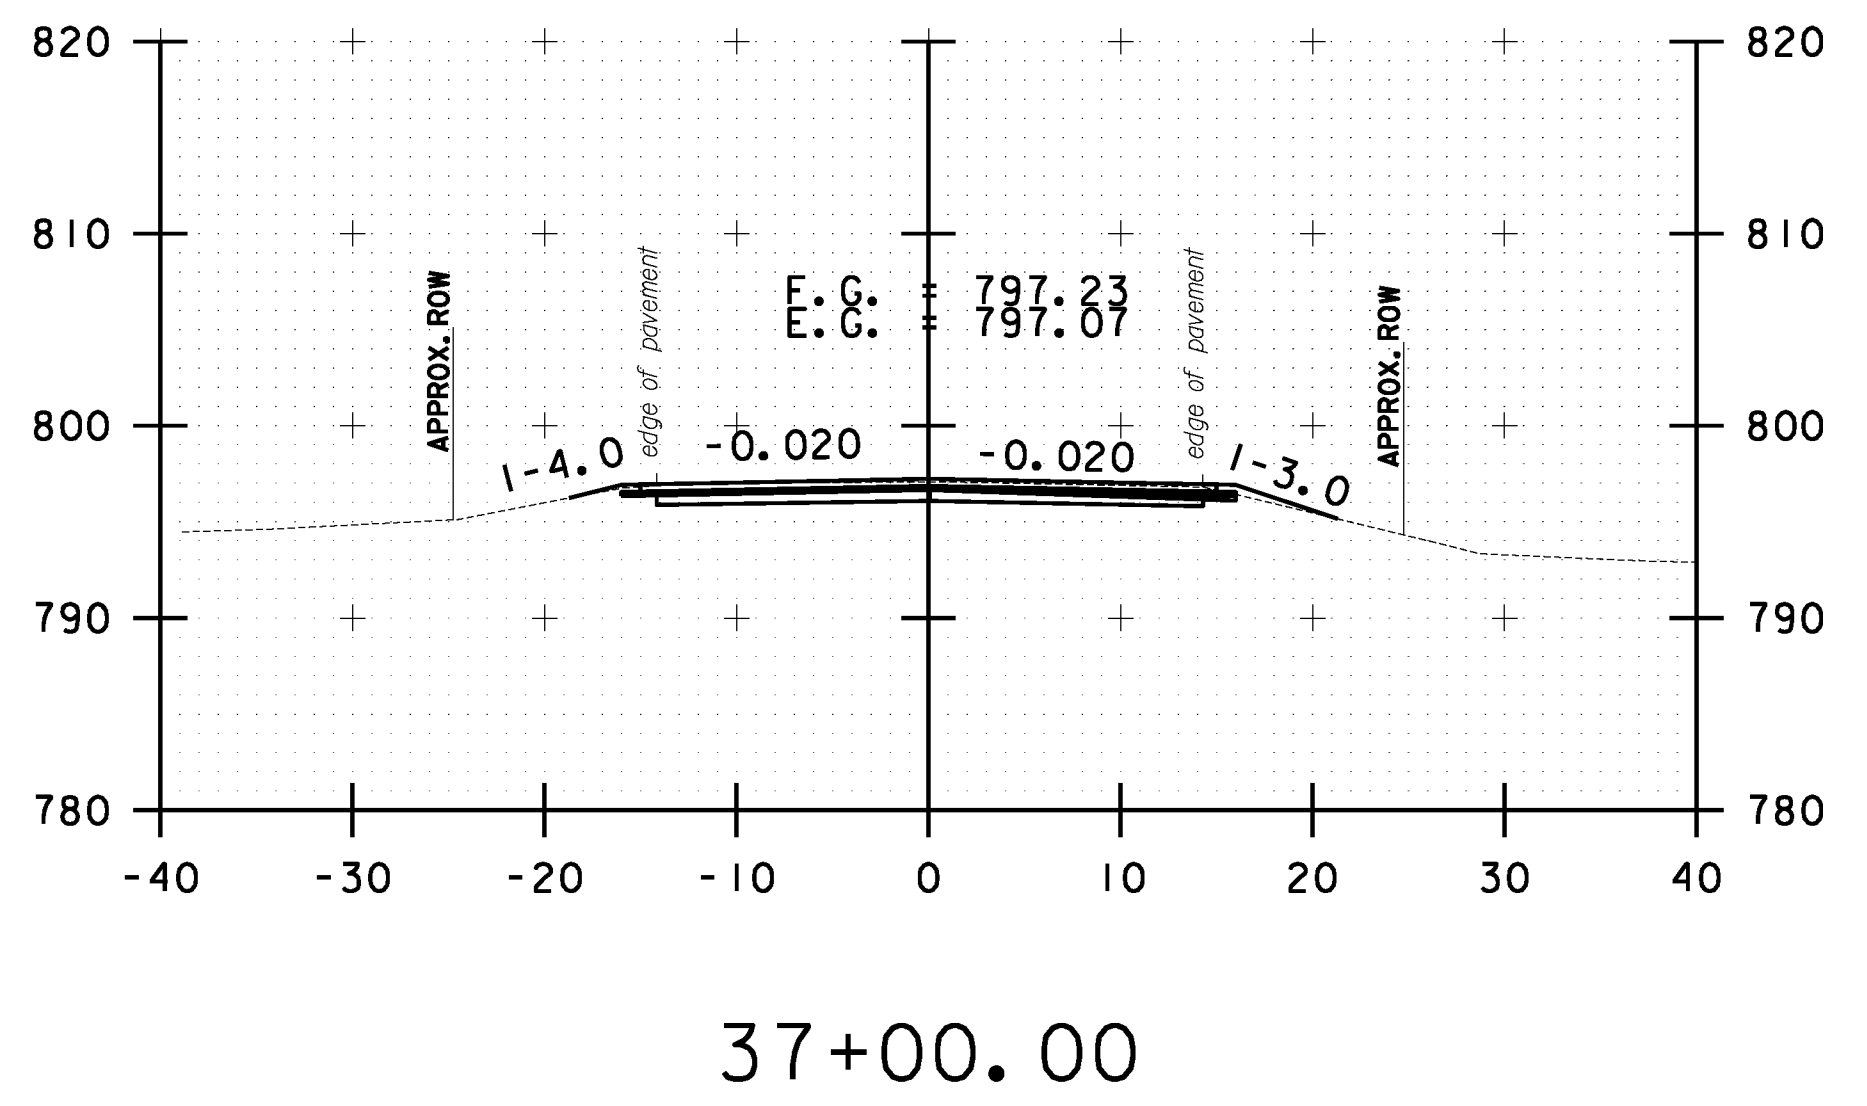

37+00.00

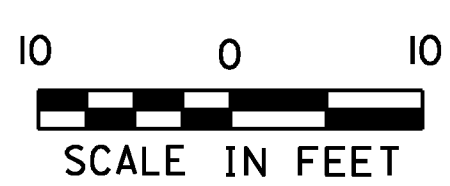

**STOCKBRIDGE  
 CROSS SECTION  
 SHEET #12**

PROJECT NAME: STOCKBRIDGE-BETHEL	PLOT DATE: 3/17/2014
PROJECT NUMBER: STP 2910(1)	DRAWN BY: W.G.P.
FILE NAME: z10b214_stock_xc.dgn	CHECKED BY: J.P.S.
DESIGNED BY: L.M.B.	SHEET 225 OF 397
IPARM FILE: z10b214xs12.1	