




FILE NAME = Y:\P\c\res\any\k2\22425\CADD\MSTN\10b214_stock.nc.dgn
 DATE/TIME = 3/17/2014
 USER = 4916

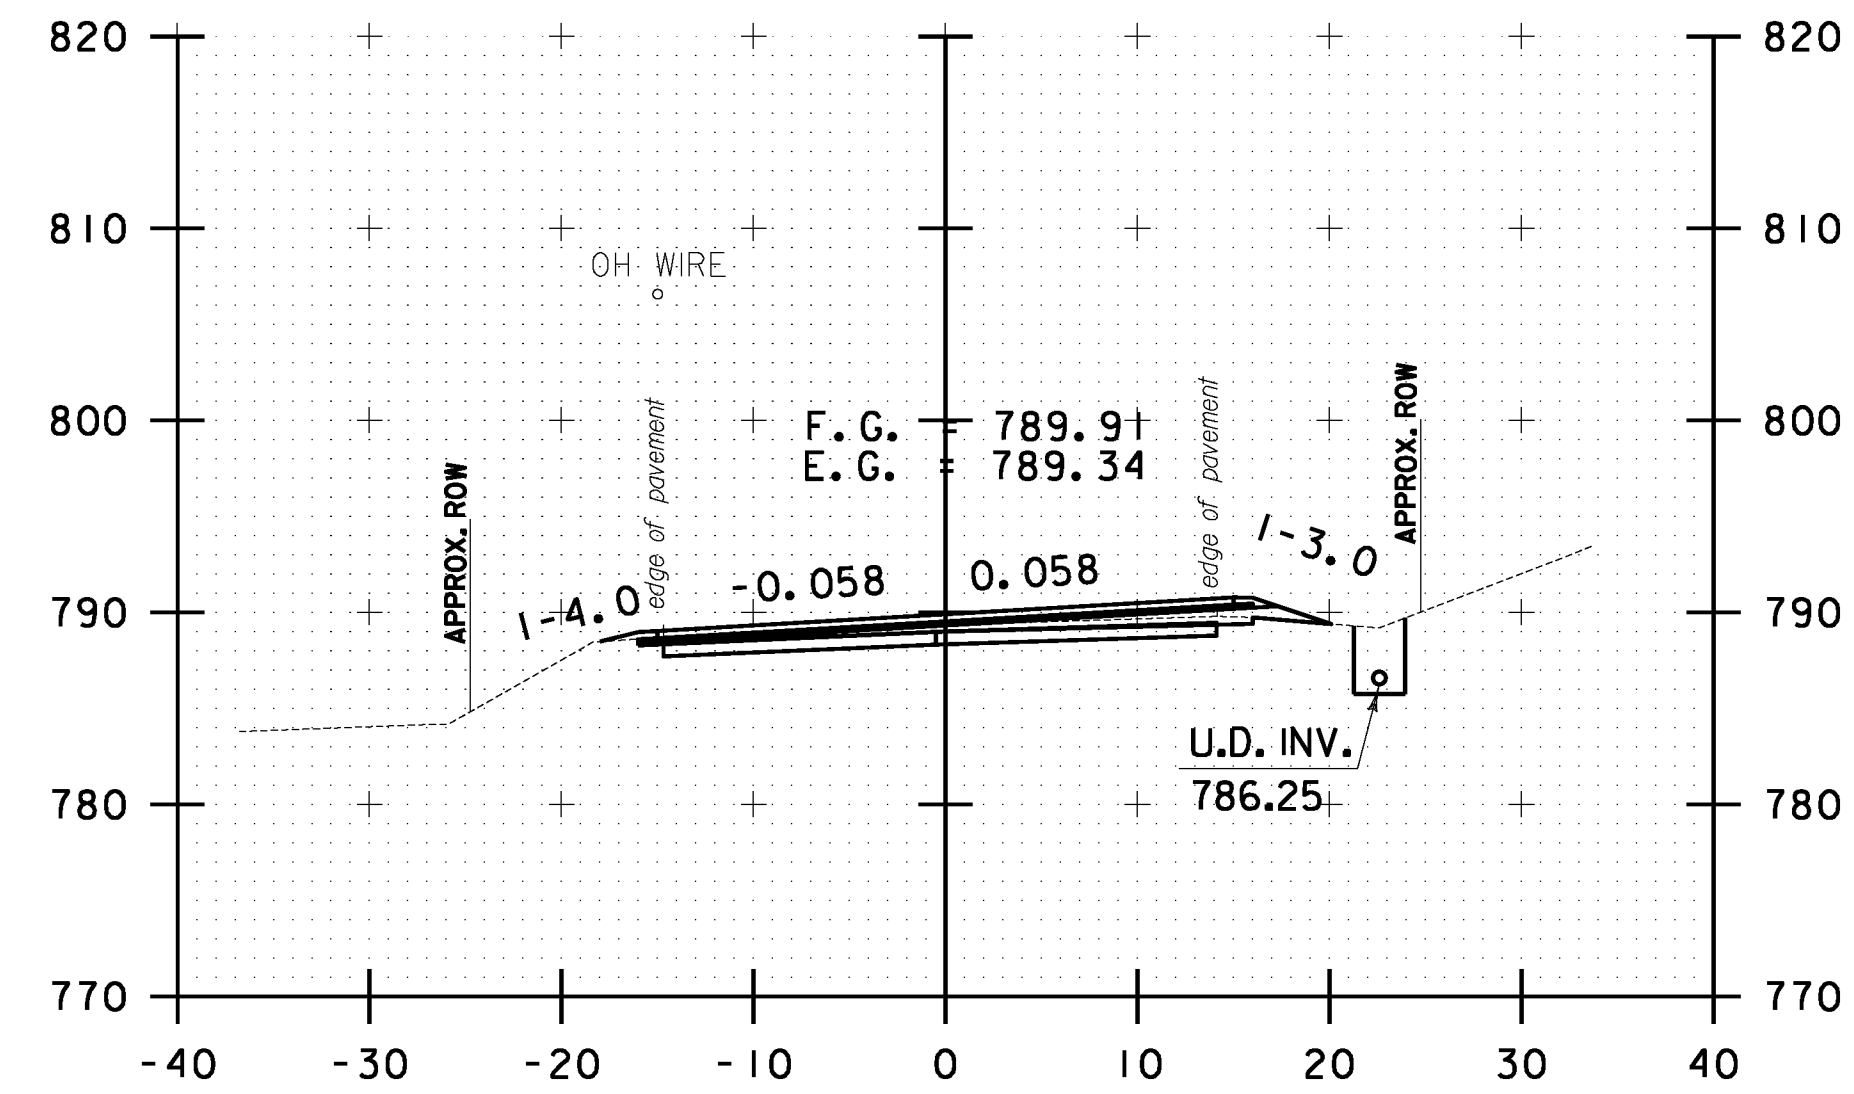


45+00.00

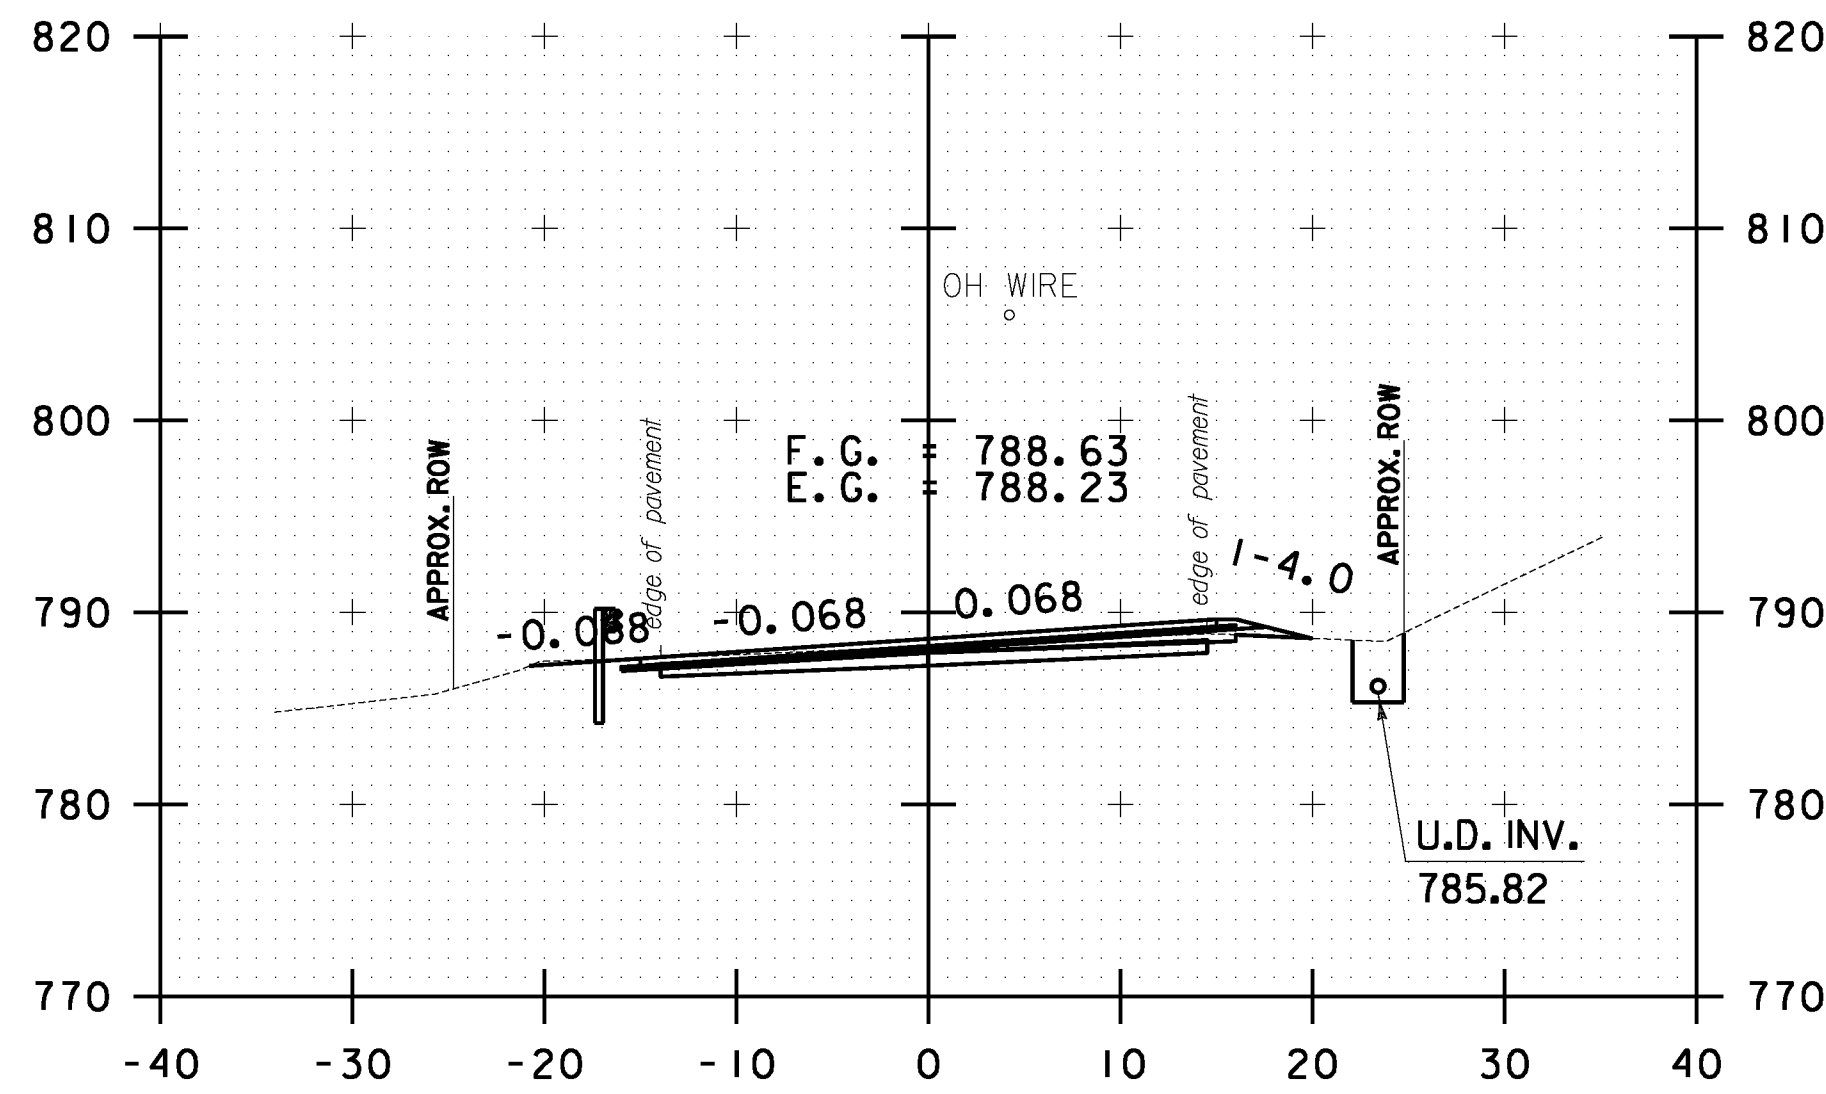


46+00.00

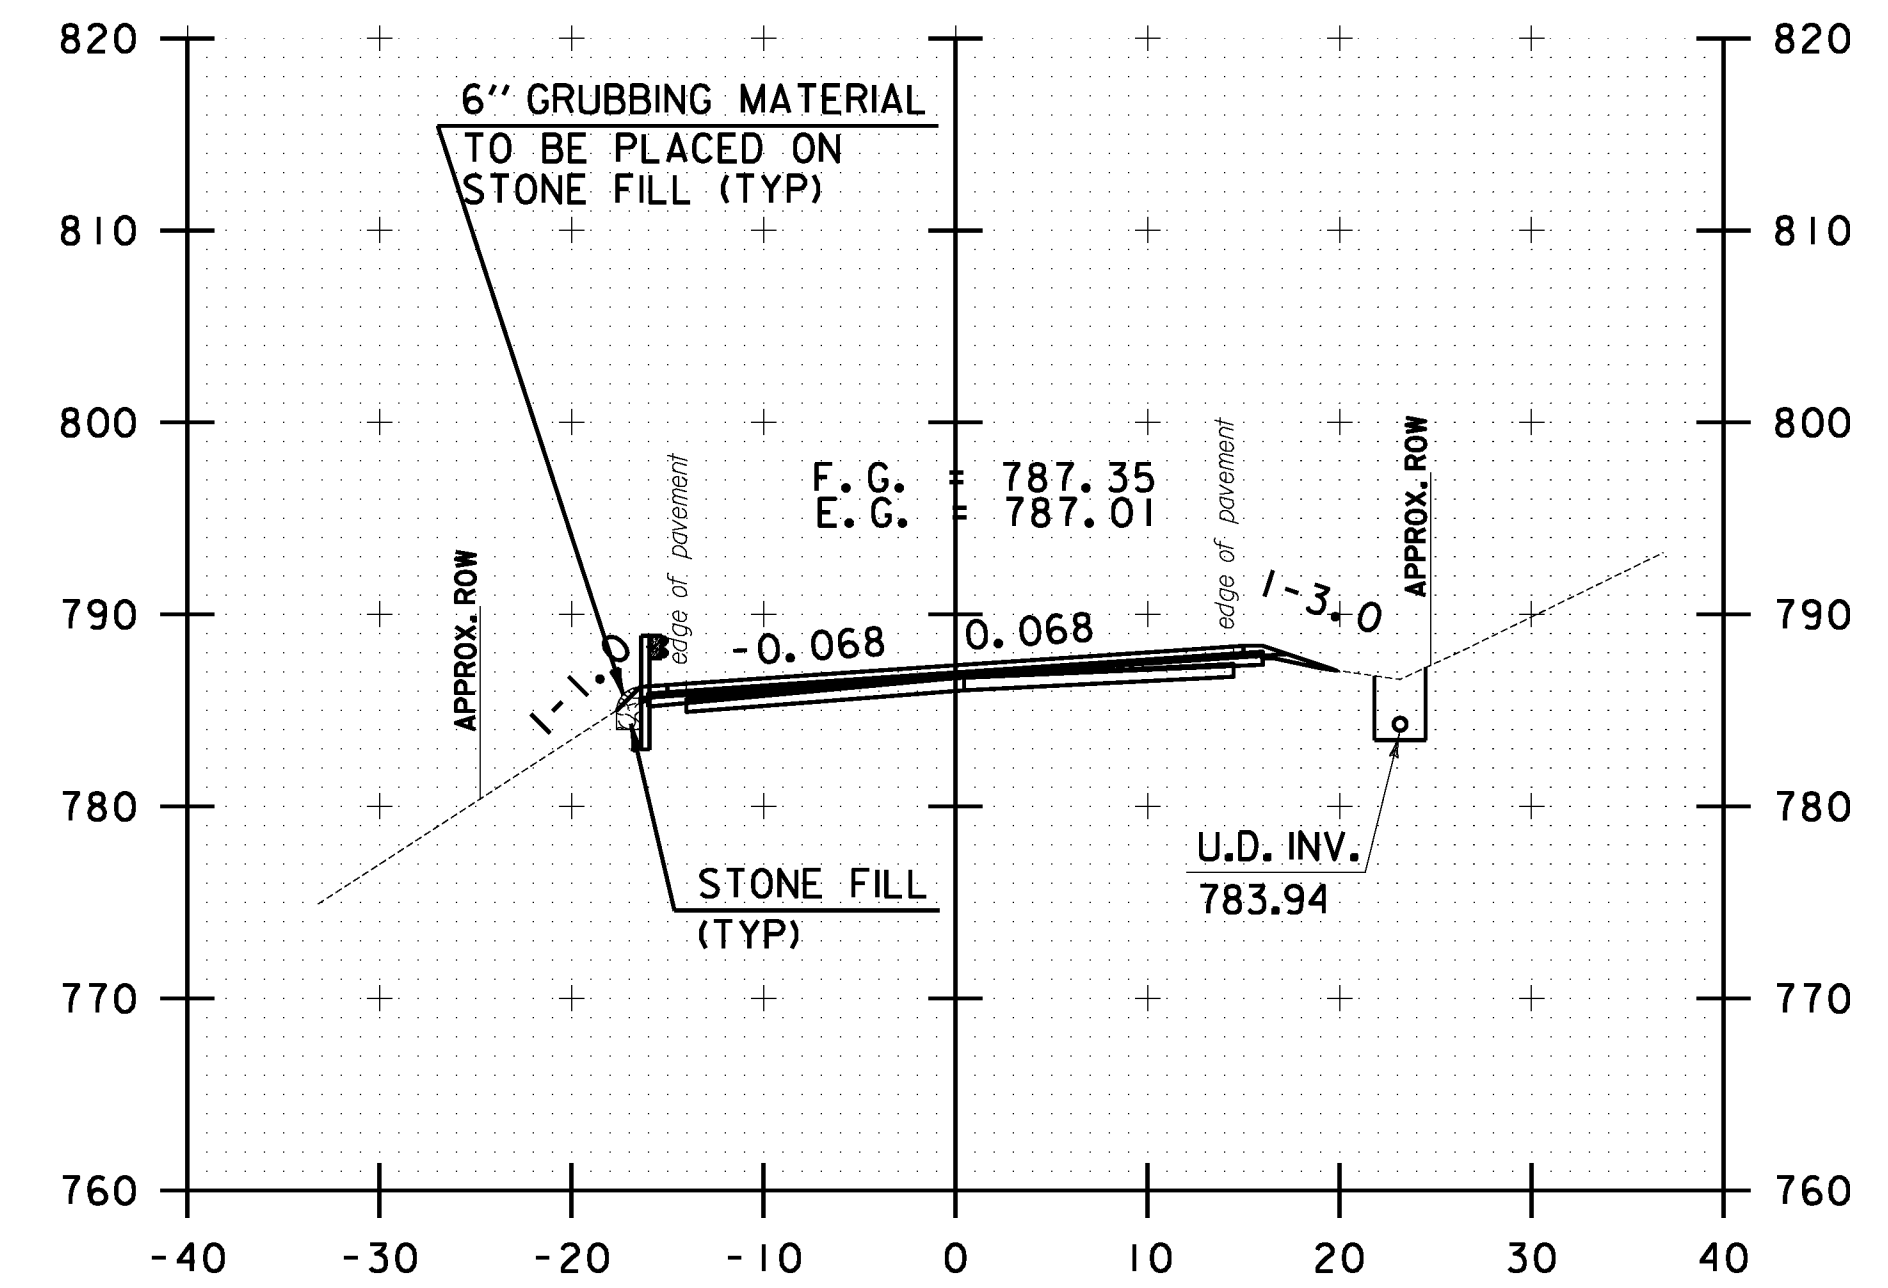


47+00.00

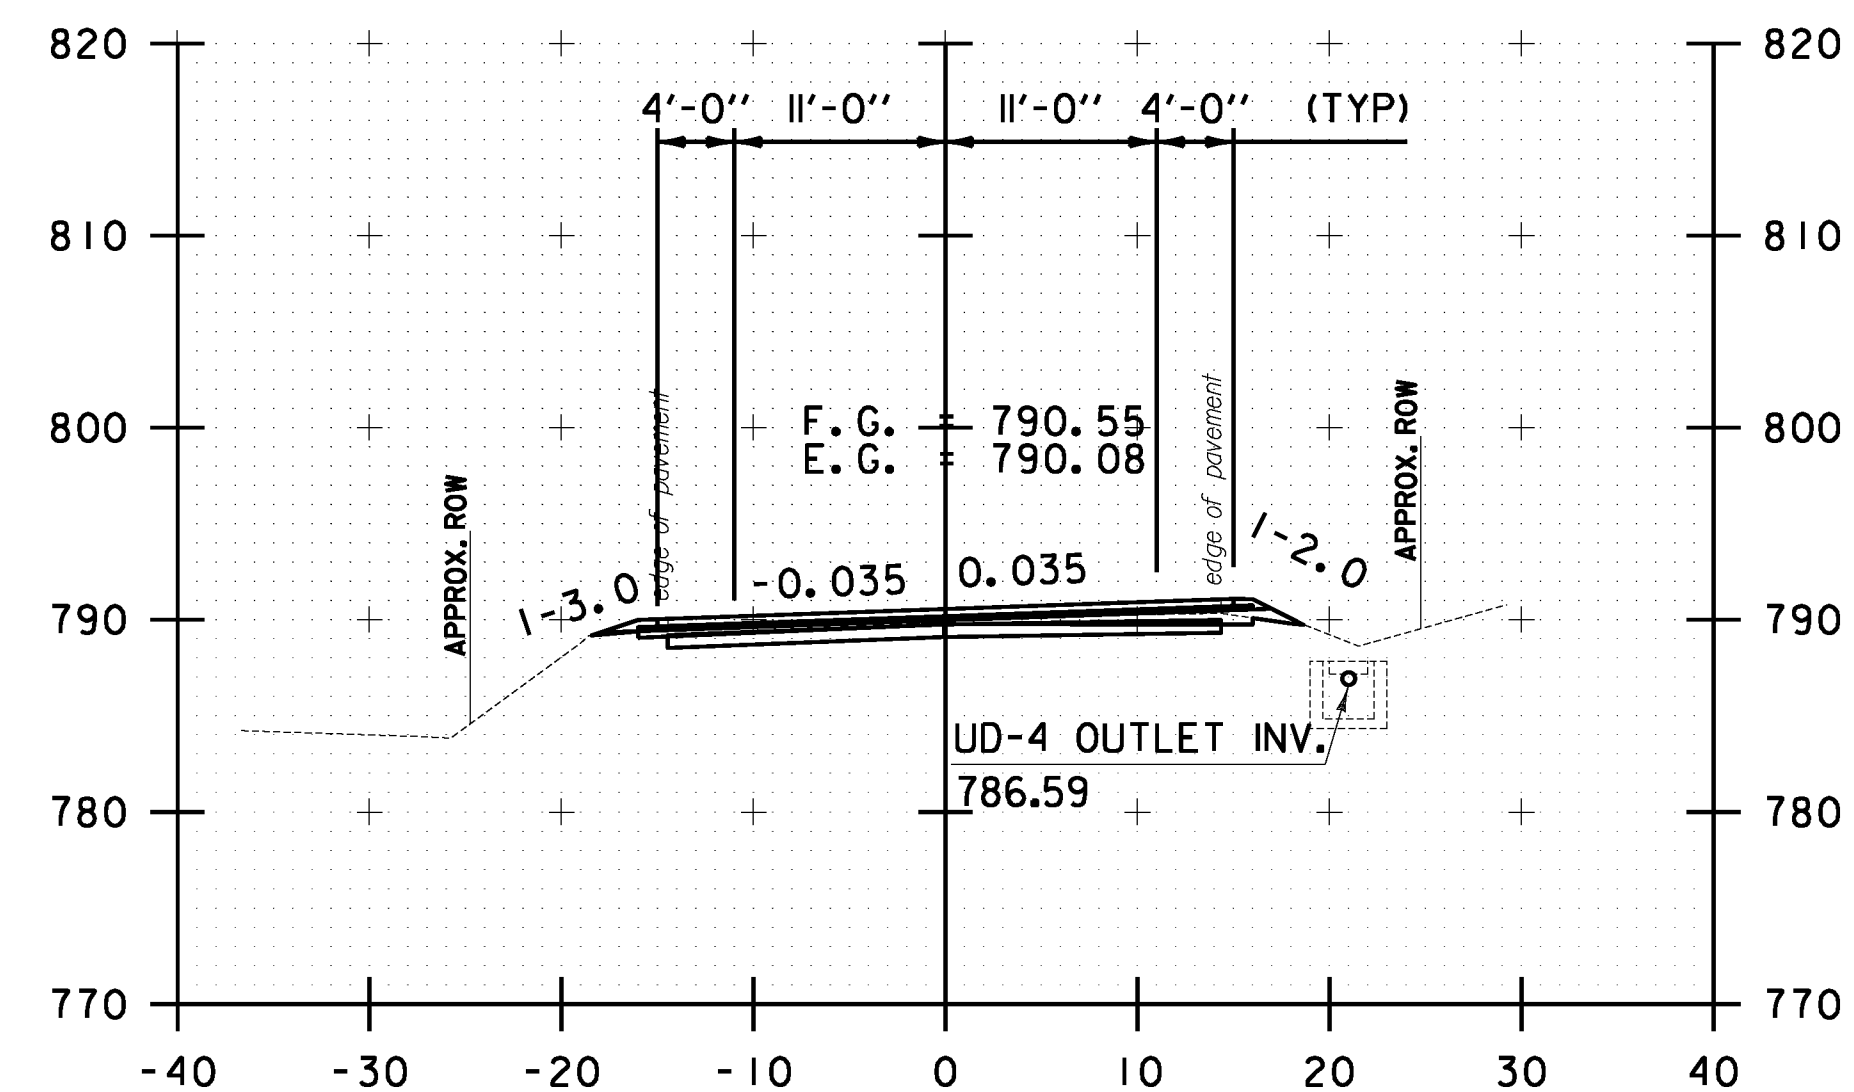


44+50.00

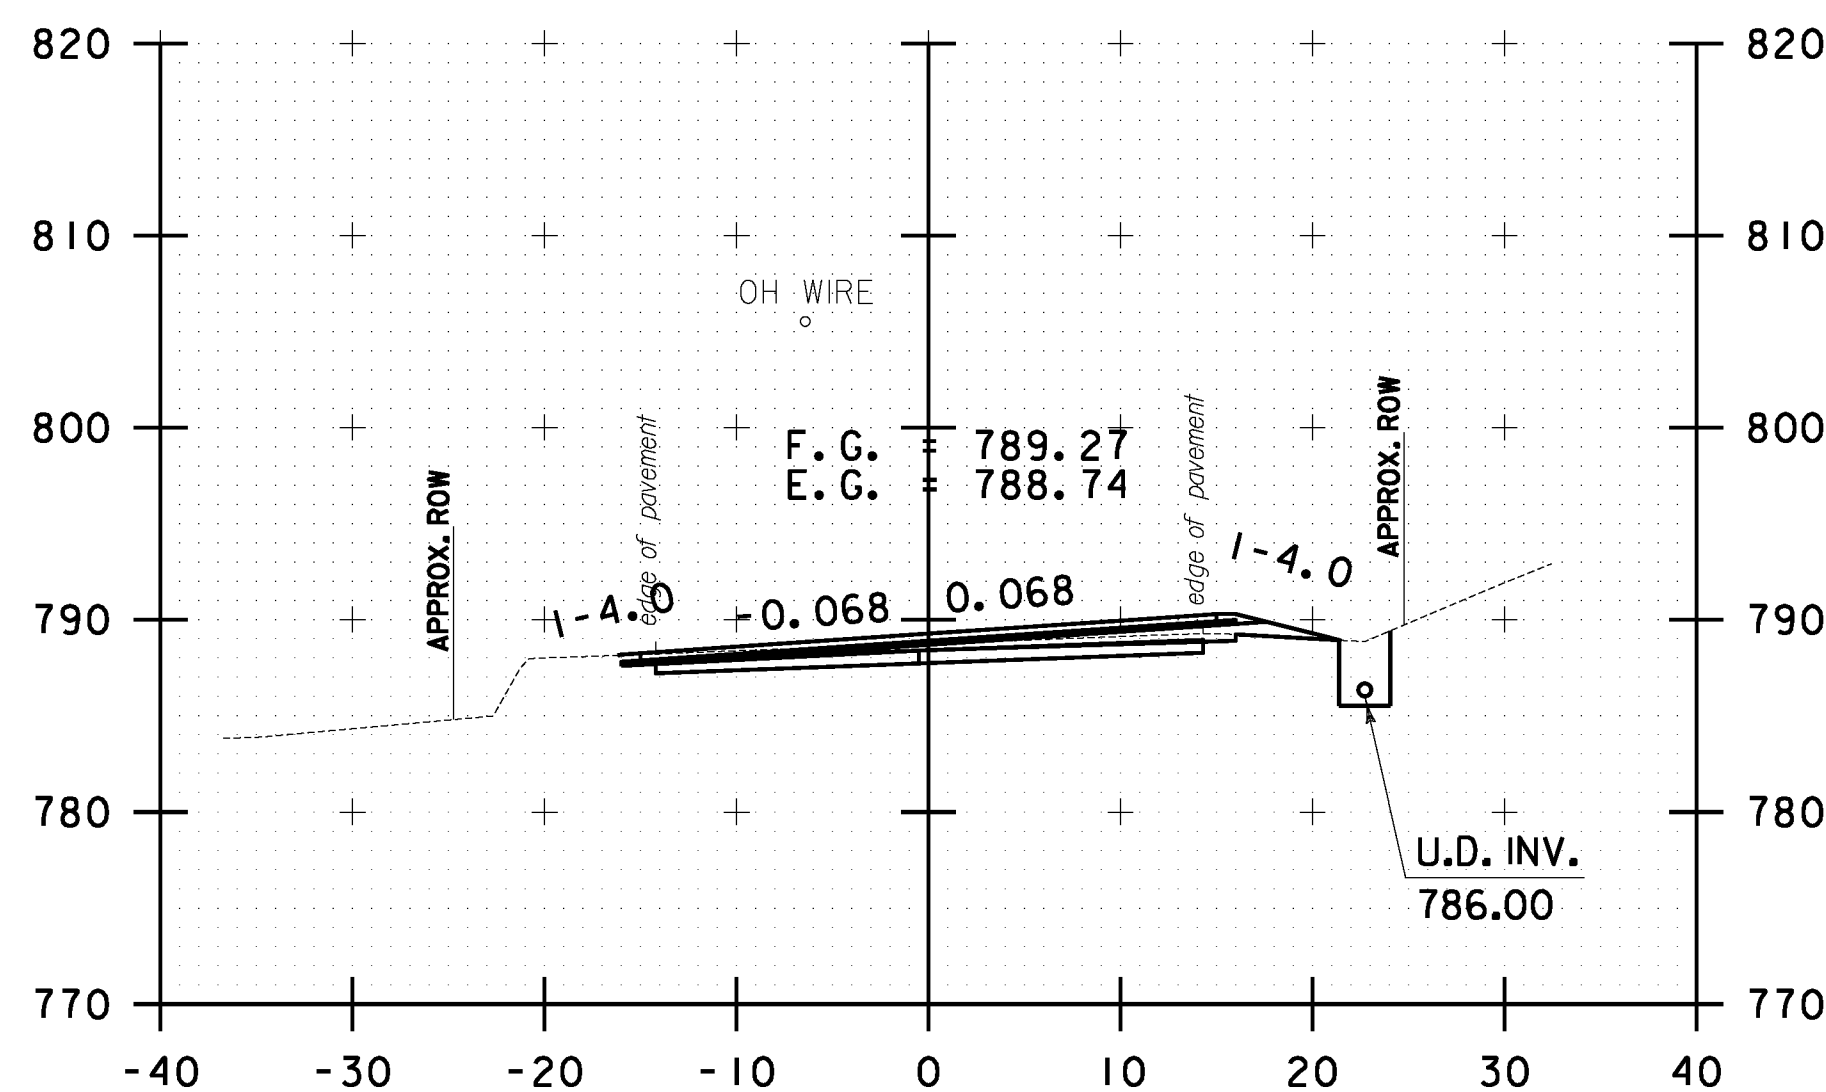

45+50.00

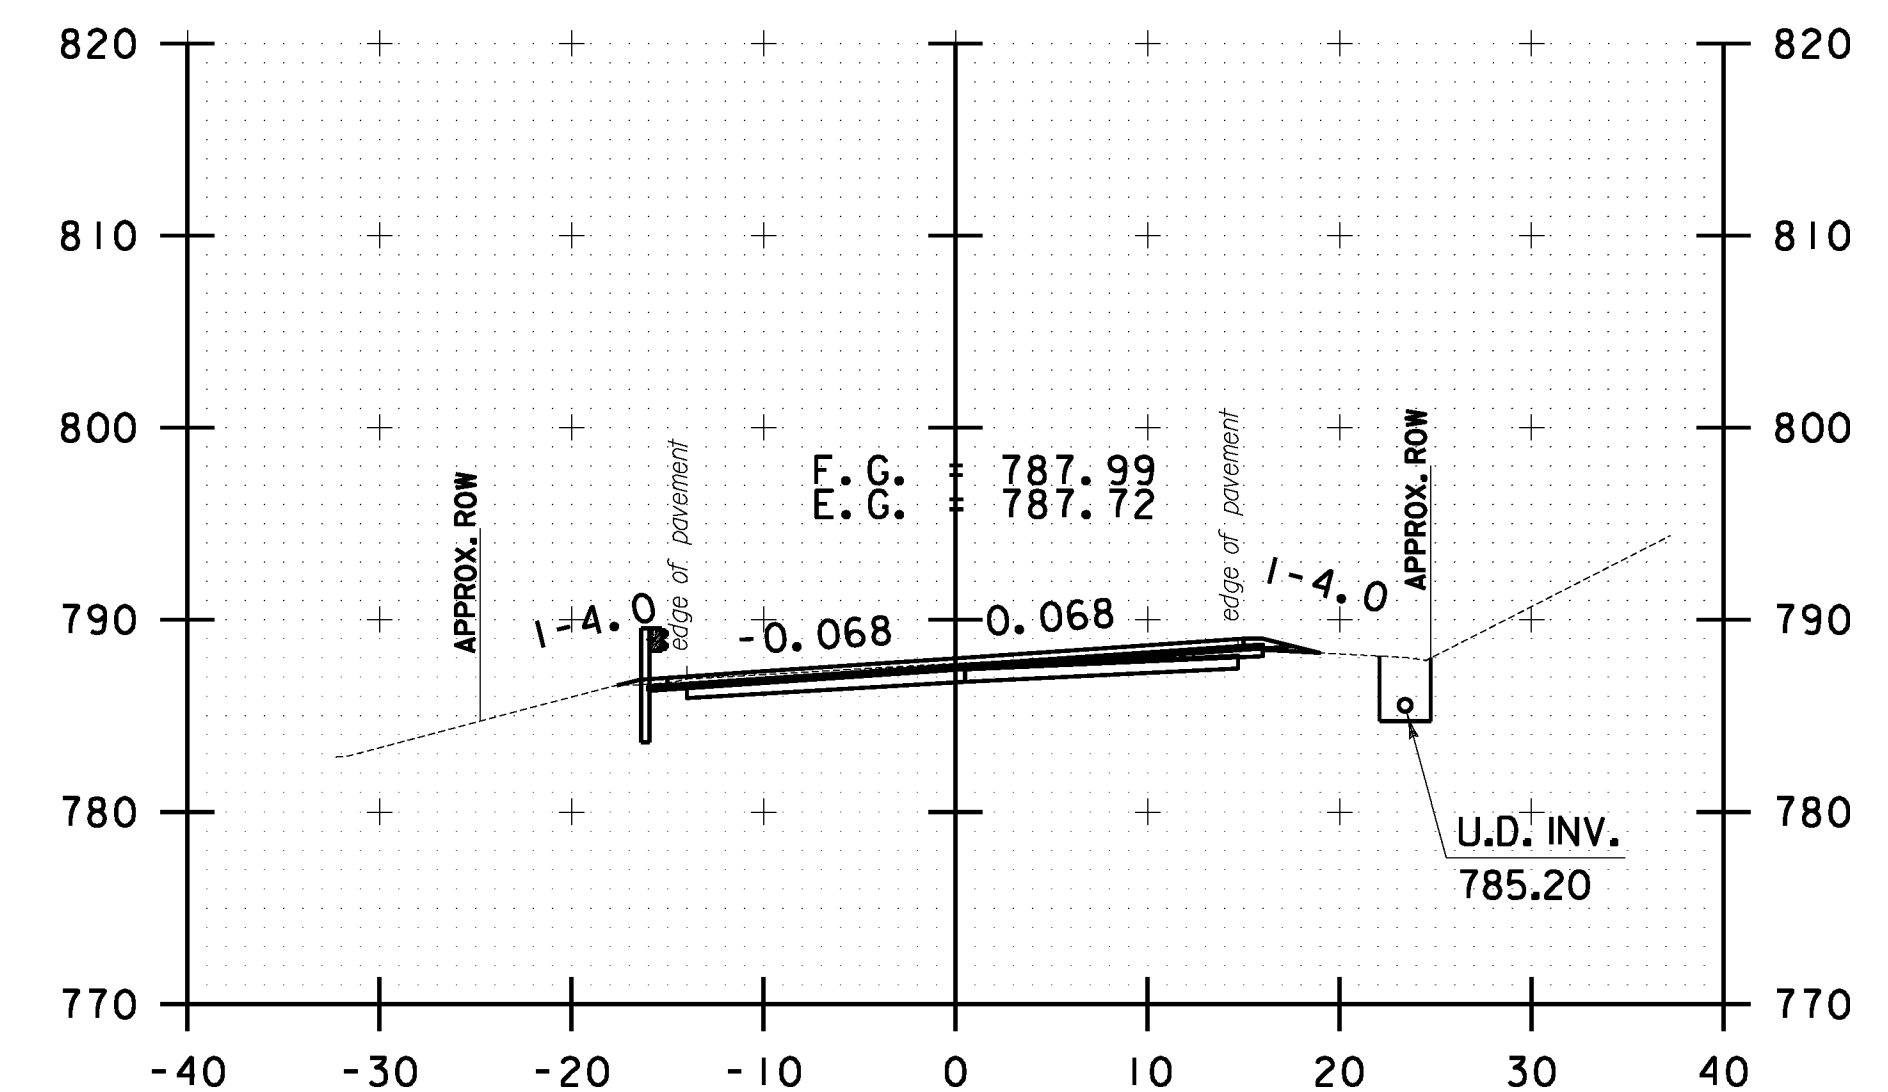

46+50.00

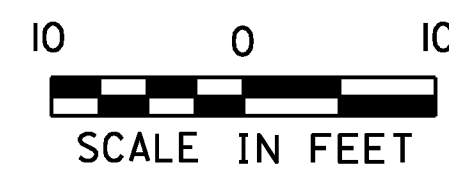

STOCKBRIDGE CROSS SECTION SHEET #15	PROJECT NAME: STOCKBRIDGE-BETHEL
	PROJECT NUMBER: STP 2910(I)
	FILE NAME: z10b214_stock.nc.dgn
DESIGNED BY: L.M.B.	PLOT DATE: 3/17/2014
IPARM FILE: z10b214xs15.1	DRAWN BY: W.G.P.
	CHECKED BY: J.P.S.
	SHEET 228 OF 397