




FILE NAME = Y:\P\c\stok\stok\ANY\K2\22425\CADD\MSTN\10b214_stock.nc.dgn
 DATE/TIME = 3/17/2014
 USER = 4916

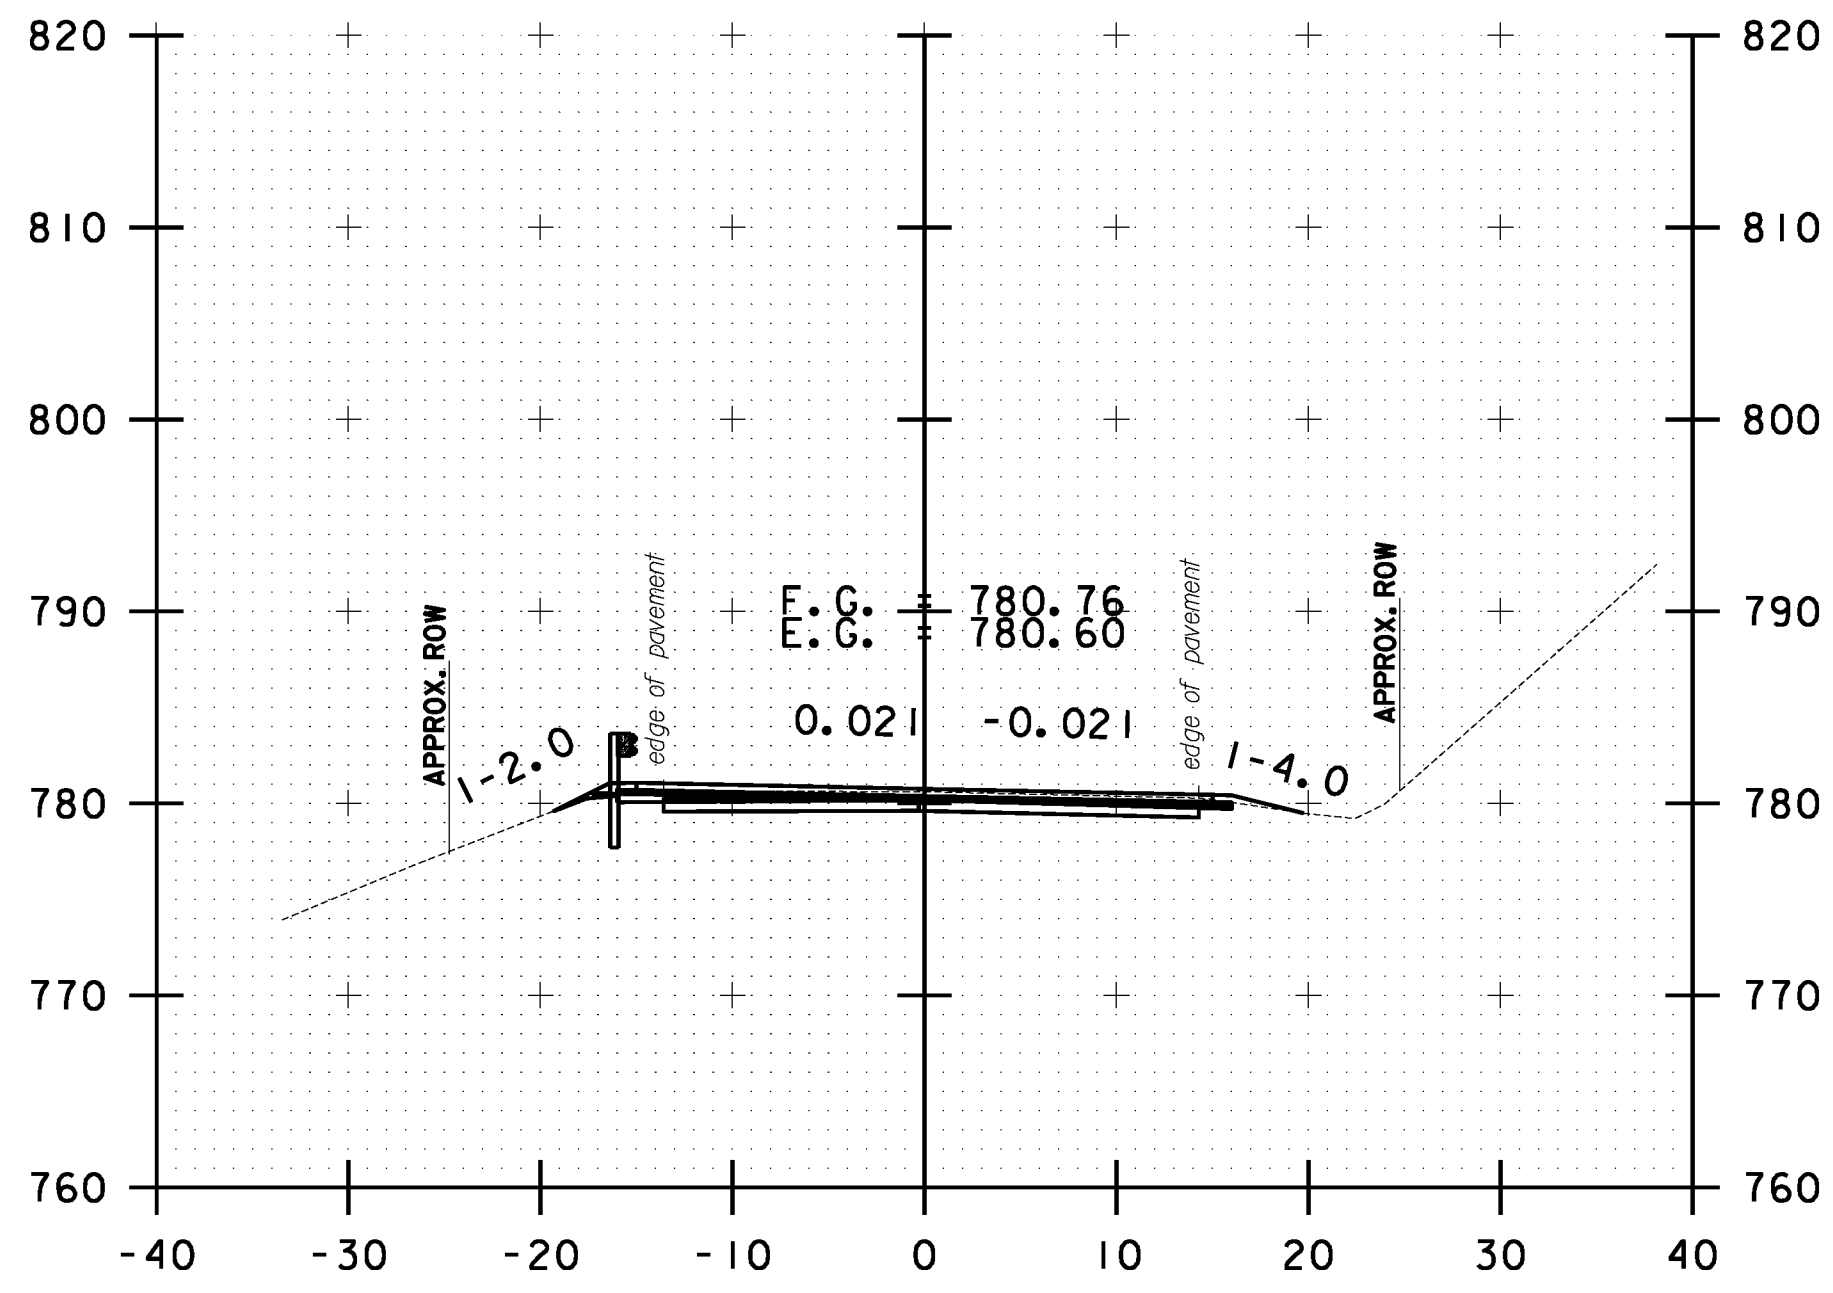


50+50.00

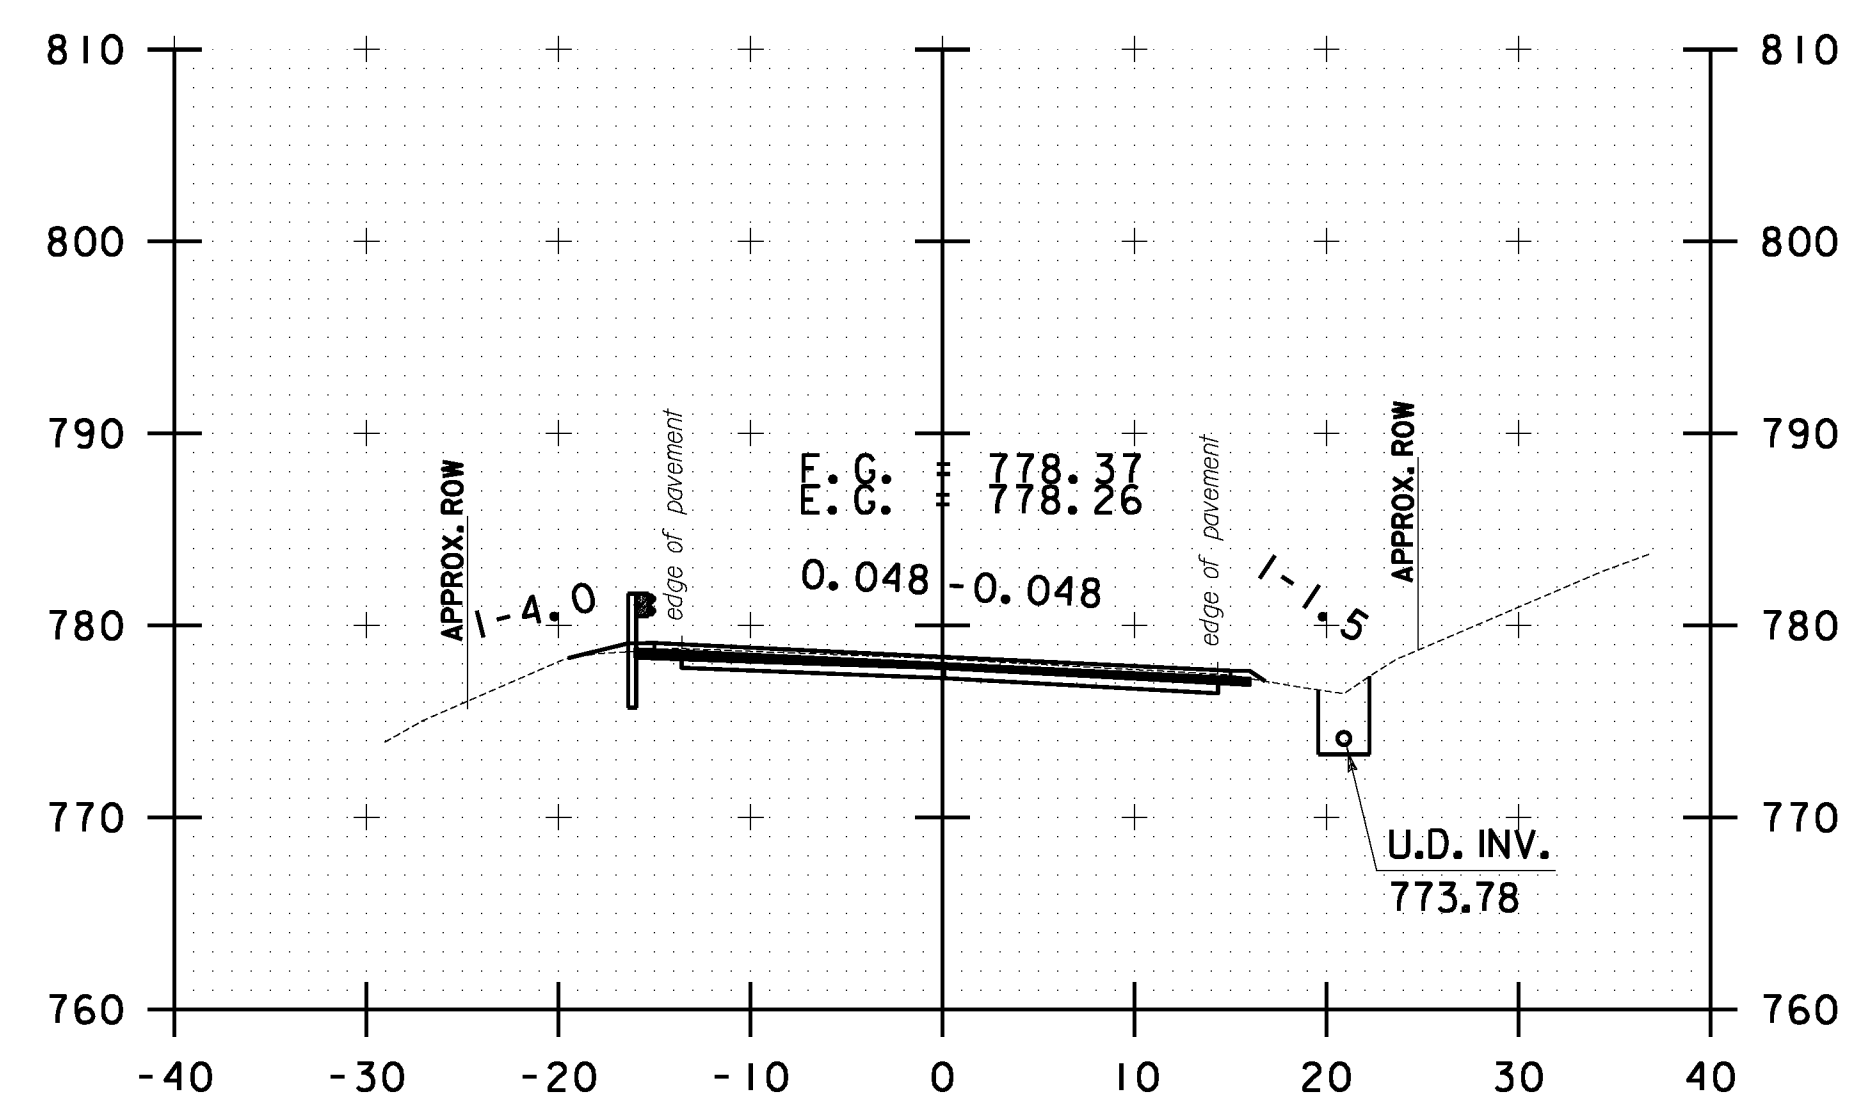


51+50.00

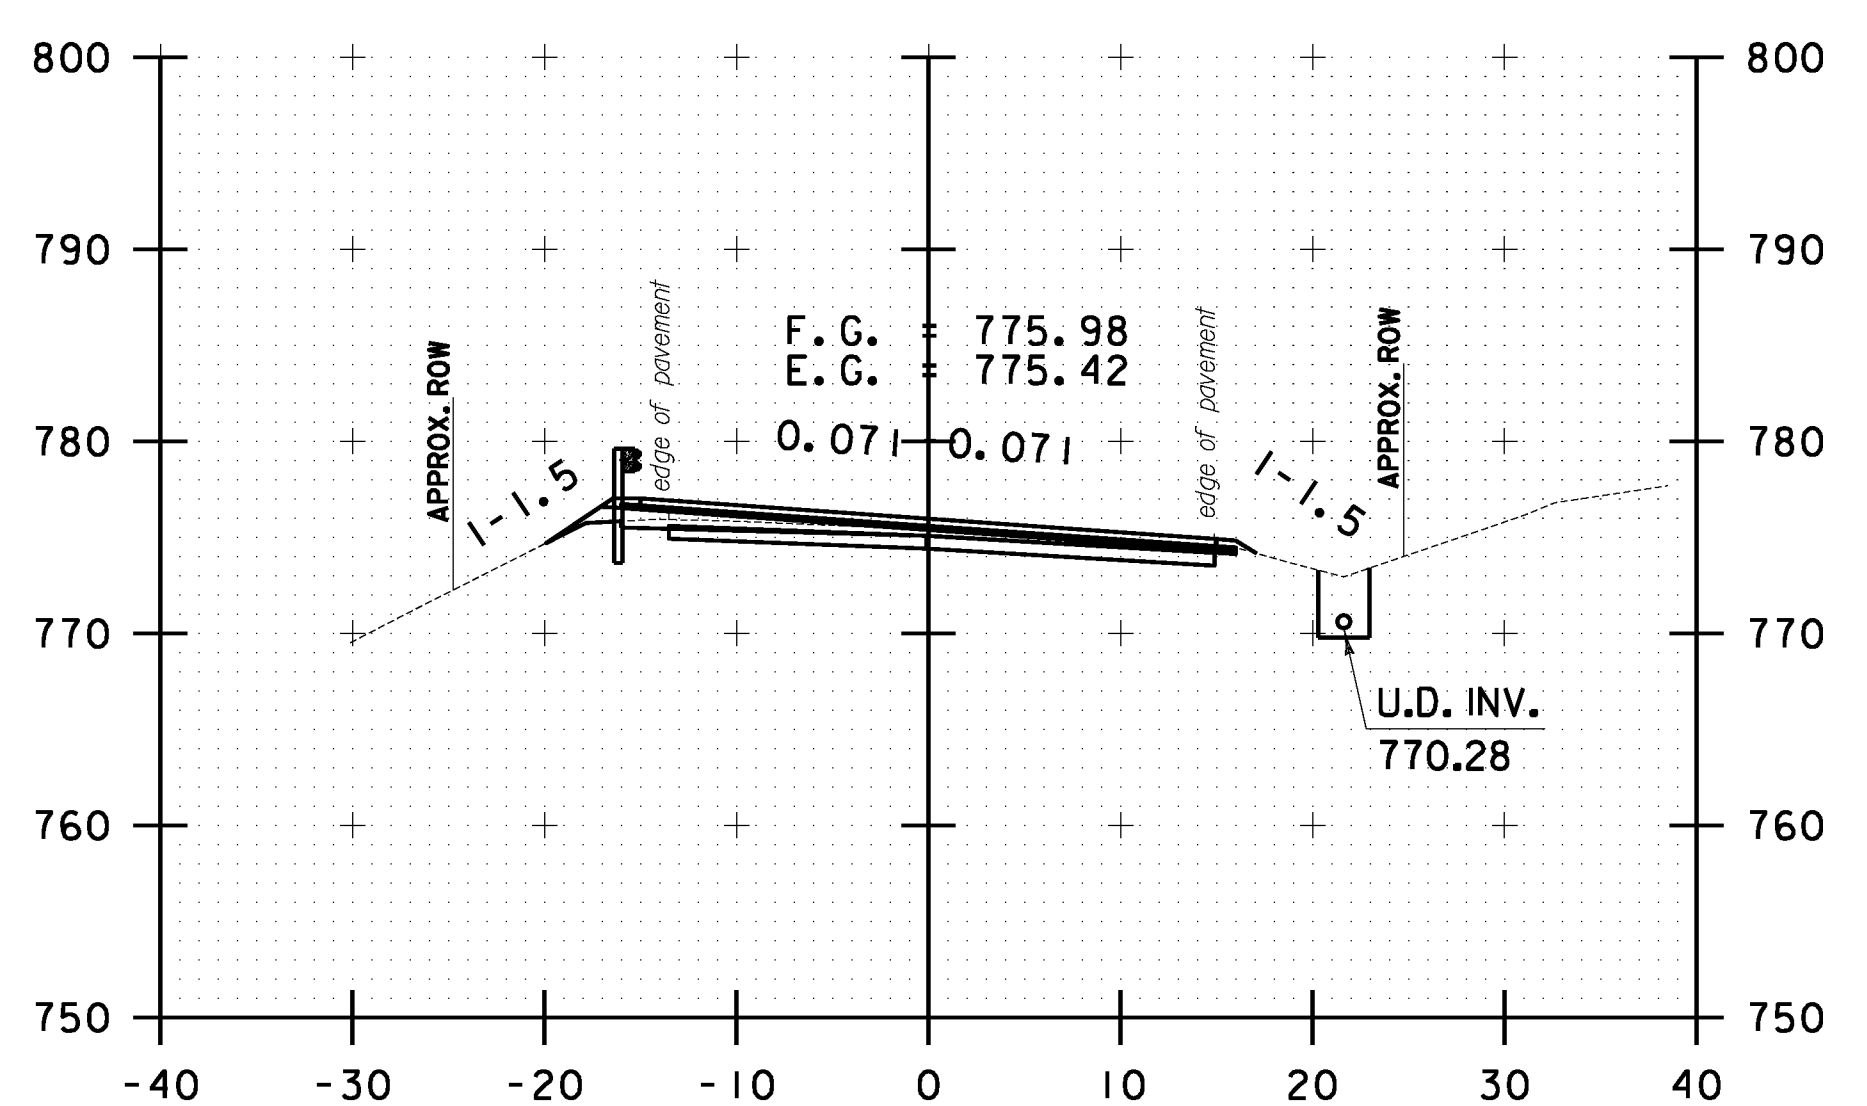


52+50.00

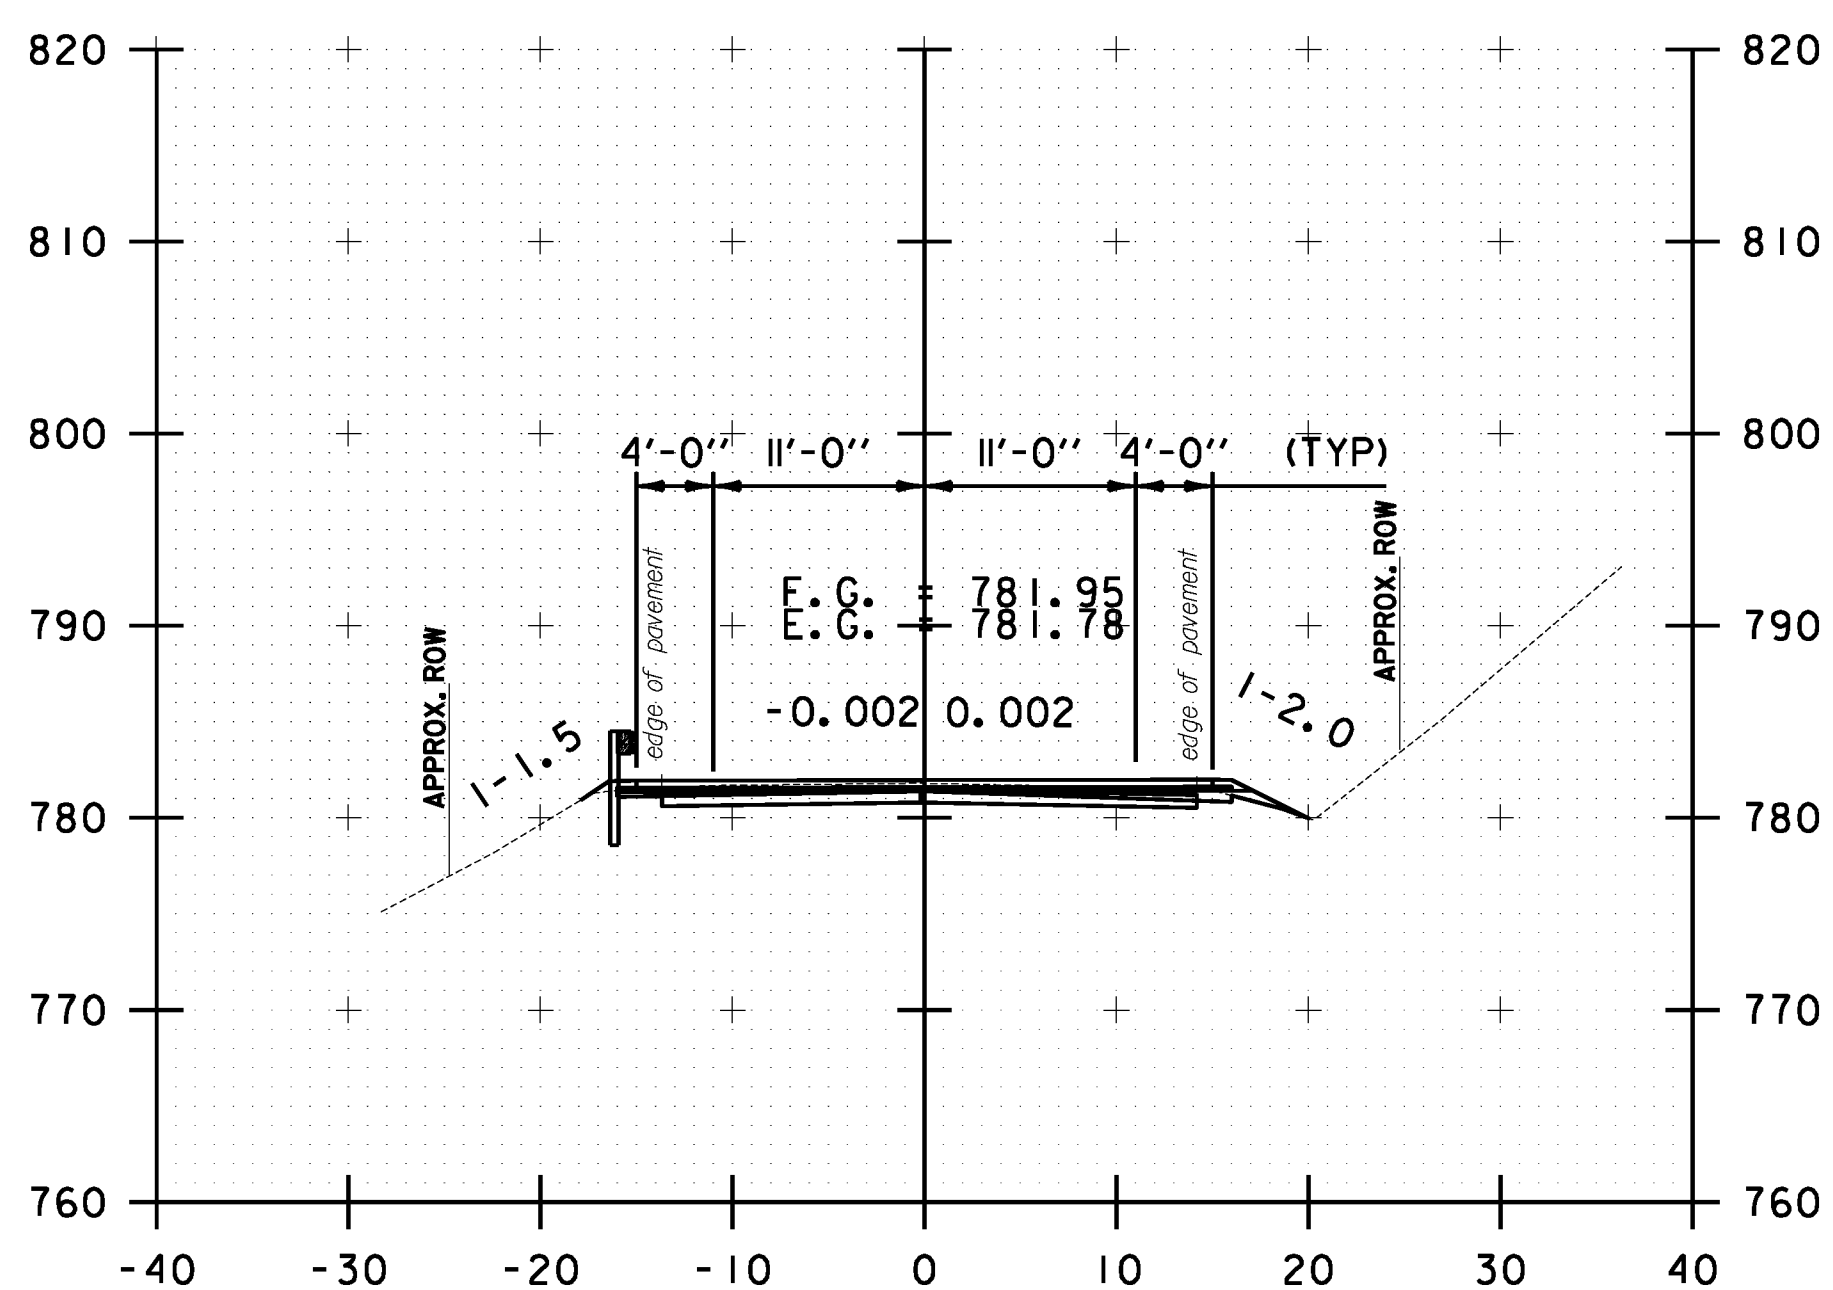


50+00.00

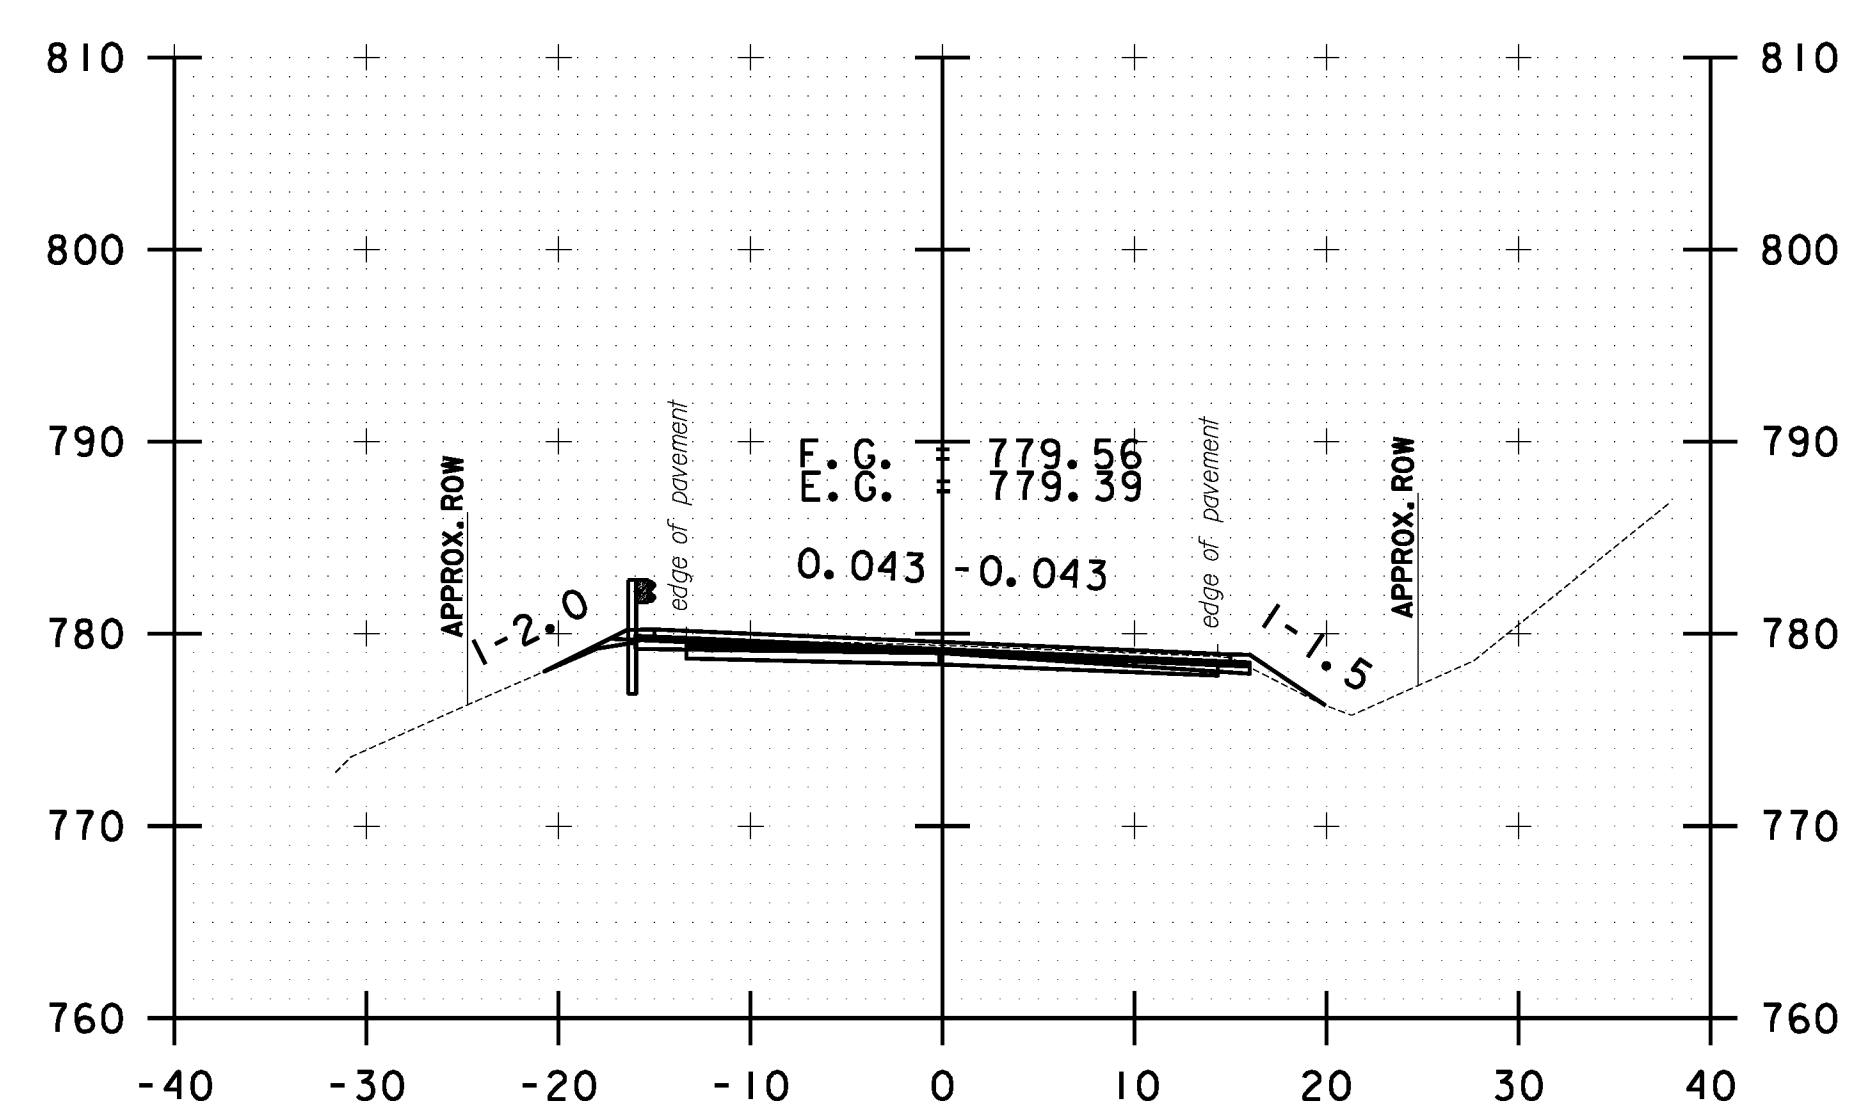

51+00.00

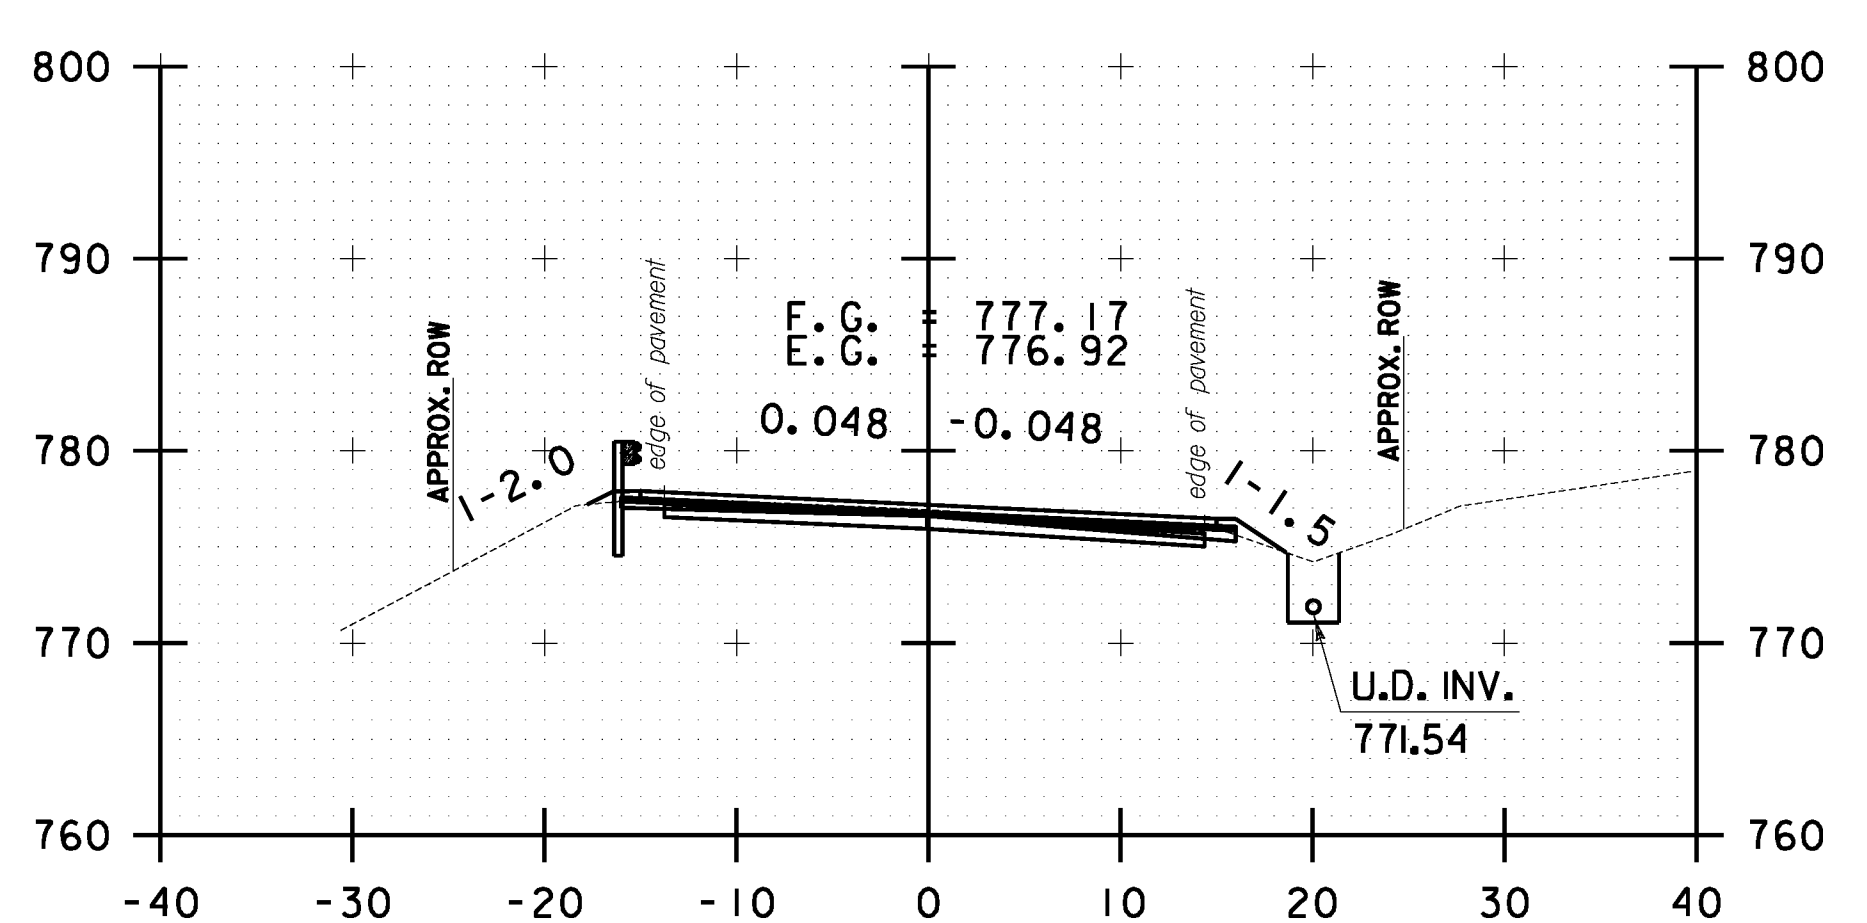

52+00.00

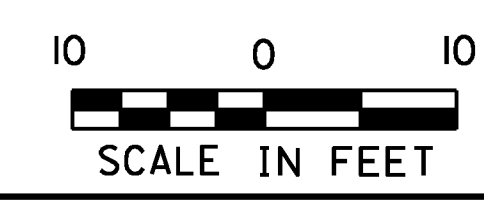

STOCKBRIDGE CROSS SECTION SHEET #17	PROJECT NAME: STOCKBRIDGE-BETHEL
	PROJECT NUMBER: STP 2910(1)
	FILE NAME: z10b214_stock.xc.dgn
	IPARM FILE: z10b214.xs17.1
	PLOT DATE: 3/17/2014
	DRAWN BY: W.G.P.
	CHECKED BY: J.P.S.
	SHEET 230 OF 397