




FILE NAME = Y:\P\c\ass\ANY\K2\22425\CADD\MSTN\10b214_stock_xc.dgn
 DATE/TIME = 3/17/2014
 USER = 4916

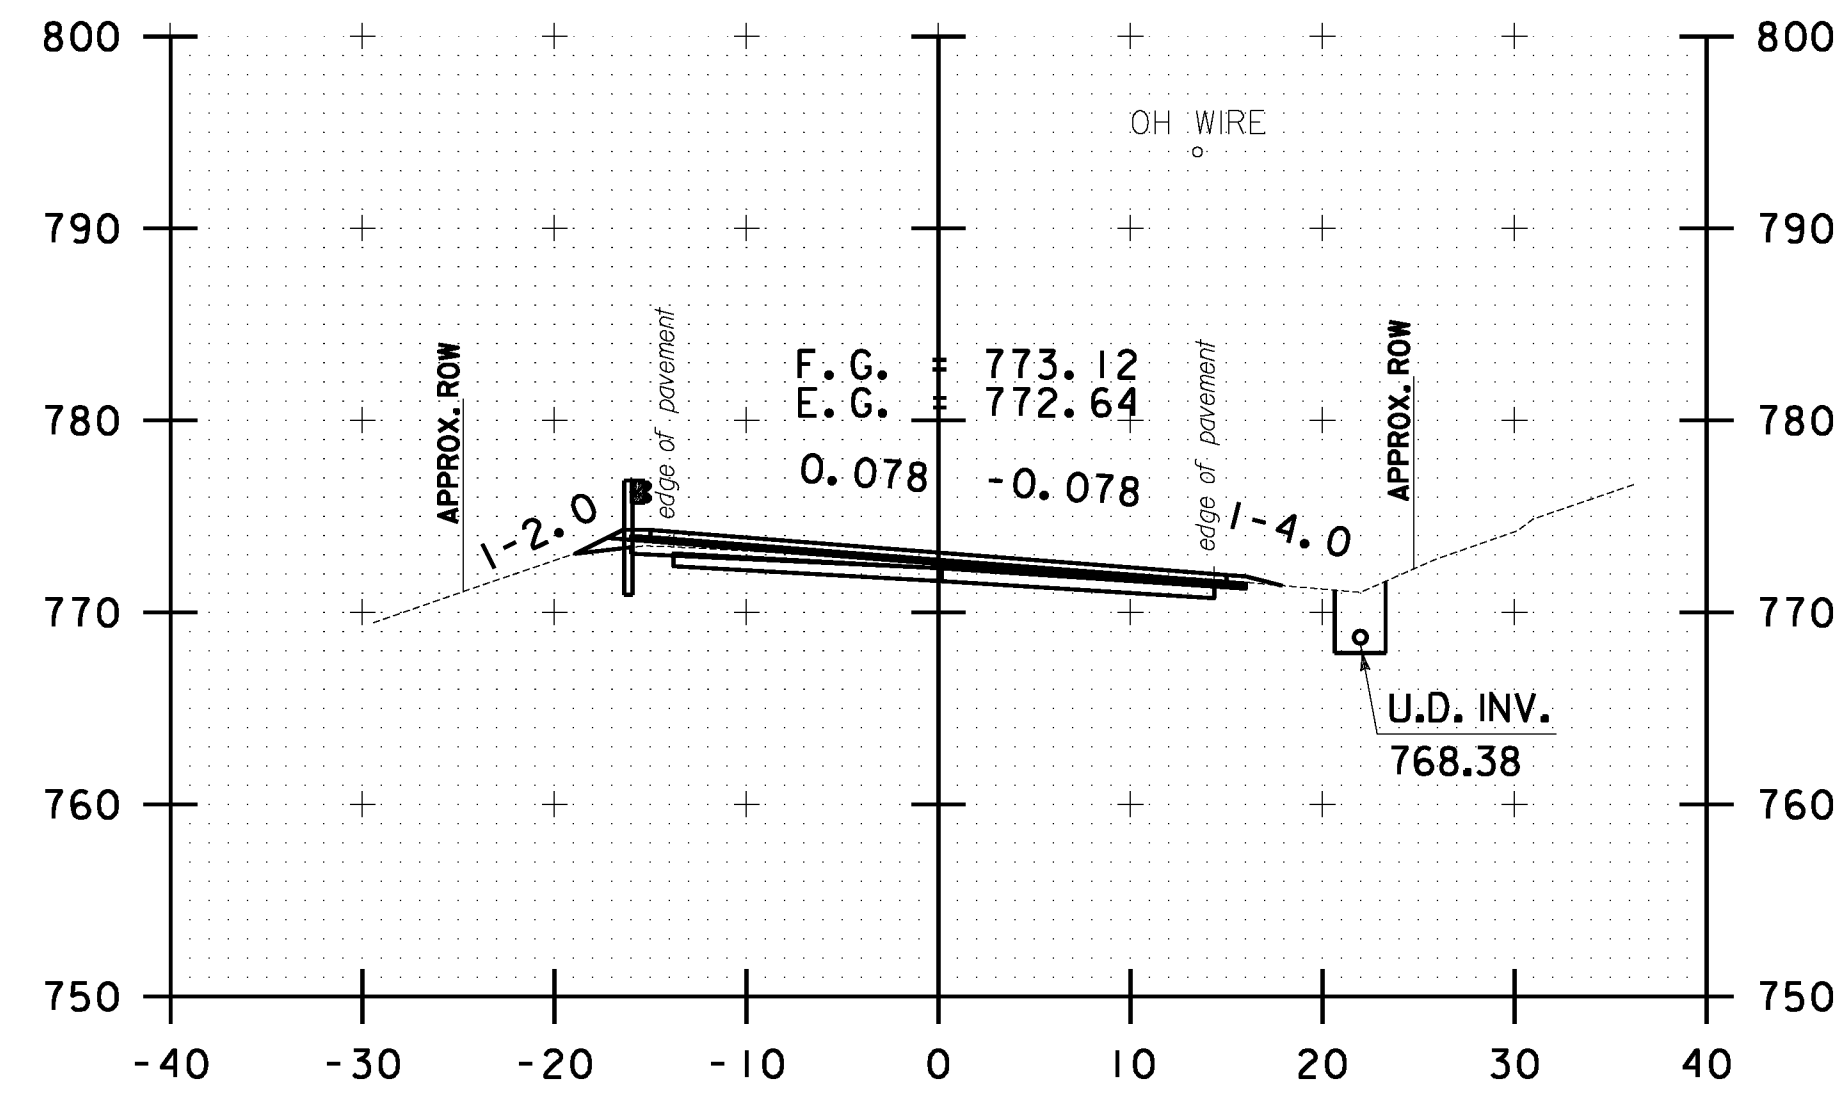


53+50.00

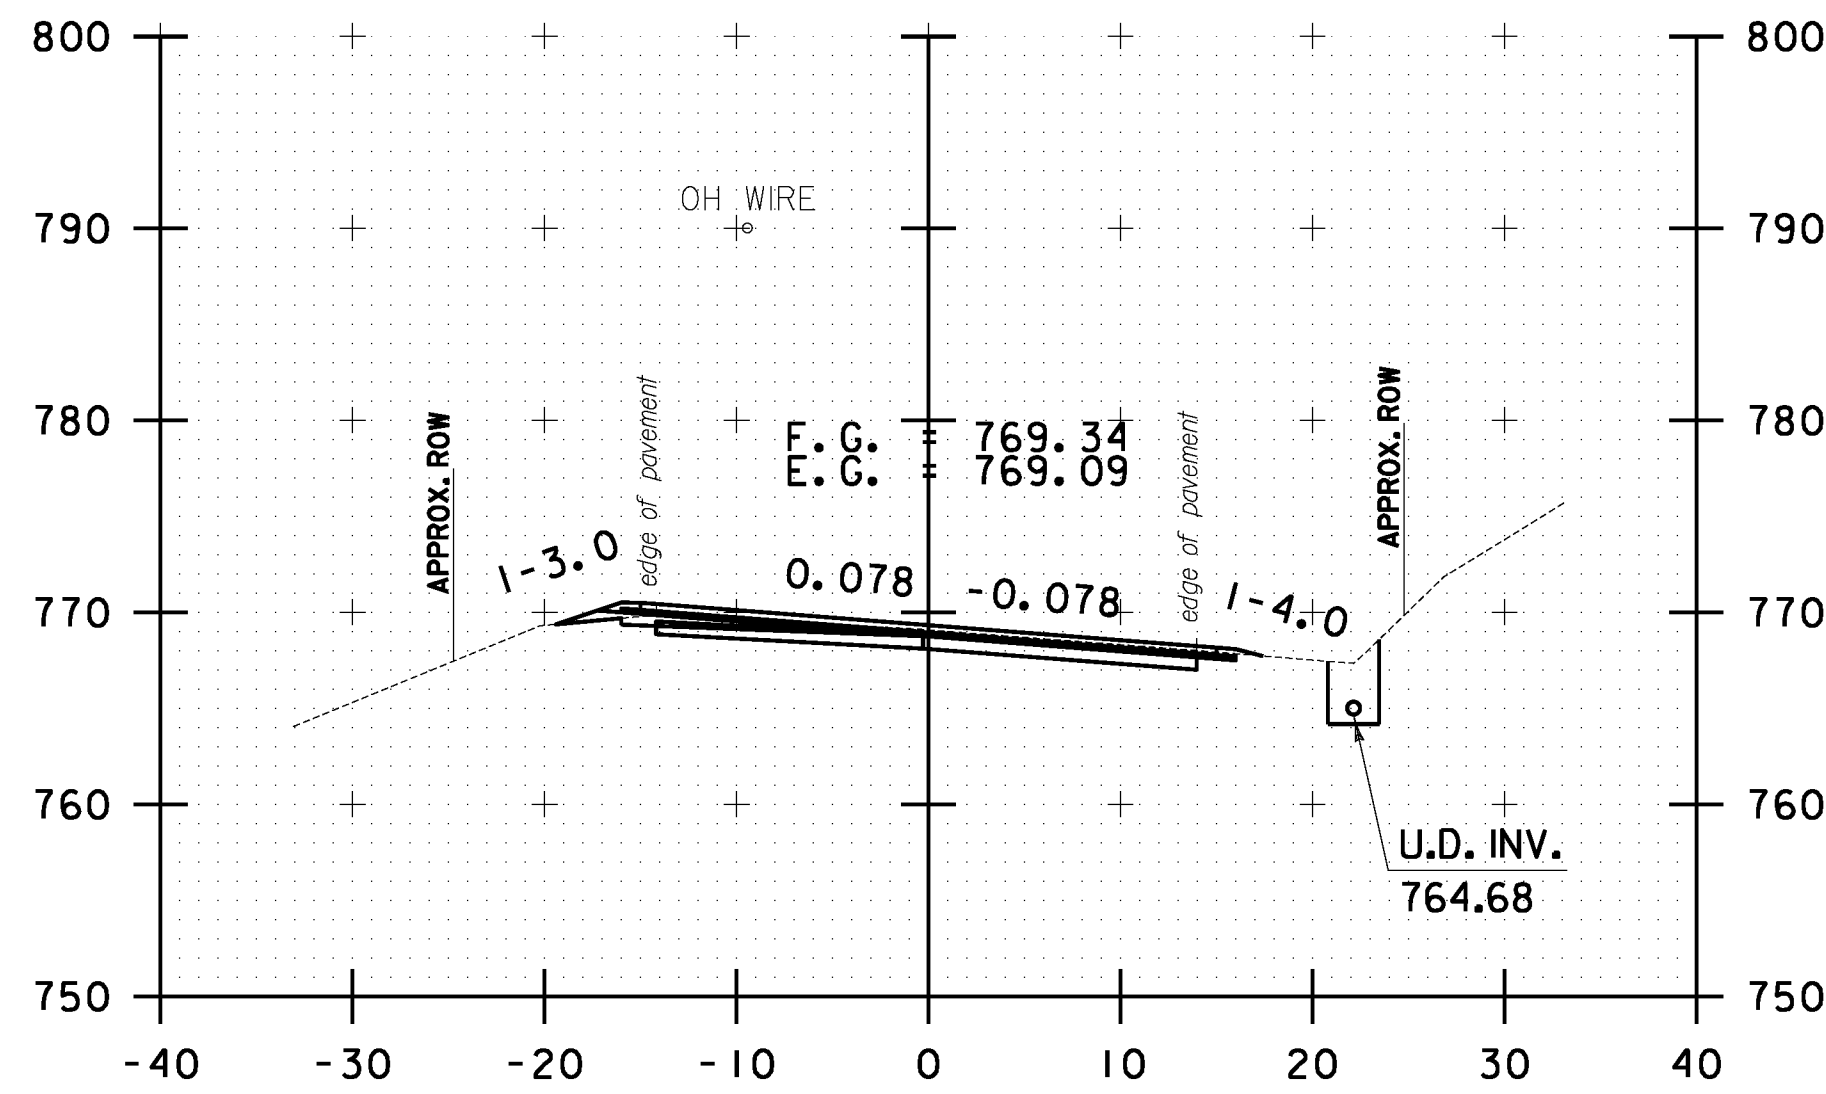


54+50.00

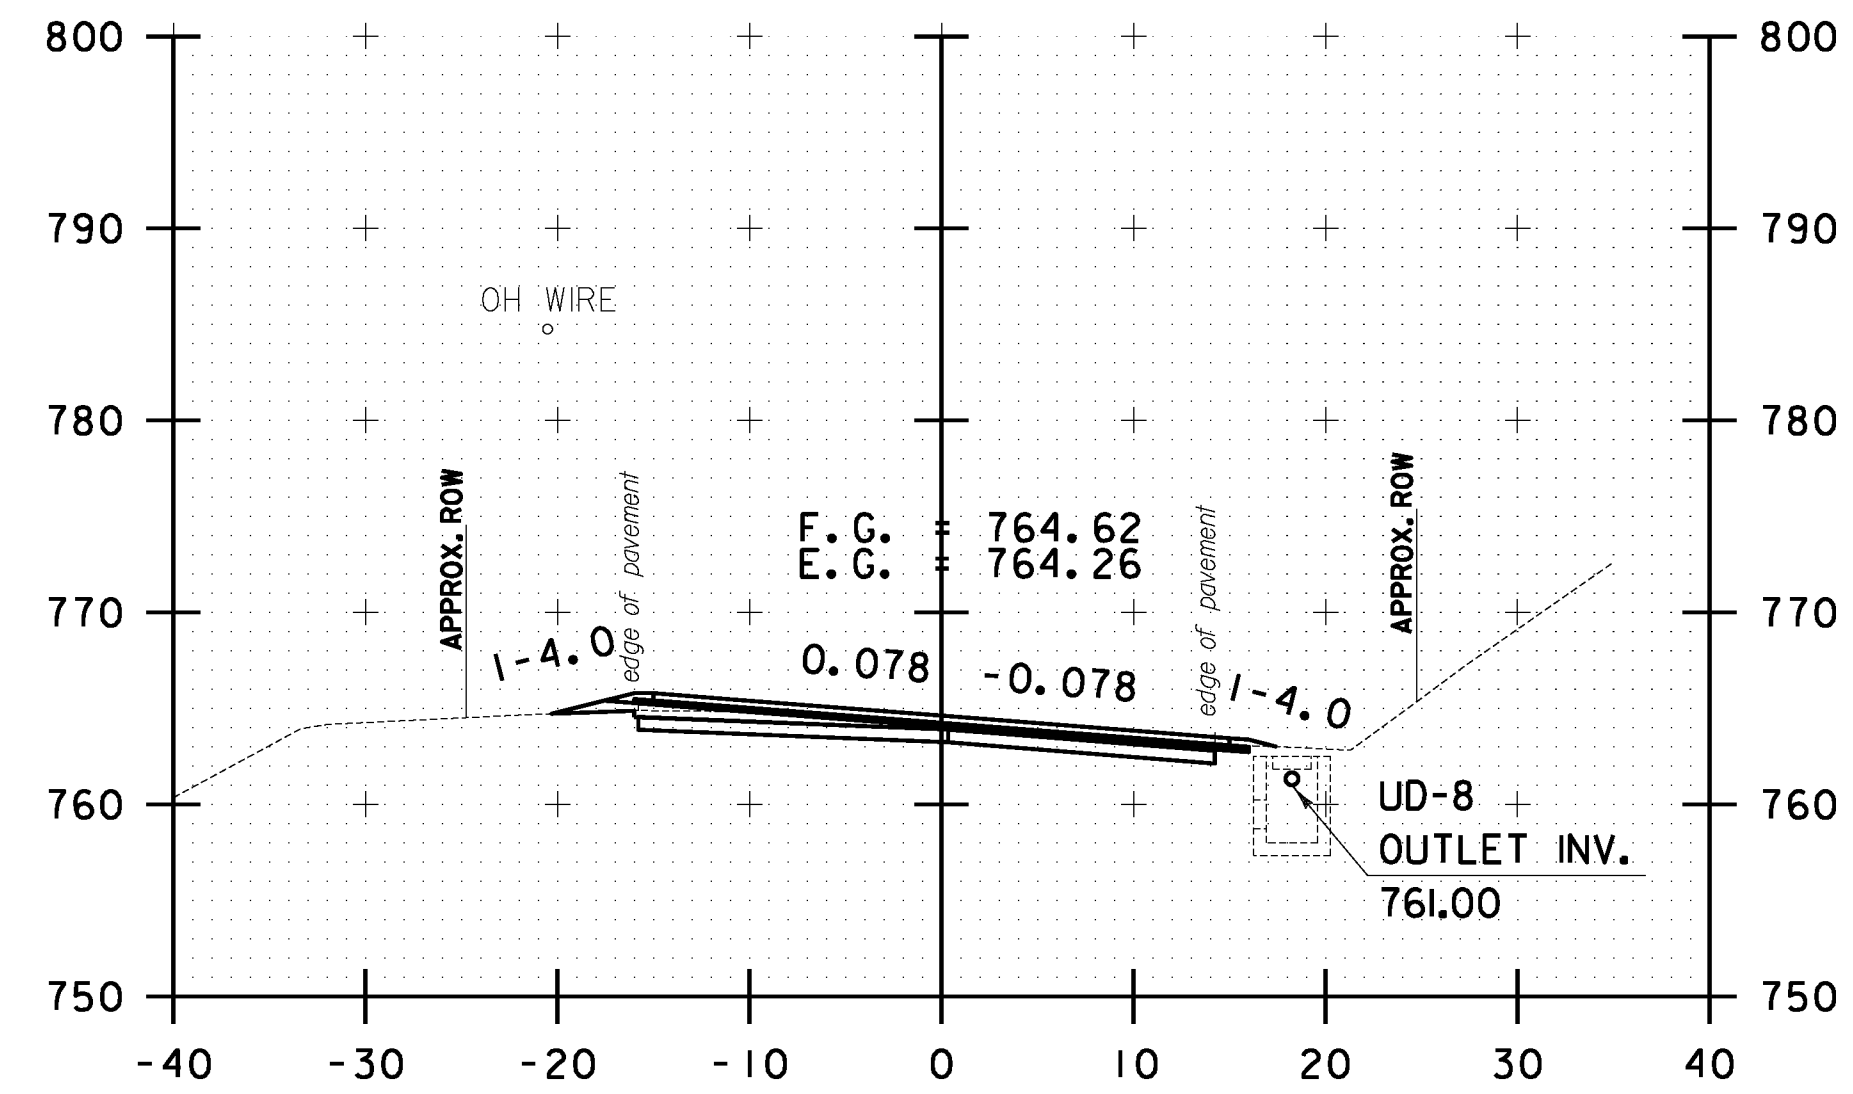


55+50.00

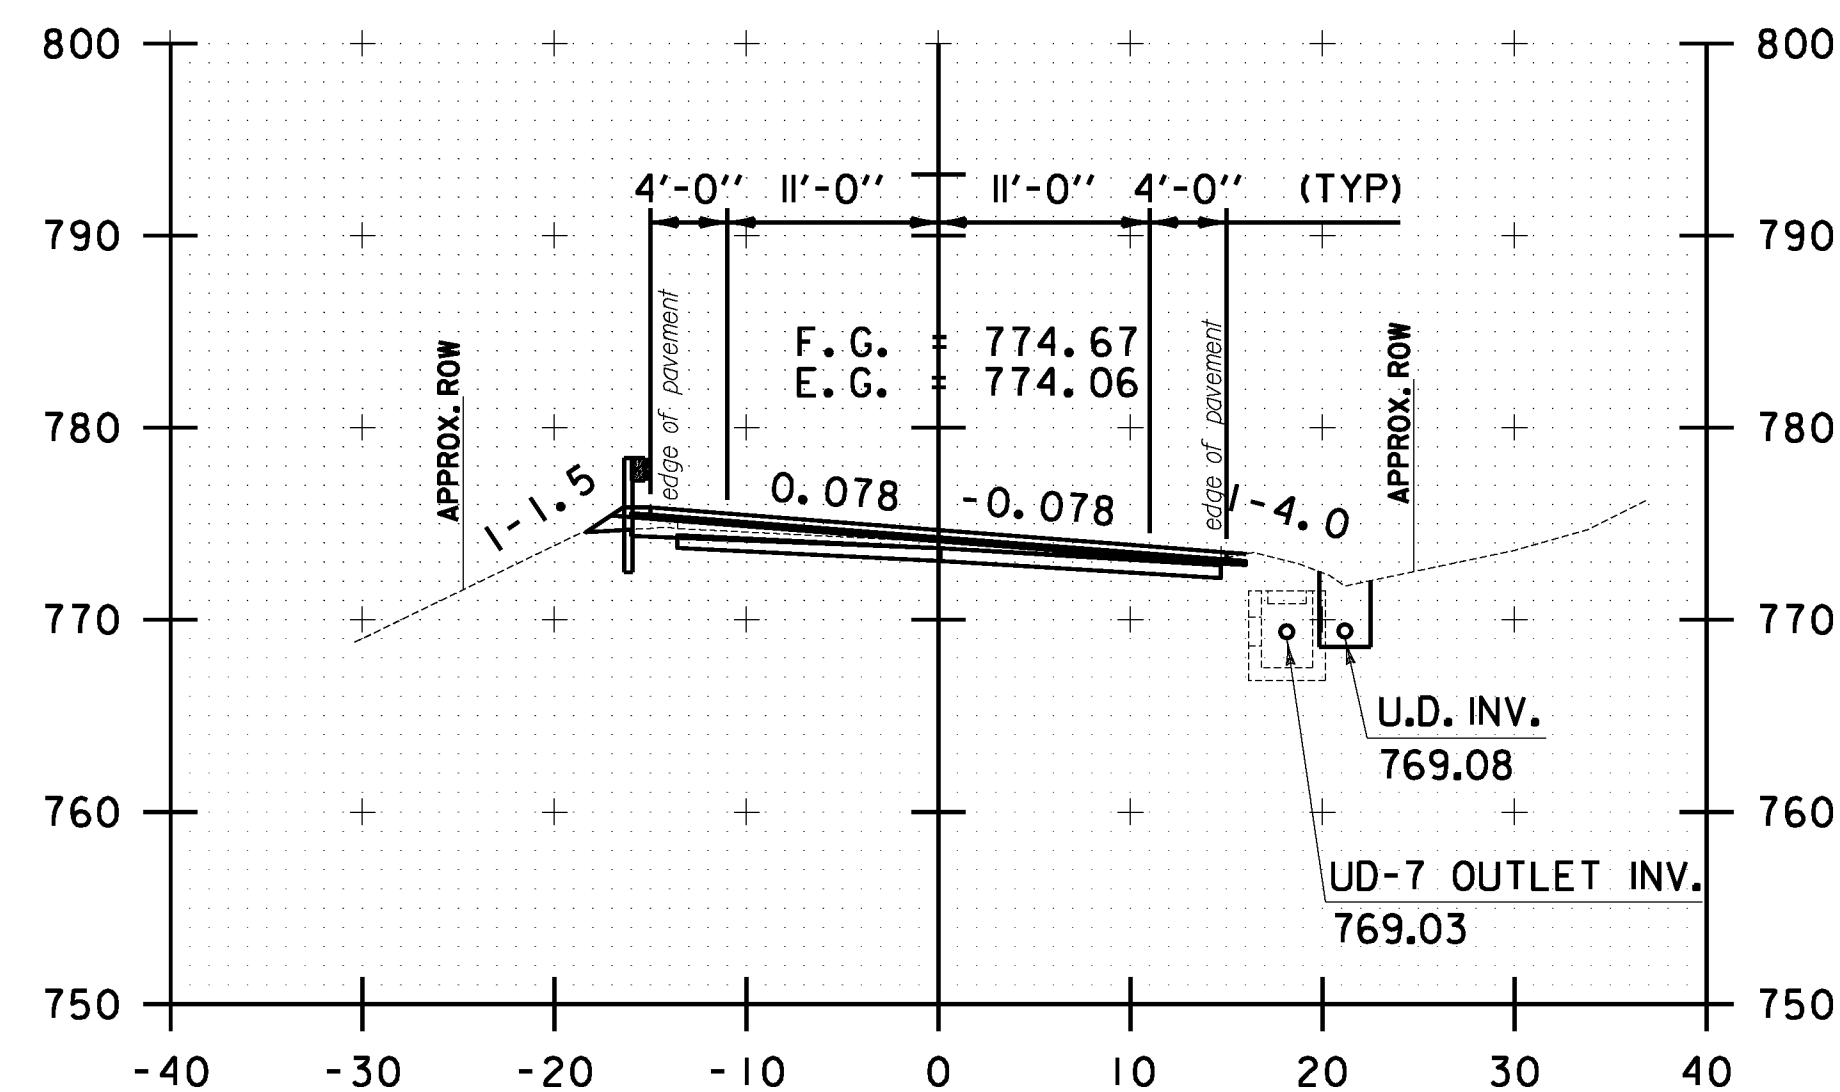


53+00.00

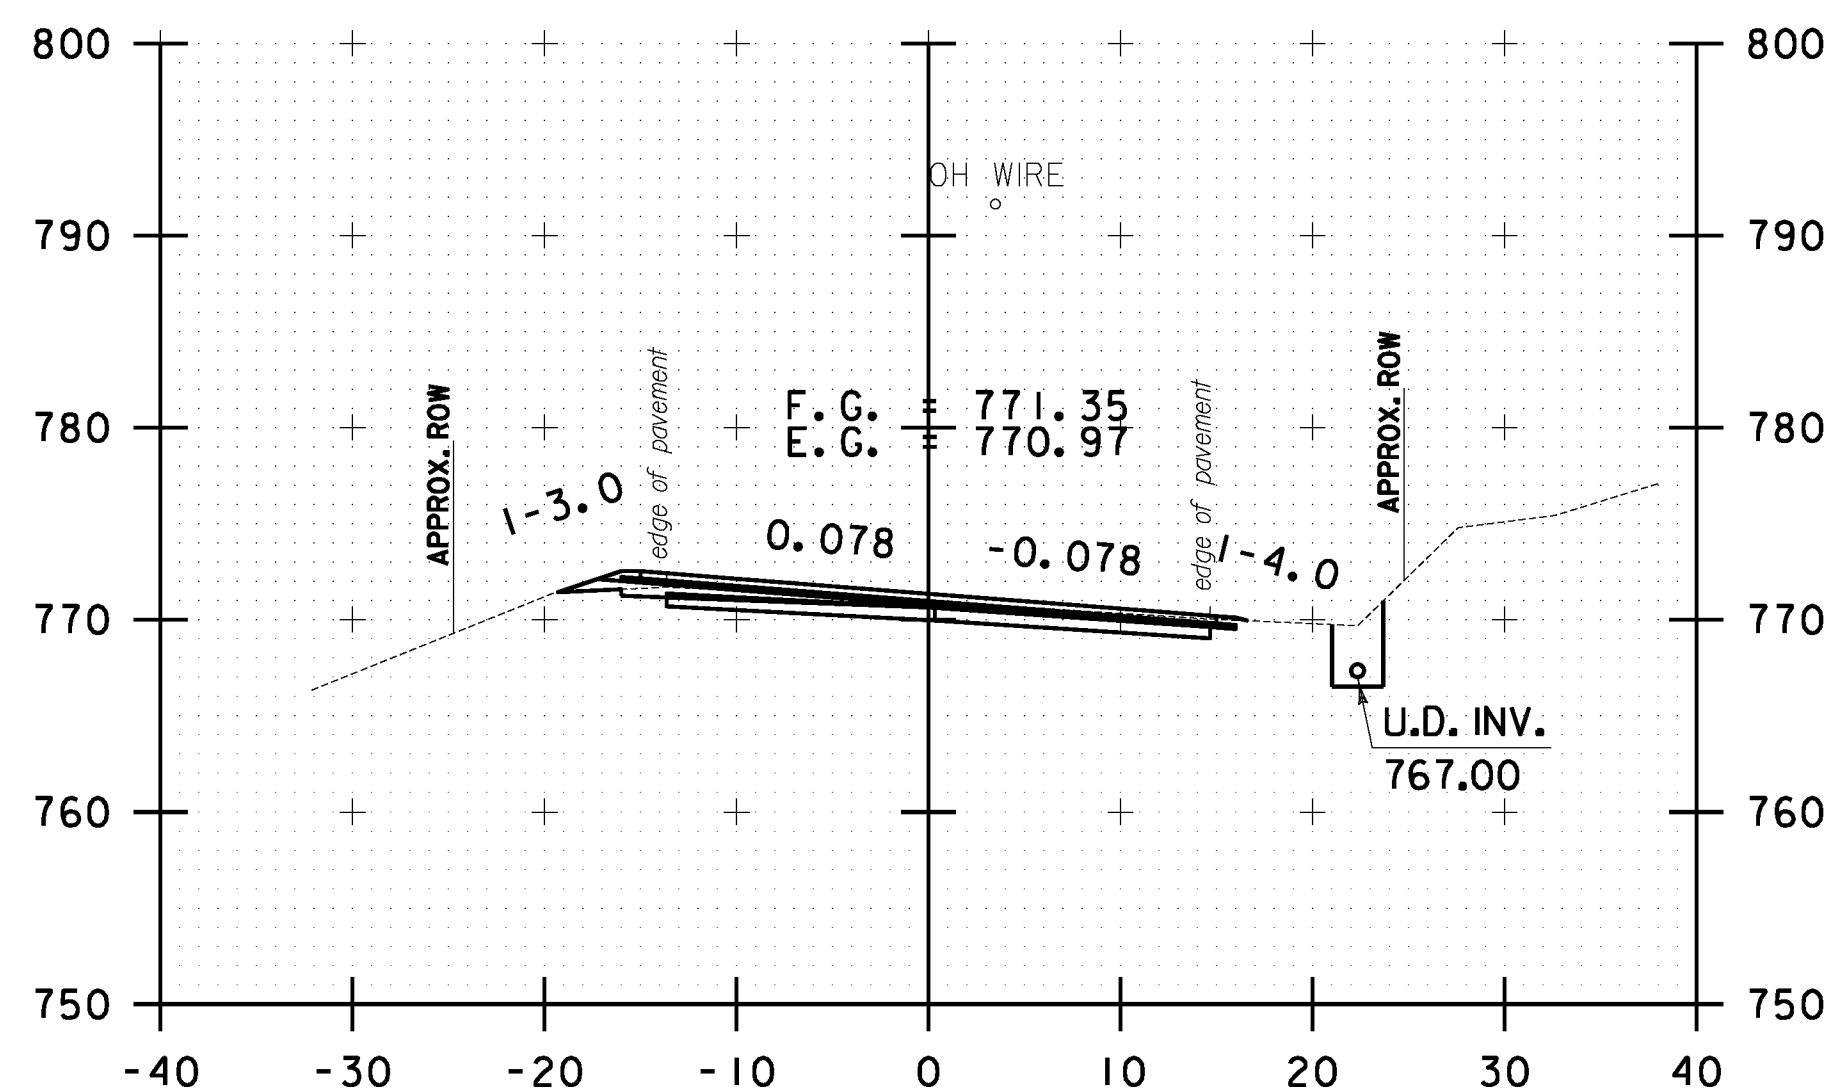

54+00.00

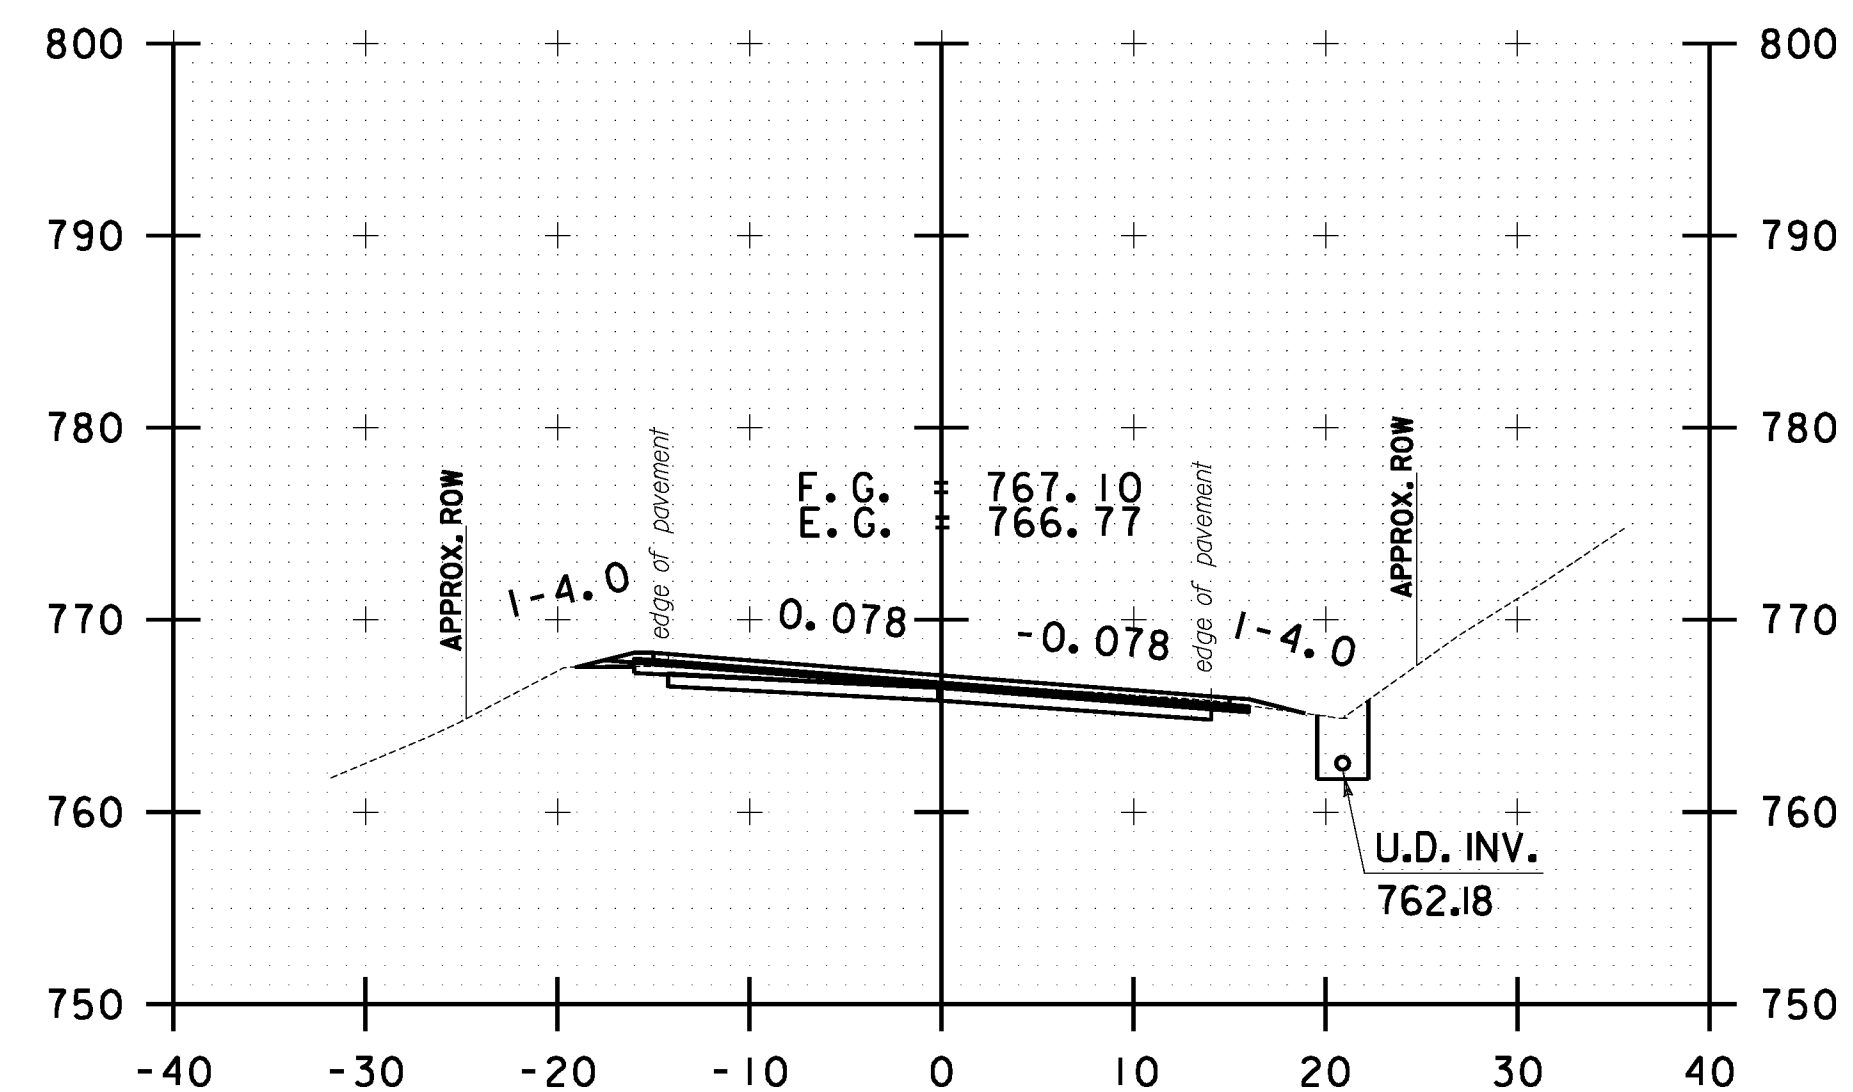

55+00.00

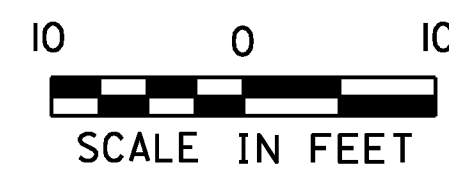

STOCKBRIDGE CROSS SECTION SHEET #18	PROJECT NAME: STOCKBRIDGE-BETHEL
	PROJECT NUMBER: STP 2910(1)
	FILE NAME: z10b214_stock_xc.dgn
DESIGNED BY: L.M.B.	PLOT DATE: 3/17/2014
IPARM FILE: z10b214xs18.1	DRAWN BY: W.G.P.
	CHECKED BY: J.P.S.
	SHEET 231 OF 397