




FILE NAME = V:\P\c\res\any\k2\22425\CADD\MSTN\10b214\_stock\_xc.dgn  
 DATE/TIME = 3/17/2014  
 USER = 4916

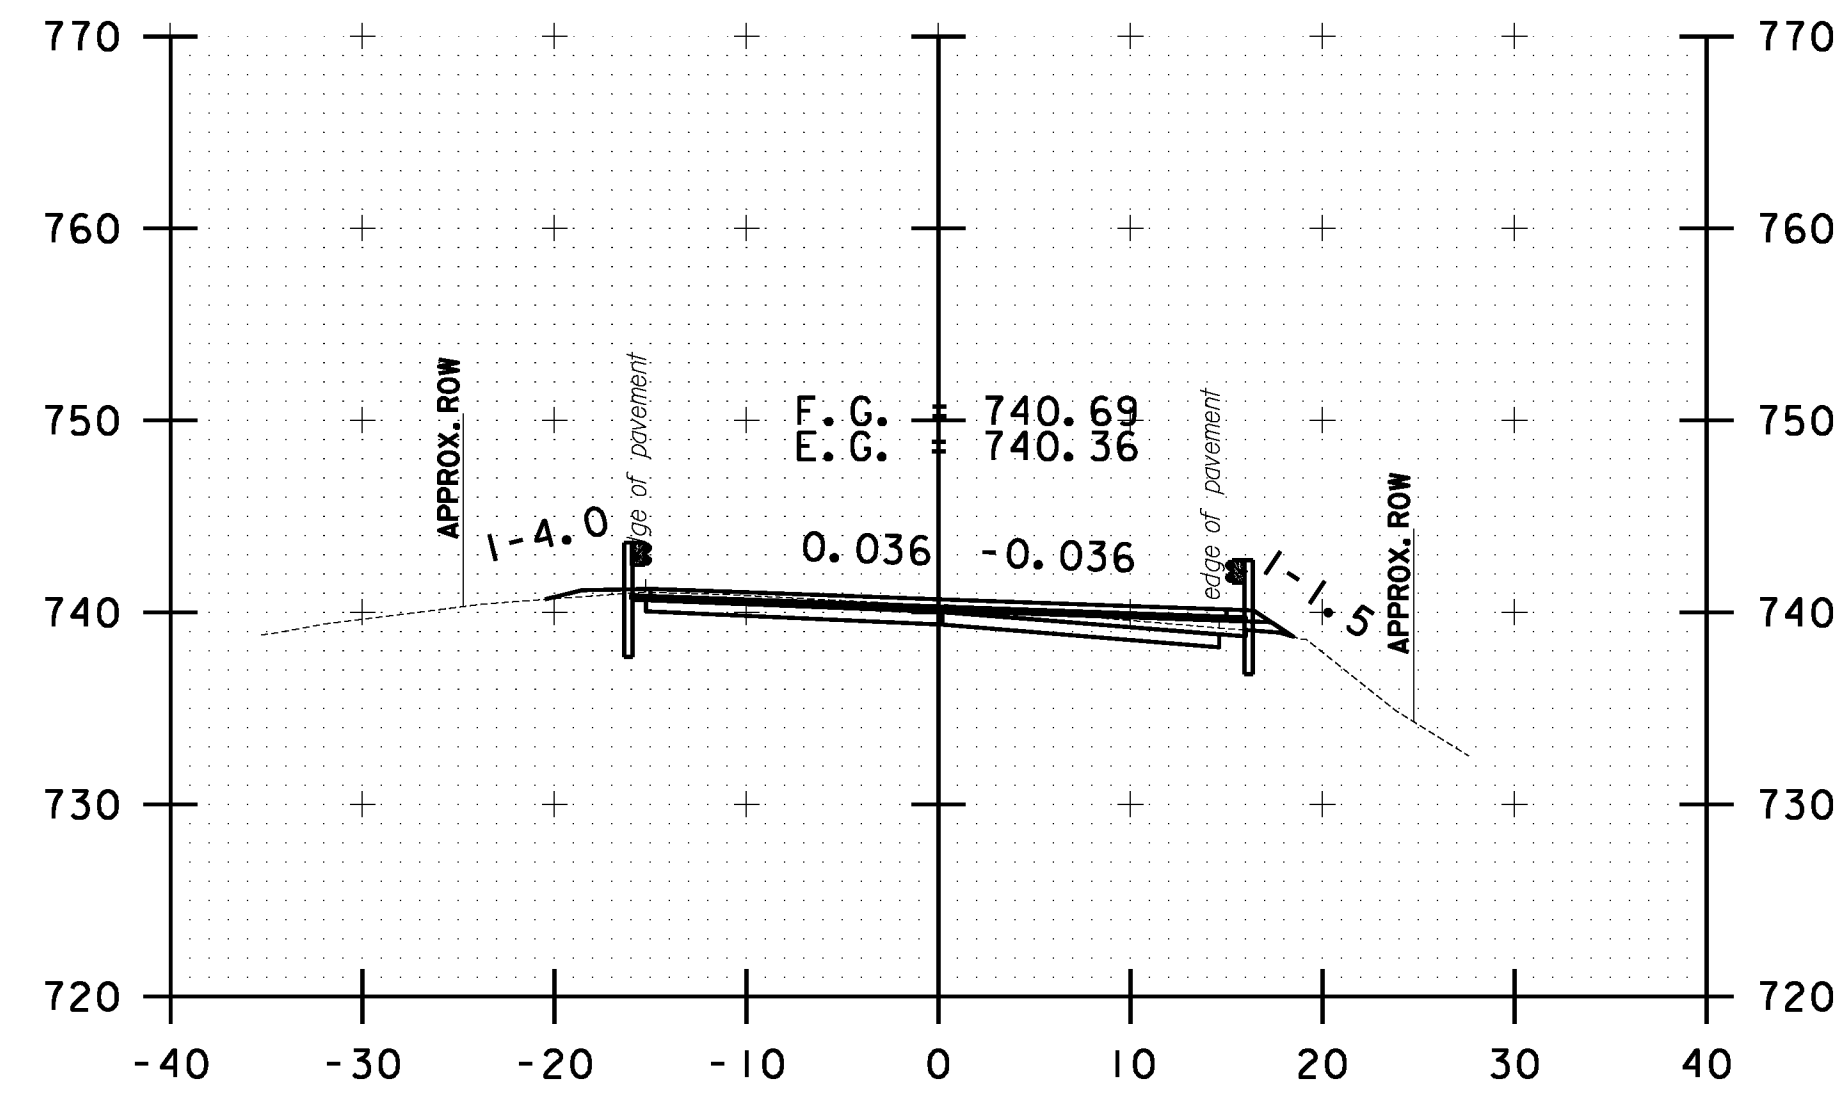


59+50.00

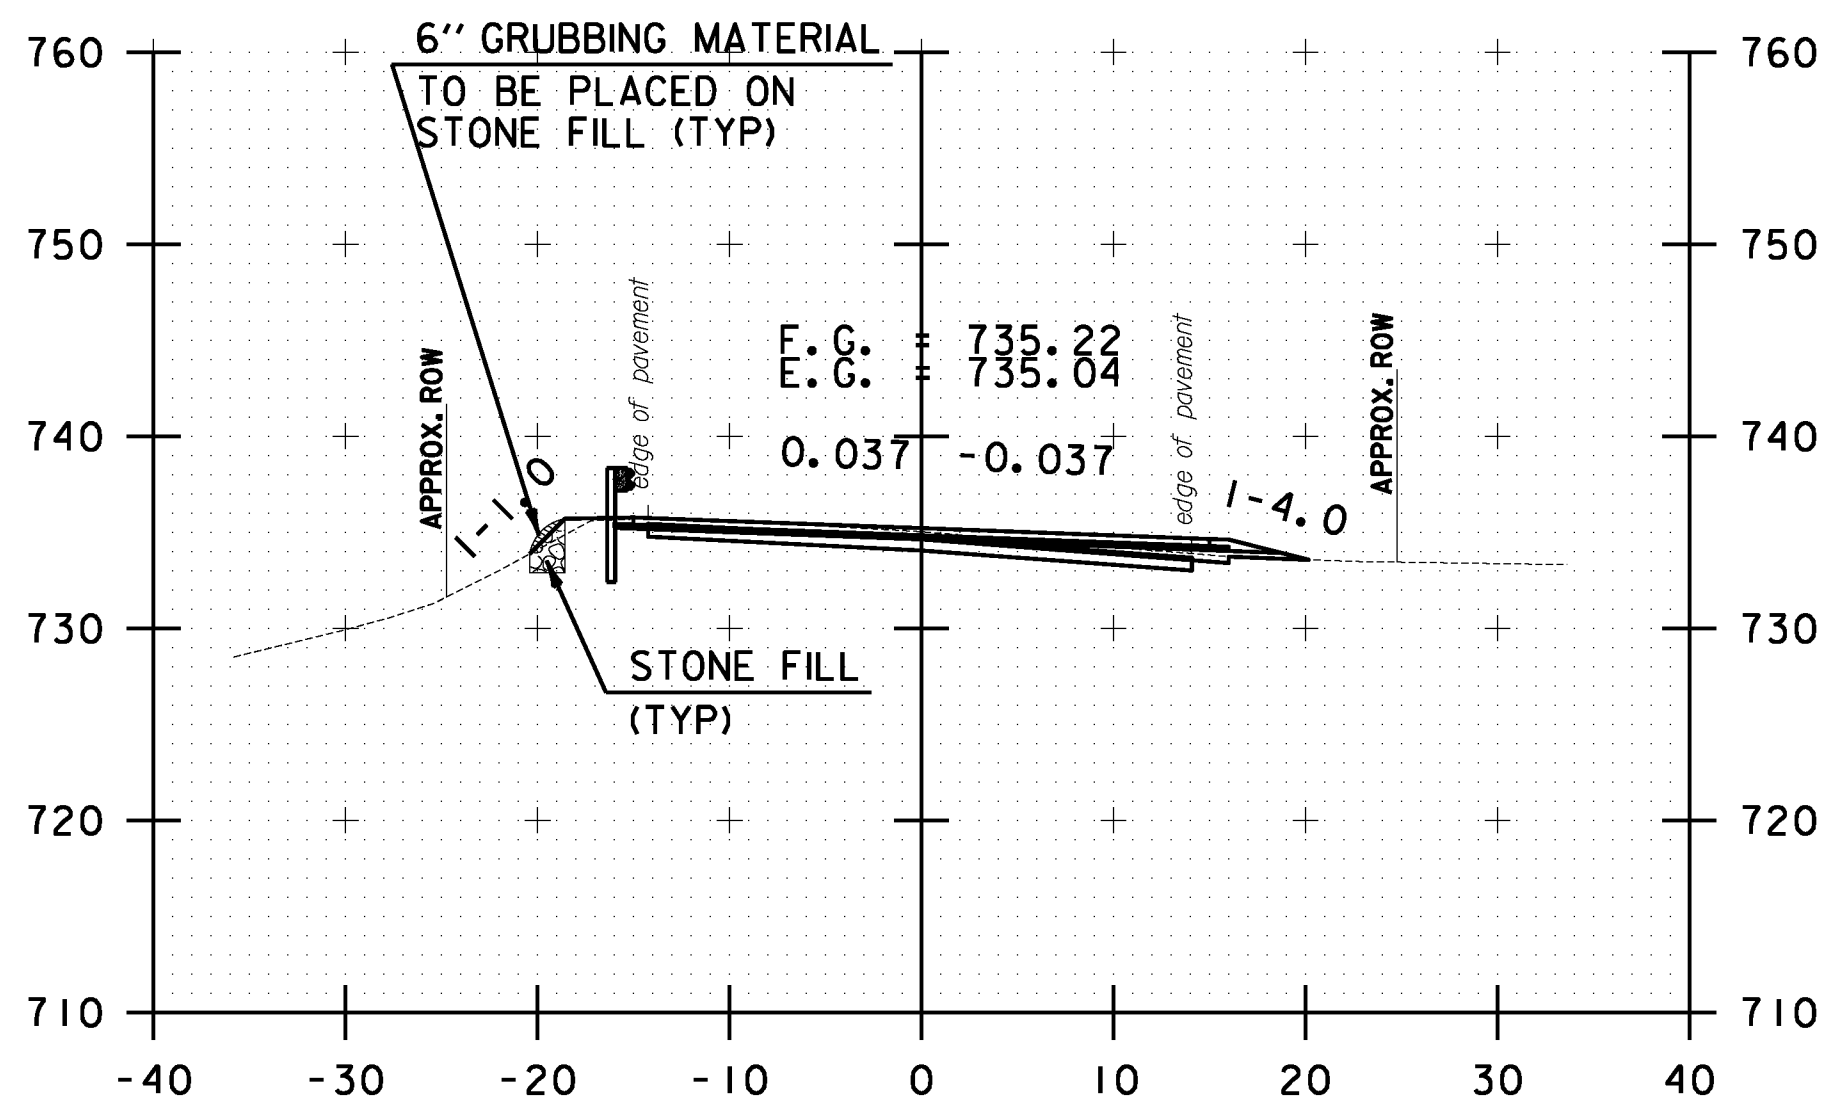


60+50.00

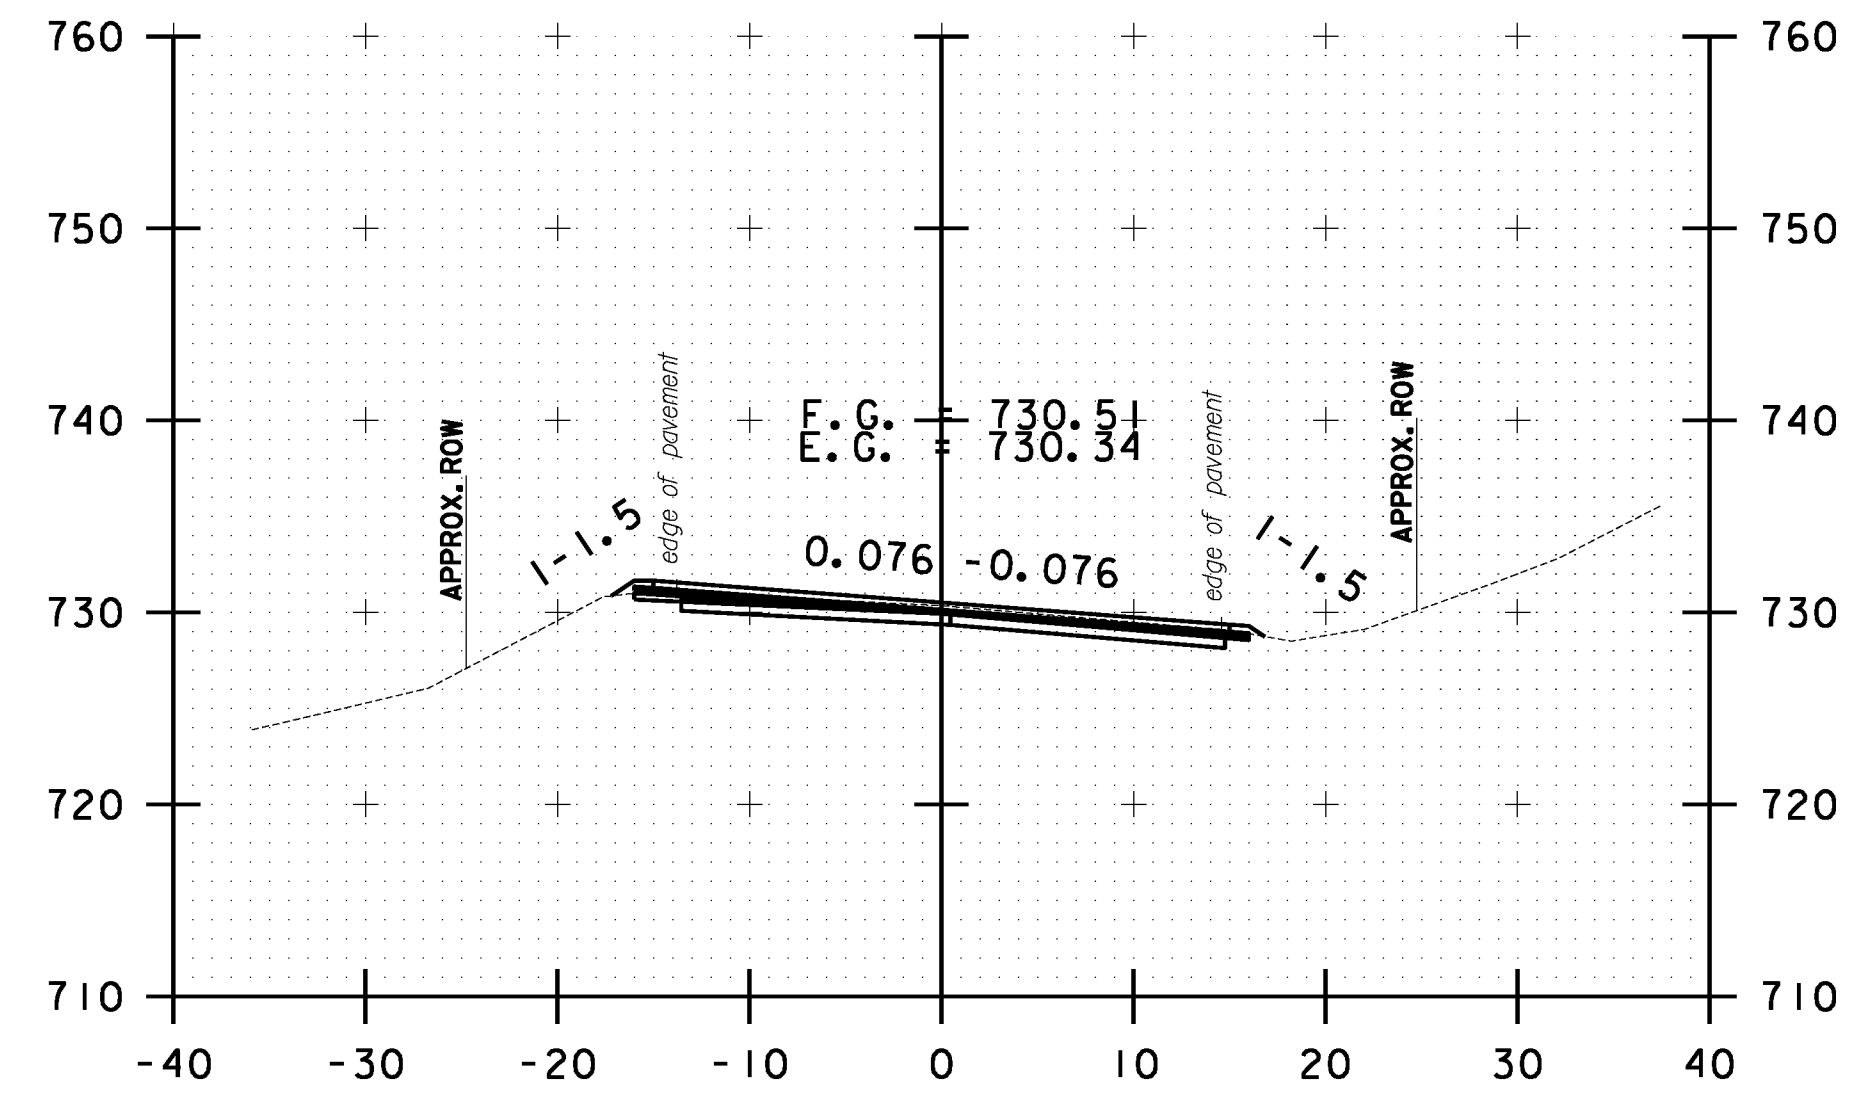


61+50.00

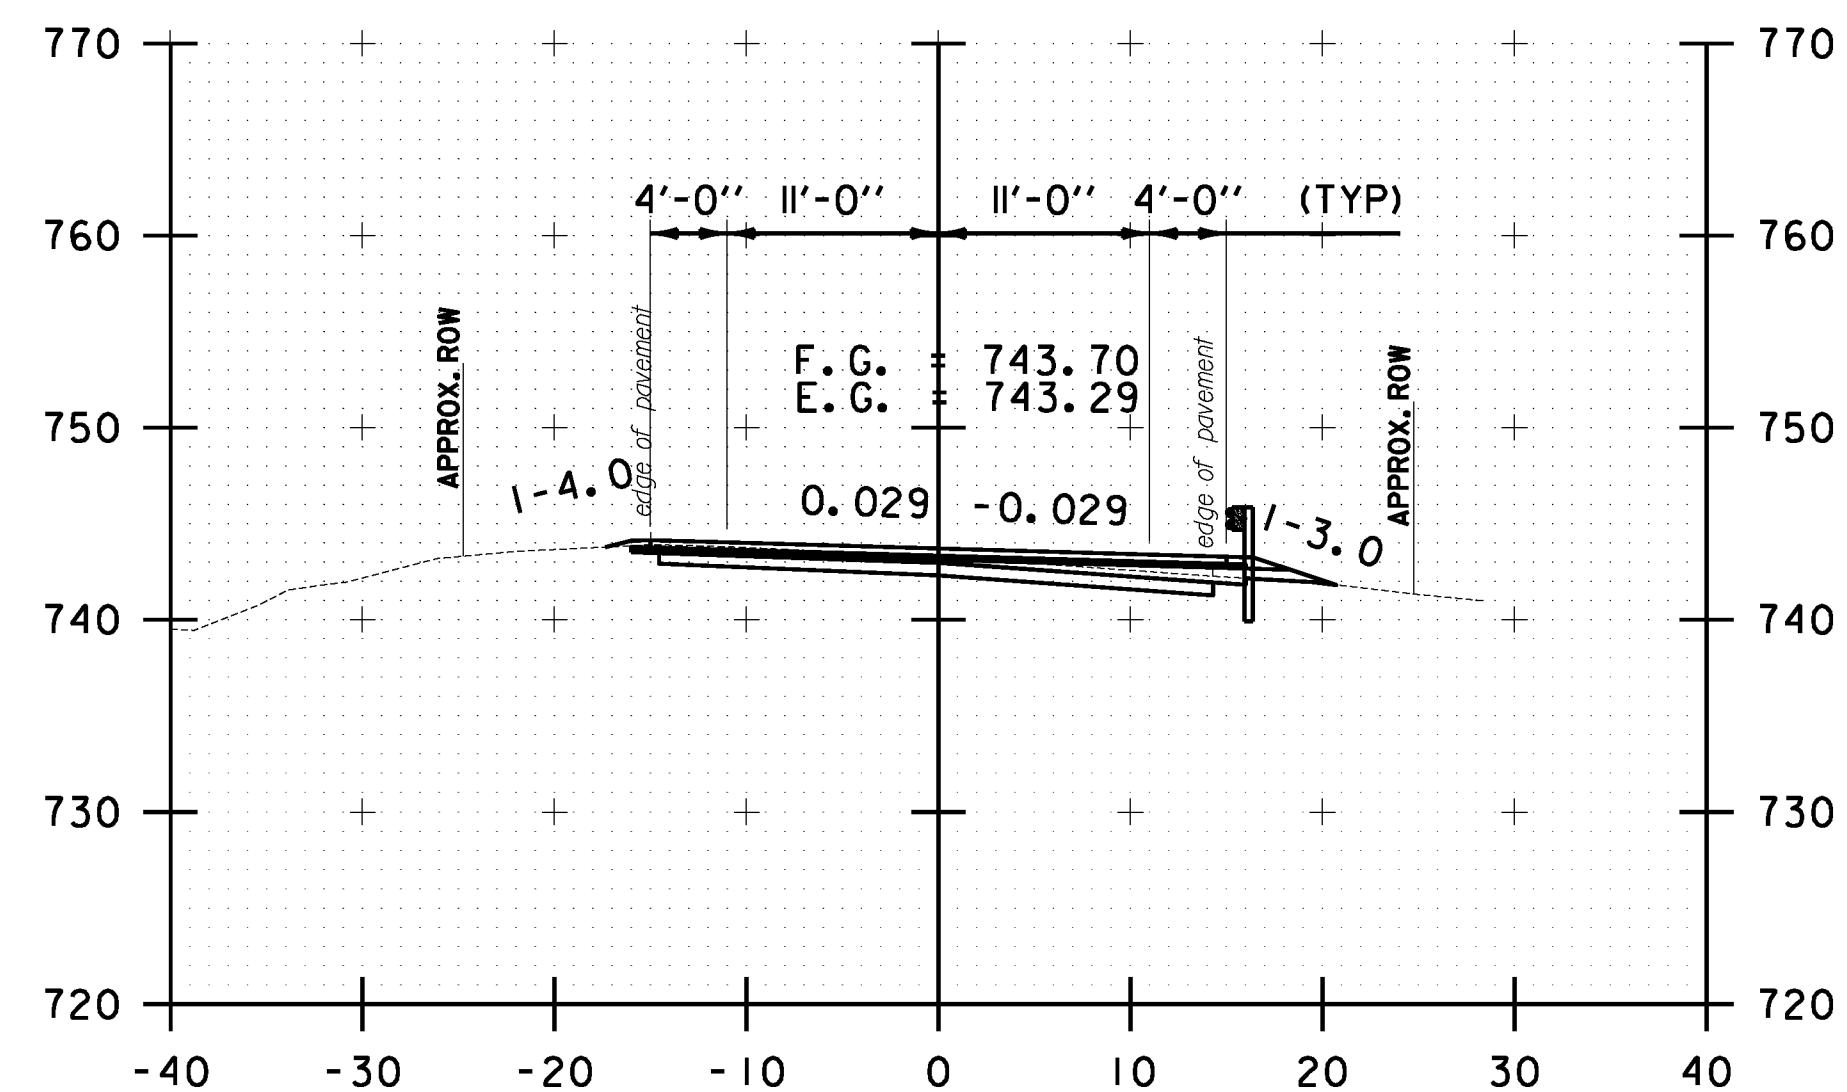


59+00.00

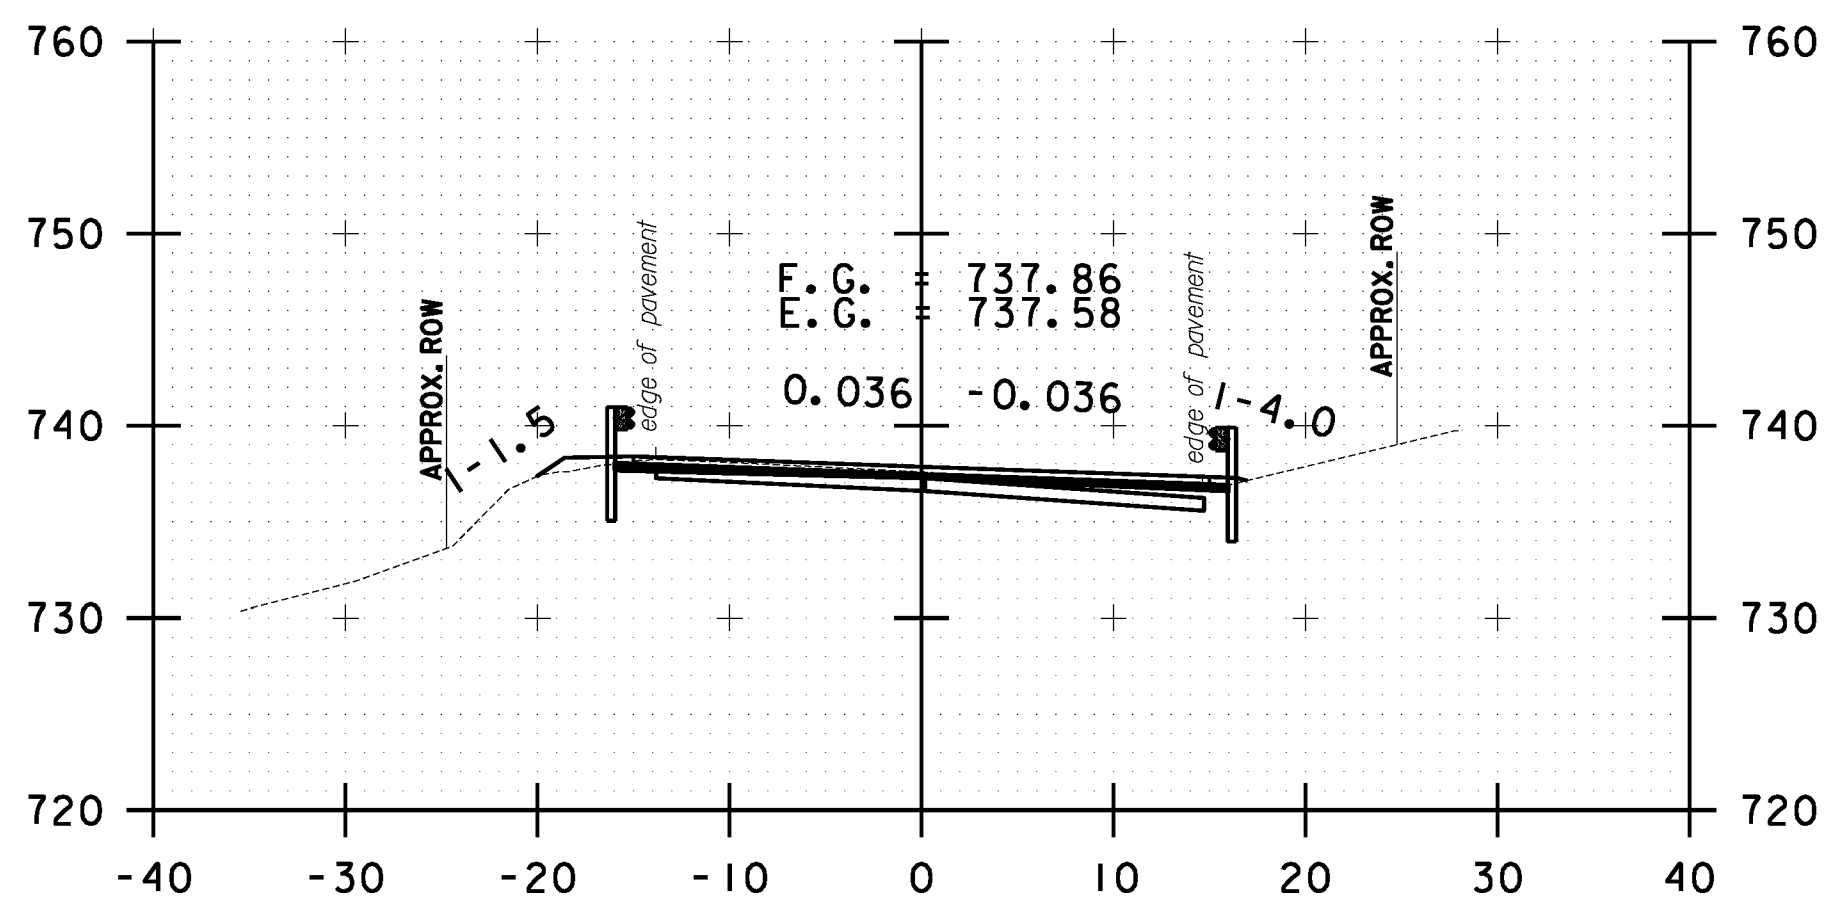

60+00.00

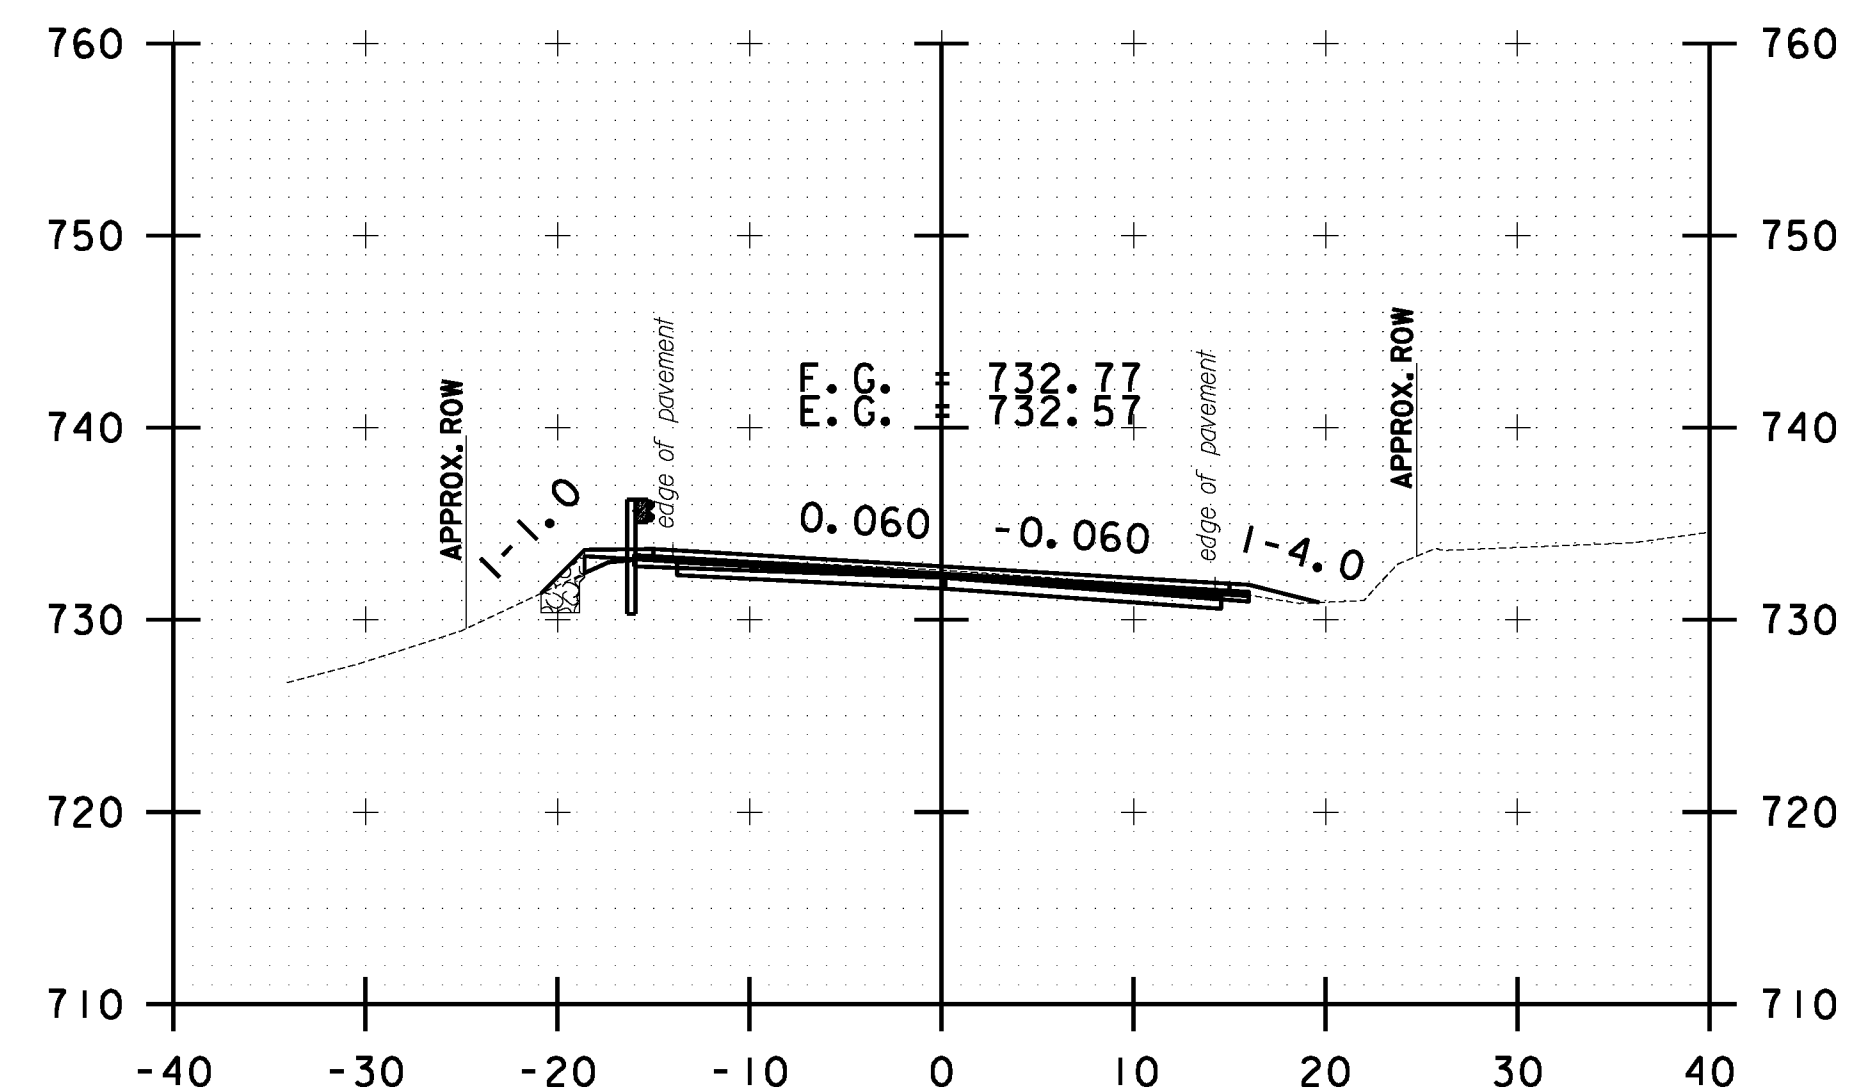

61+00.00

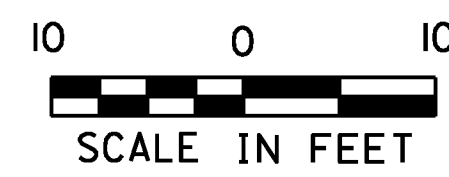

<b>STOCKBRIDGE CROSS SECTION SHEET #20</b>	PROJECT NAME: STOCKBRIDGE-BETHEL
	PROJECT NUMBER: STP 2910(1)
	FILE NAME: z10b214_stock_xc.dgn
	PLOT DATE: 3/17/2014
DESIGNED BY: L.M.B.	DRAWN BY: W.G.P.
IPARM FILE: z10b214xs20.1	CHECKED BY: J.P.S.
	SHEET 233 OF 397