




FILE NAME = Y:\P\c\as\1\NY\2\22425\CADD\MSTN\10b214_stock.nc.dgn
 DATE/TIME = 3/17/2014
 USER = 4916

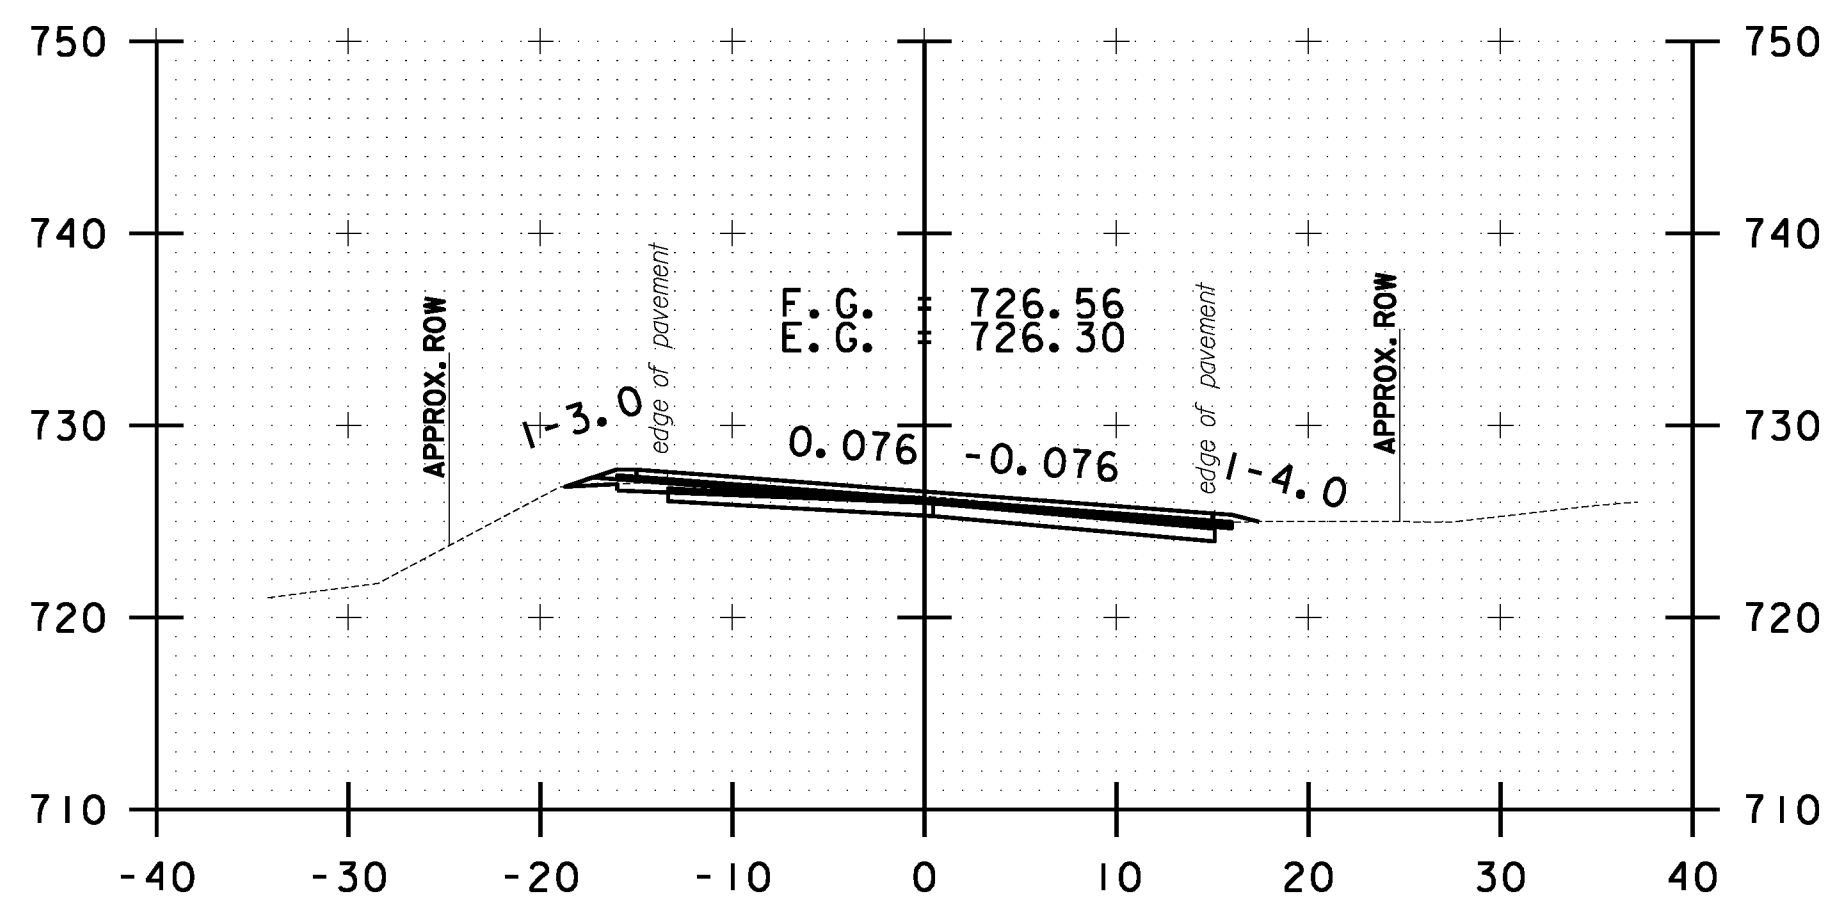


62+50.00

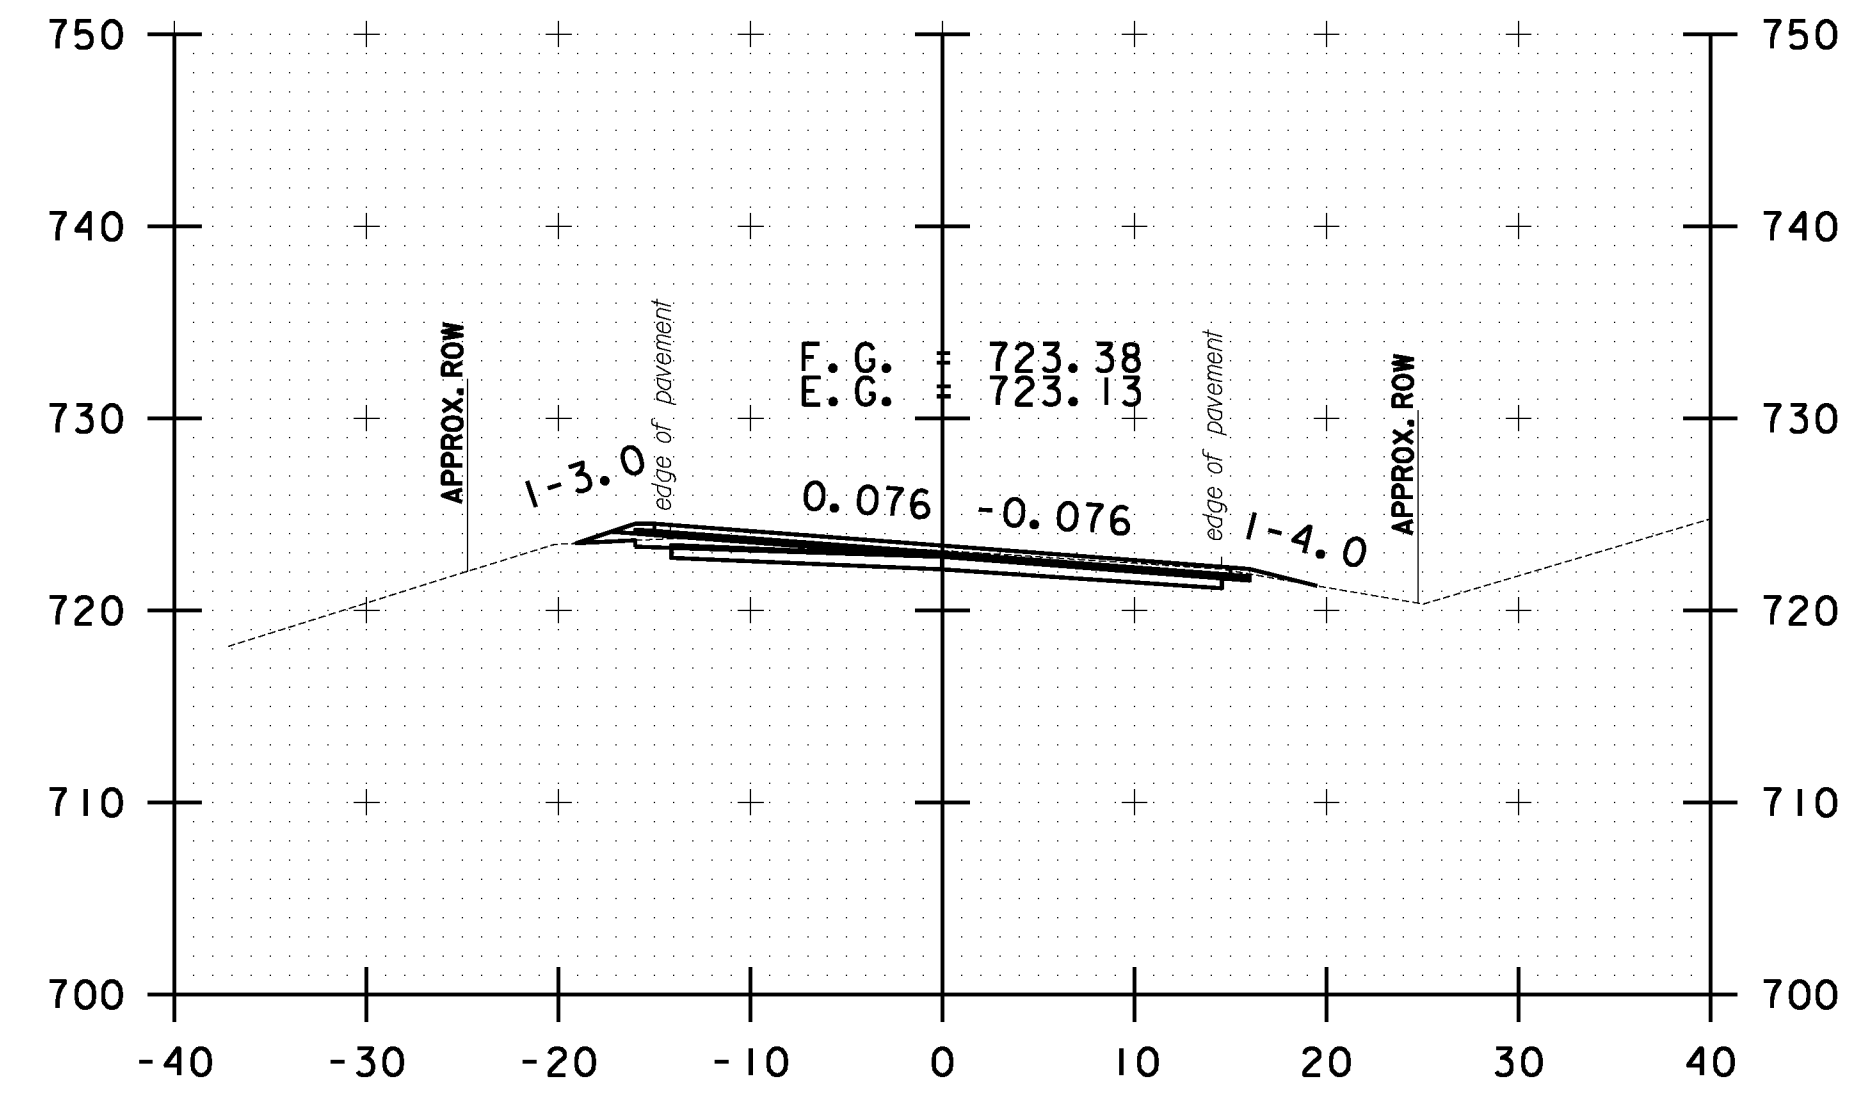


63+50.00

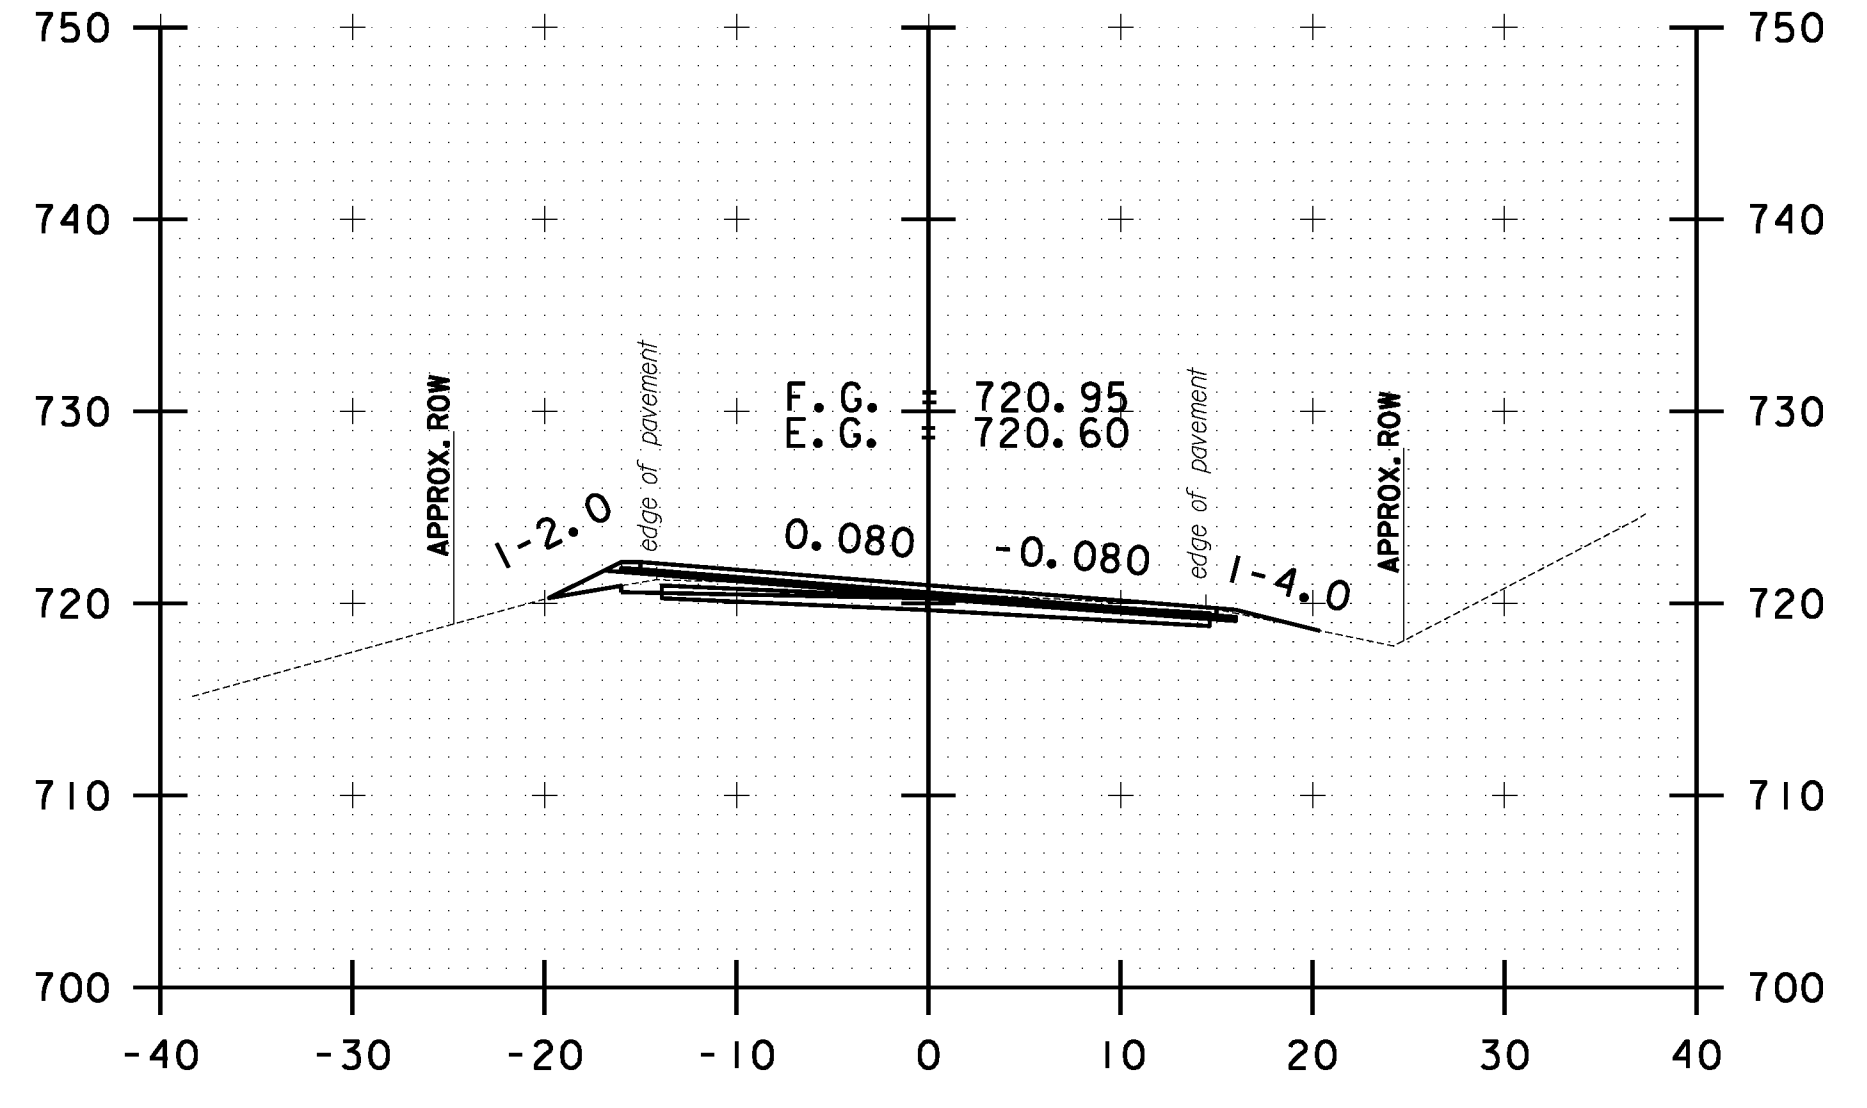


64+50.00

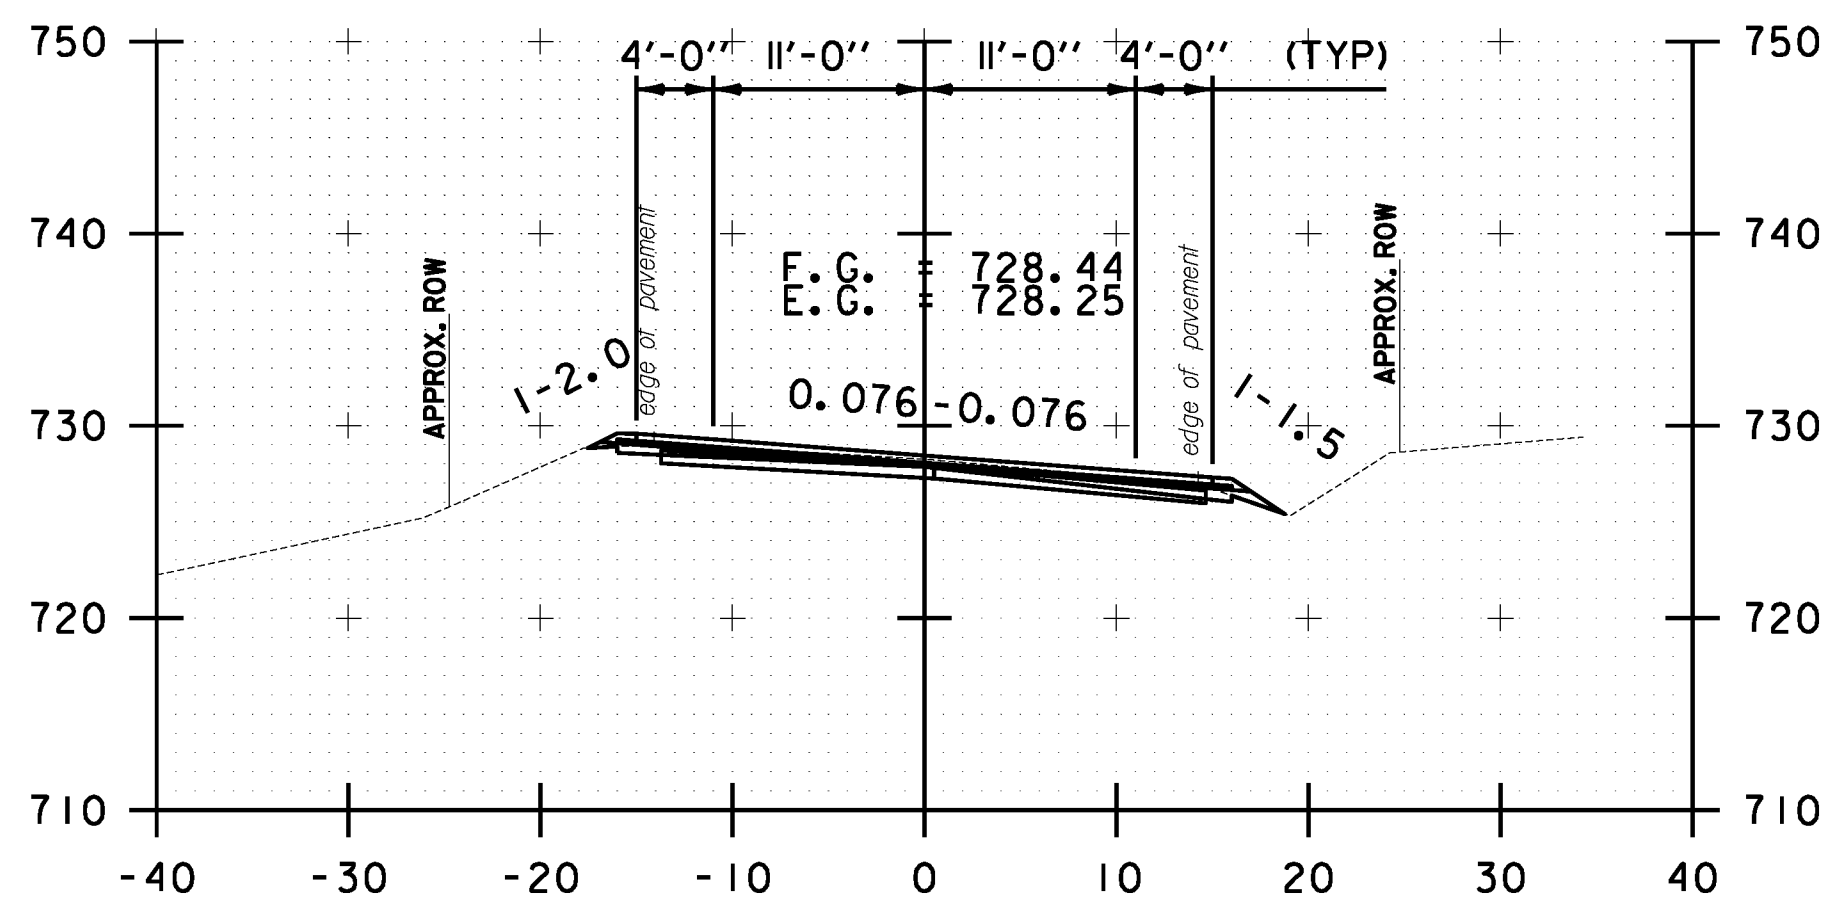


62+00.00

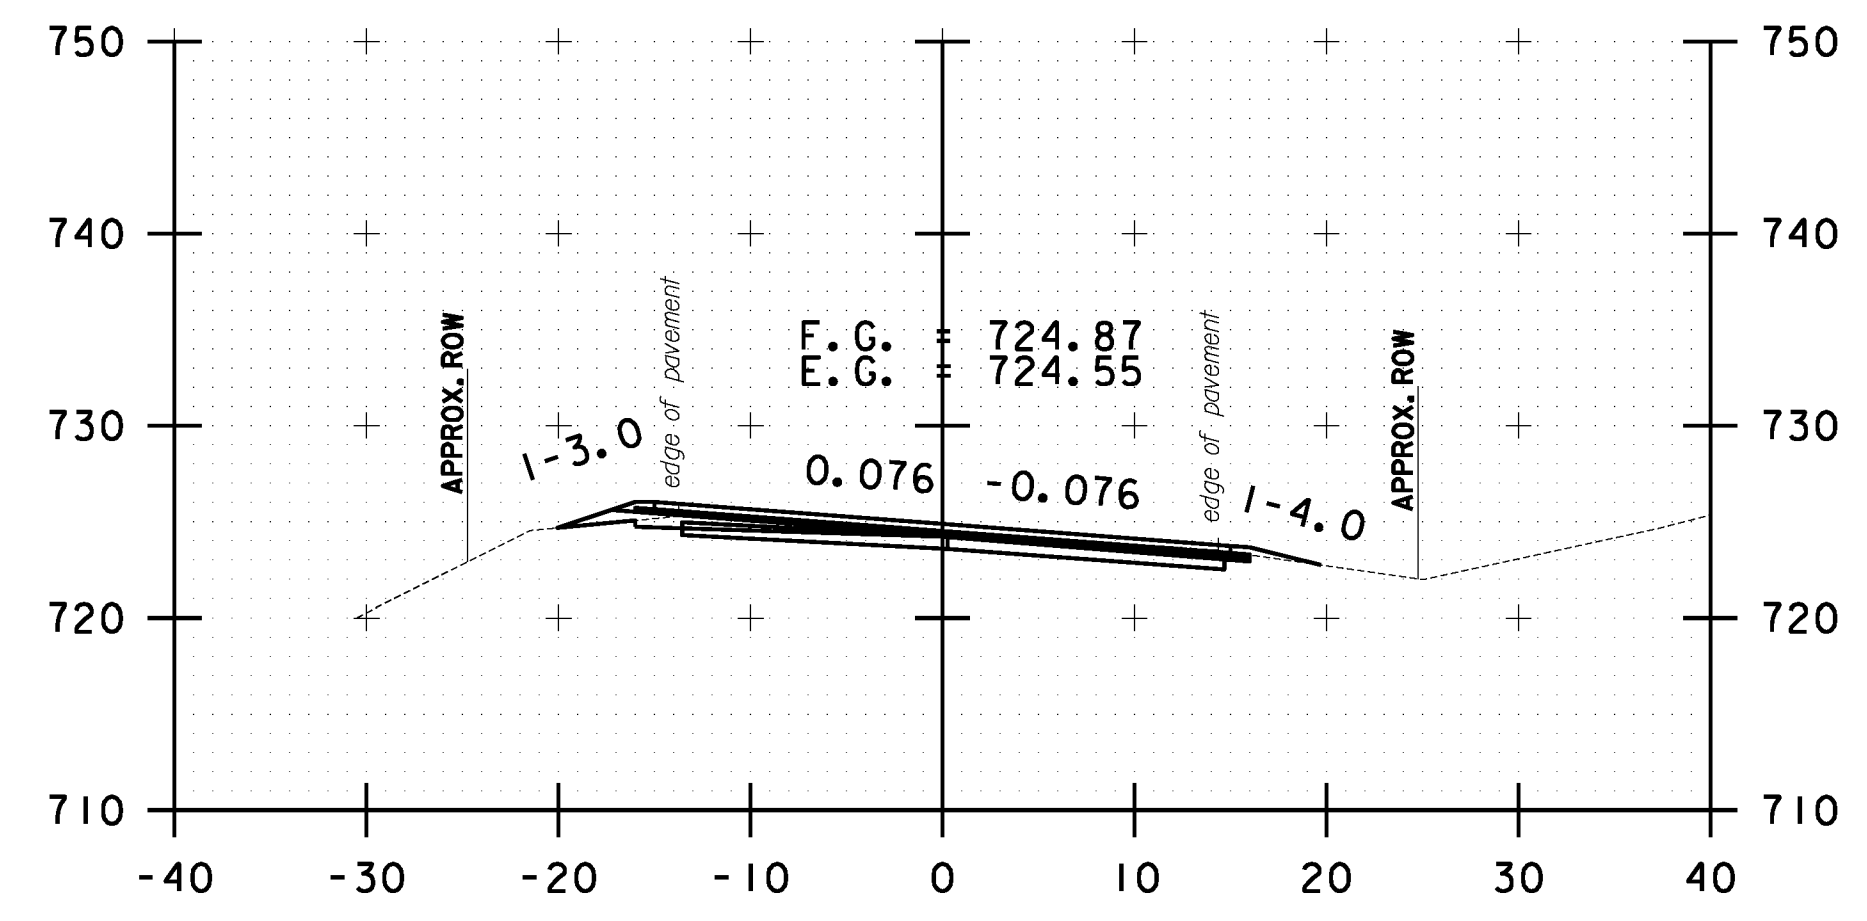

63+00.00

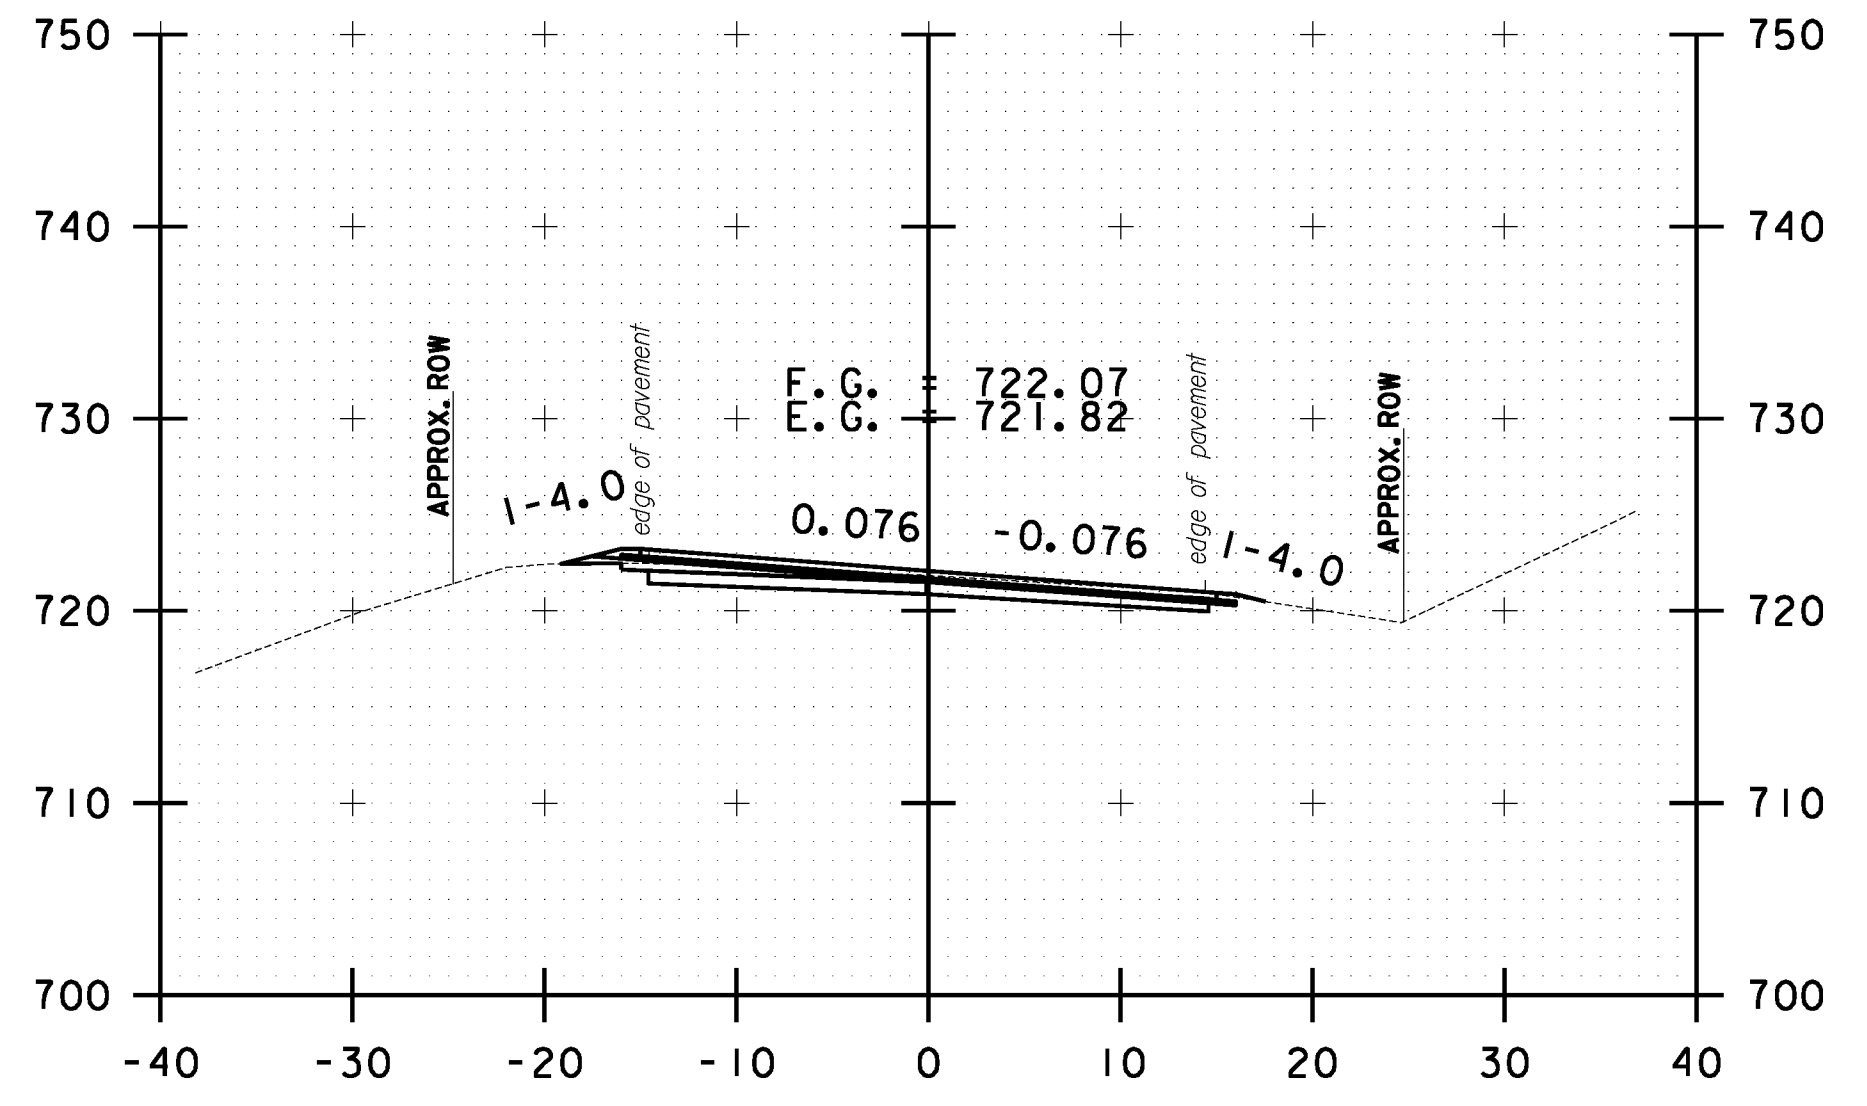

64+00.00

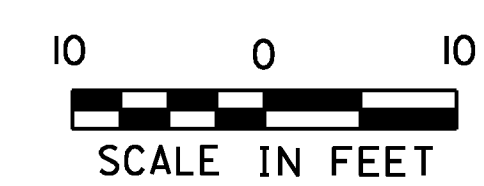

STOCKBRIDGE CROSS SECTION SHEET #21	PROJECT NAME: STOCKBRIDGE-BETHEL
	PROJECT NUMBER: STP 2910(1)
	FILE NAME: z10b214_stock.nc.dgn
	PLOT DATE: 3/17/2014
DESIGNED BY: L.M.B.	DRAWN BY: W.C.P.
IPARM FILE: z10b214xs21.1	CHECKED BY: J.P.S.
	SHEET 234 OF 397