




FILE NAME = Y:\P\c\p\stock\ANY\K2\22425\CADD\MSTN\10b214_stock_xc.dgn
 DATE/TIME = 3/17/2014
 USER = 4916

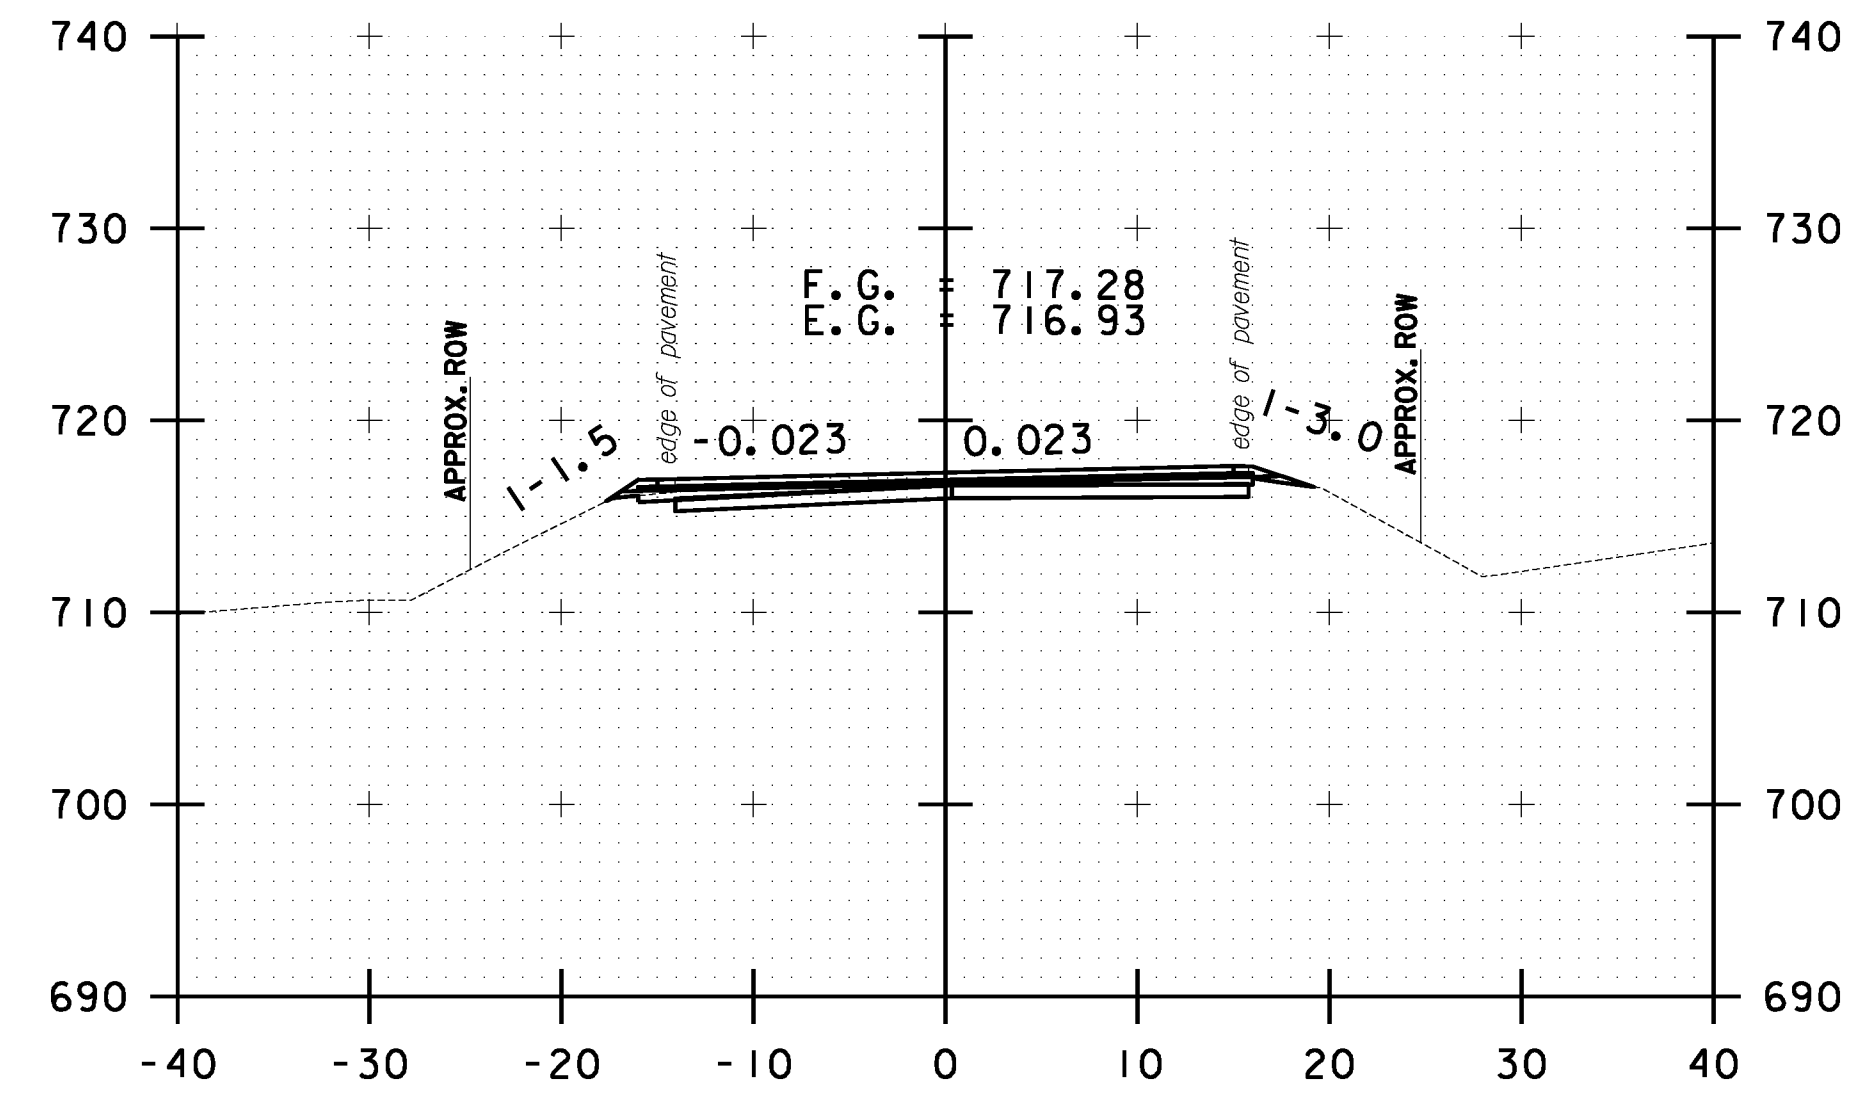


69+00.00

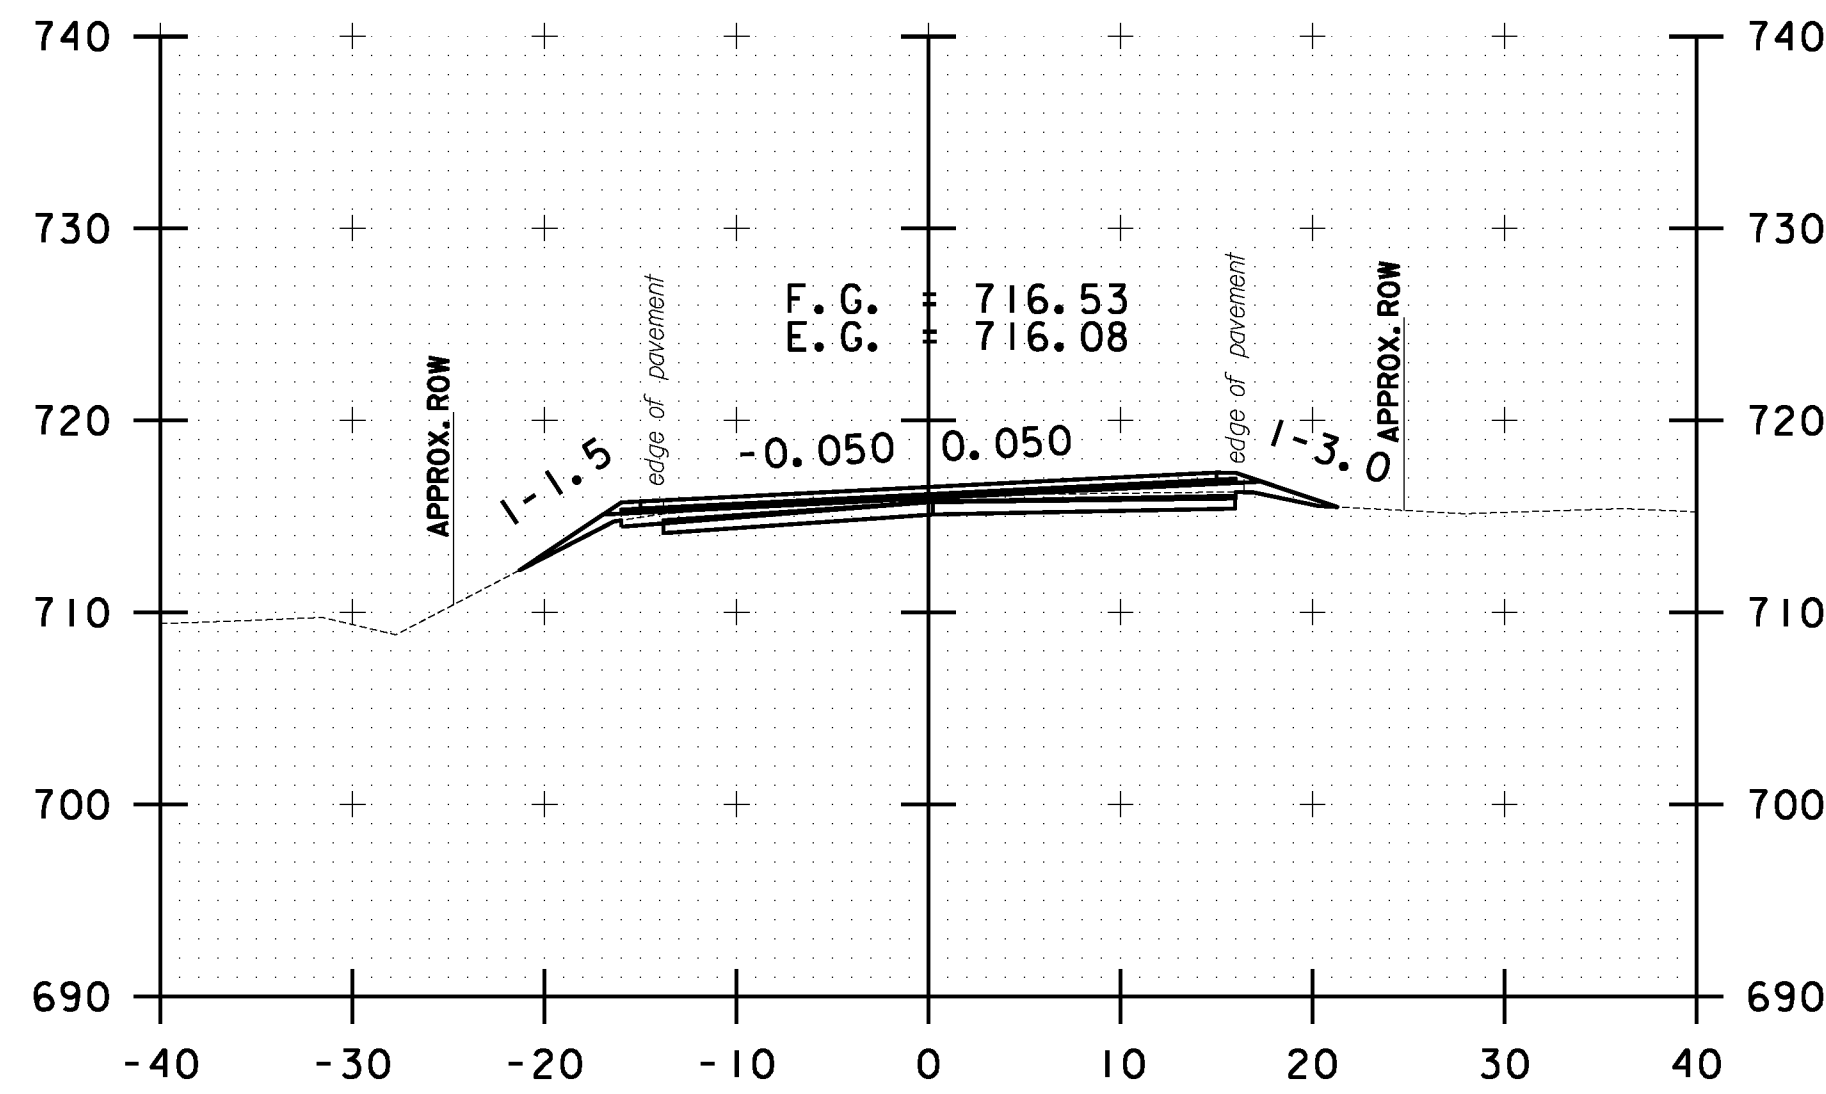


70+00.00

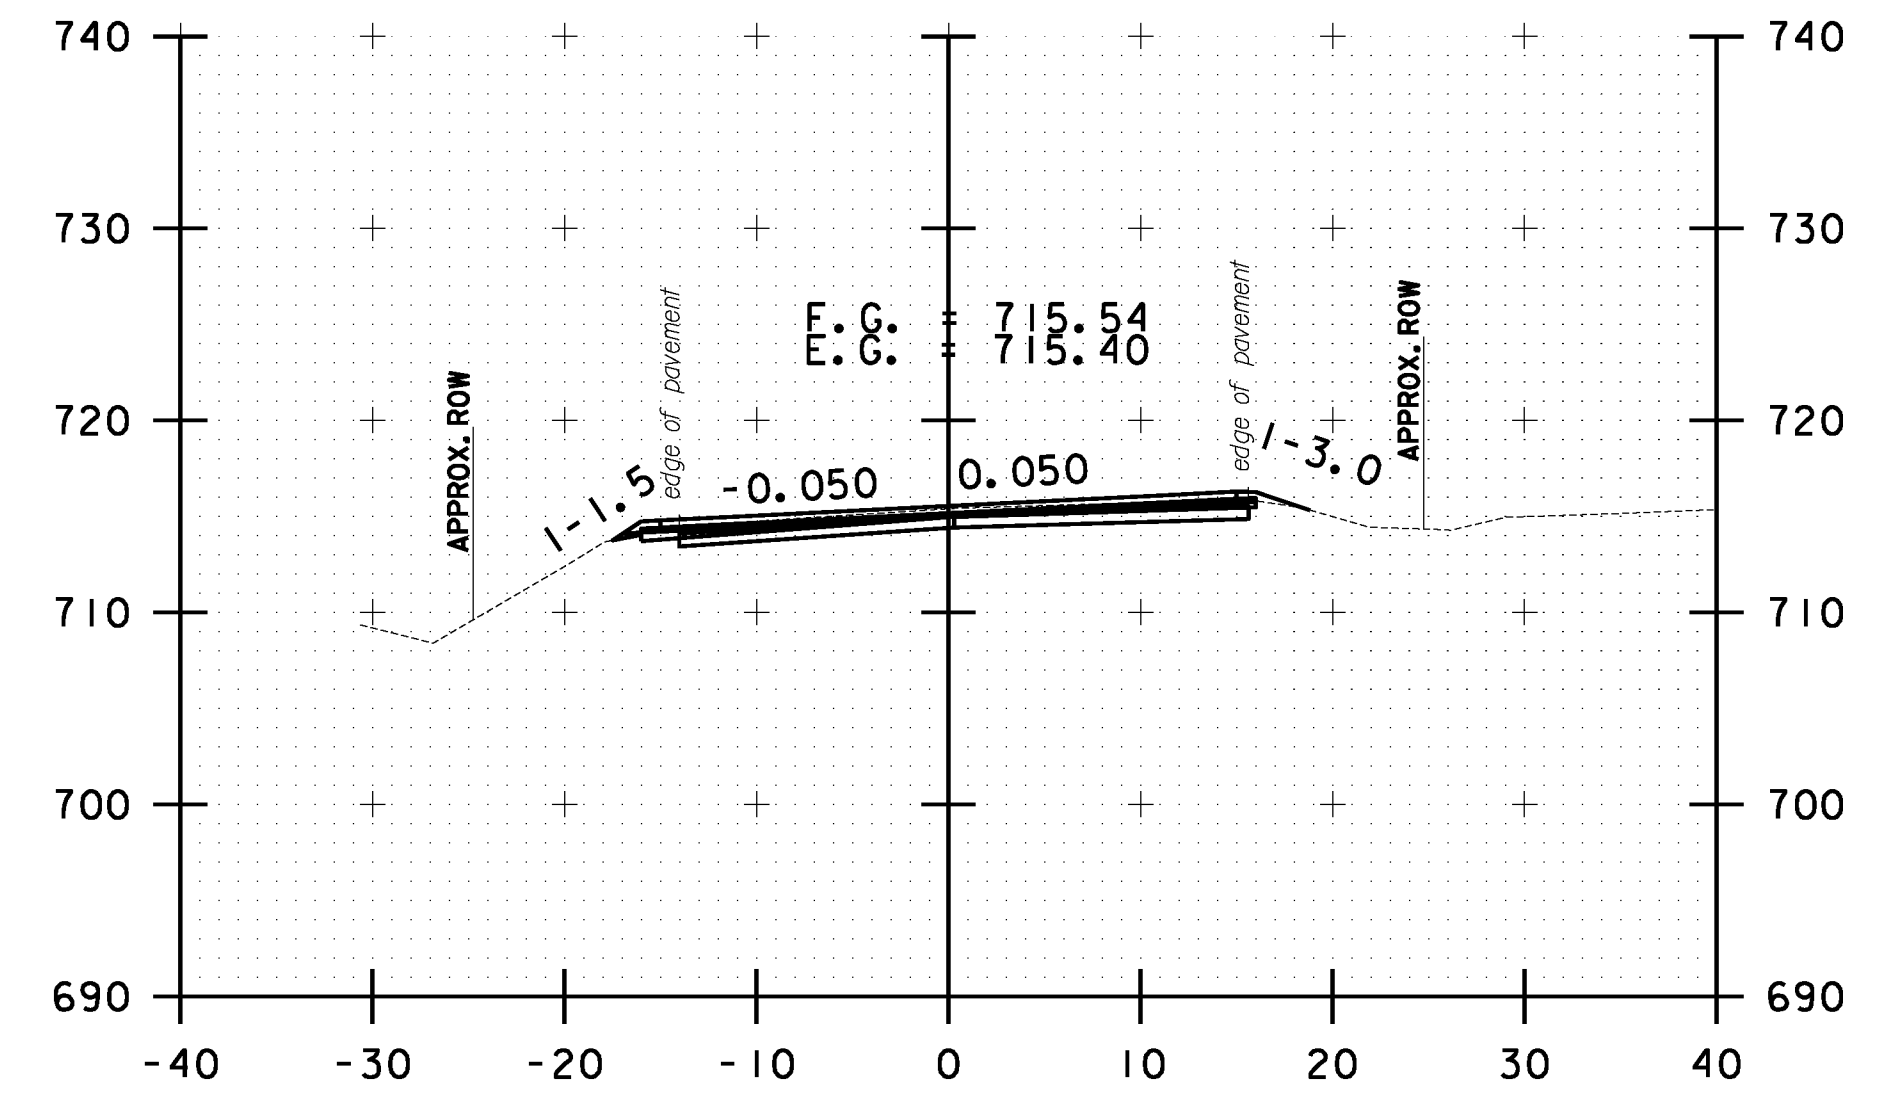


71+00.00

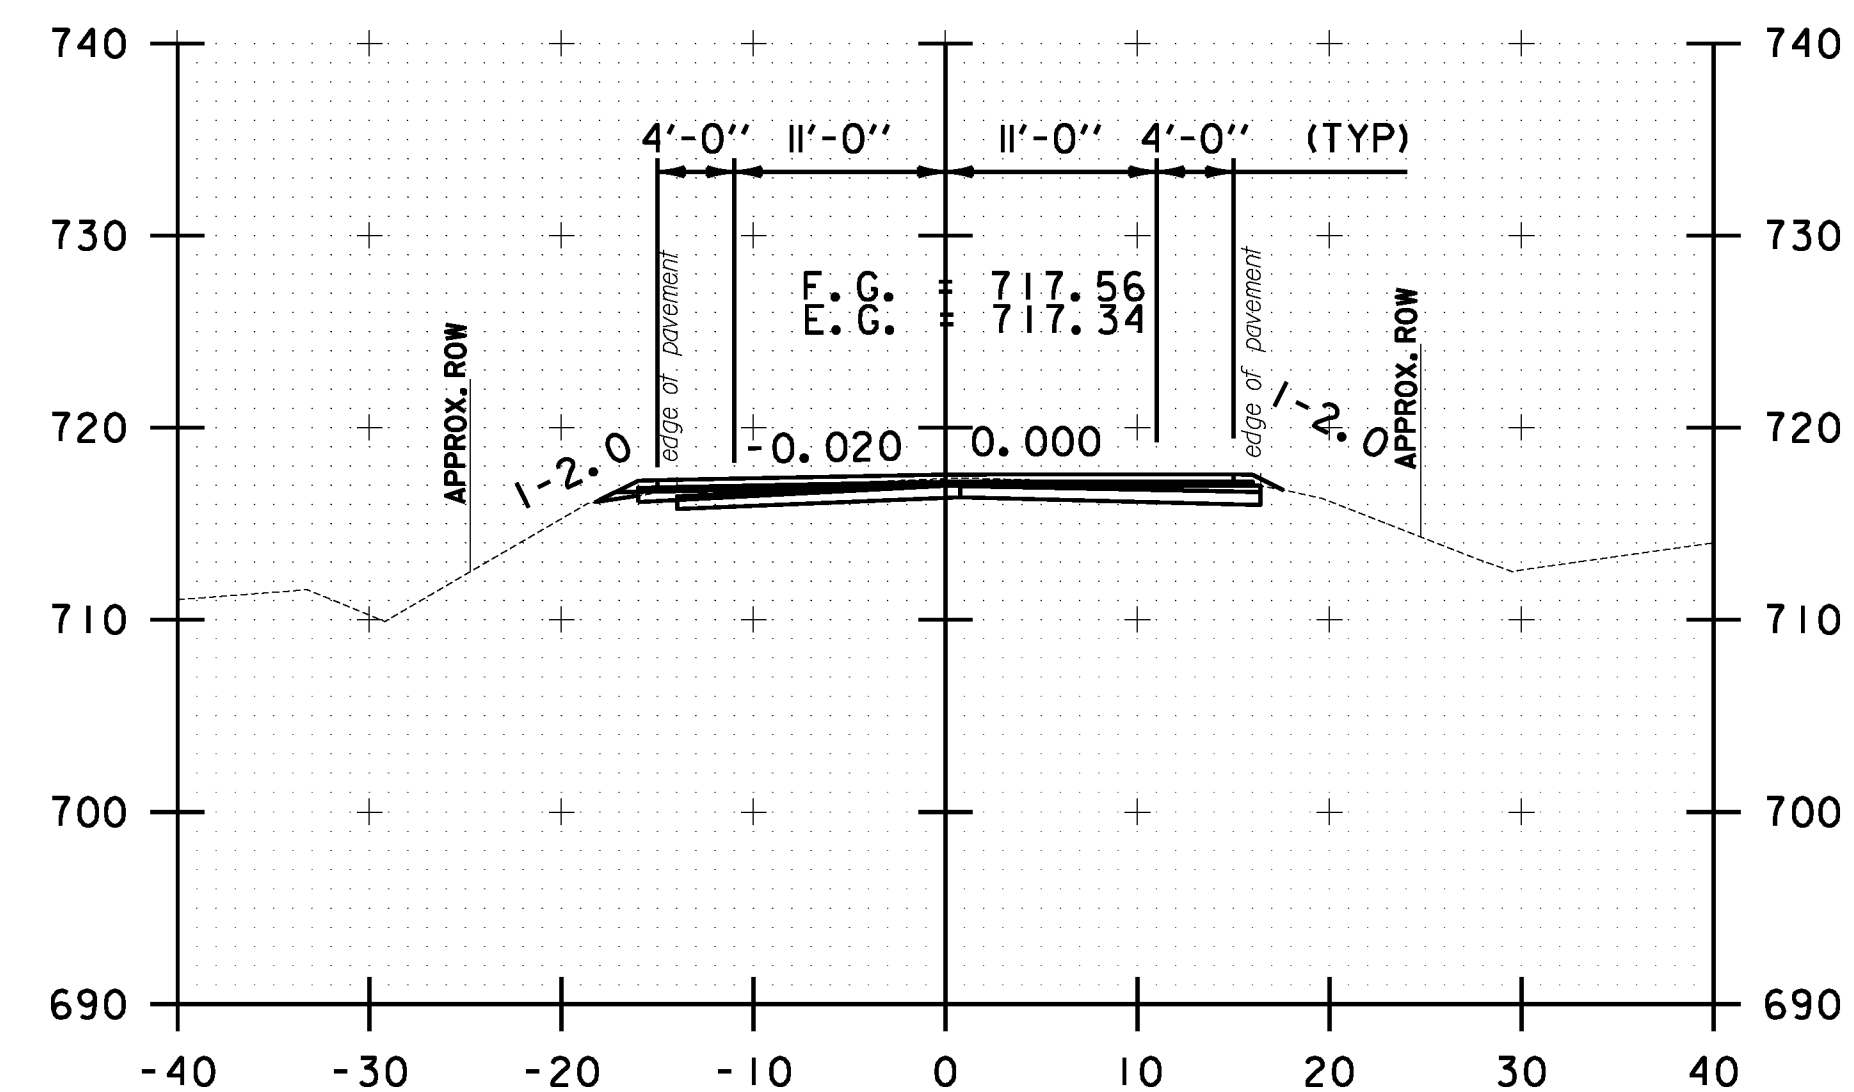

68+50.00

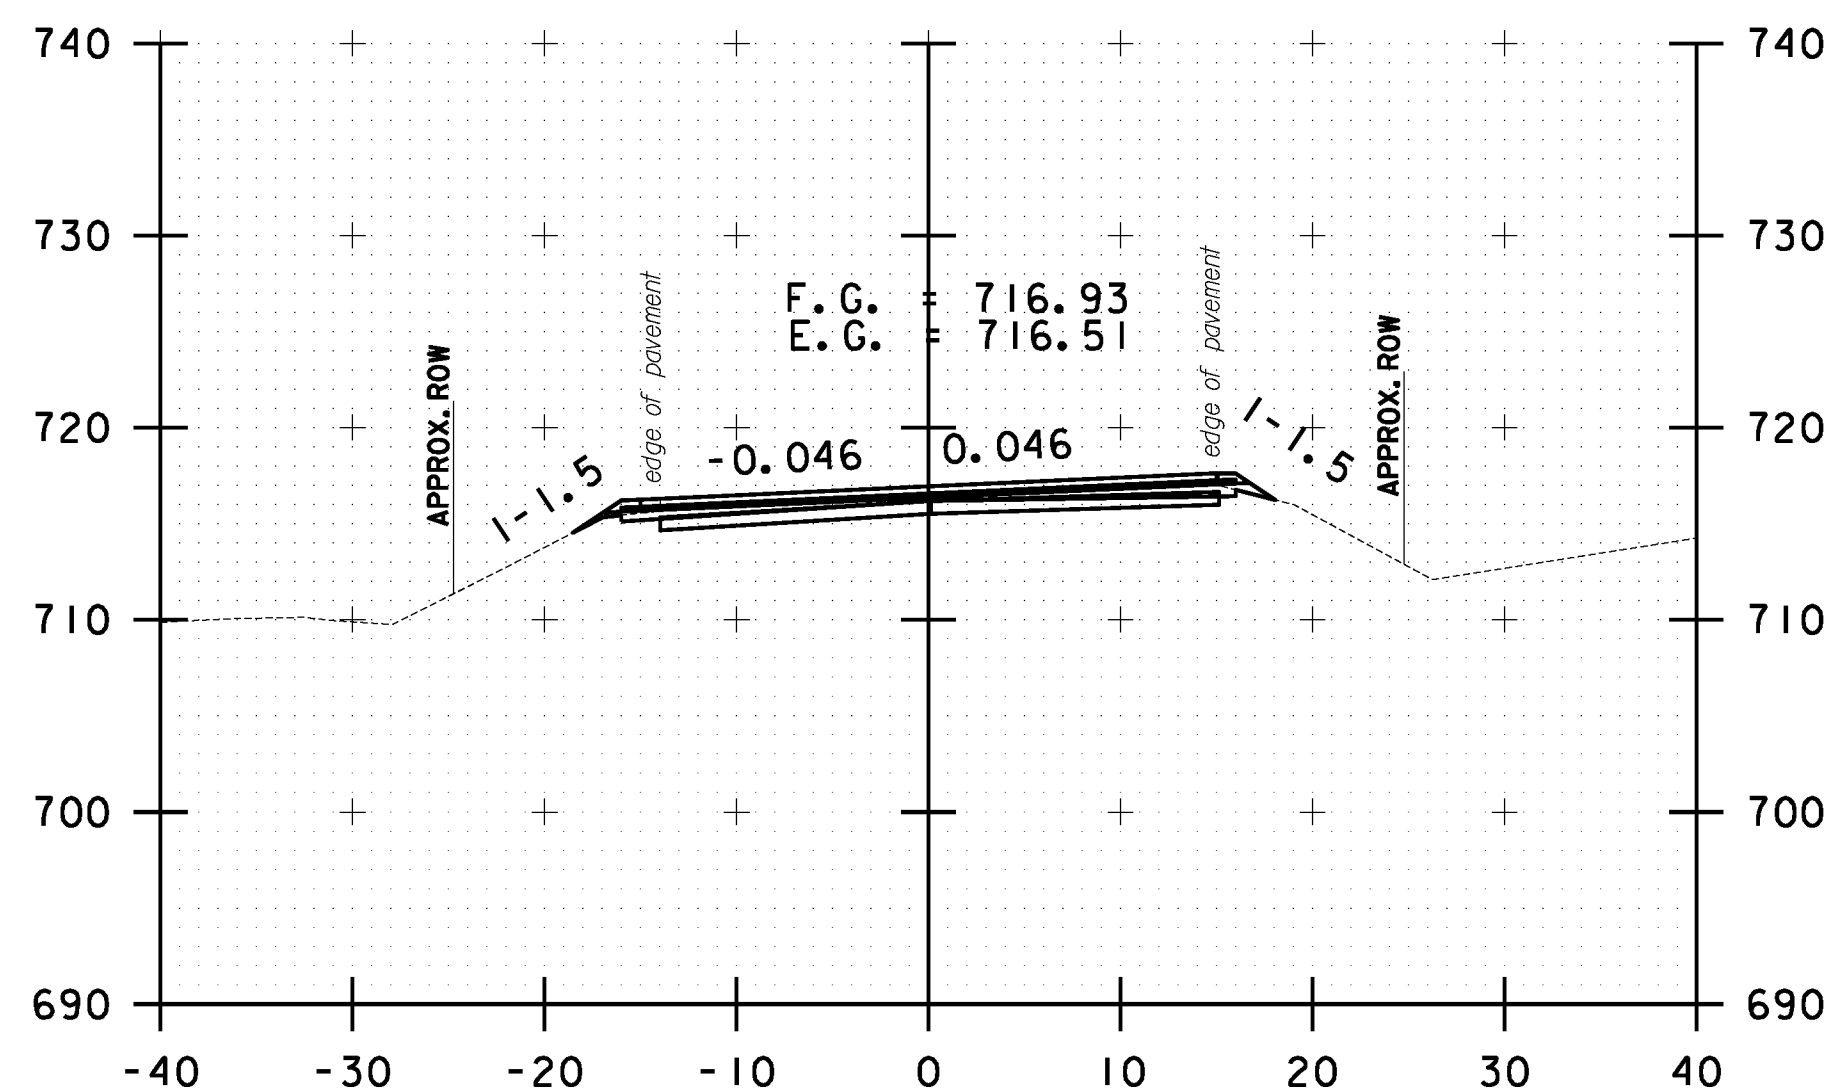

69+50.00

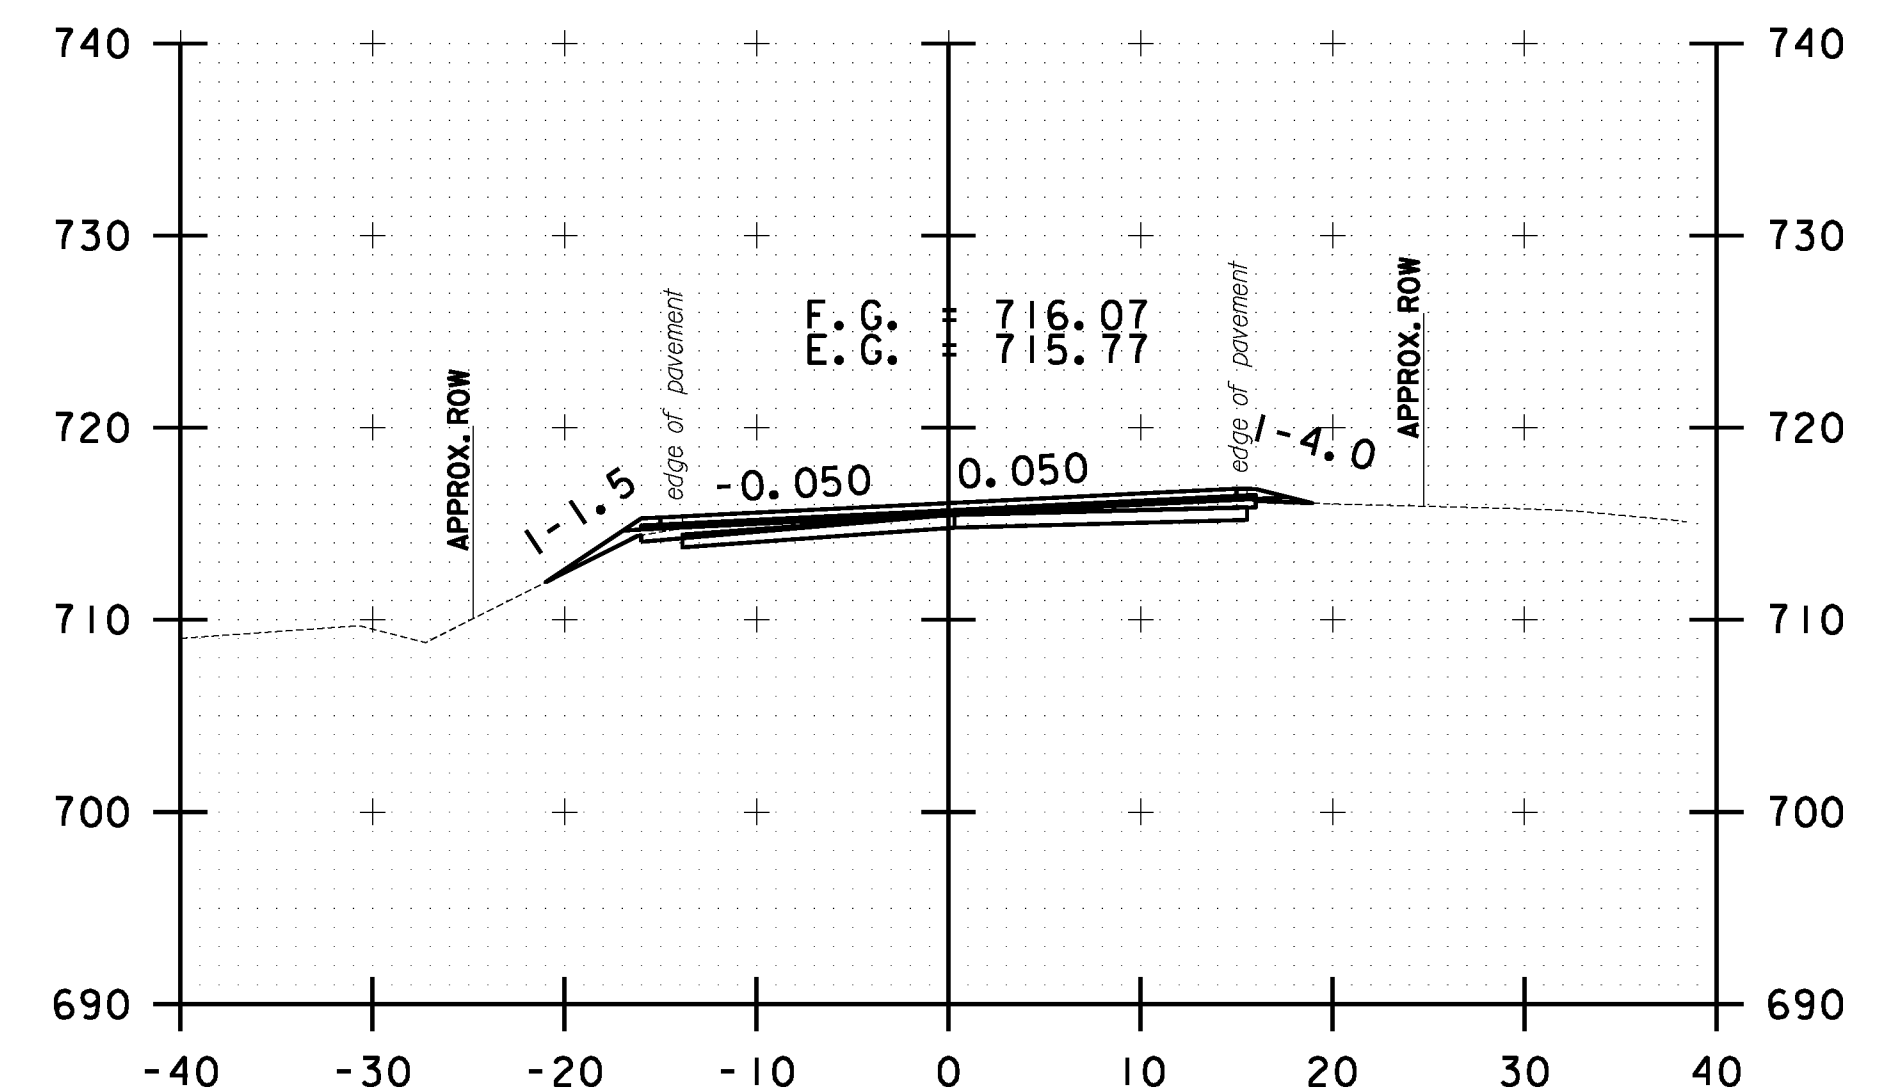

70+50.00



STOCKBRIDGE CROSS SECTION SHEET #23	PROJECT NAME: STOCKBRIDGE-BETHEL
	PROJECT NUMBER: STP 2910(1)
	FILE NAME: z10b214_stock_xc.dgn
	IPARM FILE: z10b214xs23.1
	PLOT DATE: 3/17/2014
	DRAWN BY: W.G.P.
	CHECKED BY: J.P.S.
	SHEET 236 OF 397