




FILE NAME = Y:\P\c\res\any\k2\22425\CADD\MSTN\10b214\_stock\_xc.dgn  
 DATE/TIME = 3/17/2014  
 USER = 4916

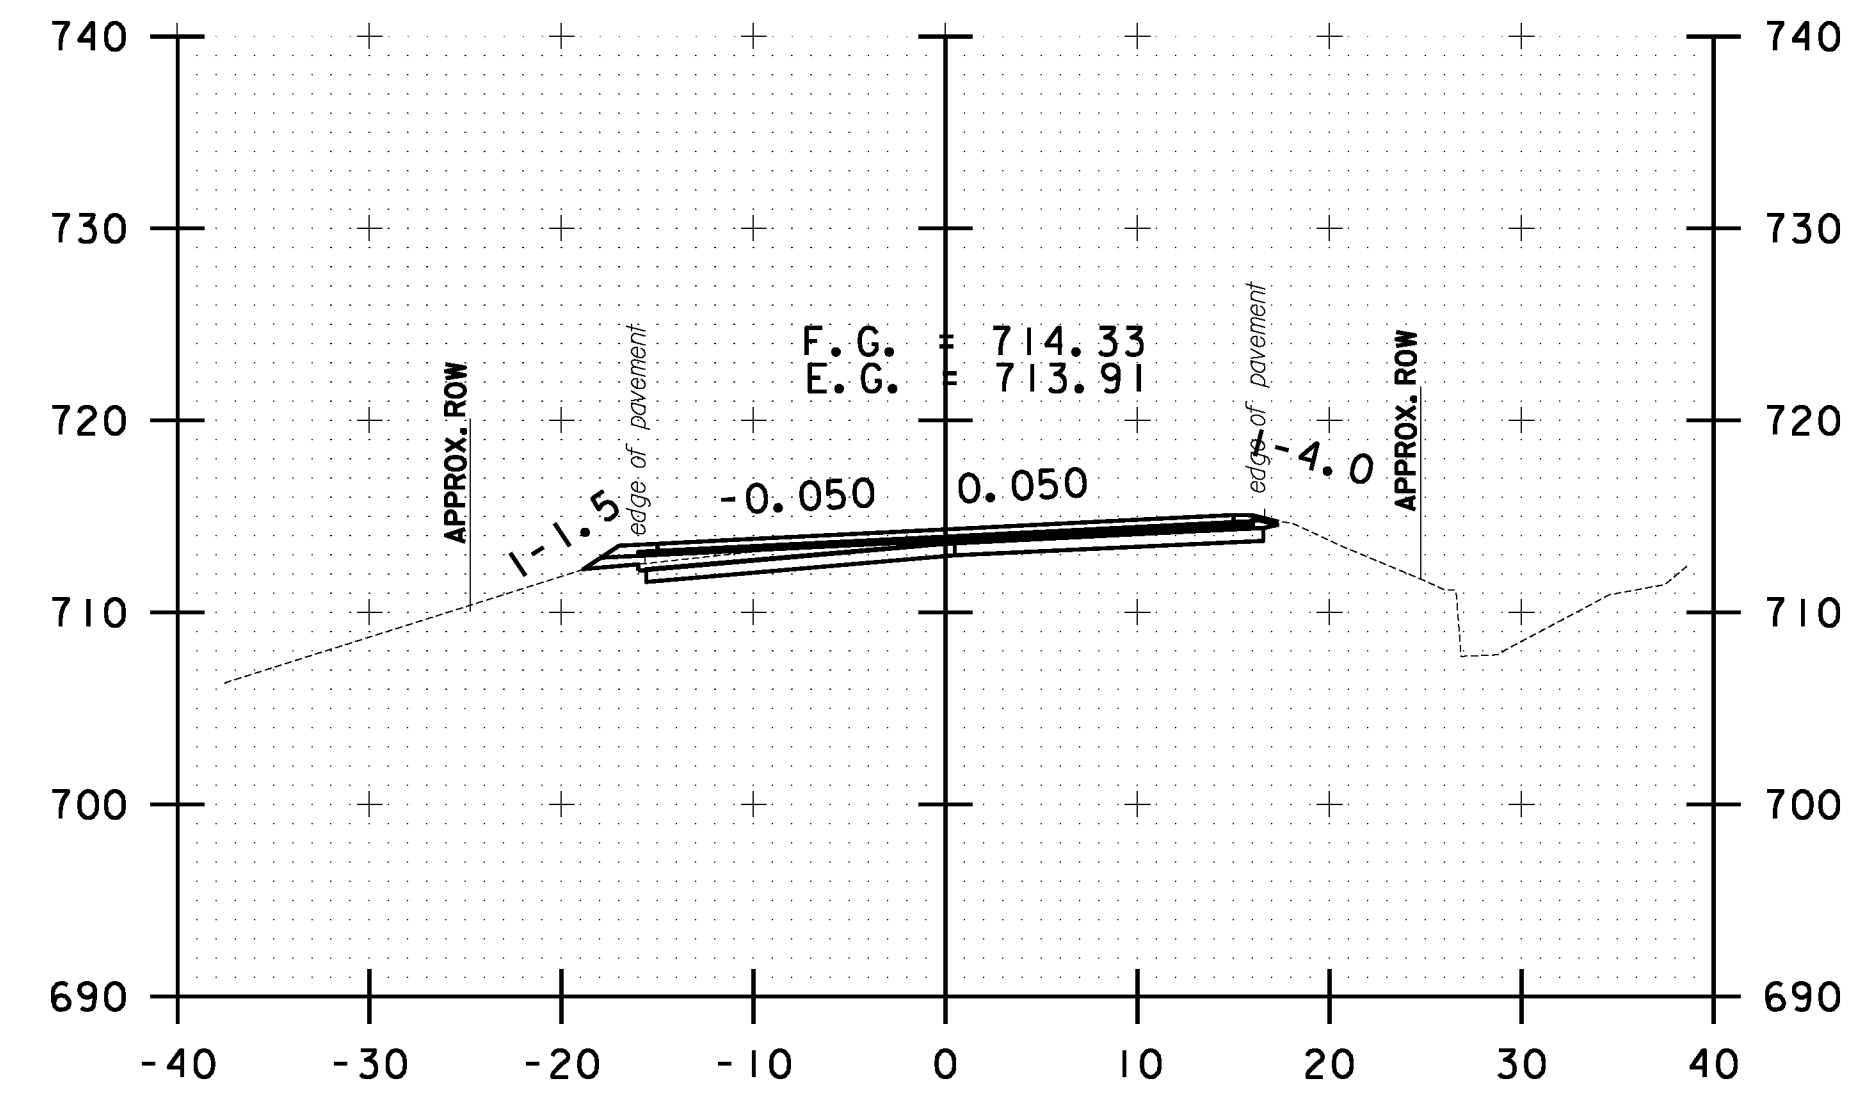


72+00.00

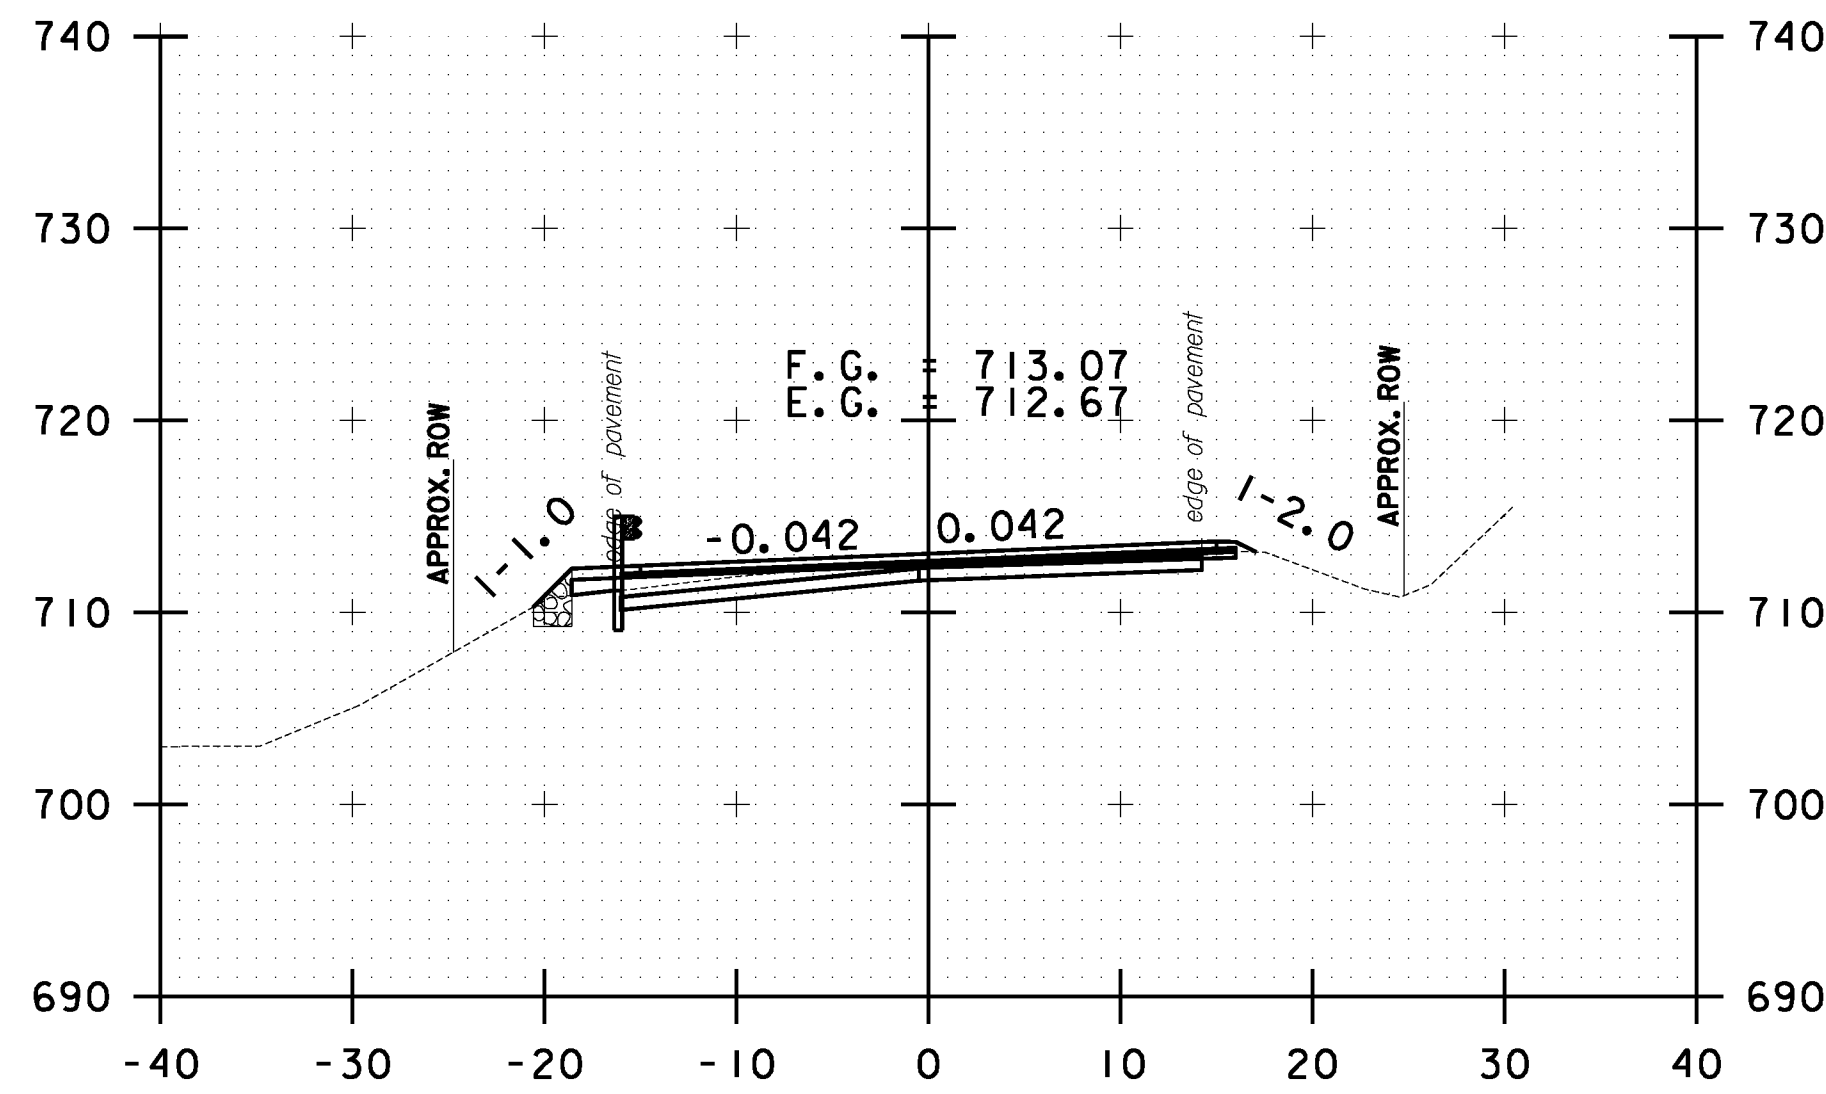


73+00.00

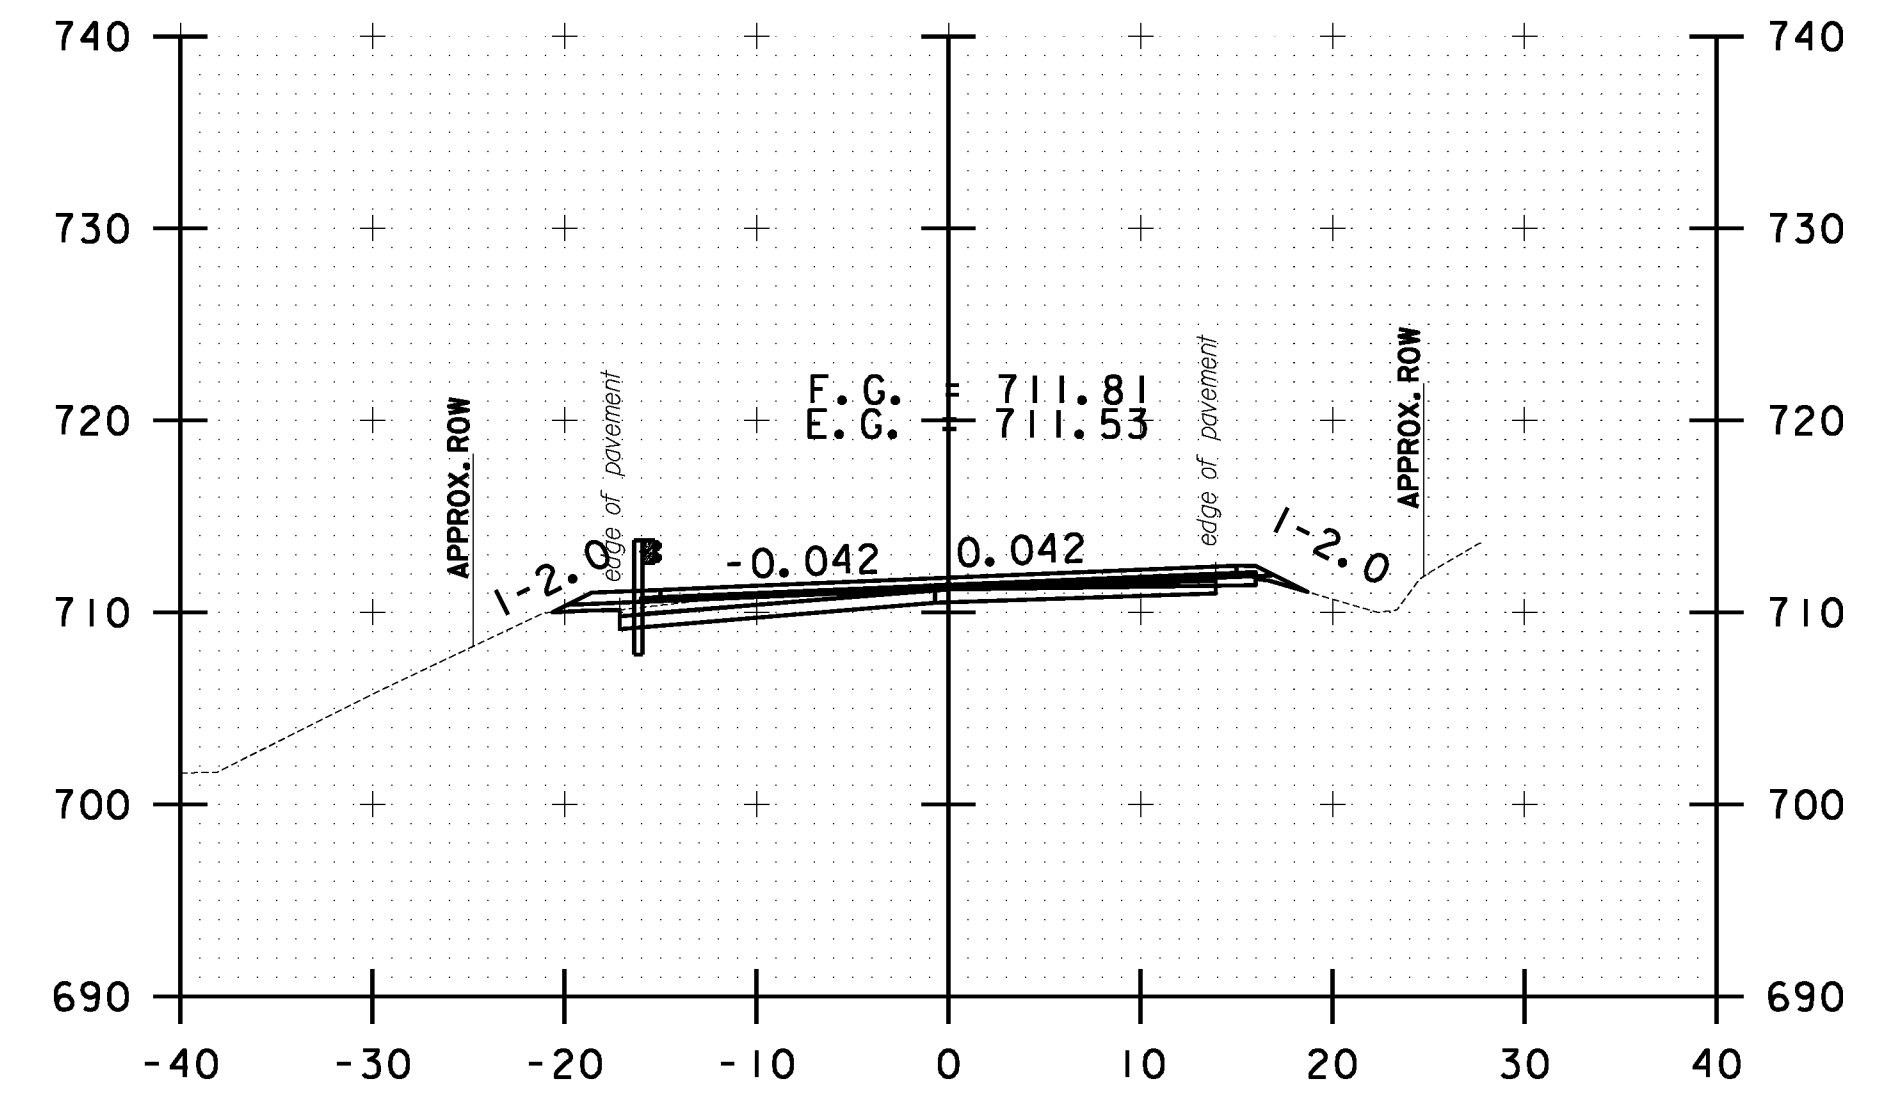


74+00.00

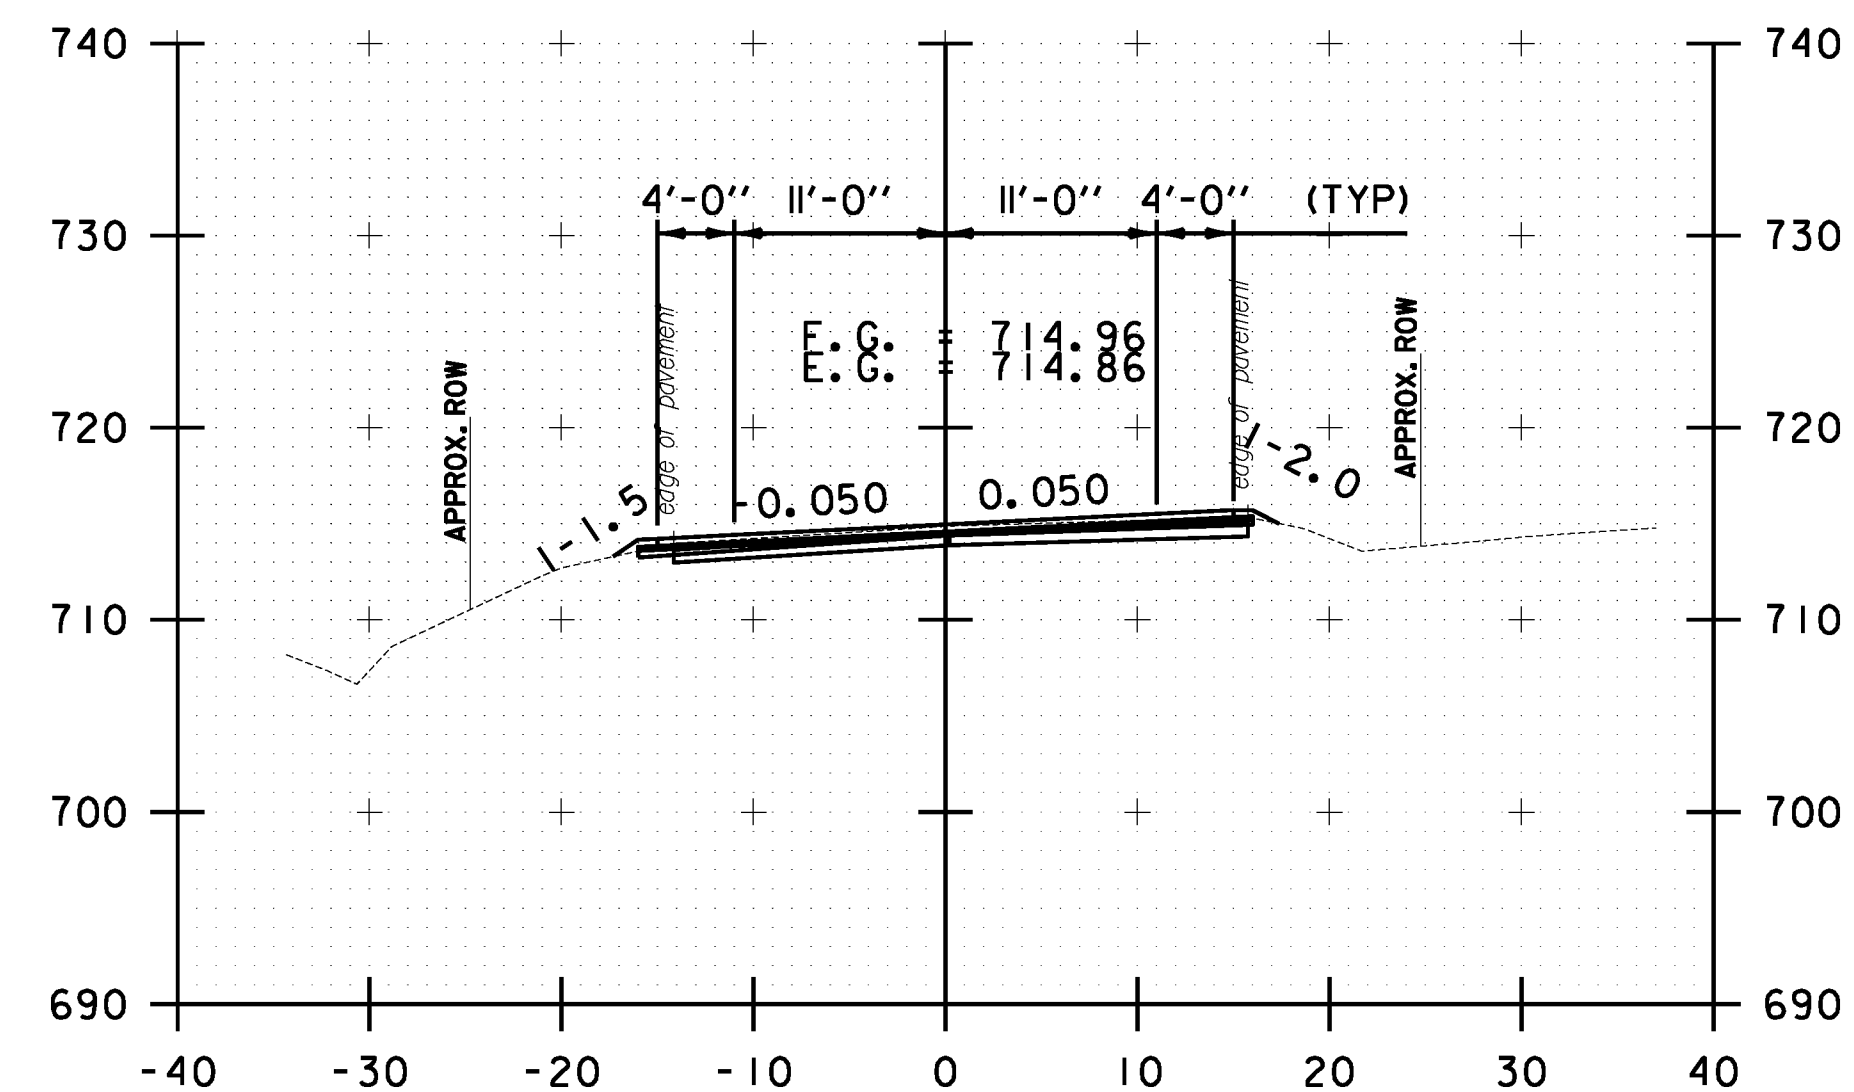

71+50.00

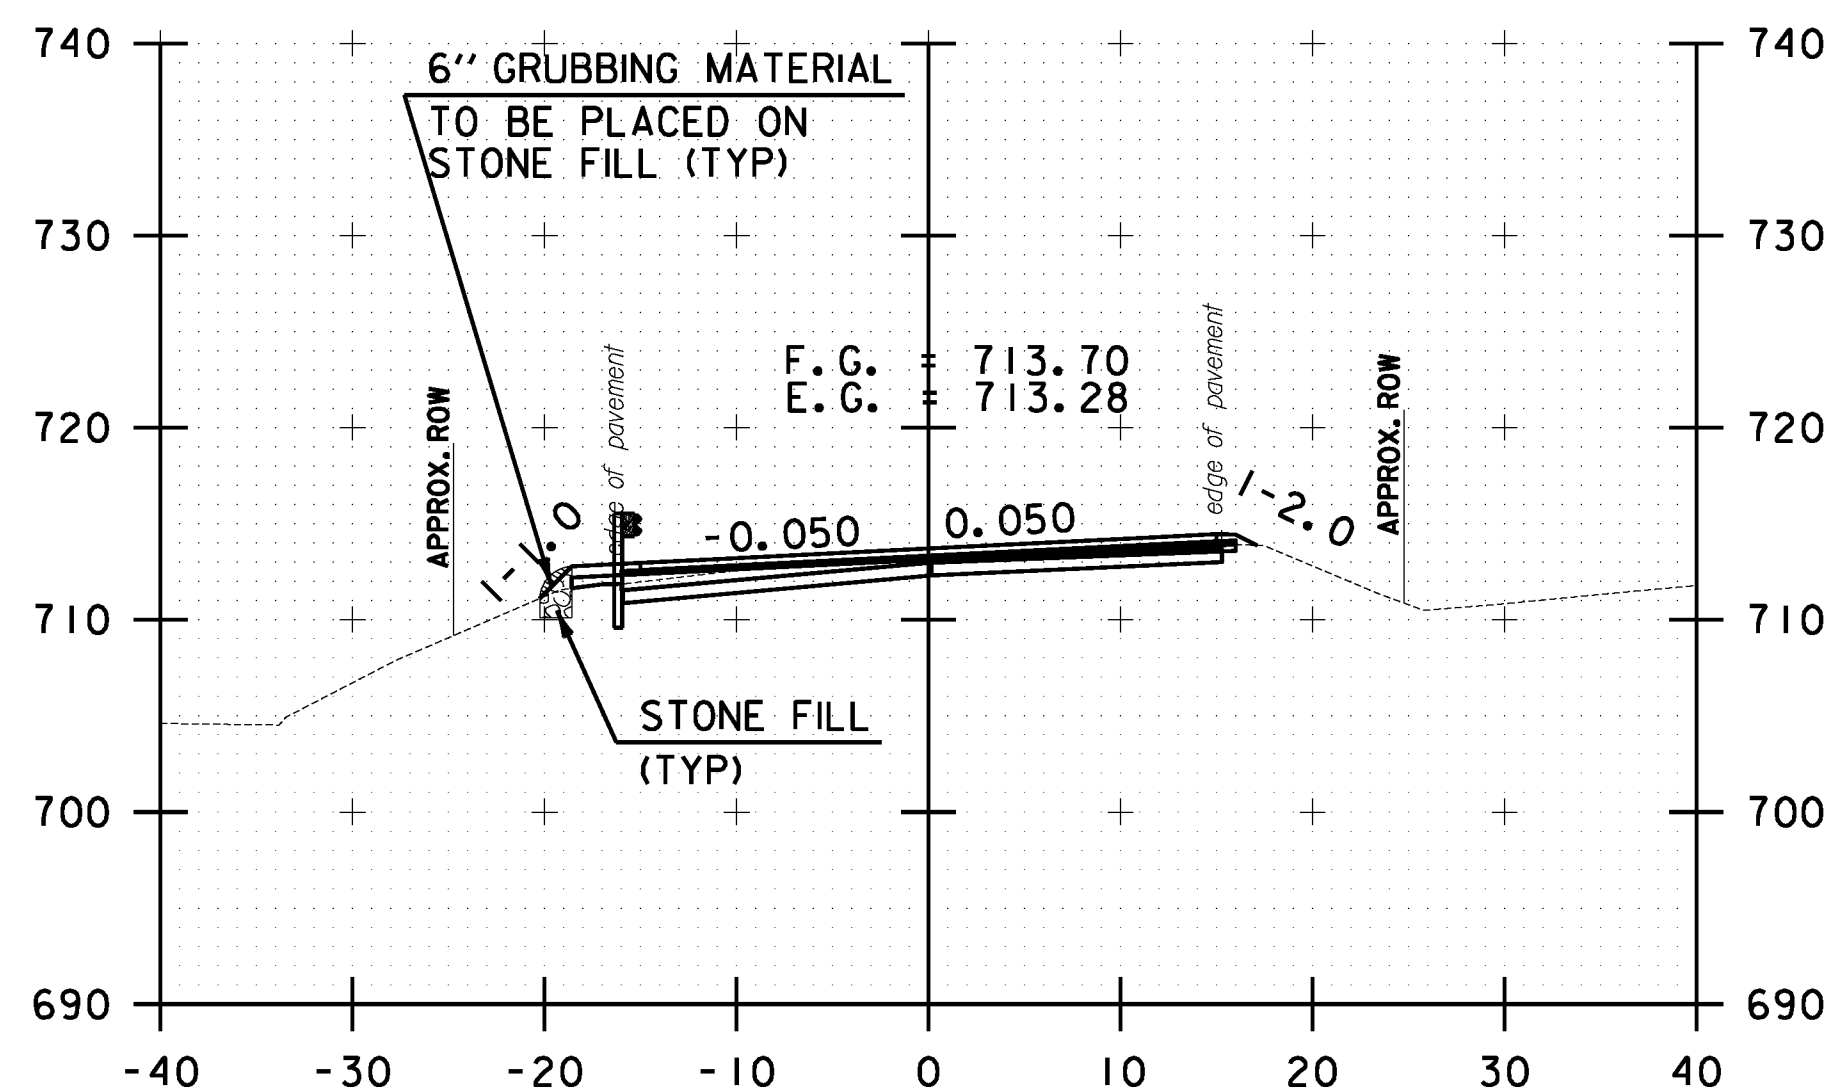

72+50.00

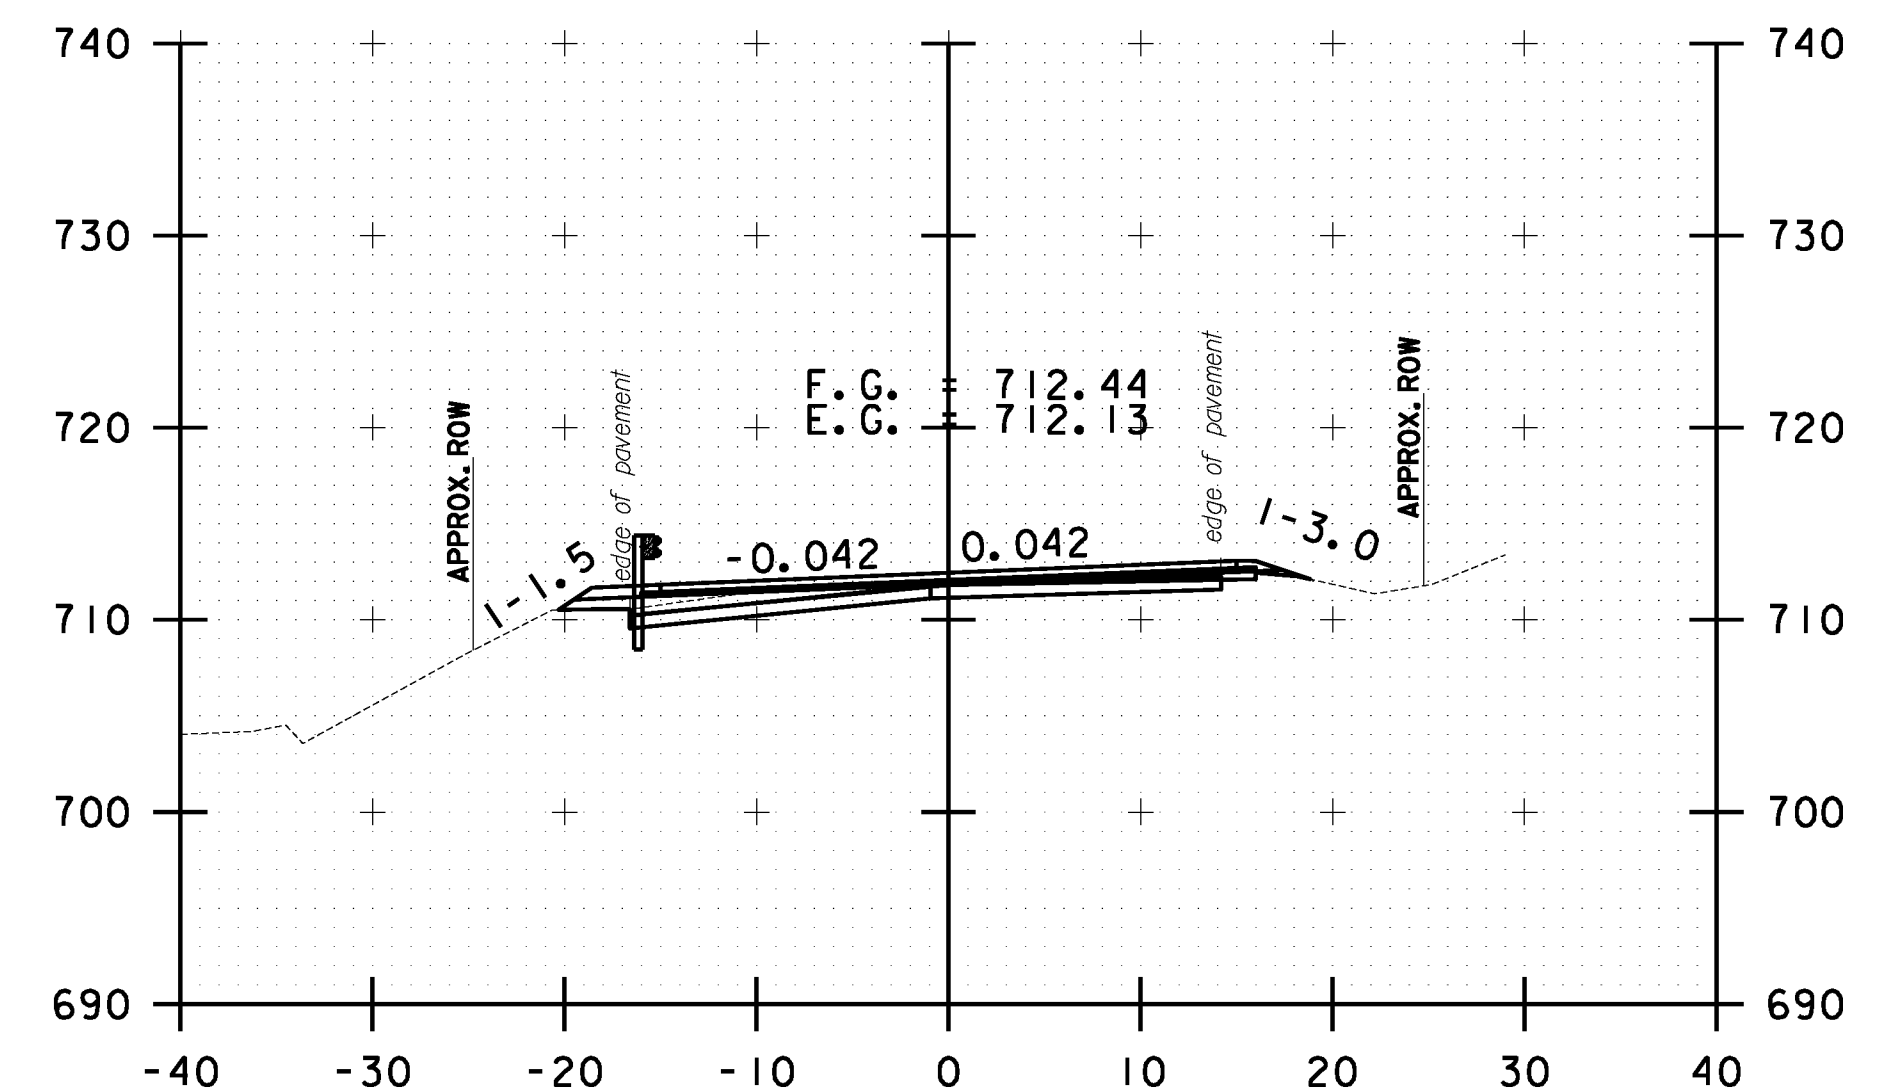

73+50.00



<b>STOCKBRIDGE CROSS SECTION SHEET #24</b>	PROJECT NAME: STOCKBRIDGE-BETHEL
	PROJECT NUMBER: STP 2910(1)
	FILE NAME: z10b214_stock_xc.dgn
	IPARM FILE: z10b214xs24.1
	PLOT DATE: 3/17/2014
	DRAWN BY: W.G.P.
	CHECKED BY: J.P.S.
	SHEET 237 OF 397